


- NOTES:
- 1 ALL ELECTRICAL EQUIPMENT INSTALLED IN THE DIGESTER BUILDING SHALL BE RATED FOR USE IN CLASS 1, DIVISION 1, GROUP D ENVIRONMENT.
  - 2 THE CONTRACTOR SHALL FURNISH AND INSTALL NEMA 7 (EXPLOSION PROOF) DISCONNECT SWITCHES FOR ALL 480 VAC MOTOR OPERATED VALVES, 120 VAC MOTOR OPERATED VALVES, AND 120 VAC INSTRUMENTS. DISCONNECT SWITCHES FOR 120 VAC LOADS SHALL BE 1-POLE, 20A, CROUSE-HINDS TYPE "EDS" OR EQUAL. DISCONNECT SWITCHES FOR 480 VAC LOADS SHALL BE 3-POLE, 30A, CROUSE-HINDS TYPE "EBM" OR EQUAL.
  - 3 THE CONTRACTOR SHALL REMOVE THE EXISTING NEMA 7 MOTOR STARTER, DISCONNECT SWITCH, AND ALL ASSOCIATED WIRE AND CONDUIT FOR THE EXISTING SLUDGE TRANSFER PUMPS NO.3 THRU NO.7. THE CONTRACTOR SHALL FIELD VERIFY THE LOCATIONS OF THESE DEVICES. THESE EXISTING PUMPS WILL BE CONTROLLED FROM THE NEW MCC-14.

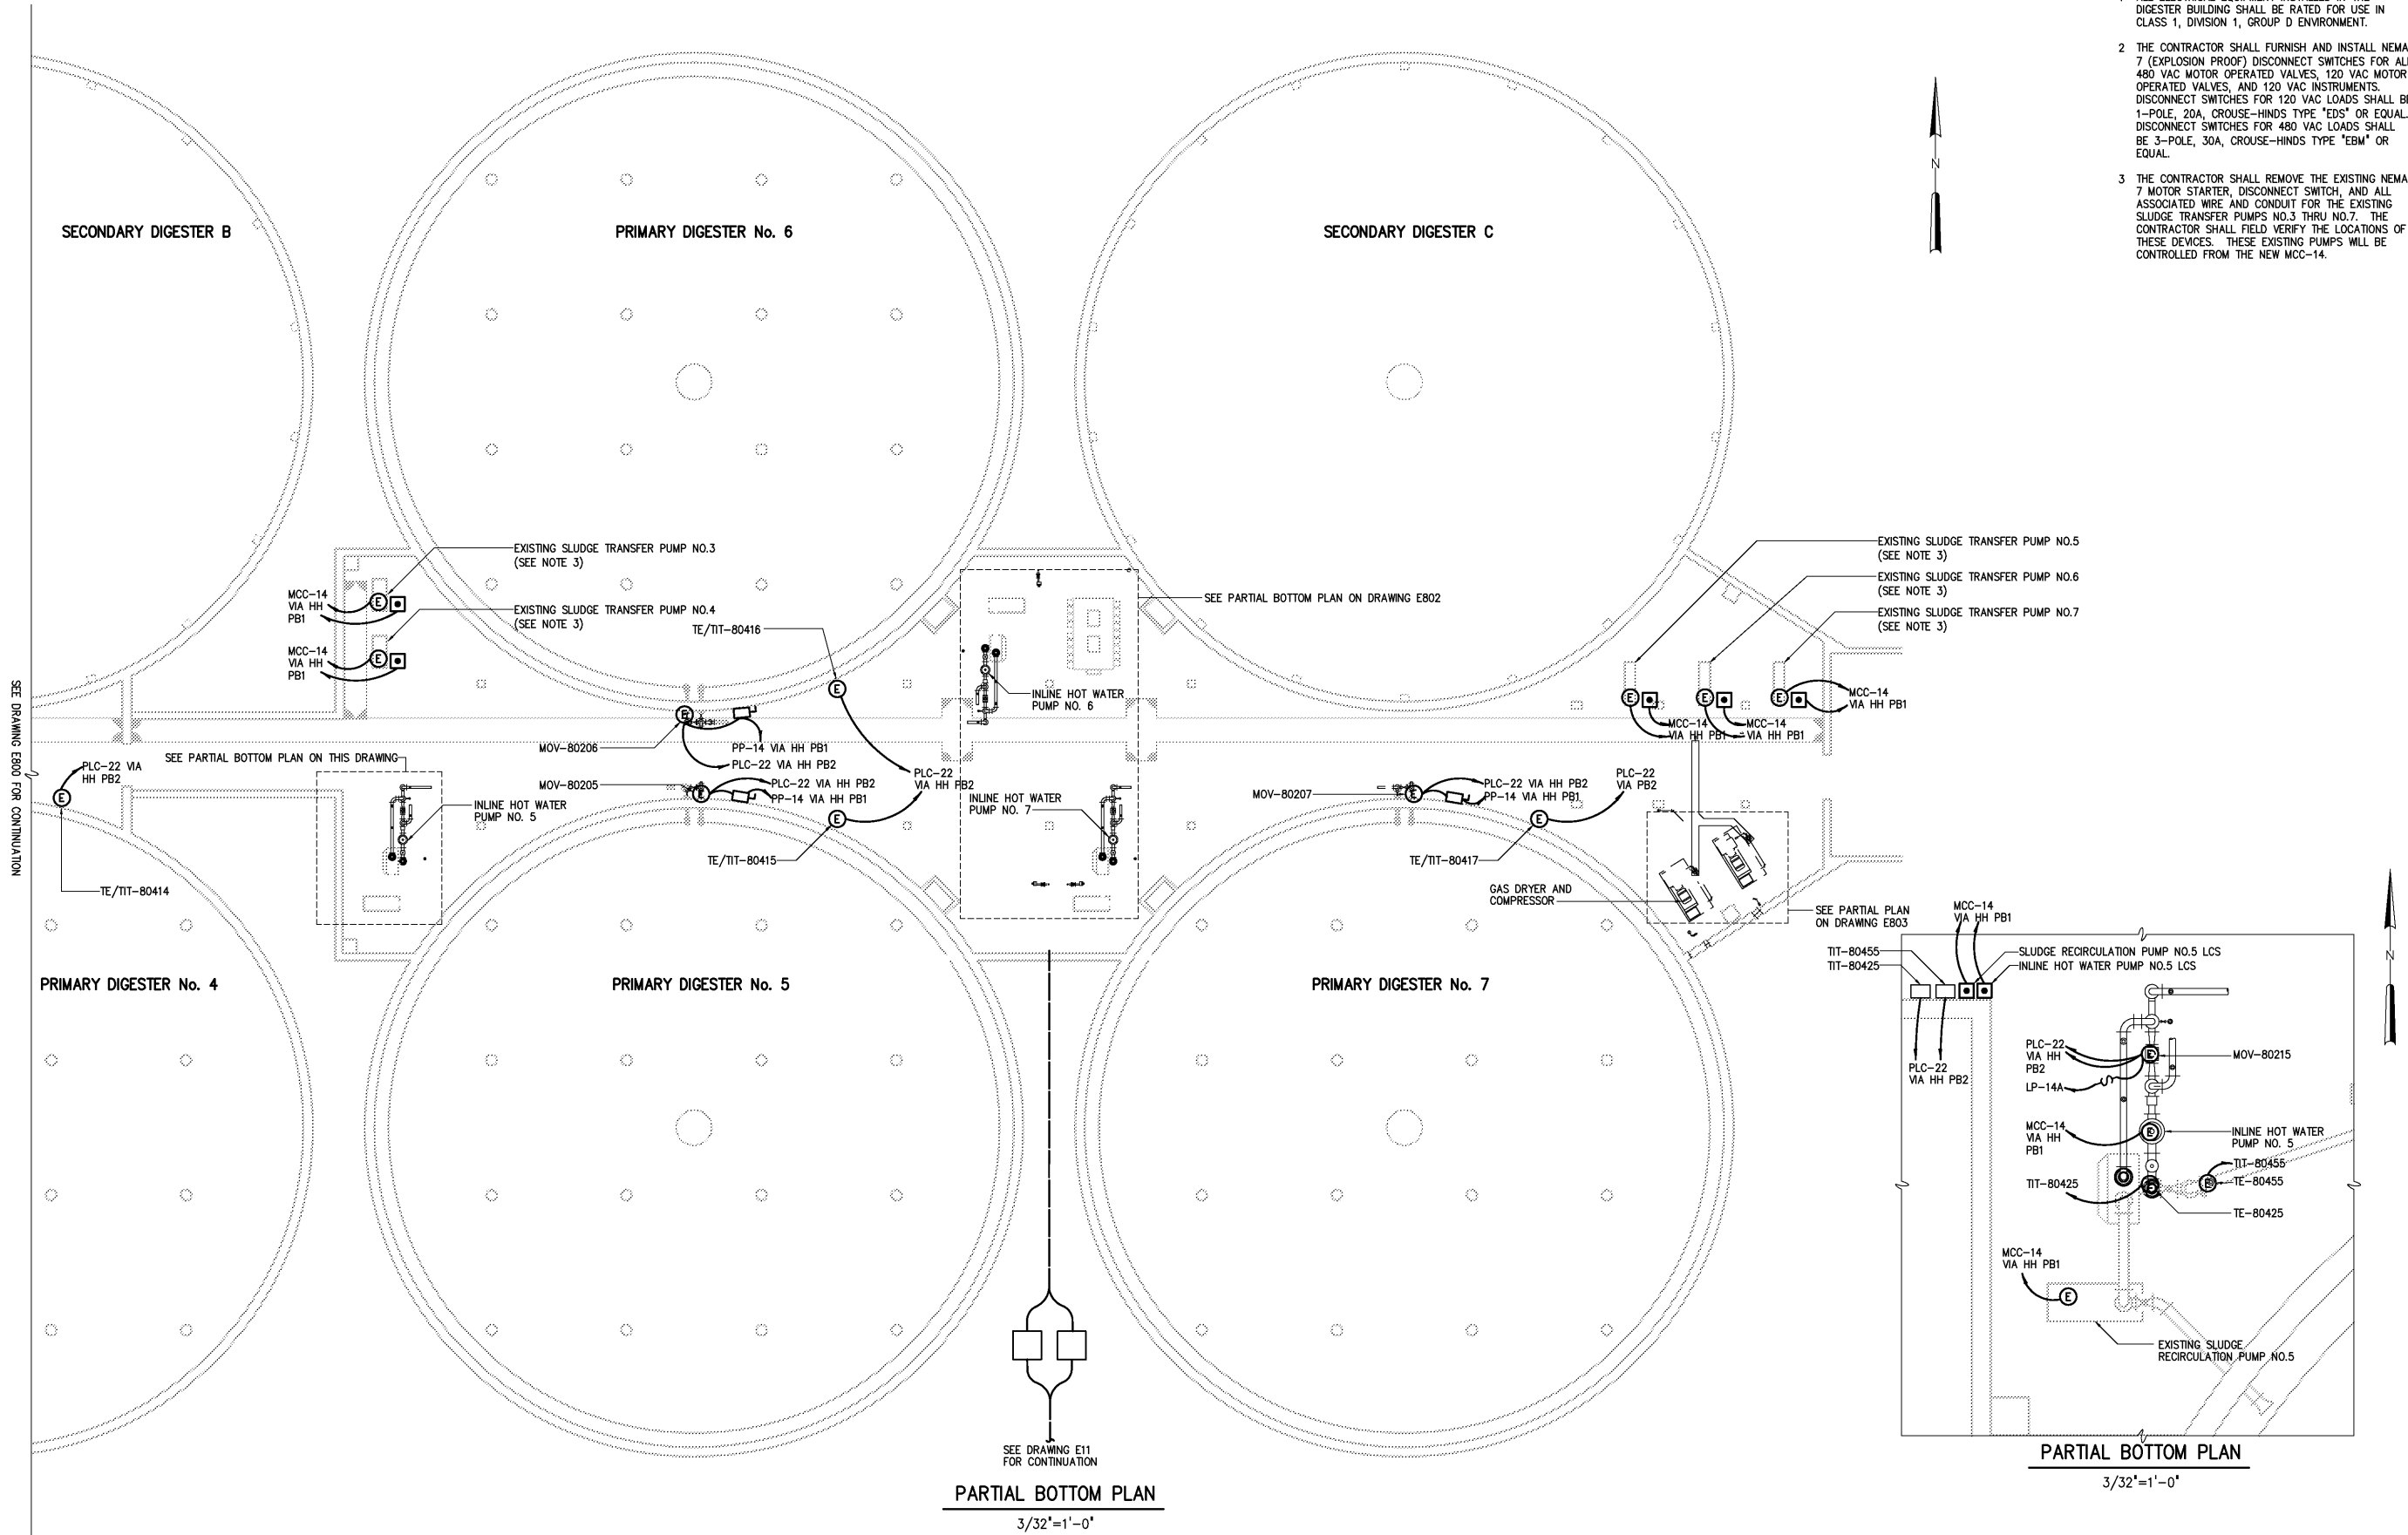

DESIGNED	BRL
DRAWN	BRL
CHECKED	
PROJ. ENGR.	DAN
APPROVED	
NO.	
DATE	BY
1	ISSUED FOR
2	REGULATORY APPROVAL
3	CONSTRUCTION
4	ADDITIONAL 1
5	ADDITIONAL 2
6	ADDITIONAL 3
100	ADDITIONAL 97

THIS DOCUMENT ORIGINALLY ISSUED FOR CONSTRUCTION AND SEALED BY ROBERT S. DIFIORE, SEAL NO. 22769

THIS DOCUMENT ORIGINALLY ISSUED FOR CONSTRUCTION AND SEALED BY RONALD L. TAYLOR, SEAL NO. 024649

RECORD DRAWING

THIS DRAWING HAS BEEN MODIFIED TO REFLECT FIELD CHANGES REPORTED BY THE CONTRACTOR OR ANOTHER PARTY, BUT NOT VERIFIED BY THE CERTIFYING ENGINEER. THIS DOCUMENT ORIGINALLY ISSUED AND SEALED BY GERALD J. RATASKY, 026535. THIS MEDIA SHALL NOT BE CONSIDERED A CERTIFIED DOCUMENT.

**HAZEN AND SAWYER**  
Environmental Engineers & Scientists  
4011 WestChase Blvd, Raleigh, North Carolina 27607

CITY OF ROANOKE  
VIRGINIA

REGIONAL WATER POLLUTION CONTROL PLANT  
PROCESS TRAIN IMPROVEMENTS

DIGESTER MODIFICATIONS  
ELECTRICAL  
PARTIAL BOTTOM PLANS

THE SCALE BAR SHOWN BELOW MEASURES ONE INCH LONG ON THE ORIGINAL DRAWING.	DATE	MARCH 2004
	H & S JOB NUMBER	30788B
	CONTRACT NUMBER	B
	DRAWING NUMBER	E801