
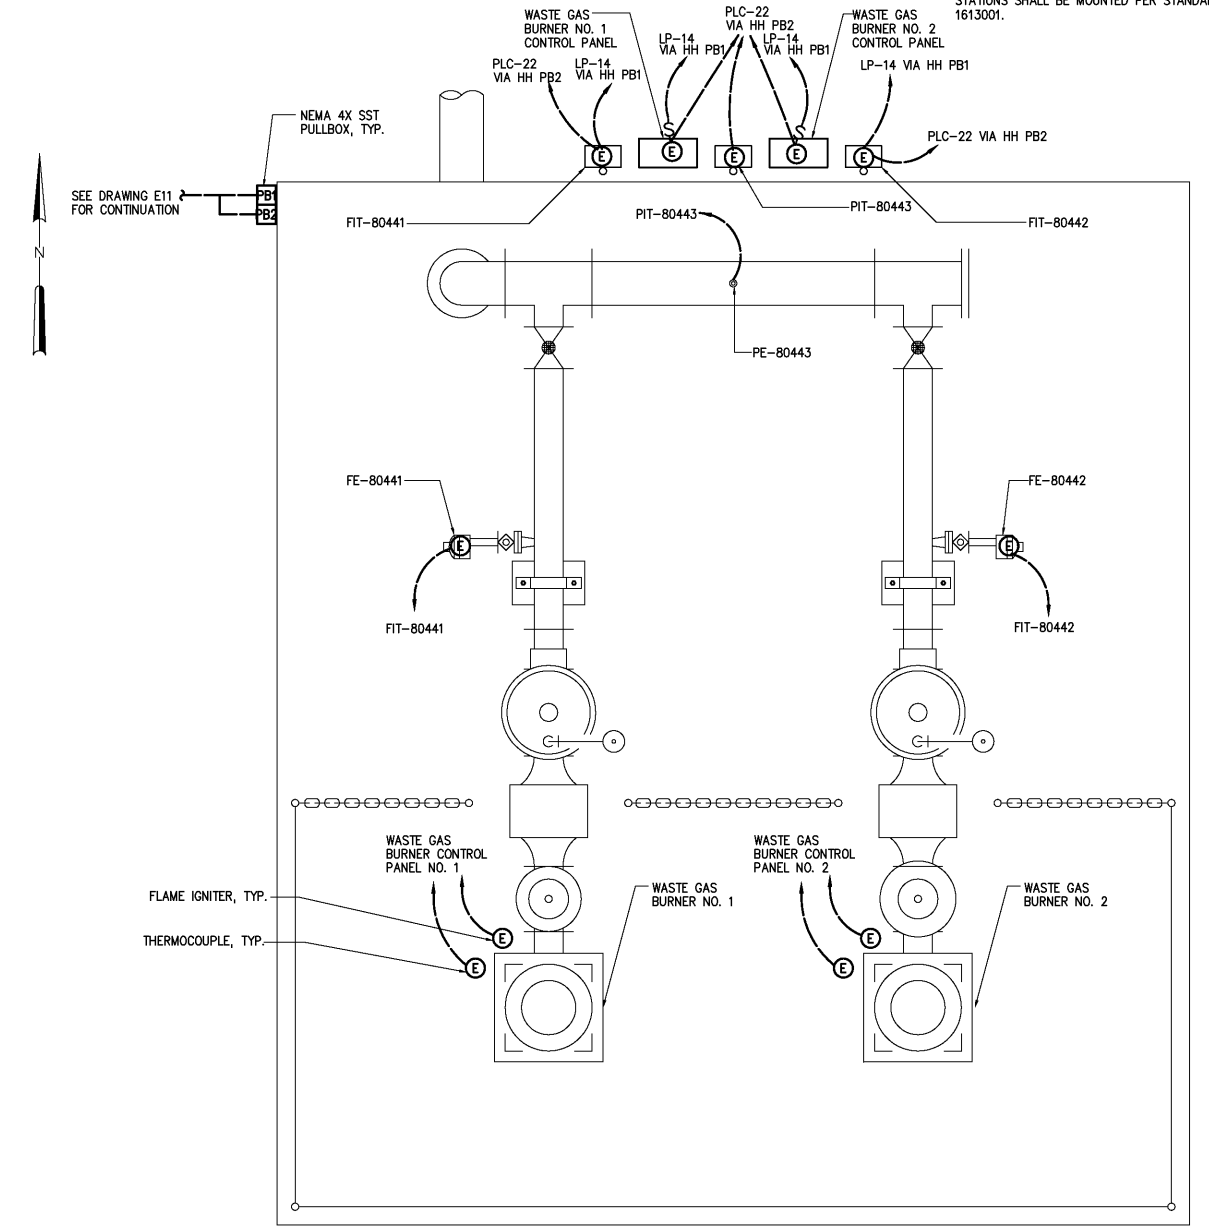


PARTIAL BOTTOM PLAN

3/16"=1'-0"

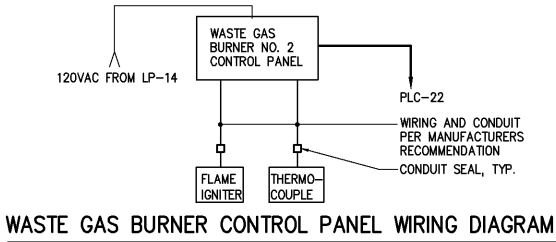

WASTE GAS BURNER PLAN

1/2"=1'-0"

- NOTES:
- 1 ALL ELECTRICAL EQUIPMENT INSTALLED IN THE DIGESTER BUILDING SHALL BE RATED FOR USE IN CLASS 1, DIVISION 1, GROUP D ENVIRONMENT.
  - 2 MCC-14 AND TX-LP-14 ARE LOCATED IN THE DIGESTER BOILER BUILDING ELECTRICAL ROOM. REFERENCE DRAWING E840.
  - 3 REFERENCE DRAWING E801 FOR LOCATIONS OF PB1 AND PB2.
  - 4 THE CONTRACTOR SHALL FURNISH AND INSTALL NEMA 7 (EXPLOSION PROOF) DISCONNECT SWITCHES FOR ALL 480 VAC MOTOR OPERATED VALVES, 120 VAC MOTOR OPERATED VALVES, AND 120 VAC INSTRUMENTS. DISCONNECT SWITCHES FOR 120 VAC LOADS SHALL BE 1-POLE, 20A, CROUSE-HINDS TYPE "EDS" OR EQUAL. DISCONNECT SWITCHES FOR 480 VAC LOADS SHALL BE 3-POLE, 30A, CROUSE-HINDS TYPE "EBM" OR EQUAL.
  - 5 ALL INSTRUMENT TRANSMITTERS AND LOCAL CONTROL STATIONS SHALL BE MOUNTED PER STANDARD DETAIL 1613001.

DESIGNED	BRL
DRAWN	BRL
CHECKED	
PROJ. ENGR.	DAN
APPROVED	
NO.	
DATE	BY
3	AS BUILT
2	CONSTRUCTION
1	REGULATORY APPROVAL
NO.	ISSUED FOR

DESIGNED	BRL
DRAWN	BRL
CHECKED	
PROJ. ENGR.	DAN
APPROVED	
NO.	
DATE	BY
3	AS BUILT
2	CONSTRUCTION
1	REGULATORY APPROVAL
NO.	ISSUED FOR

DESIGNED	BRL
DRAWN	BRL
CHECKED	
PROJ. ENGR.	DAN
APPROVED	
NO.	
DATE	BY
3	AS BUILT
2	CONSTRUCTION
1	REGULATORY APPROVAL
NO.	ISSUED FOR