


NOTES:

- 1 ALL EFFLUENT FILTER TAG NUMBERS ARE PRECEDED BY "60".
- 2 FILTER INFLUENT PIPE AND FILTER BACKWASH RECLAIM GATE ARE LOCATED BEHIND THE FILTER MEDIA IN THE FILTER GULLET.

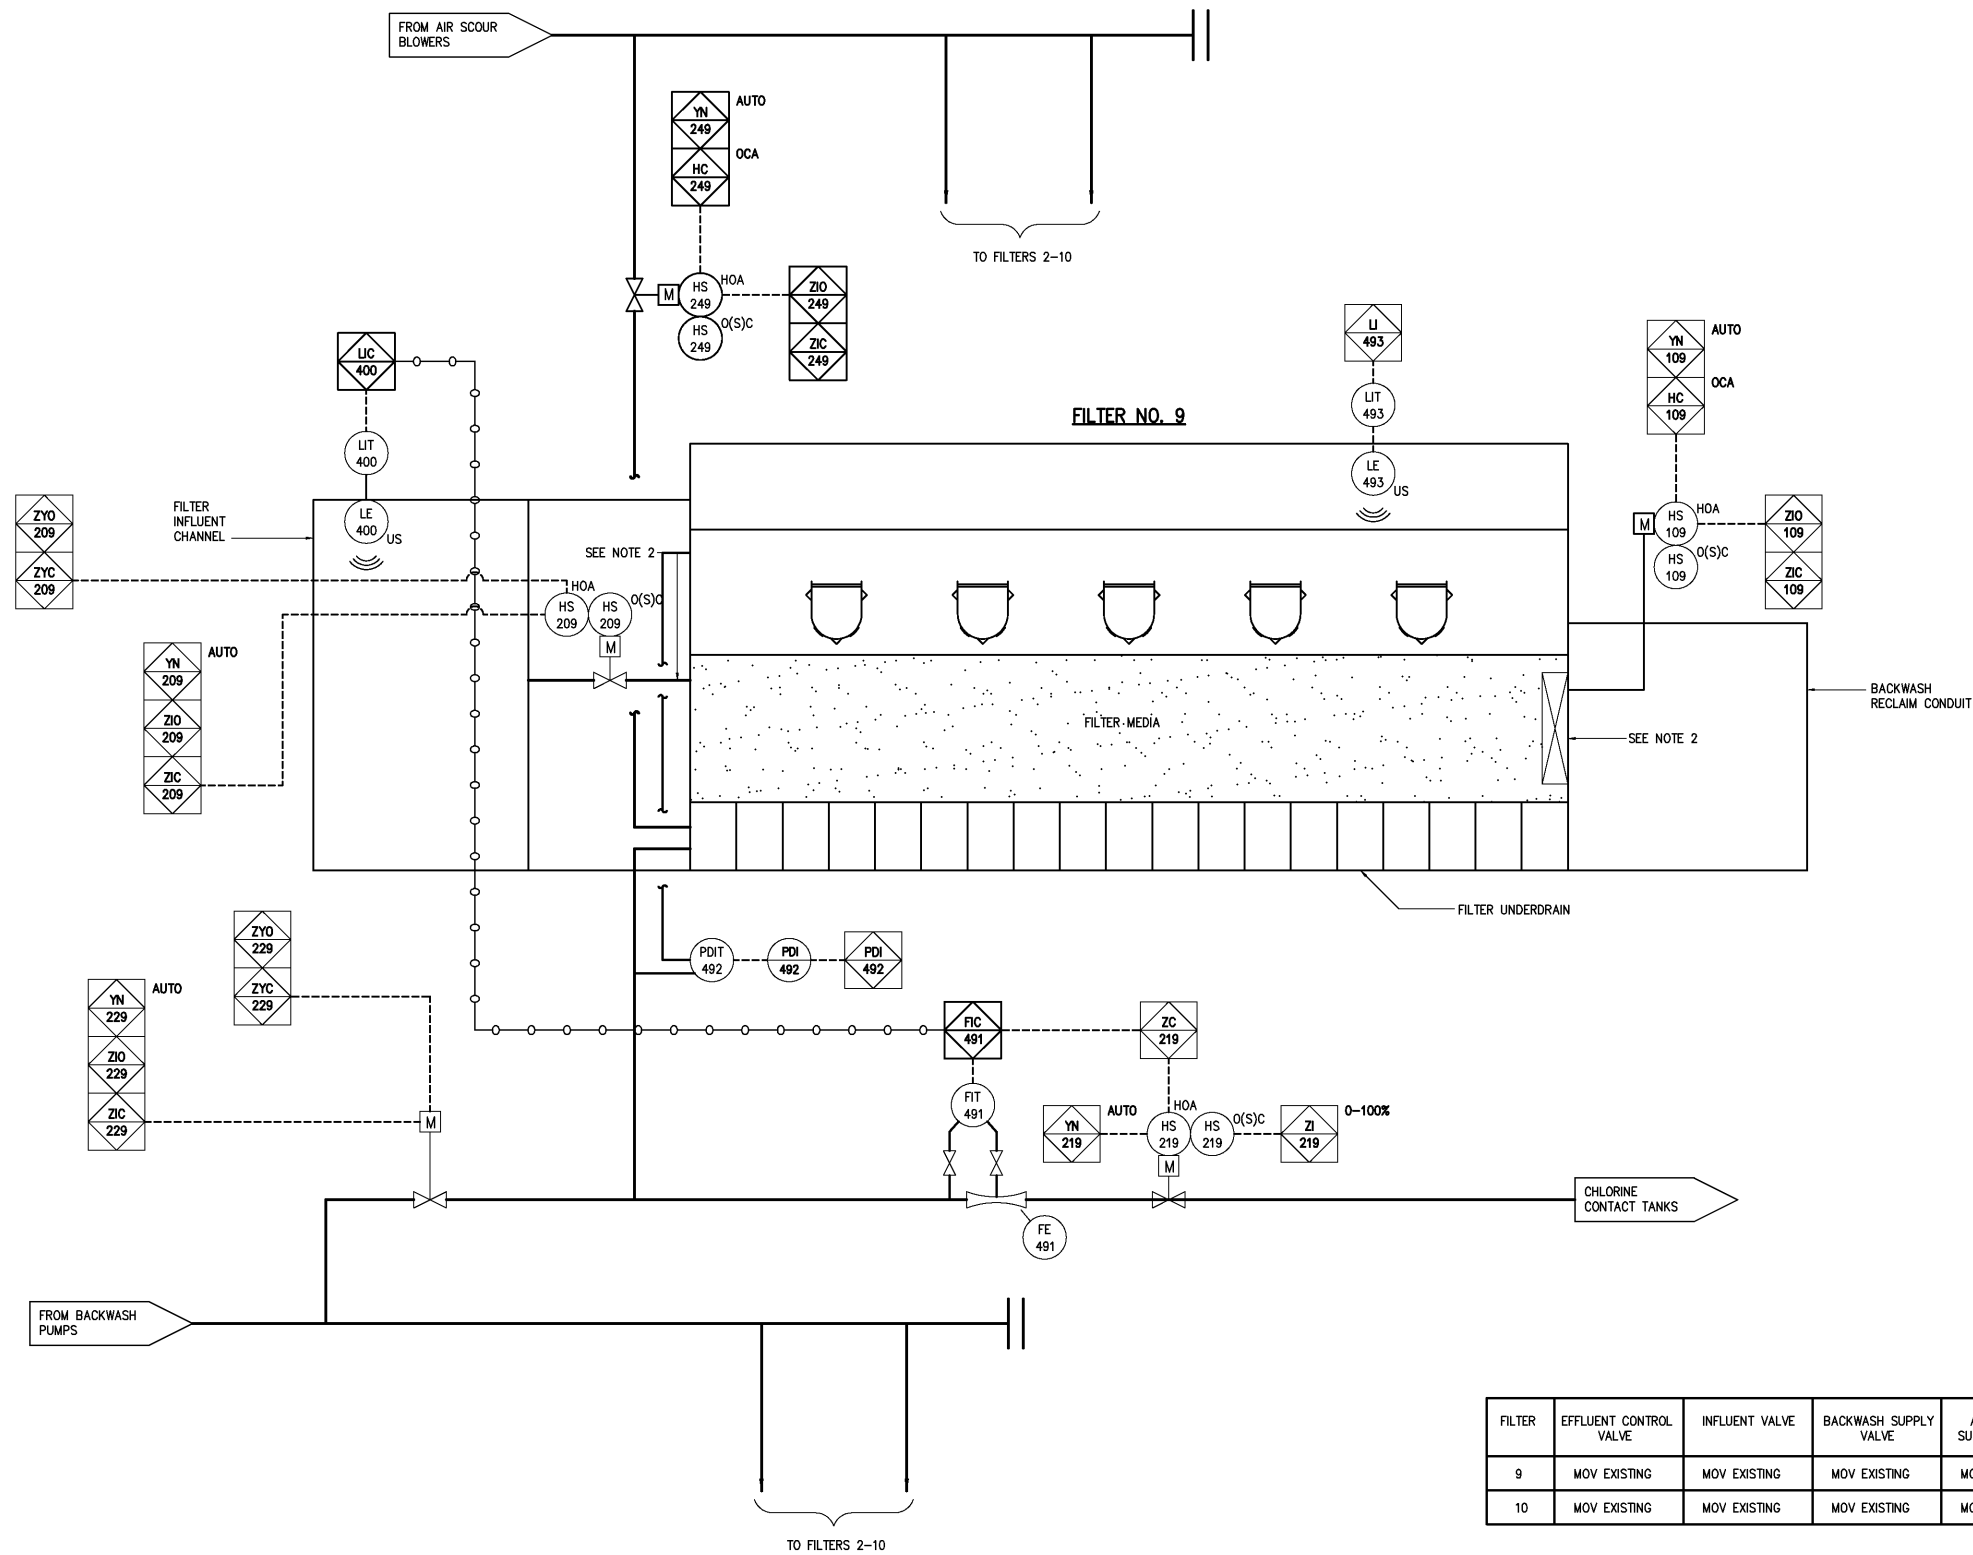

				DESIGNED <u>DMC/DBE</u>		RECORD DRAWING		HAZEN AND SAWYER Environmental Engineers & Scientists 4011 WestChase Blvd, Raleigh, North Carolina 27607	CITY OF ROANOKE VIRGINIA	INSTRUMENTATION AND CONTROL EFFLUENT FILTERS 9 & 10 PROCESS AND INSTRUMENTATION DIAGRAM	THE SCALE BAR SHOWN BELOW MEASURES ONE INCH LONG ON THE ORIGINAL DRAWING.	DATE MARCH 2004	
				DRAWN <u>PTL</u>		THIS DOCUMENT ORIGINALLY ISSUED FOR CONSTRUCTION AND SEALED BY ROBERT S. DIFIORE, SEAL NO. 22769						H & S JOB NUMBER 30788B	
				CHECKED		THIS DRAWING HAS BEEN MODIFIED TO REFLECT FIELD CHANGES REPORTED BY THE CONTRACTOR OR ANOTHER PARTY, BUT NOT VERIFIED BY THE CERTIFYING ENGINEER. THIS DOCUMENT ORIGINALLY ISSUED AND SEALED BY DANIEL B. EDWARDS, SEAL NUMBER 024960. THIS MEDIA SHALL NOT BE CONSIDERED A CERTIFIED DOCUMENT.						CONTRACT NUMBER B	
				PROJ. ENGR. <u>DAN</u>		THIS DOCUMENT ORIGINALLY ISSUED FOR CONSTRUCTION AND SEALED BY RONALD L. TAYLOR, SEAL NO. 024649						DRAWING NUMBER 1601	
3	AS BUILT	OCT 2007	RLT	APPROVED									
2	CONSTRUCTION	MAR 2004	RLT										
1	REGULATORY APPROVAL	NOV 2003	RLT										
NO.	ISSUED FOR	DATE	BY										

POST DATE 01/10/03 8:40pm FILE= H:\30788\INST\011 by PILLARAWSON XREF=MSIC\30788B