


NOTES

1 ALL DECANT PUMP TAG NUMBERS ARE PRECEDED BY '88'.

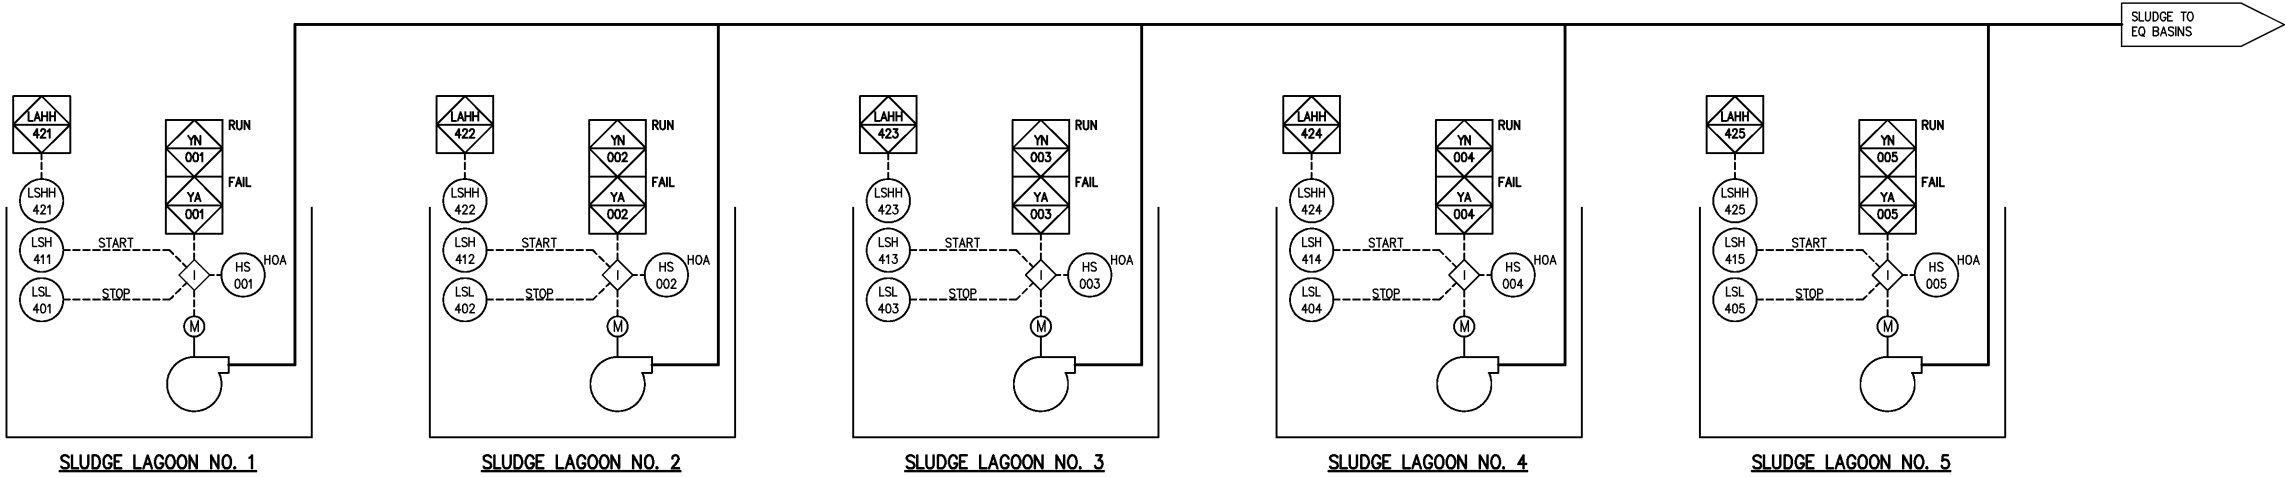

			DESIGNED DBE		THIS DOCUMENT ORIGINALLY ISSUED FOR CONSTRUCTION AND SEALED BY ROBERT S. DIFIORE, SEAL NO. 22769	RECORD DRAWING	THIS DRAWING HAS BEEN MODIFIED TO REFLECT FIELD CHANGES REPORTED BY THE CONTRACTOR OR ANOTHER PARTY, BUT NOT VERIFIED BY THE CERTIFYING ENGINEER. THIS DOCUMENT ORIGINALLY ISSUED AND SEALED BY DANIEL B. EDWARDS, SEAL NUMBER 024960. THIS MEDIA SHALL NOT BE CONSIDERED A CERTIFIED DOCUMENT.	HAZEN AND SAWYER Environmental Engineers & Scientists 4011 WestChase Blvd, Raleigh, North Carolina 27607	CITY OF ROANOKE VIRGINIA	REGIONAL WATER POLLUTION CONTROL PLANT PROCESS TRAIN IMPROVEMENTS	INSTRUMENTATION AND CONTROL LAGOON DECANT STRUCTURES PUMPING SYSTEM PROCESS AND INSTRUMENTATION DIAGRAM	THE SCALE BAR SHOWN BELOW MEASURES ONE INCH LONG ON THE ORIGINAL DRAWING.	DATE MARCH 2004		
			DRAWN JAD										H & S JOB NUMBER 30788B		
			CHECKED										CONTRACT NUMBER B		
3	AS BUILT	OCT 2007	RLT	PROJ. ENGR. DAN	THIS DOCUMENT ORIGINALLY ISSUED FOR CONSTRUCTION AND SEALED BY RONALD L. TAYLOR, SEAL NO. 024649									DRAWING NUMBER 1880	
2	CONSTRUCTION	MAR 2004	RLT												
1	REGULATORY APPROVAL	NOV 2003	RLT												
NO.	ISSUED FOR	DATE	BY	APPROVED											