

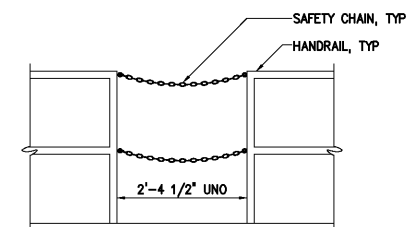
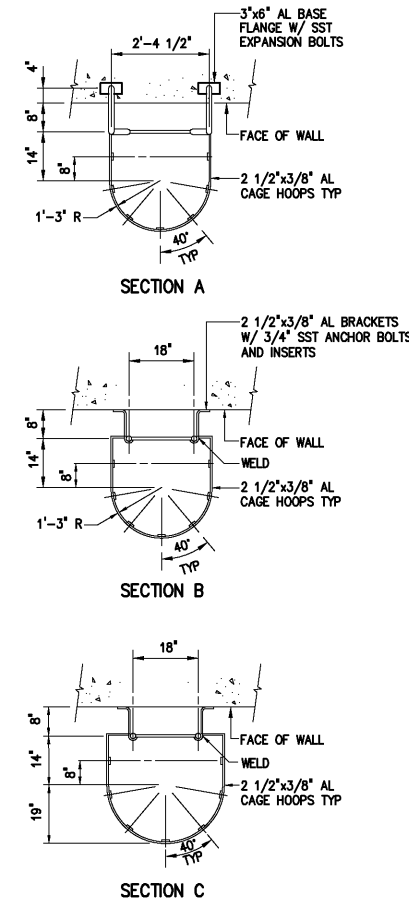
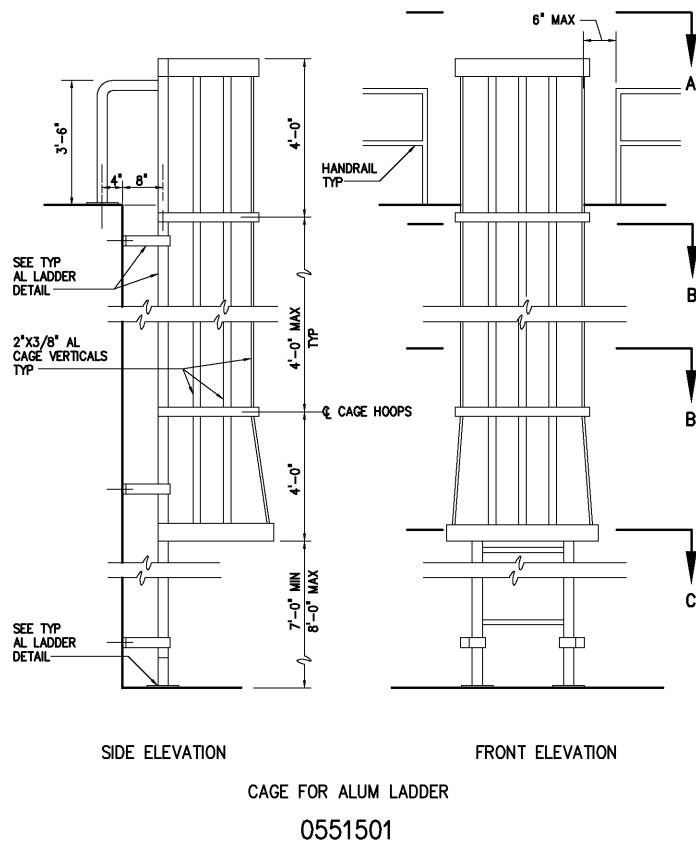


FRP HANDRAIL SYSTEM  
0665201

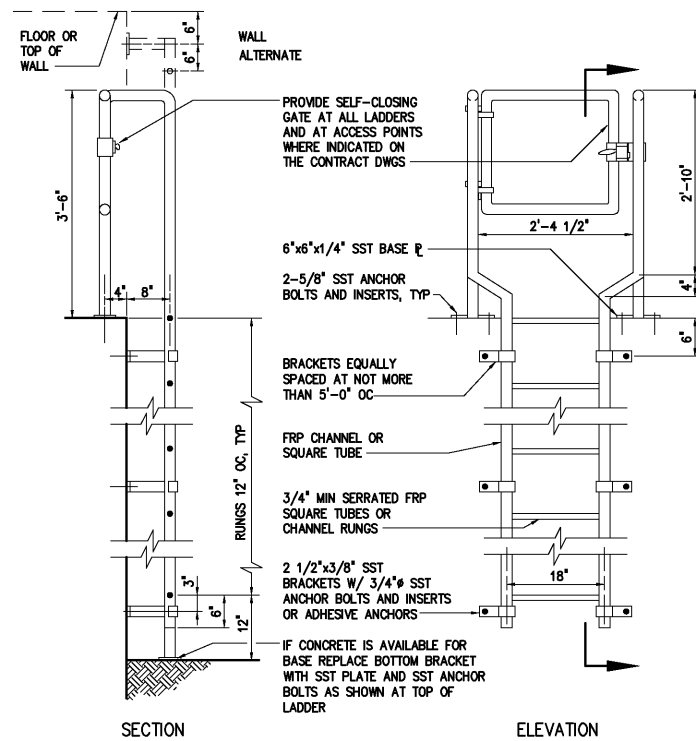

HANDRAIL SAFETY CHAIN GATE  
0552001

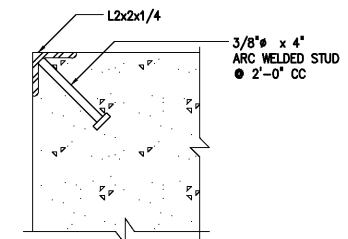

NOTE: CORNER GUARD REQUIRED  
ONLY WHERE SHOWN ON PLANS

CORNER GUARD  
0554001

				DESIGNED	H & S
				DRAWN	H & S
				CHECKED	
3	AS BUILT	OCT 2007	RLT	PROJ. ENGR.	H & S
2	CONSTRUCTION	MAR 2004	RLT		
1	REGULATORY APPROVAL	NOV 2003	RLT		
NO.	ISSUED FOR	DATE	BY	APPROVED	

THIS DOCUMENT ORIGINALLY ISSUED  
FOR CONSTRUCTION AND SEALED BY  
ROBERT S. DIFIORE, SEAL NO. 22769

#### RECORD DRAWING

THIS DRAWING HAS BEEN MODIFIED TO REFLECT FIELD  
CHANGES REPORTED BY THE CONTRACTOR OR ANOTHER  
PARTY, BUT NOT VERIFIED BY THE CERTIFYING ENGINEER.  
THIS DOCUMENT ORIGINALLY ISSUED AND SEALED BY  
CHRISTOPHER T. PHILLIPS, 033796. THIS MEDIA SHALL  
NOT BE CONSIDERED A CERTIFIED DOCUMENT.

THIS DOCUMENT ORIGINALLY ISSUED  
FOR CONSTRUCTION AND SEALED BY  
RONALD L. TAYLOR, SEAL NO. 024649

**HAZEN AND SAWYER**  
Environmental Engineers & Scientists  
4011 WestChase Blvd, Raleigh, North Carolina 27607

CITY OF ROANOKE  
VIRGINIA

REGIONAL WATER POLLUTION CONTROL PLANT  
PROCESS TRAIN IMPROVEMENTS

MISCELLANEOUS STANDARD DETAILS

THE SCALE BAR SHOWN BELOW MEASURES ONE INCH LONG ON THE ORIGINAL DRAWING.	DATE MARCH 2004
H & S JOB NUMBER 30788B	CONTRACT NUMBER B
DRAWING NUMBER D10	