


CITY OF ROANOKE, VIRGINIA




REGIONAL WATER POLLUTION CONTROL PLANT
CONTRACT C - ADMINISTRATION AND
MAINTENANCE BUILDINGS

SRF PROJECT NO. C-515294
CITY PROJECT NO. 6521
BID NO. 03-12-07
MARCH 2008

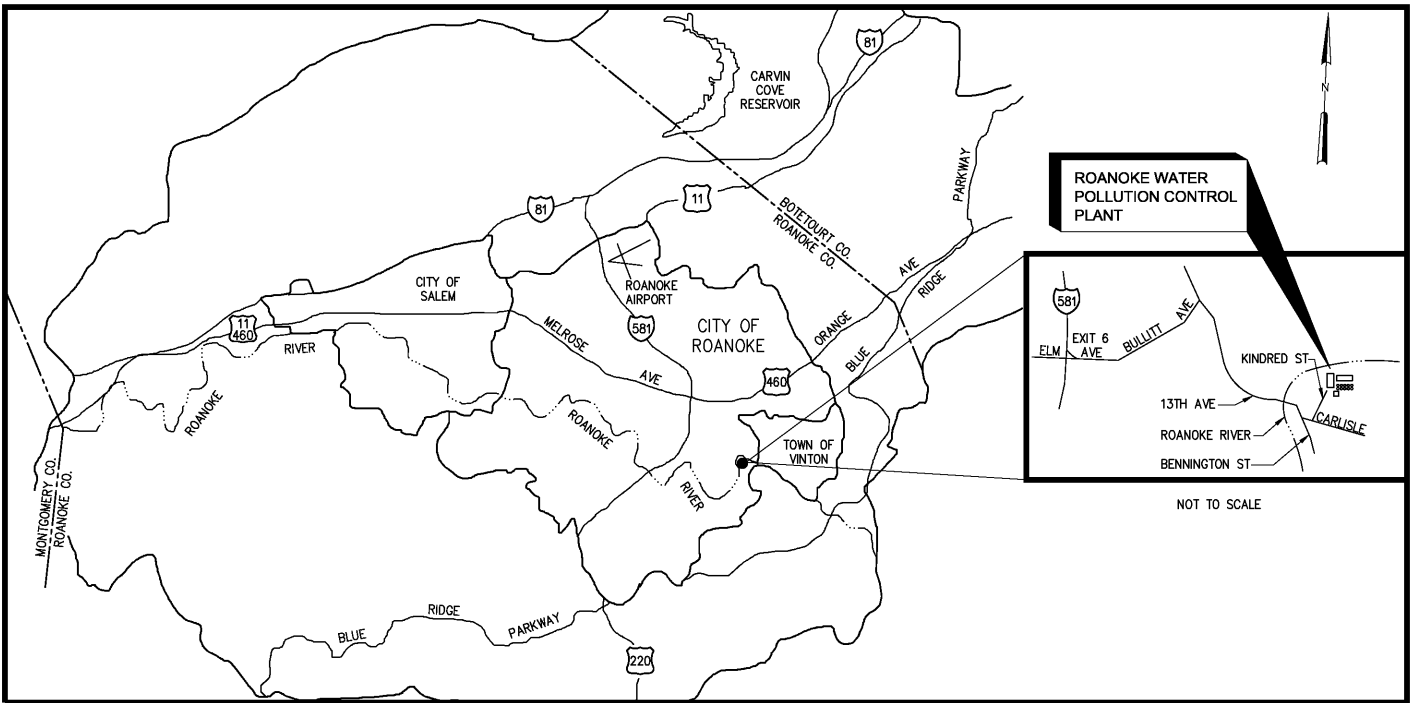

LOCATION PLAN

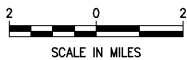

THIS DOCUMENT ORIGINALLY ISSUED
FOR CONSTRUCTION AND SEALED BY
ROBERT S. DIFIORE, SEAL NO. 22769

HAZEN AND SAWYER
Environmental Engineers & Scientists
4011 WestChase Blvd, Raleigh, North Carolina 27607

THIS DOCUMENT ORIGINALLY ISSUED
FOR CONSTRUCTION AND SEALED BY
RONALD L. TAYLOR, SEAL NO. 024649

RECORD DRAWINGS