
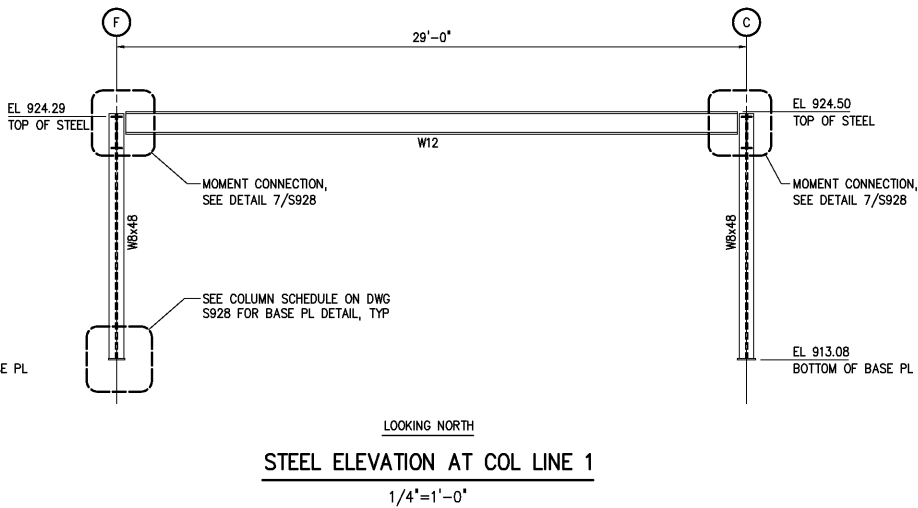
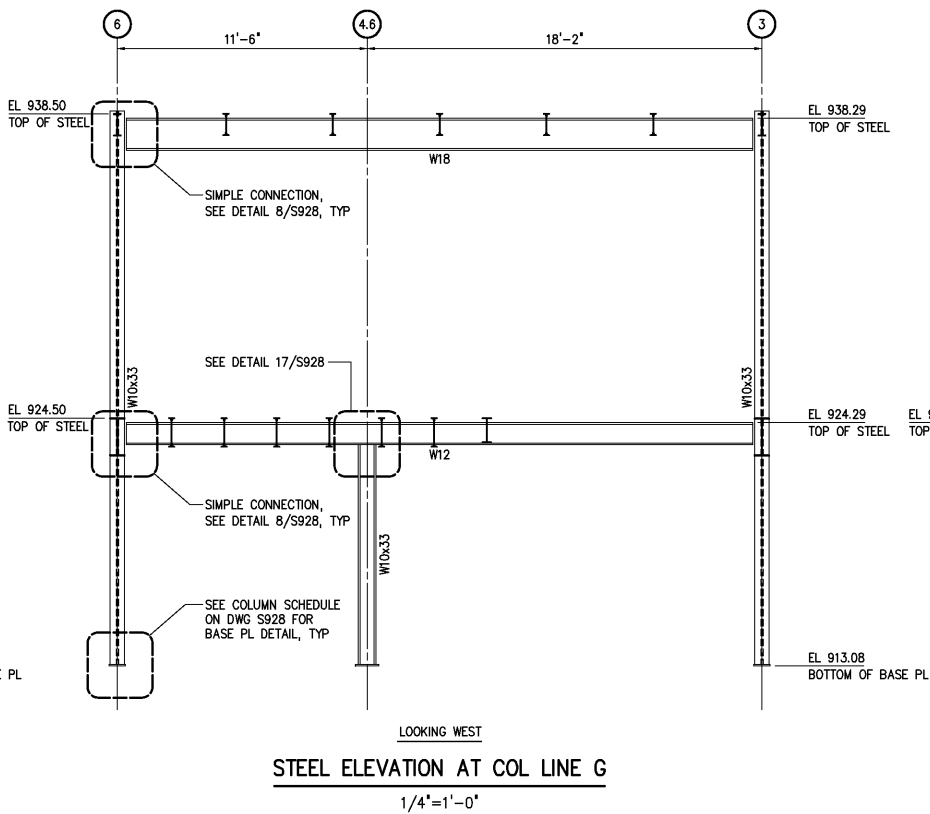
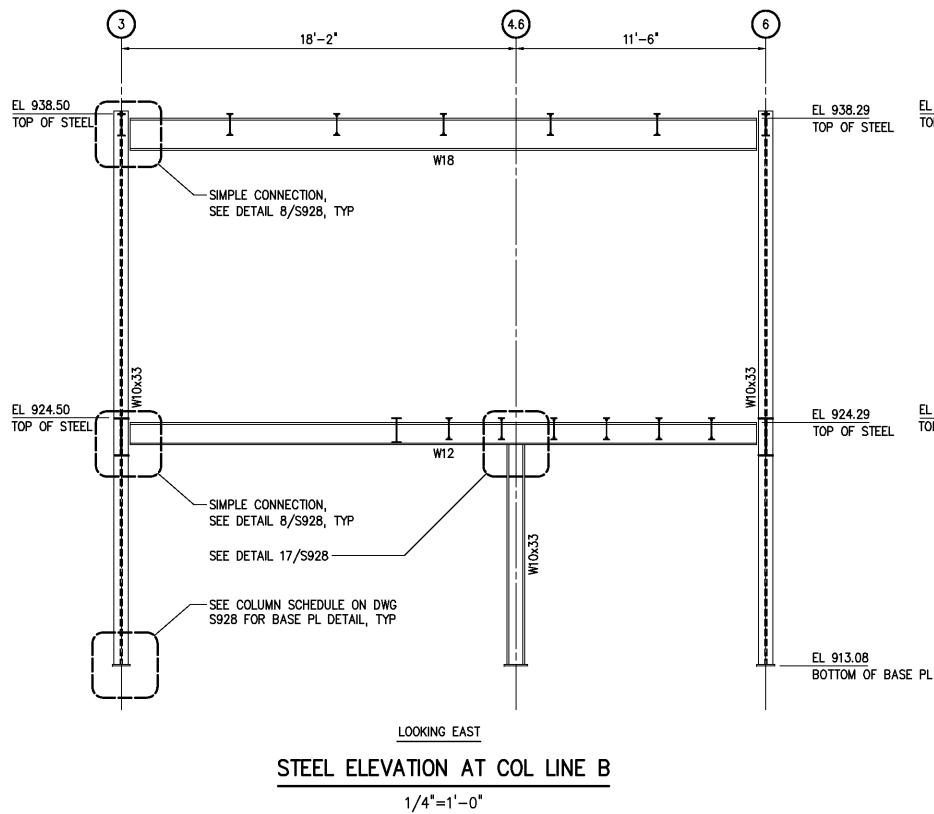
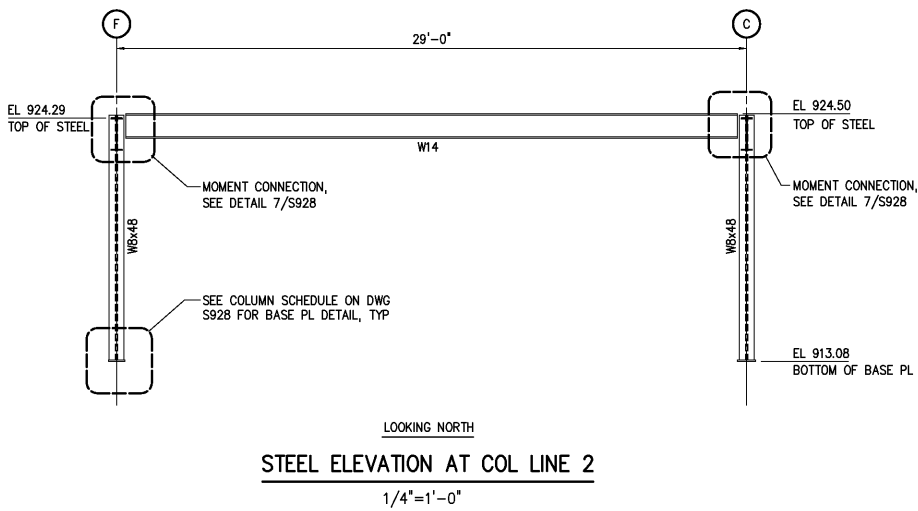
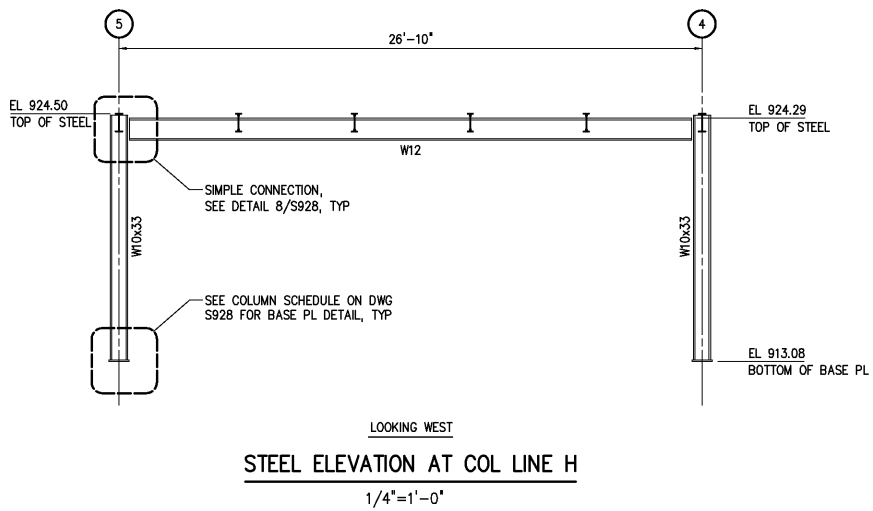


NOTES:
1 CONCRETE SLAB AND STEEL DECKING NOT SHOWN IN STEEL ELEVATIONS.

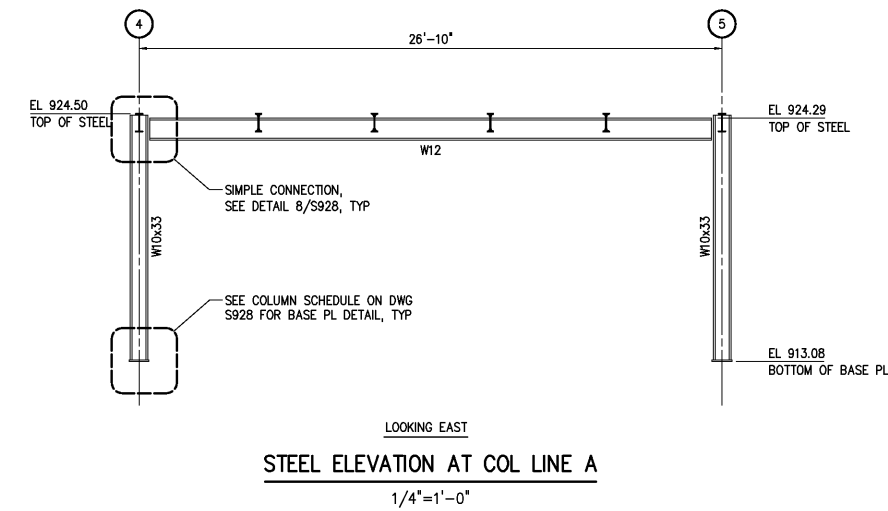

				DESIGNED	BGS	RECORD DRAWING	THIS DOCUMENT ORIGINALLY ISSUED FOR CONSTRUCTION AND SEALED BY ROBERT S. DIFIORE, SEAL NO. 22769	HAZEN AND SAWYER Environmental Engineers & Scientists 4011 WestChase Blvd, Raleigh, North Carolina 27607	CITY OF ROANOKE VIRGINIA	ADMINISTRATION BUILDING	THE SCALE BAR SHOWN BELOW MEASURES ONE INCH LONG ON THE ORIGINAL DRAWING.	DATE	JANUARY 2004	
				DRAWN	SMH						H & S JOB NUMBER	30788C		
				CHECKED							CONTRACT NUMBER	DRAWING NUMBER		
3	RECORD DRAWING	JAN 2006	RLT	PROJ. ENGR.	DAN	THIS DRAWING HAS BEEN MODIFIED TO REFLECT FIELD CHANGES REPORTED BY THE CONTRACTOR OR ANOTHER PARTY, BUT NOT VERIFIED BY THE CERTIFYING ENGINEER. THIS DOCUMENT ORIGINALLY ISSUED AND SEALED BY CHRISTOPHER T. PHILLIPS, 033796. THIS MEDIA SHALL NOT BE CONSIDERED A CERTIFIED DOCUMENT.	THIS DOCUMENT ORIGINALLY ISSUED FOR CONSTRUCTION AND SEALED BY RONALD L. TAYLOR, SEAL NO. 024649		REGIONAL WATER POLLUTION CONTROL PLANT PROCESS TRAIN IMPROVEMENTS	STRUCTURAL ELEVATIONS - SHEET 1		C	S924	
2	CONSTRUCTION	JAN 2004	RLT											
1	REGULATORY APPROVAL	NOV 2003	RLT											
NO.	ISSUED FOR	DATE	BY	APPROVED										