


LOOKING SOUTH
STEEL ELEVATION AT COL LINES 5 & 6
 1/4"=1'-0"

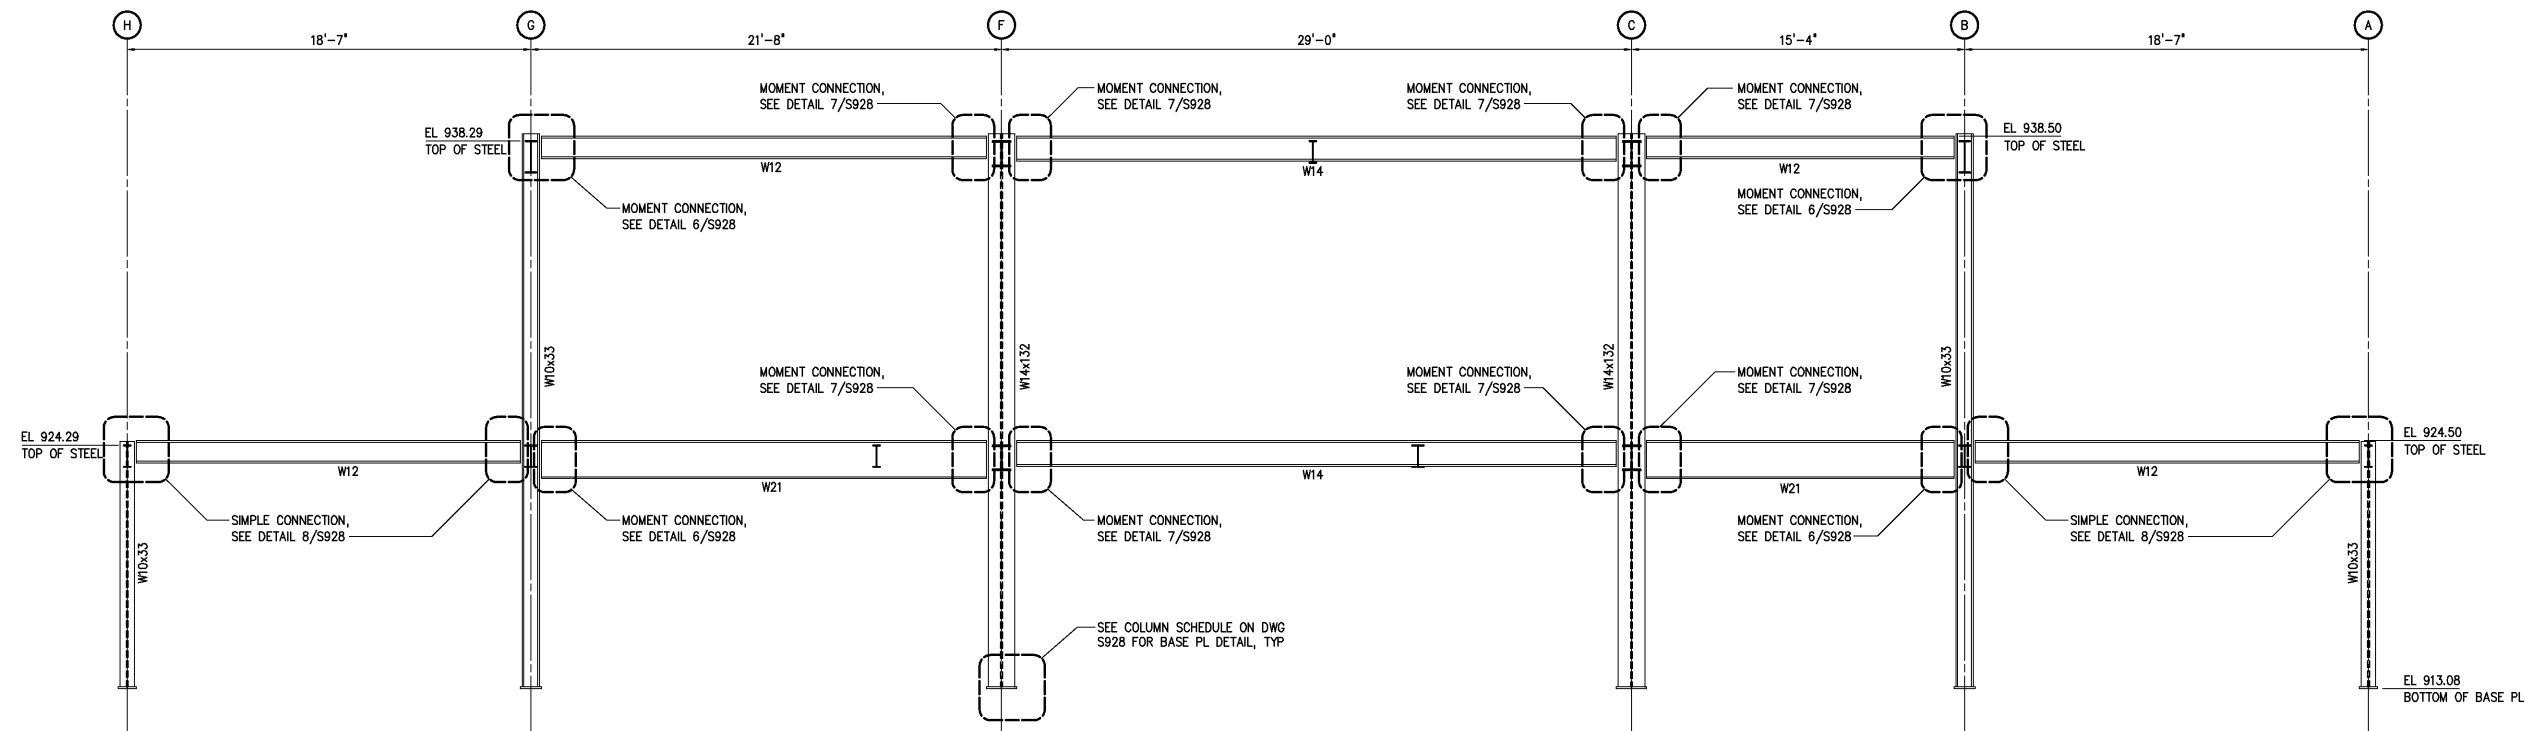

LOOKING NORTH
STEEL ELEVATION AT COL LINES 3 & 4
 1/4"=1'-0"

NOTES:
 1 CONCRETE SLAB AND STEEL DECKING NOT SHOWN IN STEEL ELEVATIONS.

DESIGNED	BGS
DRAWN	SMH
CHECKED	
PROJ. ENGR.	DAN
APPROVED	
NO.	
3	RECORD DRAWING
2	CONSTRUCTION
1	REGULATORY APPROVAL
NO.	ISSUED FOR
	DATE
	BY

THIS DOCUMENT ORIGINALLY ISSUED FOR CONSTRUCTION AND SEALED BY ROBERT S. DIFIORE, SEAL NO. 22769

RECORD DRAWING

THIS DRAWING HAS BEEN MODIFIED TO REFLECT FIELD CHANGES REPORTED BY THE CONTRACTOR OR ANOTHER PARTY, BUT NOT VERIFIED BY THE CERTIFYING ENGINEER. THIS DOCUMENT ORIGINALLY ISSUED AND SEALED BY CHRISTOPHER T. PHILLIPS, 033796. THIS MEDIA SHALL NOT BE CONSIDERED A CERTIFIED DOCUMENT.

THIS DOCUMENT ORIGINALLY ISSUED FOR CONSTRUCTION AND SEALED BY RONALD L. TAYLOR, SEAL NO. 024649

HAZEN AND SAWYER
 Environmental Engineers & Scientists
 4011 WestChase Blvd, Raleigh, North Carolina 27607

CITY OF ROANOKE
 VIRGINIA
REGIONAL WATER POLLUTION CONTROL PLANT
 PROCESS TRAIN IMPROVEMENTS

ADMINISTRATION BUILDING
STRUCTURAL
ELEVATIONS - SHEET 3

THE SCALE BAR SHOWN BELOW MEASURES ONE INCH LONG ON THE ORIGINAL DRAWING.	DATE	JANUARY 2004
	H & S JOB NUMBER	30788C
	CONTRACT NUMBER	C
	DRAWING NUMBER	S926