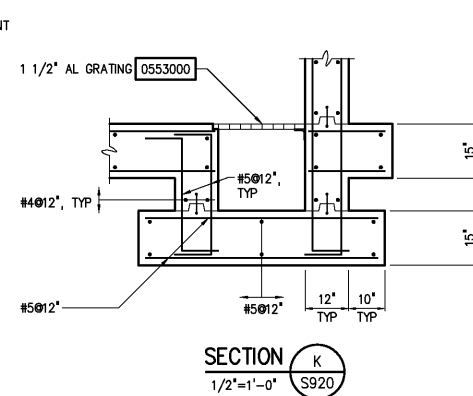
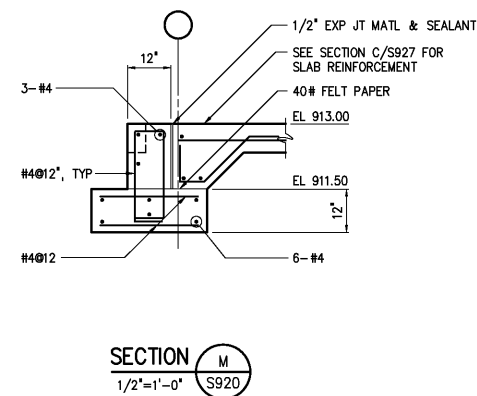
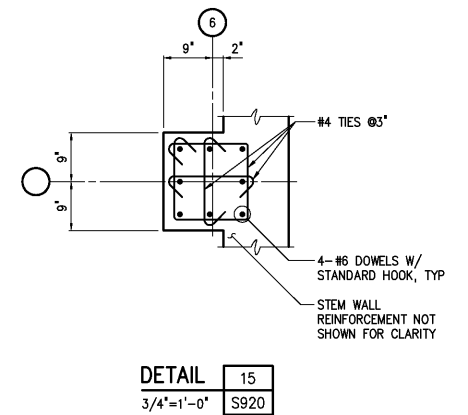
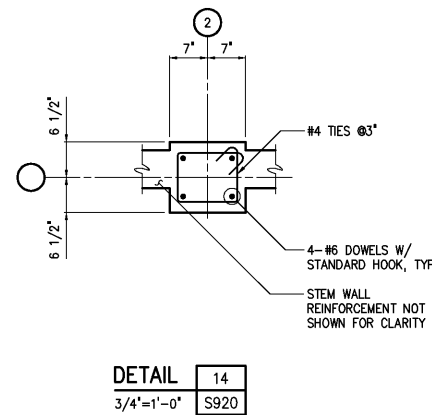
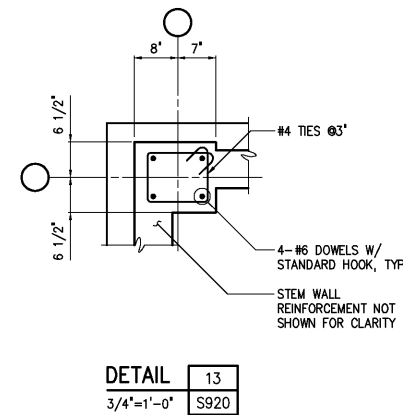
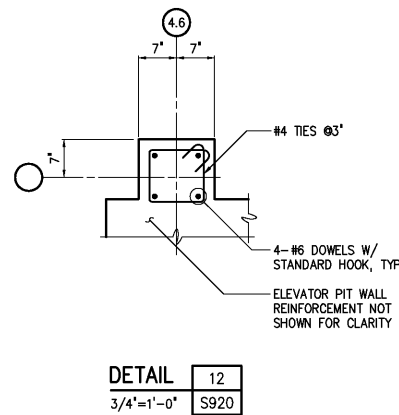
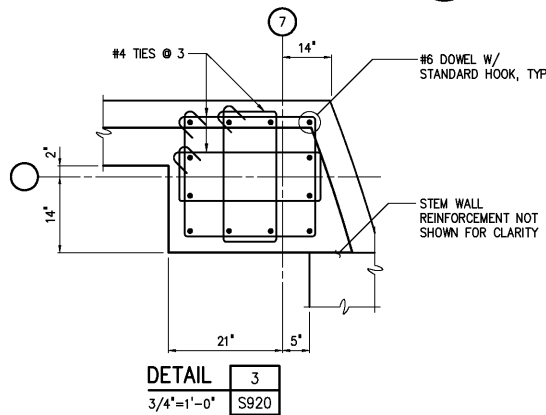
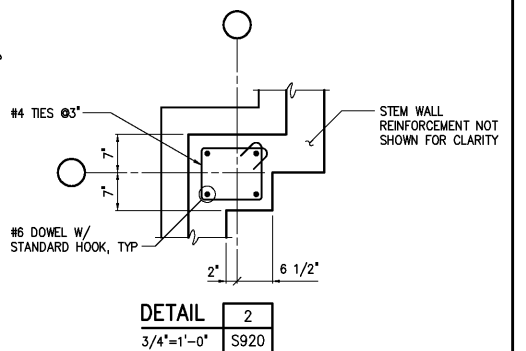
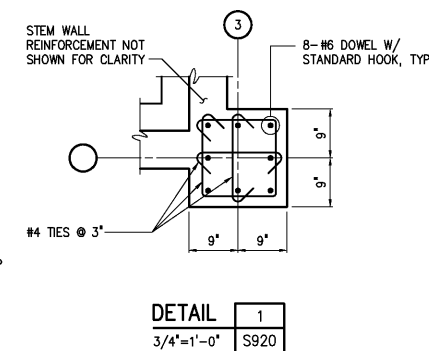
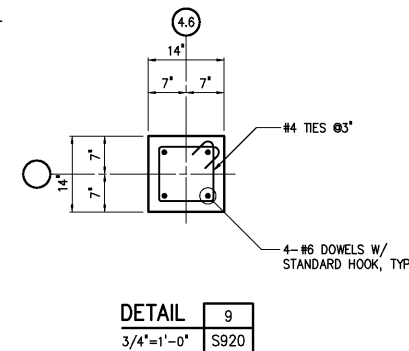
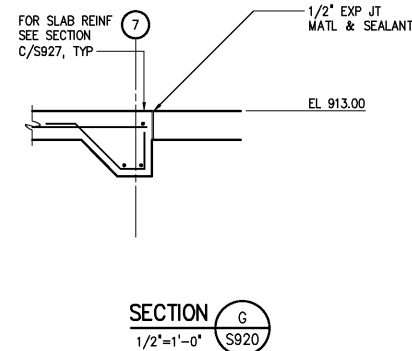
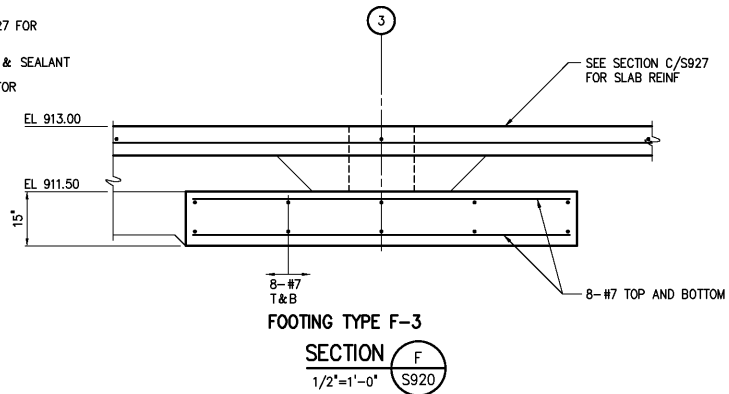
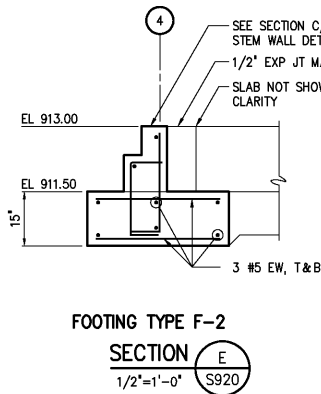
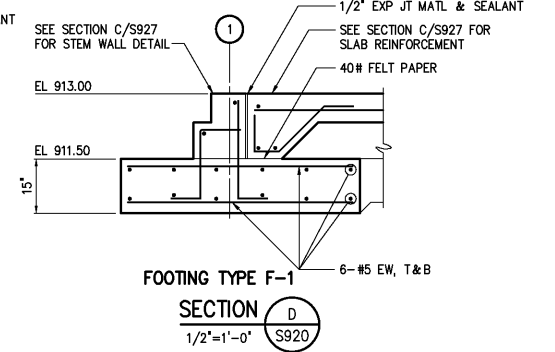
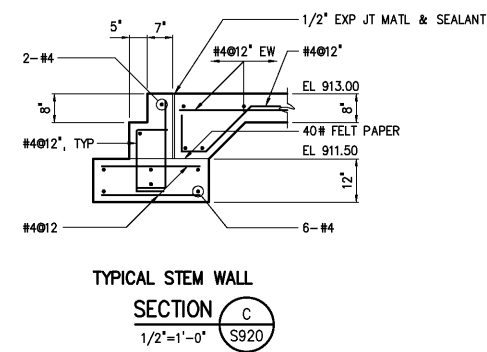
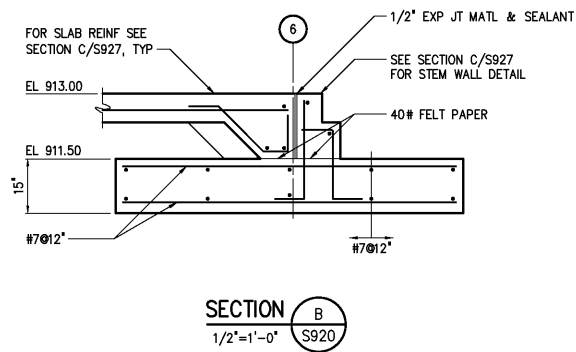
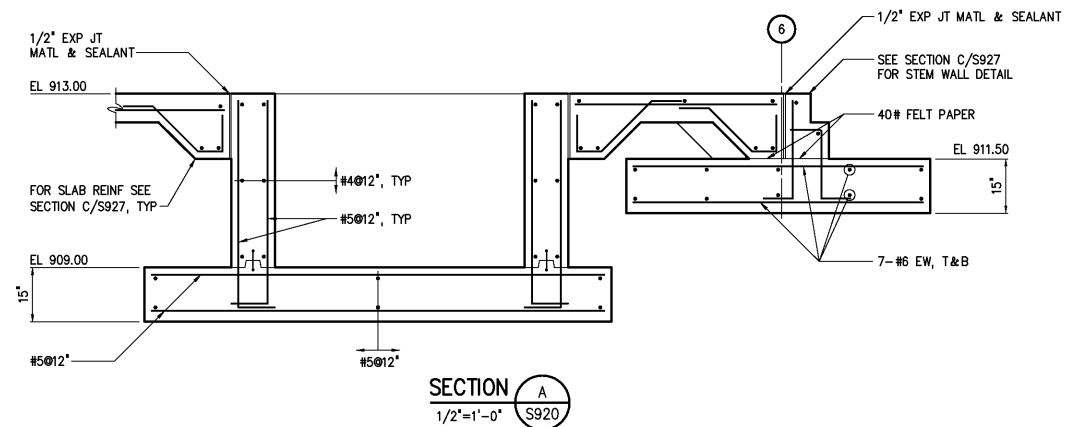


				DESIGNED _____ BGS	THIS DOCUMENT ORIGINALLY ISSUED FOR CONSTRUCTION AND SEALED BY ROBERT S. DIFIORE, SEAL NO. 22769 RECORD DRAWING THIS DRAWING HAS BEEN MODIFIED TO REFLECT FIELD CHANGES REPORTED BY THE CONTRACTOR OR ANOTHER PARTY, BUT NOT VERIFIED BY THE CERTIFYING ENGINEER. THIS DOCUMENT ORIGINALLY ISSUED AND SEALED BY CHRISTOPHER T. PHILLIPS, 033796. THIS MEDIA SHALL NOT BE CONSIDERED A CERTIFIED DOCUMENT. HAZEN AND SAWYER Environmental Engineers & Scientists 4011 WestChase Blvd, Raleigh, North Carolina 27607	CITY OF ROANOKE VIRGINIA		ADMINISTRATION BUILDING	THE SCALE BAR SHOWN BELOW MEASURES ONE INCH LONG ON THE ORIGINAL DRAWING.	DATE JANUARY 2004	
				DRAWN _____ SMH/BGS		H & S JOB NUMBER 30788C					
				CHECKED _____		CONTRACT NUMBER		DRAWING NUMBER			
3	RECORD DRAWING	JAN 2006	RLT	PROJ. ENGR. DAN		C				S927	
2	CONSTRUCTION	JAN 2004	RLT		THIS DOCUMENT ORIGINALLY ISSUED FOR CONSTRUCTION AND SEALED BY RONALD L. TAYLOR, SEAL NO. 024649 APPROVED _____	REGIONAL WATER POLLUTION CONTROL PLANT PROCESS TRAIN IMPROVEMENTS		STRUCTURAL SECTIONS AND DETAILS			
1	REGULATORY APPROVAL	NOV 2003	RLT								
NO.	ISSUED FOR	DATE	BY								