


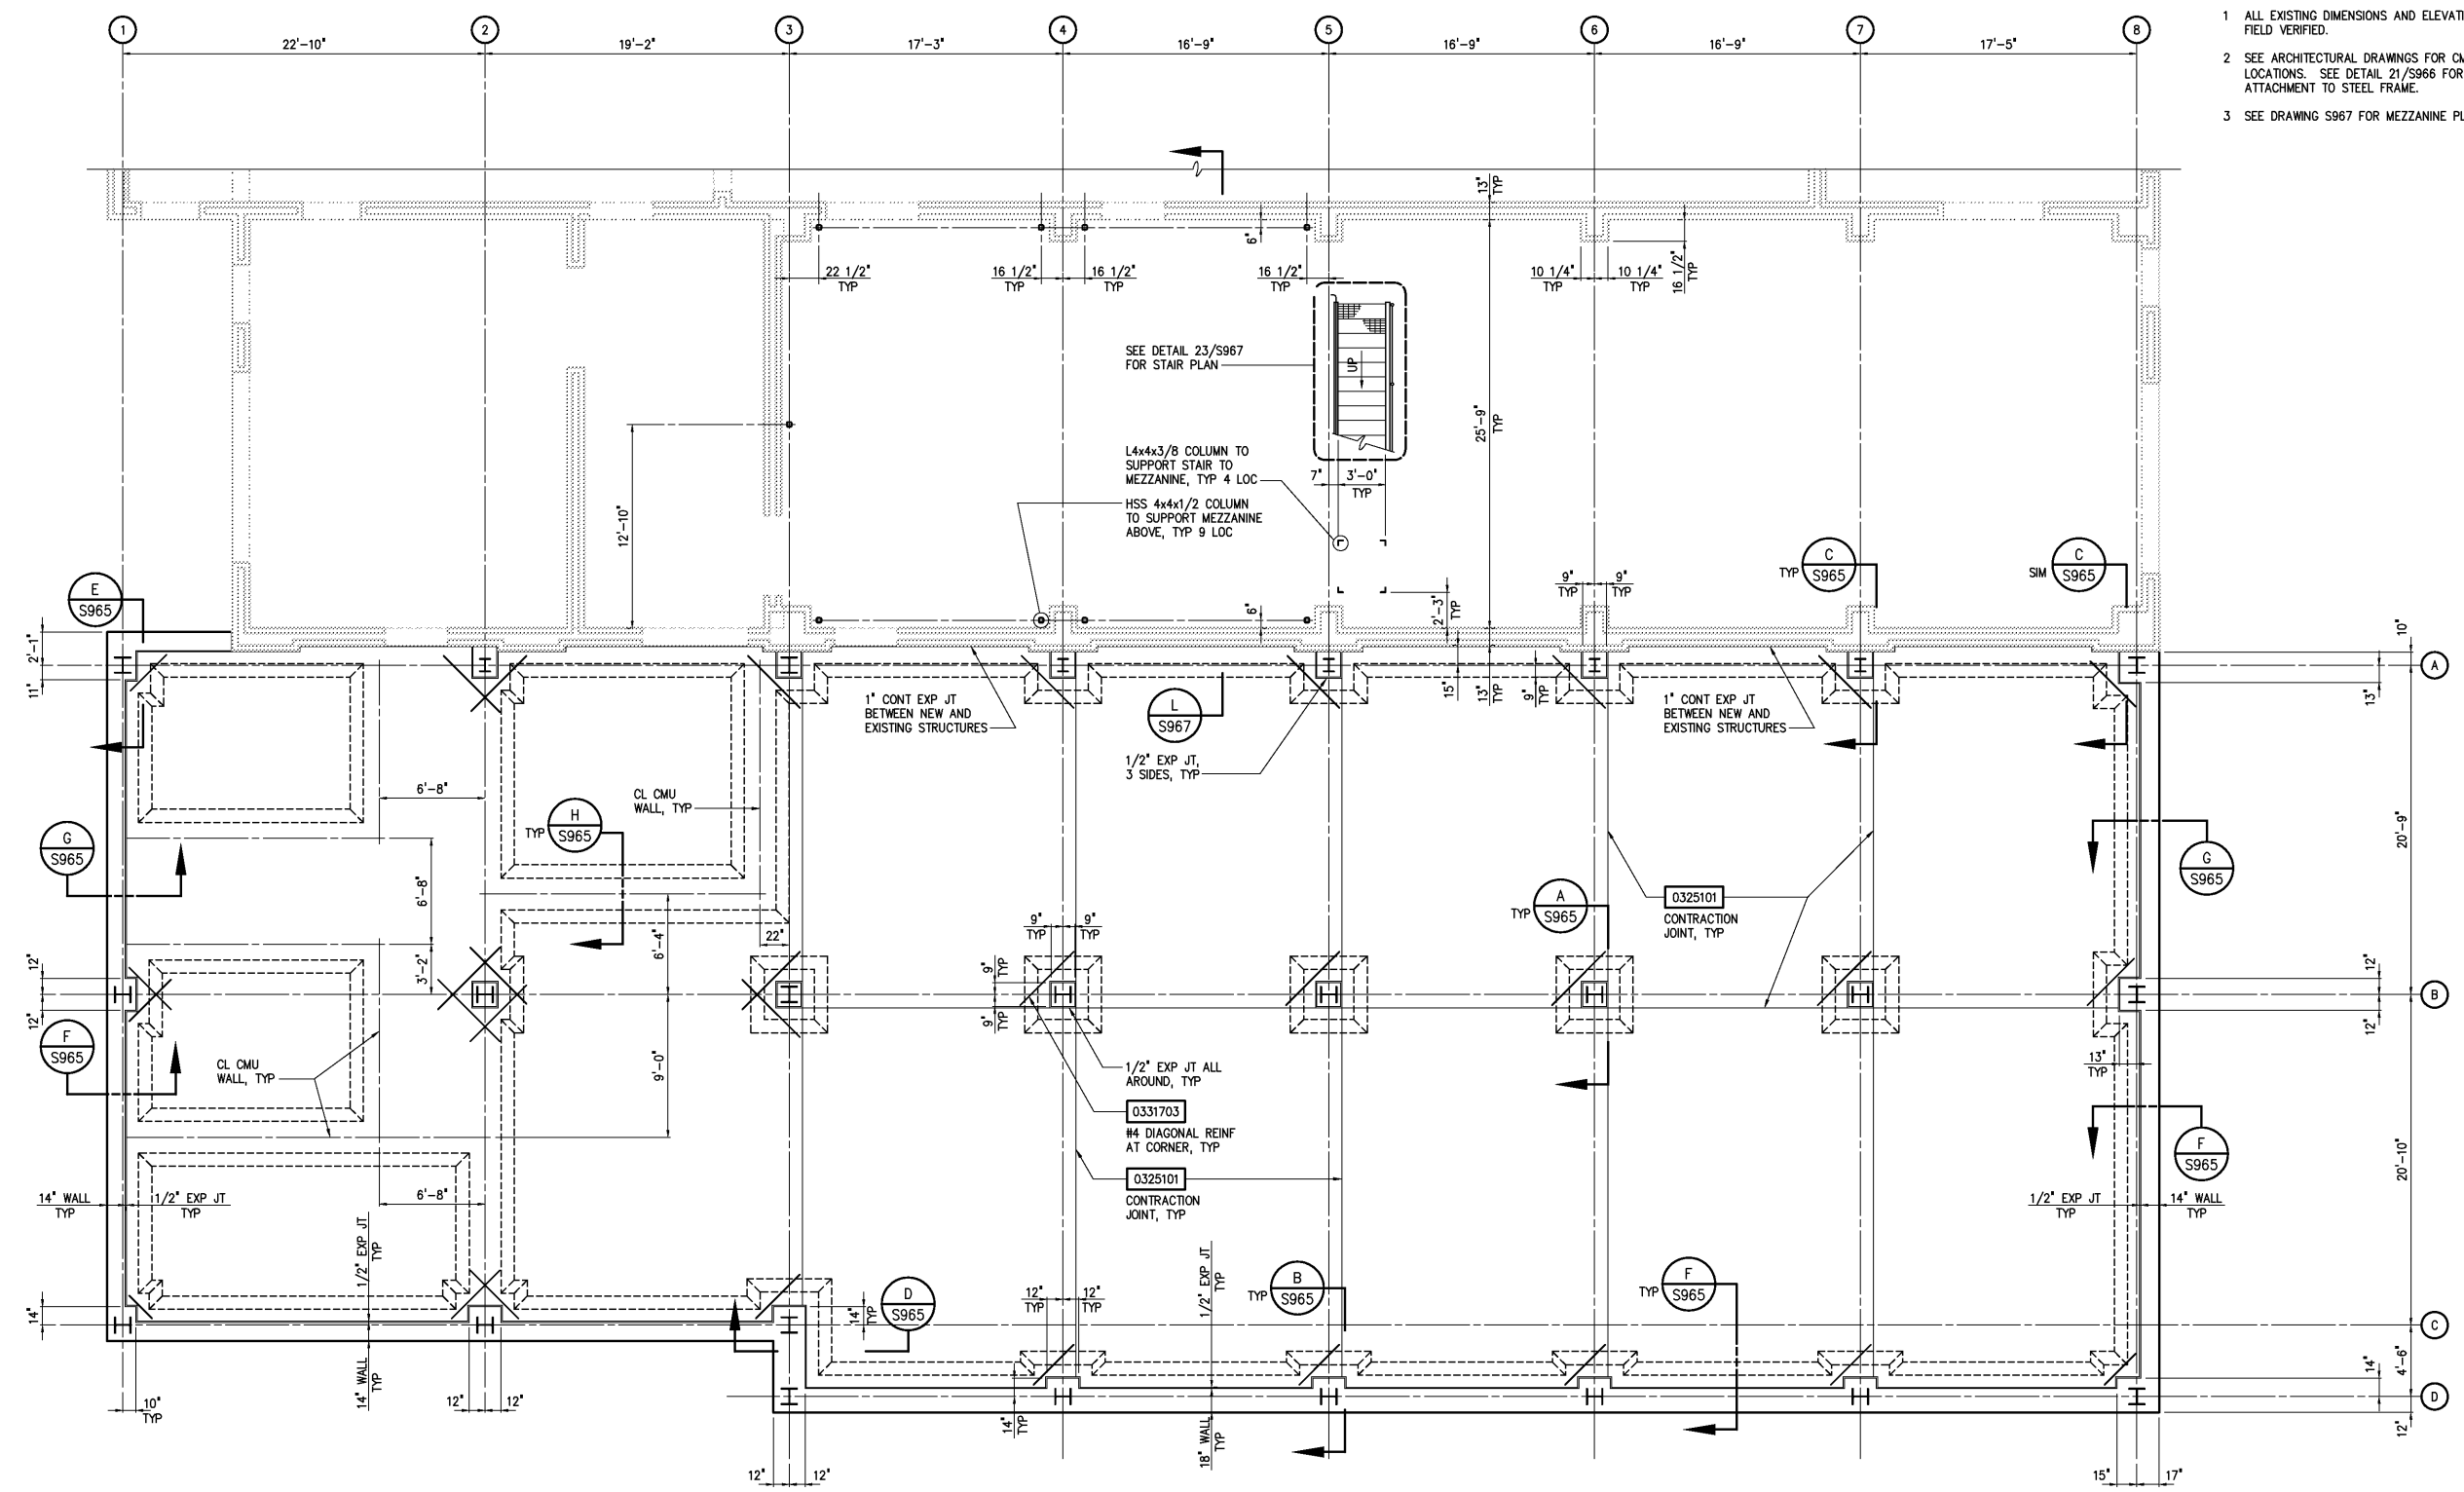

- NOTES:
- 1 ALL EXISTING DIMENSIONS AND ELEVATIONS TO BE FIELD VERIFIED.
 - 2 SEE ARCHITECTURAL DRAWINGS FOR CMU WALL LOCATIONS. SEE DETAIL 21/S966 FOR CMU ATTACHMENT TO STEEL FRAME.
 - 3 SEE DRAWING S967 FOR MEZZANINE PLAN.

BOTTOM PLAN
3/16"=1'-0"

				DESIGNED _____ BGS	RECORD DRAWING	THIS DOCUMENT ORIGINALLY ISSUED FOR CONSTRUCTION AND SEALED BY ROBERT S. DIFIORE, SEAL NO. 22769 THIS DRAWING HAS BEEN MODIFIED TO REFLECT FIELD CHANGES REPORTED BY THE CONTRACTOR OR ANOTHER PARTY, BUT NOT VERIFIED BY THE CERTIFYING ENGINEER. THIS DOCUMENT ORIGINALLY ISSUED AND SEALED BY CHRISTOPHER T. PHILLIPS, 033796. THIS MEDIA SHALL NOT BE CONSIDERED A CERTIFIED DOCUMENT.	HAZEN AND SAWYER Environmental Engineers & Scientists 4011 WestChase Blvd, Raleigh, North Carolina 27607	CITY OF ROANOKE VIRGINIA	REGIONAL WATER POLLUTION CONTROL PLANT PROCESS TRAIN IMPROVEMENTS	MAINTENANCE BUILDING MODIFICATIONS	THE SCALE BAR SHOWN BELOW MEASURES ONE INCH LONG ON THE ORIGINAL DRAWING.	DATE JANUARY 2004	
			DRAWN _____ BGS	H & S JOB NUMBER 30788C									
			CHECKED _____										
3	RECORD DRAWING	JAN 2006	RLT	PROJ. ENGR. _____ DAN	CONTRACT NUMBER C							DRAWING NUMBER S961	
2	CONSTRUCTION	JAN 2004	RLT	THIS DOCUMENT ORIGINALLY ISSUED FOR CONSTRUCTION AND SEALED BY RONALD L. TAYLOR, SEAL NO. 024649									
1	REGULATORY APPROVAL	NOV 2003	RLT										
NO.	ISSUED FOR	DATE	BY	APPROVED									

POST DATE 01/06/06 3:33pm FILE= H:\30788\30788C\STRU\961R by H&S\CHELOR 30788-30788C\961R 960\961-pb-a, 960\961-a-pl