




FOOTING TYPE F-1
SECTION A
1/2"=1'-0" S960

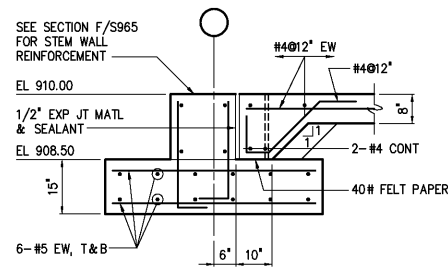


FOOTING TYPE F-2
SECTION B
1/2"=1'-0" S960

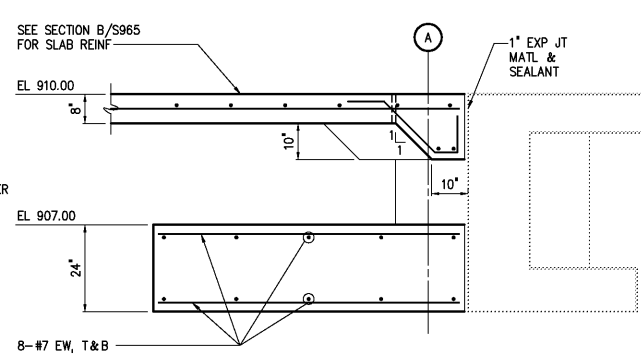


FOOTING TYPE F-3
SECTION C
1/2"=1'-0" S960

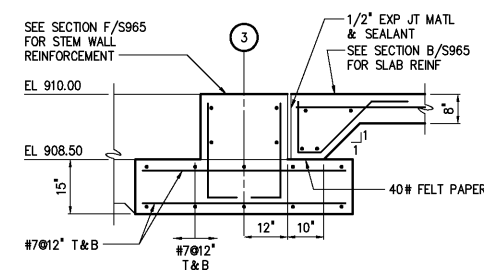


FOOTING TYPE F-4
SECTION D
1/2"=1'-0" S960

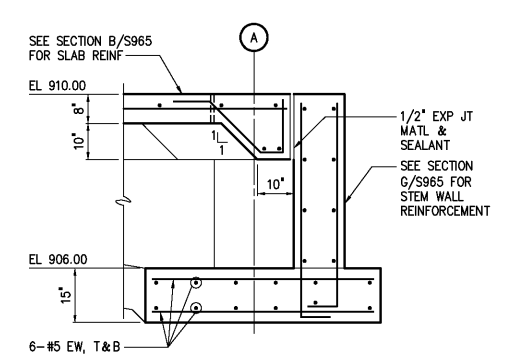


FOOTING TYPE F-5
SECTION E
1/2"=1'-0" S960

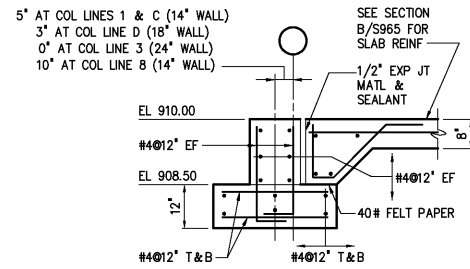


SECTION F
1/2"=1'-0" S960

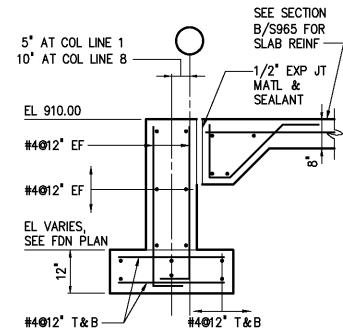


SECTION G
1/2"=1'-0" S960

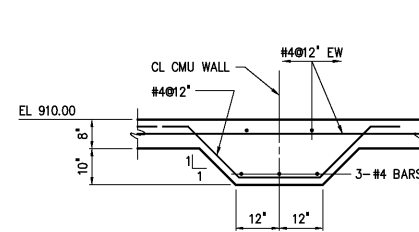


SECTION H
1/2"=1'-0" S961

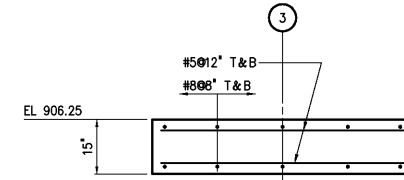


FOOTING TYPE F-6
SECTION Q
1/2"=1'-0" S960

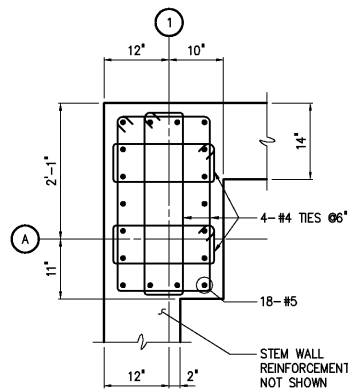


DETAIL 1
3/4"=1'-0" S960

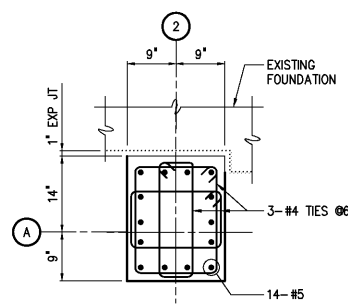


DETAIL 2
3/4"=1'-0" S960

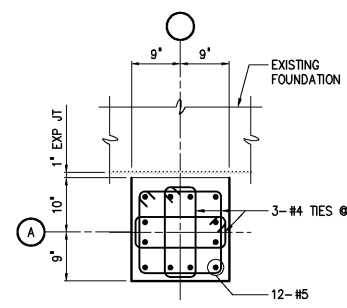


DETAIL 3
3/4"=1'-0" S960

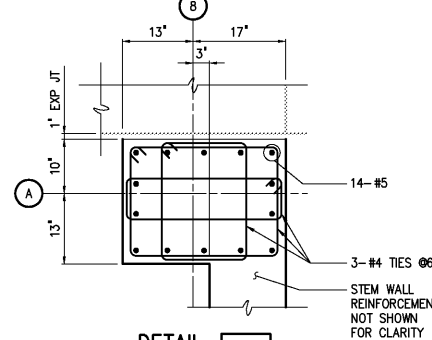


DETAIL 4
3/4"=1'-0" S960

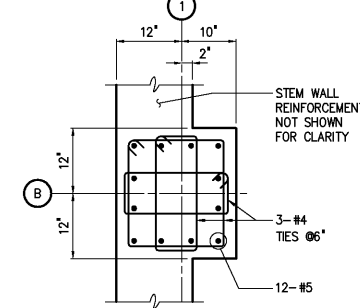


DETAIL 5
3/4"=1'-0" S960

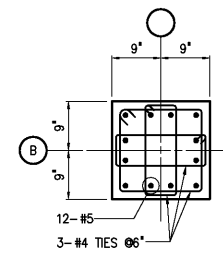


DETAIL 6
3/4"=1'-0" S960

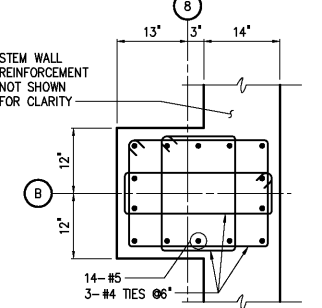


DETAIL 7
3/4"=1'-0" S960

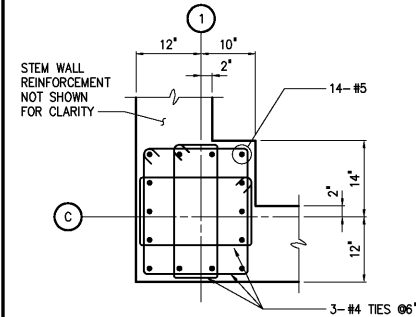


DETAIL 8
3/4"=1'-0" S960

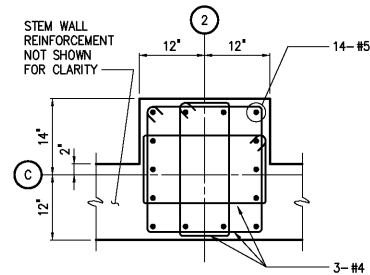


DETAIL 9
3/4"=1'-0" S960

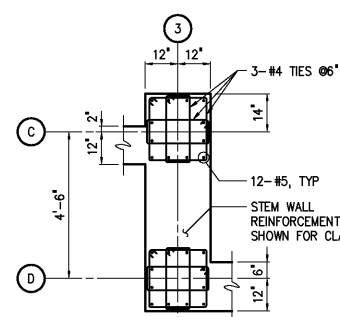


DETAIL 10
3/8"=1'-0" S960

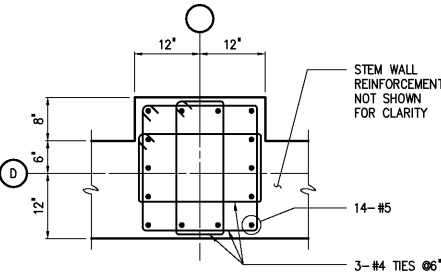


DETAIL 11
3/4"=1'-0" S960

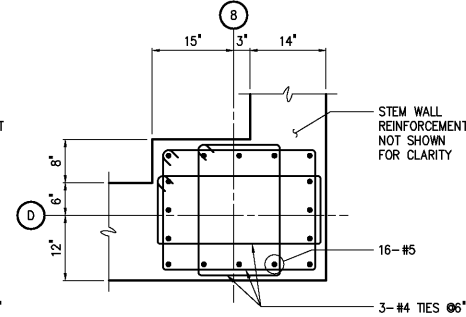

DETAIL 12
3/4"=1'-0" S960

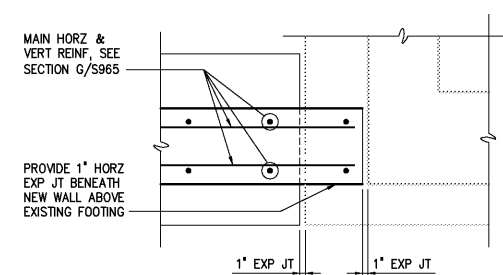

DETAIL 13
3/4"=1'-0" S960

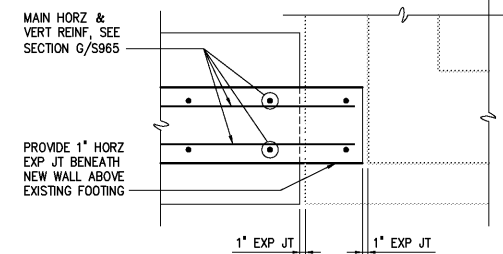

MAIN HORZ & VERT REINF, SEE SECTION G/S965
PROVIDE 1" HORZ EXP JT BENEATH NEW WALL ABOVE EXISTING FOOTING

DESIGNED	BGS
DRAWN	BGS
CHECKED	
PROJ. ENGR.	DAN
APPROVED	
NO.	
3	RECORD DRAWING
2	CONSTRUCTION
1	REGULATORY APPROVAL
NO.	ISSUED FOR
	DATE
	BY

THIS DOCUMENT ORIGINALLY ISSUED FOR CONSTRUCTION AND SEALED BY ROBERT S. DIFIORE, SEAL NO. 22759

THIS DOCUMENT ORIGINALLY ISSUED FOR CONSTRUCTION AND SEALED BY RONALD L. TAYLOR, SEAL NO. 024649

RECORD DRAWING

THIS DRAWING HAS BEEN MODIFIED TO REFLECT FIELD CHANGES REPORTED BY THE CONTRACTOR OR ANOTHER PARTY, BUT NOT VERIFIED BY THE CERTIFYING ENGINEER. THIS DOCUMENT ORIGINALLY ISSUED AND SEALED BY CHRISTOPHER T. PHILLIPS, 033796. THIS MEDIA SHALL NOT BE CONSIDERED A CERTIFIED DOCUMENT.

HAZEN AND SAWYER
Environmental Engineers & Scientists
4011 WestChase Blvd, Raleigh, North Carolina 27607

CITY OF ROANOKE
VIRGINIA

REGIONAL WATER POLLUTION CONTROL PLANT
PROCESS TRAIN IMPROVEMENTS

MAINTENANCE BUILDING MODIFICATIONS
STRUCTURAL
SECTIONS AND DETAILS

THE SCALE BAR SHOWN BELOW MEASURES ONE INCH LONG ON THE ORIGINAL DRAWING.	DATE	JANUARY 2004
	H & S JOB NUMBER	30788C
	CONTRACT NUMBER	C
	DRAWING NUMBER	S965