

DOOR SCHEDULE																		
NO.	FRAME		DOOR					DETAILS			GLAZING	LOUVER	FIRE LABEL	BSA LABEL	FINISH	HDWR NO	THRSHLD	REMARKS
	TYPE	MATL	TYPE	MATL	WIDTH	HEIGHT	THICKNESS	HEAD	JAMB	SILL								
OPERATIONS/ LABORATORY BUILDING-- SEE DRAWING A901																		
902	F-1	HM	D	WD	3'-0"	7'-0"	1 3/4"	5/A3	5/A3	5/A3	TG	--	--	--	STAIN	5	--	GLASS TO BE TRANSLUCENT;DET. SIM
905	F-1	AL	F	AL	3'-0"	7'-0"	1 3/4"	5/A3	5/A3	5/A3	TG	--	--	--	MFR	1	--	DOUBLE-ACTING ALUM STOREFRONT
906	SF-3	AL	F	AL	3'-0"	7'-0"	1 3/4"	MFR	MFR	MFR	TG	--	--	--	MFR	1	--	ALUMINUM STOREFRONT
ADMINISTRATION BUILDING -- SEE DRAWINGS A920 & A921																		
920	F-1	HM	A	WD	3'-0"	7'-0"	1 3/4"	8/A3	8/A3	8/A3	--	--	--	--	STAIN	8	--	--
921	F-1	HM	A	WD	3'-0"	7'-0"	1 3/4"	8/A3	8/A3	8/A3	--	--	--	--	STAIN	8	MARBLE	--
922	F-1	HM	A	WD	3'-0"	7'-0"	1 3/4"	8/A3	8/A3	8/A3	--	--	--	--	STAIN	8	--	--
923	F-1	HM	A	WD	2'-6"	7'-0"	1 3/4"	8/A3	8/A3	8/A3	--	--	--	--	STAIN	6	--	--
924	F-1	HM	A	WD	3'-0"	7'-0"	1 3/4"	8/A3	8/A3	8/A3	--	--	--	--	STAIN	8	MARBLE	--
925	F-1	HM	A	WD	3'-0"	7'-0"	1 3/4"	8/A3	8/A3	8/A3	--	--	--	--	STAIN	6	MARBLE	--
926	SF-1	HM	SF-1	HM	3'-0"	7'-0"	1 3/4"	9/A3	9/A3	9/A3	TG	--	--	--	MFR	3	AL	--
926A	SF-1	HM	SF-1	HM	3'-0"	7'-0"	1 3/4"	9/A3	9/A3	9/A3	TG	--	--	--	MFR	3	AL	--
926B	F-1	HM	A	WD	3'-0"	7'-0"	1 3/4"	8/A3	8/A3	8/A3	--	--	--	--	STAIN	5	REDUCER	--
927	F-1	HM	A	WD	3'-0"	7'-0"	1 3/4"	8/A3	8/A3	8/A3	--	--	--	--	STAIN	5	REDUCER	--
928	F-1	HM	C	WD	3'-0"	7'-0"	1 3/4"	8/A3	8/A3	8/A3	WG	--	1	--	STAIN	4	REDUCER	--
928A	SF-1	HM	SF-1	HM	3'-0"	7'-0"	1 3/4"	9/A3	9/A3	9/A3	TG	--	--	--	MFR	3	AL	--
929	F-1	HM	A	WD	3'-0"	7'-0"	1 3/4"	8/A3	8/A3	8/A3	--	--	--	--	STAIN	4	--	--
930	F-1	HM	A	WD	3'-0"	7'-0"	1 3/4"	8/A3	8/A3	8/A3	--	--	--	--	STAIN	10	REDUCER	PROVIDE STOREROOM LOCK FUNCTION
931	F-1	HM	A	WD	3'-0"	7'-0"	1 3/4"	8/A3	8/A3	8/A3	--	--	--	--	STAIN	10	REDUCER	PROVIDE STOREROOM LOCK FUNCTION
932	F-1	HM	A	WD	3'-0"	7'-0"	1 3/4"	8/A3	8/A3	8/A3	--	--	--	--	STAIN	6	REDUCER	--
934	SF-2	AL	SF-2	AL	(2) 3'-0"	7'-0"	1 3/4"	9/A3	9/A3	9/A3	TG	--	--	--	MFR	1	AL	ALUM STOREFRONT; DETAIL SIMILAR
936	F-1	HM	A	WD	3'-0"	7'-0"	1 3/4"	8/A3	8/A3	8/A3	--	--	--	--	STAIN	5	REDUCER	--
937	F-1	HM	D	WD	3'-0"	7'-0"	1 3/4"	8/A3	8/A3	8/A3	TG	--	--	--	STAIN	4	REDUCER	--
937A	F-1	WD	B	WD	5'-0"	7'-0"	1 3/4"	MFR	MFR	MFR	--	--	--	--	STAIN	1	REDUCER	ACCORDIAN DOOR
938	F-1	HM	A	WD	3'-0"	7'-0"	1 3/4"	8/A3	8/A3	8/A3	--	--	--	--	STAIN	6	--	--
939	F-1	HM	C	WD	3'-0"	7'-0"	1 3/4"	8/A3	8/A3	8/A3	WG	--	1	--	STAIN	4	REDUCER	--
939A	SF-1	HM	SF-1	HM	3'-0"	7'-0"	1 3/4"	9/A3	9/A3	9/A3	TG	--	--	--	MFR	3	AL	--
941	F-1	HM	A	WD	3'-0"	7'-0"	1 3/4"	8/A3	8/A3	8/A3	--	--	--	--	STAIN	4	--	--
941A	SF-1	HM	SF-1	HM	3'-0"	7'-0"	1 3/4"	9/A3	9/A3	9/A3	TG	--	--	--	MFR	3	AL	--
942	F-1	HM	A	HM	3'-0"	6'-8"	1 3/4"	8/A3	8/A3	8/A3	--	--	--	--	PT	10	--	PROVIDE STOREROOM LOCK FUNCTION
943	F-1	HM	A	WD	3'-0"	6'-8"	1 3/4"	8/A3	8/A3	8/A3	--	--	--	--	STAIN	10	REDUCER	PROVIDE STOREROOM LOCK FUNCTION
943A	F-1	HM	A	HM	3'-0"	5'-0"	1 3/4"	8/A3	8/A3	8/A3	--	--	--	--	PT	10	--	PROVIDE STOREROOM LOCK FUNCTION
943B	F-1	HM	A	HM	3'-0"	5'-0"	1 3/4"	8/A3	8/A3	8/A3	--	--	--	--	PT	10	--	PROVIDE STOREROOM LOCK FUNCTION
944	F-1	HM	A	WD	3'-0"	7'-0"	1 3/4"	8/A3	8/A3	8/A3	--	--	--	--	STAIN	7	MARBLE	--
945	F-1	HM	A	WD	3'-0"	7'-0"	1 3/4"	8/A3	8/A3	8/A3	--	--	--	--	STAIN	7	MARBLE	--
946	F-1	HM	C	WD	3'-0"	7'-0"	1 3/4"	8/A3	8/A3	8/A3	WG	--	1	--	STAIN	4	REDUCER	--
946A	F-1	HM	C	WD	3'-0"	7'-0"	1 3/4"	8/A3	8/A3	8/A3	WG	--	1	--	STAIN	4	REDUCER	--
947	F-1	HM	A	WD	3'-0"	7'-0"	1 3/4"	8/A3	8/A3	8/A3	--	--	--	--	STAIN	10	REDUCER	PROVIDE STOREROOM LOCK FUNCTION
948	F-1	HM	A	WD	3'-0"	7'-0"	1 3/4"	8/A3	8/A3	8/A3	--	--	--	--	STAIN	5	--	--
948A	F-1	HM	A	WD	3'-0"	6'-0"	1 3/4"	9/A3	9/A3	9/A3	--	--	--	--	STAIN	6	REDUCER	DETAILS SIMILAR
949	F-1	HM	A	WD	3'-0"	7'-0"	1 3/4"	8/A3	8/A3	8/A3	--	--	--	--	STAIN	6	REDUCER	--
950	F-1	HM	A	WD	(2) 3'-0"	7'-0"	1 3/4"	8/A3	8/A3	8/A3	--	--	--	--	STAIN	9	--	--
951	F-1	HM	A	WD	3'-0"	7'-0"	1 3/4"	8/A3	8/A3	8/A3	--	--	--	--	STAIN	5	--	--
952	F-1	HM	A	WD	3'-0"	7'-0"	1 3/4"	8/A3	8/A3	8/A3	--	--	--	--	STAIN	5	--	--
953	F-1	HM	A	WD	3'-0"	7'-0"	1 3/4"	8/A3	8/A3	8/A3	--	--	--	--	STAIN	5	--	--
953A	F-1	HM	A	WD	3'-0"	6'-0"	1 3/4"	9/A3	9/A3	9/A3	--	--	--	--	STAIN	6	REDUCER	DETAILS SIMILAR
MAINTENANCE BUILDING -- SEE DRAWING A961																		
960	F-3	HM	A	HM	3'-0"	7'-0"	1 3/4"	5/A3	5/A3	5/A3	--	--	--	--	PT	8	--	DETAILS SIMILAR
961	F-3	HM	A	HM	3'-0"	7'-0"	1 3/4"	6/A3	6/A3	6/A3	--	--	--	--	PT	8	MARBLE	--
962	F-3	HM	A	HM	3'-0"	7'-0"	1 3/4"	5/A3	5/A3	5/A3	--	--	--	--	PT	8	--	DETAILS SIMILAR
963	F-3	HM	A	HM	3'-0"	7'-0"	1 3/4"	6/A3	6/A3	6/A3	--	--	--	--	PT	8	MARBLE	--
964	F-3	HM	A	HM	3'-0"	7'-0"	1 3/4"	6/A3	6/A3	6/A3	--	--	--	--	PT	6	MARBLE	--
966	F-3	HM	A	HM	3'-0"	7'-0"	1 3/4"	6/A3	6/A3	6/A3	--	--	--	--	PT	4	AL	--
967	F-3	HM	C	HM	3'-0"	7'-0"	1 3/4"	6/A4	6/A4	6/A4	TG	--	--	--	PT	4	AL	--
968	F-3	HM	A	HM	3'-0"	7'-0"	1 3/4"	5/A3	5/A3	5/A3	--	--	--	--	PT	5	--	--
969	F-3	HM	A	HM	3'-0"	7'-0"	1 3/4"	5/A3	5/A3	5/A3	--	--	--	--	PT	5	--	--
969A	F-3	HM	D	HM	3'-0"	7'-0"	1 3/4"	5/A3	5/A3	5/A3	TG	--	--	--	PT	10	AL	--
969B	MFR	AL	E	AL	6'-0"	4'-3"	3/4"	70/A4	70/A4	70/A4	--	--	--	--	MFR	1	--	ROLLING COUNTER DOOR
970	F-3	AL	D	AL	3'-0"	7'-0"	1 3/4"	1/A3	1/A3	1/A3	TG	--	--	--	MFR	3	AL	--
972	F-3	HM	A	HM	3'-0"	7'-0"	1 3/4"	5/A3	5/A3	5/A3	--	--	--	--	PT	5	--	--
973	F-3	HM	A	HM	3'-0"	7'-0"	1 3/4"	5/A3	5/A3	5/A3	--	--	--	--	PT	5	--	--
974	MFR	STEEL	G	STEEL	4'-0"	8'-0"	3/4"	MFR	MFR	MFR	--	--	--	--	MFR	1	--	SLIDING GATE
975	F-3	HM	D	HM	3'-0"	7'-0"	1 3/4"	6/A3	6/A3	6/A3	TG	--	--	--	PT	3	AL	--
976	F-3	HM	D	HM	3'-0"	7'-0"	1 3/4"	5/A3	5/A3	5/A3	TG	--	--	--	PT	5	--	DETAILS SIMILAR
979	F-3	HM	D	HM	3'-0"	7'-0"	1 3/4"	5/A3	5/A3	5/A3	TG	--	--	--	PT	4	--	DETAILS SIMILAR
980	F-1	HM	D	HM	3'-4"	7'-0"	1 3/4"	5/A3	5/A3	5/A3	TG	--	--	--	PT	4	--	EXISTING OPENING; VERIFY SIZE
981	F-3	HM	D	HM	3'-0"	7'-0"	1 3/4"	5/A3	5/A3	5/A3	TG	--	--	--	PT	5	--	DETAILS SIMILAR
982	F-3	HM	A	HM	3'-0"	7'-0"	1 3/4"	5/A3	5/A3	5/A3	--	--	--	--	PT	6	--	DETAILS SIMILAR
983	F-3	HM	D	HM	3'-0"	7'-0"	1 3/4"	6/A3	6/A3	6/A3	TG	--	--	--	PT	4	--	--
984	F-4	AL	D	AL	3'-0"	7'-0"	1 3/4"	3/A3	1/A3	1/A3	TG	--	--	--	MFR	3	AL	36X32 LOUVER ABOVE
984A	MFR	STEEL	E	AL	10'-0"	10'-0"	3/4"	2/A3	2/A3	2/A3	--	--	--	--	MFR	1	--	ROLL-- UP DOOR
984B	F-4	AL	D	AL	(2) 3'-0"	7'-0"	1 3/4"	3/A3	1/A3	1/A3	TG	--	--	--	MFR	2	AL	72X32 LOUVER ABOVE
985	F-3	HM	A	HM	3'-0"	7'-0"	1 3/4"	5/A3	5/A3	5/A3	--	--	--	--	PT	6	--	DETAILS SIMILAR

SCHEDULE ABBREVIATIONS:

PT= PAINTED

FRP= FIBERGLASS REINFORCED POLYESTER LAMINATE

HM= HOLLOW METAL

AL= ALUMINUM

WD= WOOD


TG= TEMPERED GLASS

WG= WIRE GLASS


MFR= MANUFACTURER

DOOR TYPES 1/4" = 1'-0"


NOTES: GLASS SHALL BE 1/4" TEMPERED, EXCEPT FIRE RATED DOORS
WHICH SHALL BE 1/4" WIRE GLASS

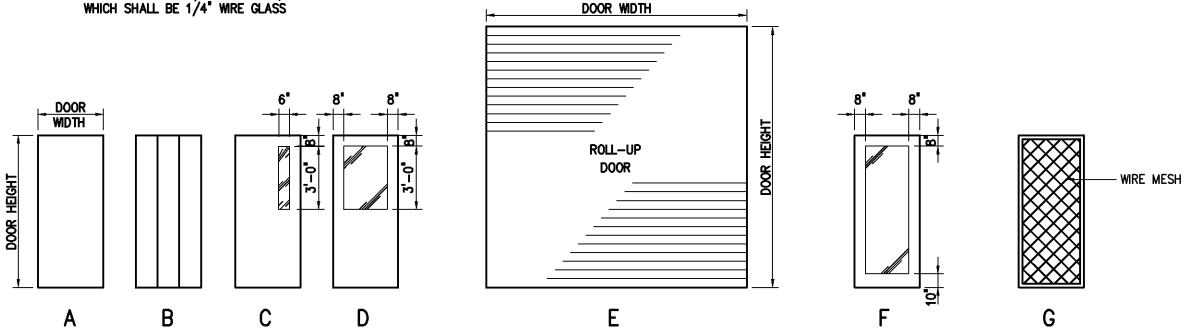


FRAME TYPES 1/4" = 1'-0"

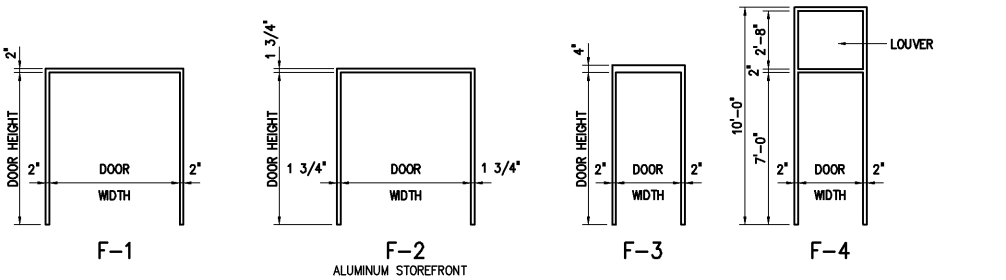

THRESHOLD TYPES 3" = 1'-0"

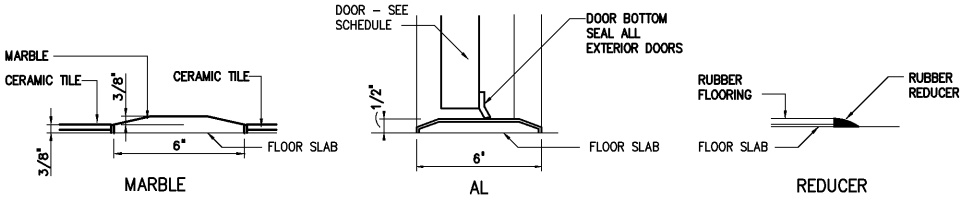

FRAME PROFILES 3" = 1'-0"

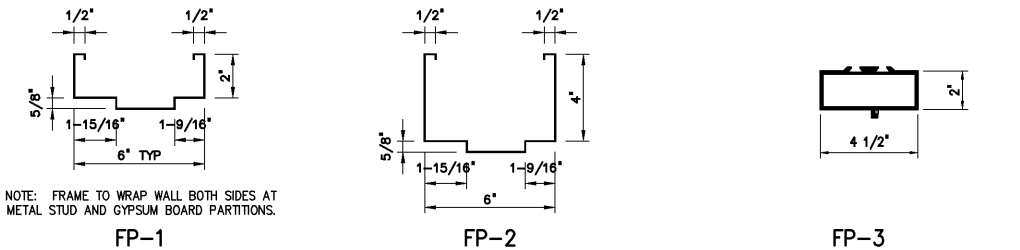

HOLLOW METAL FRAME PROFILES

STOREFRONT FRAME PROFILES

DESIGNED _____ WHR				RECORD DRAWING				CITY OF ROANOKE VIRGINIA				ARCHITECTURAL DOOR SCHEDULE AND DOOR TYPES				THE SCALE BAR SHOWN BELOW MEASURES ONE INCH LONG ON THE ORIGINAL DRAWING.		DATE JANUARY 2004 H & S JOB NUMBER 30788C	
DRAWN _____ ALB/DAW				CHECKED _____				REGIONAL WATER POLLUTION CONTROL PLANT PROCESS TRAIN IMPROVEMENTS										CONTRACT NUMBER C	
PROJ. ENGR. _____ DAN				APPROVED _____														DRAWING NUMBER A2	
NO. _____																			