




DETAIL 1
1 1/2"=1'-0" A3

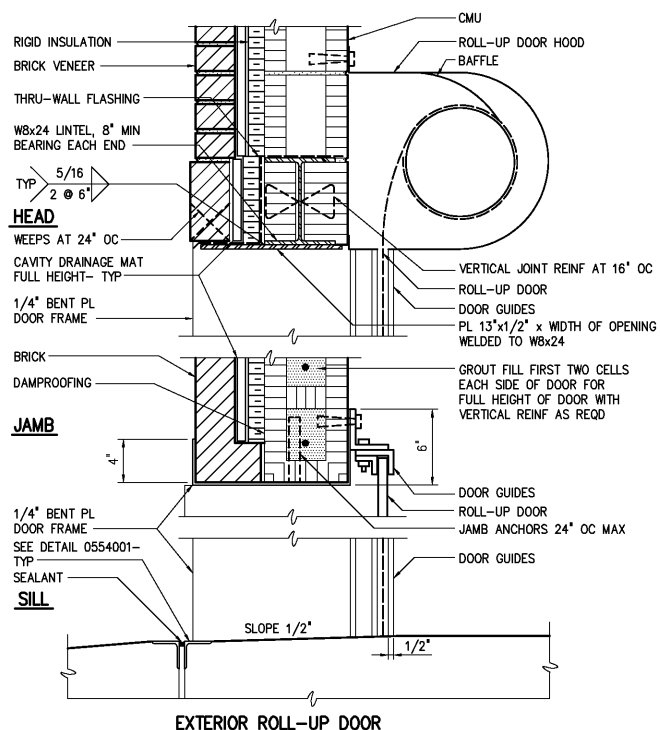

DETAIL 2
1 1/2"=1'-0" A3

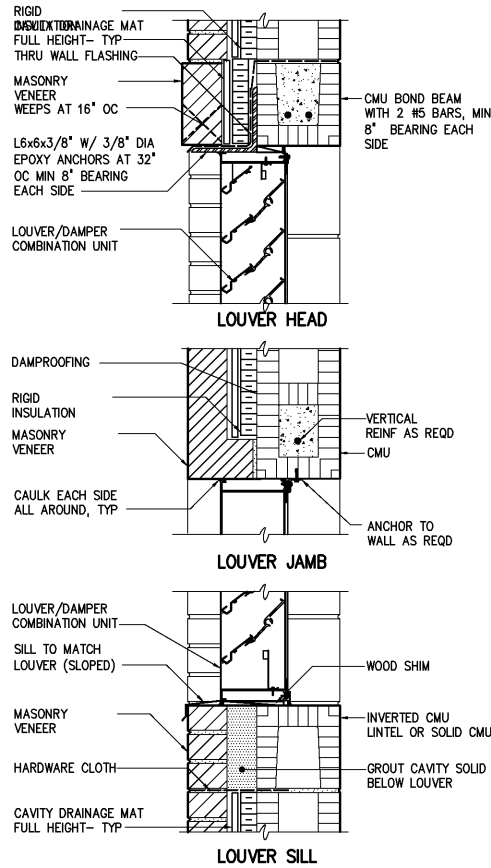


DETAIL 3
1 1/2"=1'-0" A3

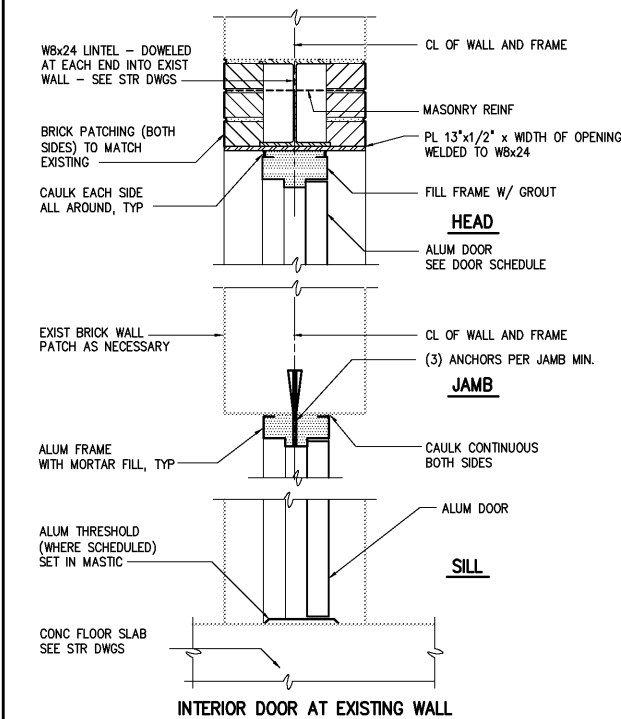


DETAIL 6
1 1/2"=1'-0" A3




DETAIL 8
1 1/2"=1'-0" A3

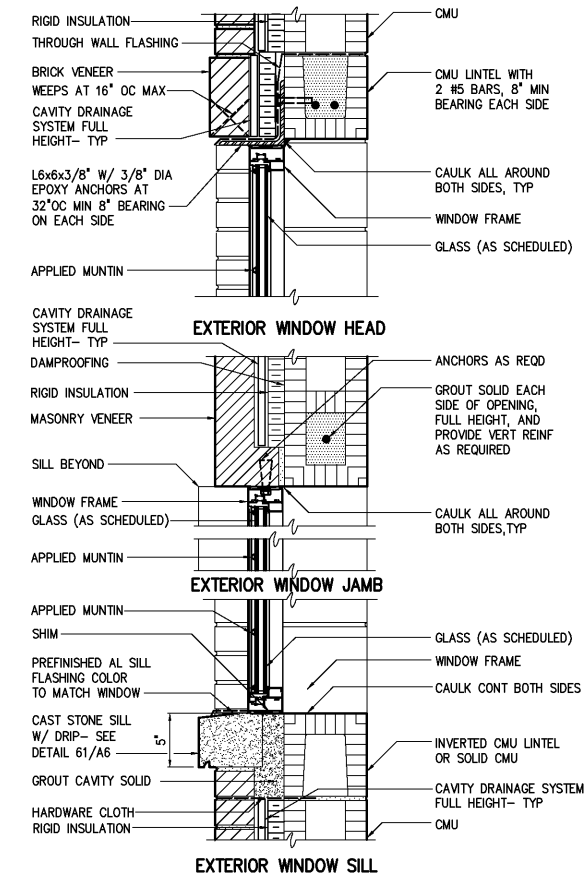


DETAIL 4
1 1/2"=1'-0" A3

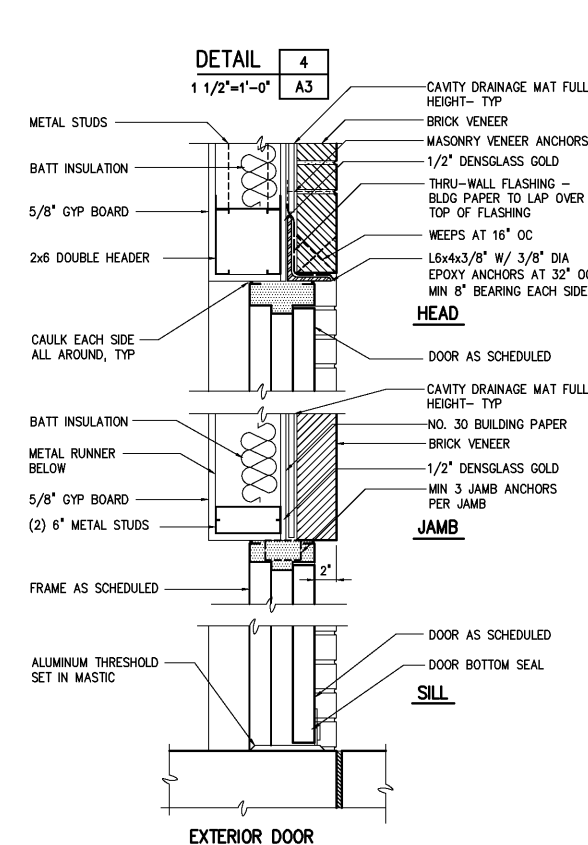

DETAIL 9
1 1/2"=1'-0" A3

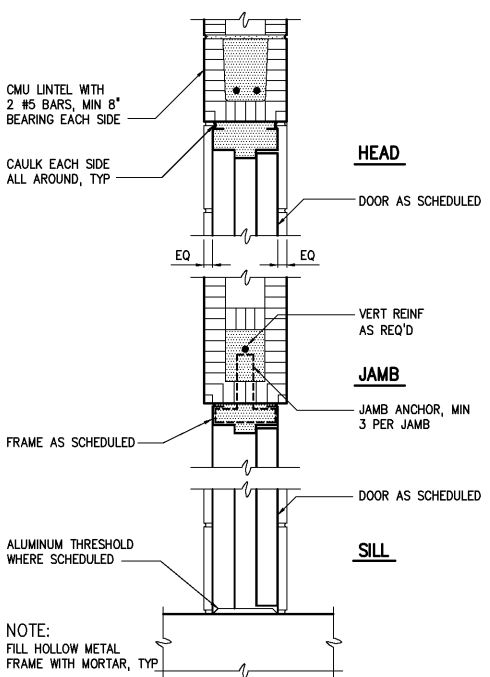

DETAIL 5
1 1/2"=1'-0" A3

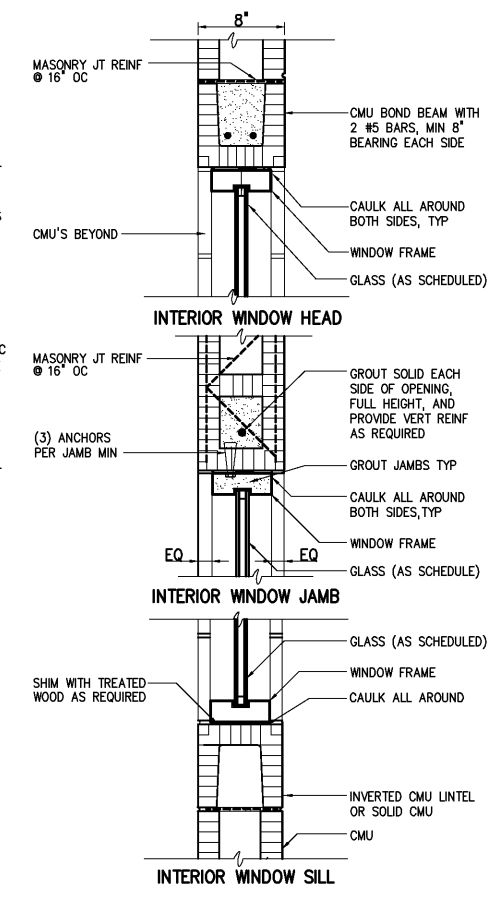

DETAIL 10
1 1/2"=1'-0" A3

				DESIGNED WHR	RECORD DRAWING		CITY OF ROANOKE VIRGINIA		ARCHITECTURAL		THE SCALE BAR SHOWN BELOW MEASURES ONE INCH LONG ON THE ORIGINAL DRAWING.		DATE JANUARY 2004	
				DRAWN ALB/LRU	THIS DRAWING HAS BEEN MODIFIED TO REFLECT FIELD CHANGES REPORTED BY THE CONTRACTOR OR ANOTHER PARTY, BUT NOT VERIFIED BY THE CERTIFYING ENGINEER. THIS DOCUMENT ORIGINALLY ISSUED AND SEALED BY WILLIAM H. RUSSELL, SEAL NUMBER 008532. THIS MEDIA SHALL NOT BE CONSIDERED A CERTIFIED DOCUMENT.		HAZEN AND SAWYER		REGIONAL WATER POLLUTION CONTROL PLANT PROCESS TRAIN IMPROVEMENTS		H & S JOB NUMBER 30788C		CONTRACT NUMBER C	
				CHECKED	THIS DOCUMENT ORIGINALLY ISSUED FOR CONSTRUCTION AND SEALED BY ROBERT S. DIFIORE, SEAL NO. 22769		Environmental Engineers & Scientists		DRAWING NUMBER A3					
				PROJ. ENGR. DAN	THIS DOCUMENT ORIGINALLY ISSUED FOR CONSTRUCTION AND SEALED BY RONALD L. TAYLOR, SEAL NO. 024649		4011 WestChase Blvd, Raleigh, North Carolina 27607							
				APPROVED										
3	RECORD DRAWING	JAN 2006	RLT											
2	CONSTRUCTION	JAN 2004	RLT											
1	REGULATORY APPROVAL	NOV 2003	RLT											
NO.	ISSUED FOR	DATE	BY											