



EXTERIOR WINDOW HEAD

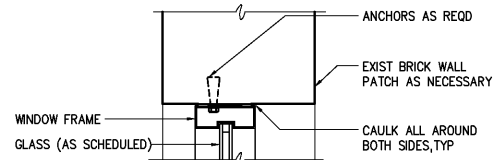


EXTERIOR WINDOW JAMB

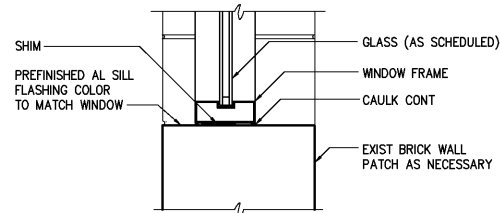


EXTERIOR WINDOW SILL


DETAIL 12
1 1/2"=1'-0" A4

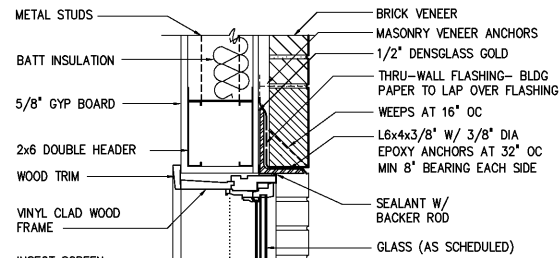

HEAD

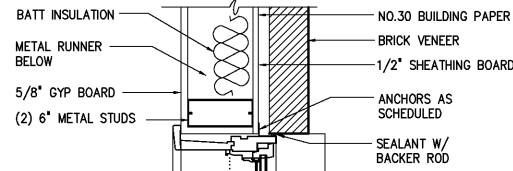


JAMB

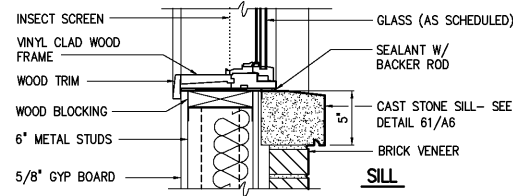


SILL

EXTERIOR WINDOW


DETAIL 13
1 1/2"=1'-0" A4

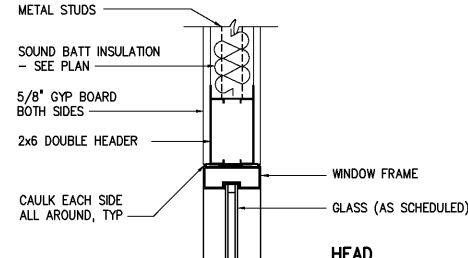

HEAD

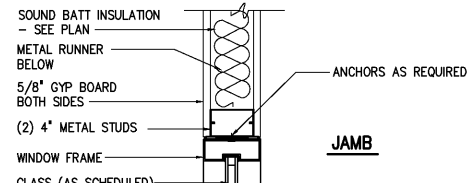


JAMB

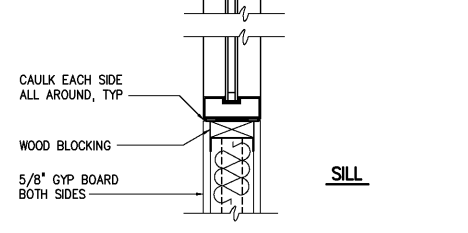

SILL

INTERIOR WINDOW


DETAIL 15
1 1/2"=1'-0" A4

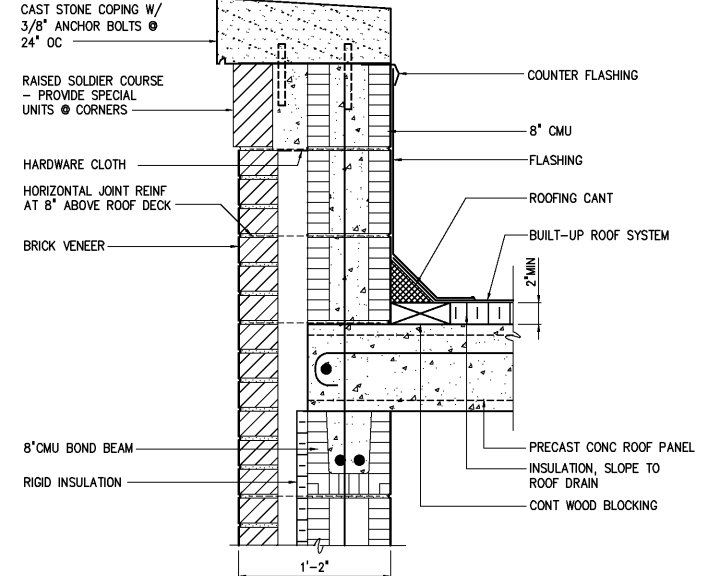

ALL ROOFING DETAILS SHALL BE IN
ACCORDANCE WITH MANUFACTURER'S RECOMMENDATIONS


PARAPET FLASHING

DETAIL 16
1 1/2"=1'-0" A4

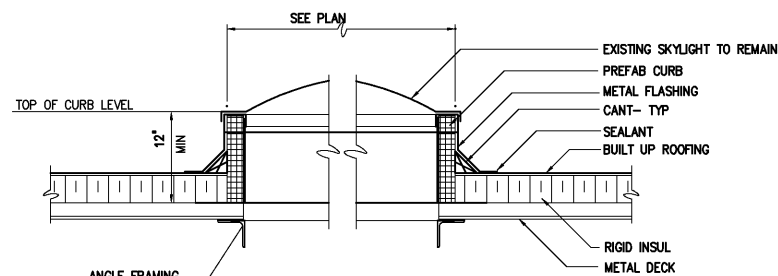


TYPICAL EXISTING SKYLIGHT

DETAIL 17
1 1/2"=1'-0" A4

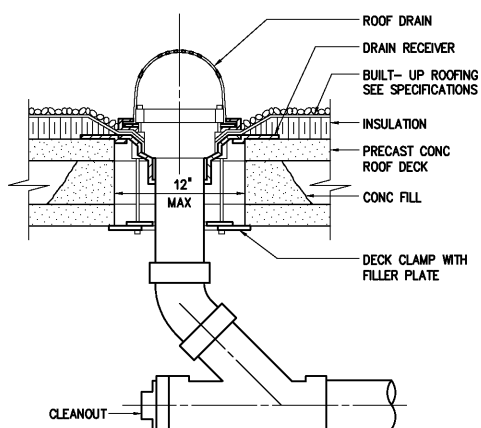

ROOF DRAIN


DETAIL 18
1 1/2" = 1'-0" A4

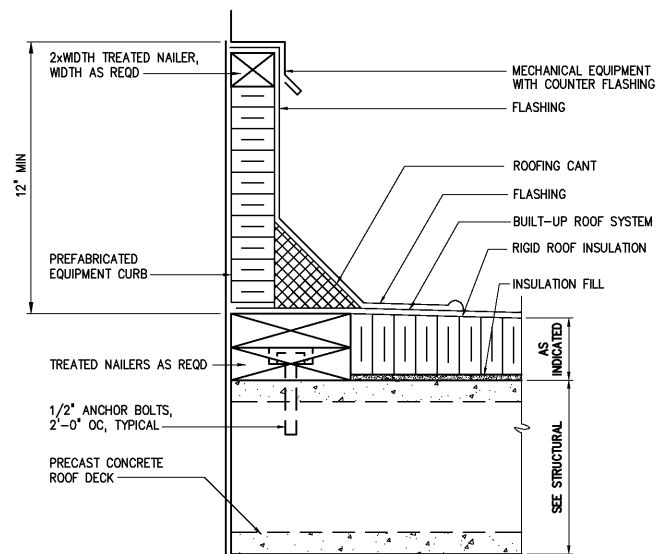

ALL ROOFING DETAILS SHALL BE IN
ACCORDANCE WITH MANUFACTURER'S RECOMMENDATIONS

EQUIPMENT CURB


DETAIL 19
1 1/2" = 1'-0" A4

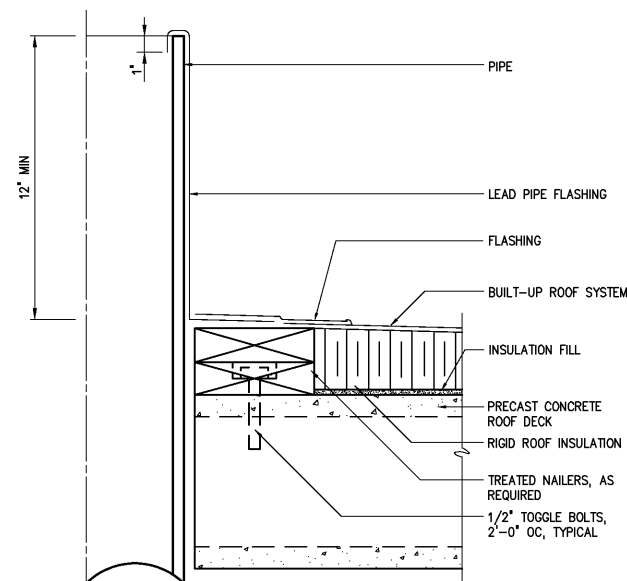


ALL ROOFING DETAILS SHALL BE IN
ACCORDANCE WITH MANUFACTURER'S RECOMMENDATIONS

PIPE THRU ROOF


DETAIL 20
1 1/2" = 1'-0" A4

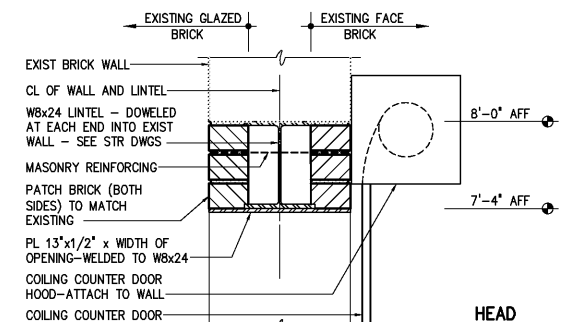

HEAD

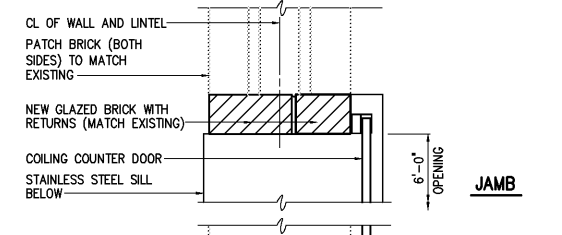

JAMB

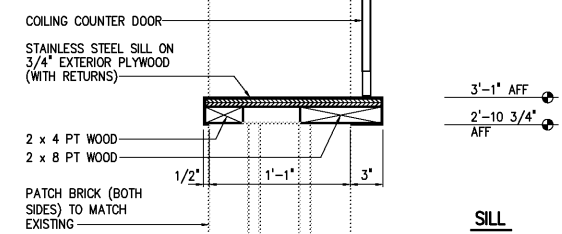

SILL

COILING COUNTER DOOR

DETAIL 70
1 1/2" = 1'-0" A4

3	RECORD DRAWING	JAN 2006	RLT	DESIGNED	WHR
2	CONSTRUCTION	JAN 2004	RLT	DRAWN	ALB/DAW
1	REGULATORY APPROVAL	NOV 2003	RLT	CHECKED	
NO.	ISSUED FOR	DATE	BY	PROJ. ENGR.	DAN
				APPROVED	

THIS DOCUMENT ORIGINALLY ISSUED
FOR CONSTRUCTION AND SEALED BY
ROBERT S. DIFIORE, SEAL NO. 22769

THIS DOCUMENT ORIGINALLY ISSUED
FOR CONSTRUCTION AND SEALED BY
RONALD L. TAYLOR, SEAL NO. 024649

RECORD DRAWING

THIS DRAWING HAS BEEN MODIFIED TO REFLECT FIELD
CHANGES REPORTED BY THE CONTRACTOR OR ANOTHER
PARTY, BUT NOT VERIFIED BY THE CERTIFYING ENGINEER.
THIS DOCUMENT ORIGINALLY ISSUED AND SEALED BY
WILLIAM H. RUSSELL, SEAL NUMBER 008532. THIS MEDIA
SHALL NOT BE CONSIDERED A CERTIFIED DOCUMENT.

HAZEN AND SAWYER
Environmental Engineers & Scientists
4011 WestChase Blvd, Raleigh, North Carolina 27607

CITY OF ROANOKE
VIRGINIA
REGIONAL WATER POLLUTION CONTROL PLANT
PROCESS TRAIN IMPROVEMENTS

ARCHITECTURAL
MISCELLANEOUS DETAILS

THE SCALE BAR SHOWN BELOW MEASURES ONE INCH LONG ON THE ORIGINAL DRAWING.	DATE JANUARY 2004
H & S JOB NUMBER CONTRACT NUMBER C	30788C DRAWING NUMBER A4