


**NOTES:**

1. DIMENSIONS GIVEN ARE TO NOMINAL FACE OF MASONRY.
2. ALL INTERIOR WALLS SHALL BE PARTITION TYPE A, UNLESS NOTED OTHERWISE. SEE SHEET A6 FOR PARTITION TYPES.
3. PROVIDE 1-HOUR RATED ENCLOSURE AT TOP OF AND BOTTOM OF RATED SHAFT.

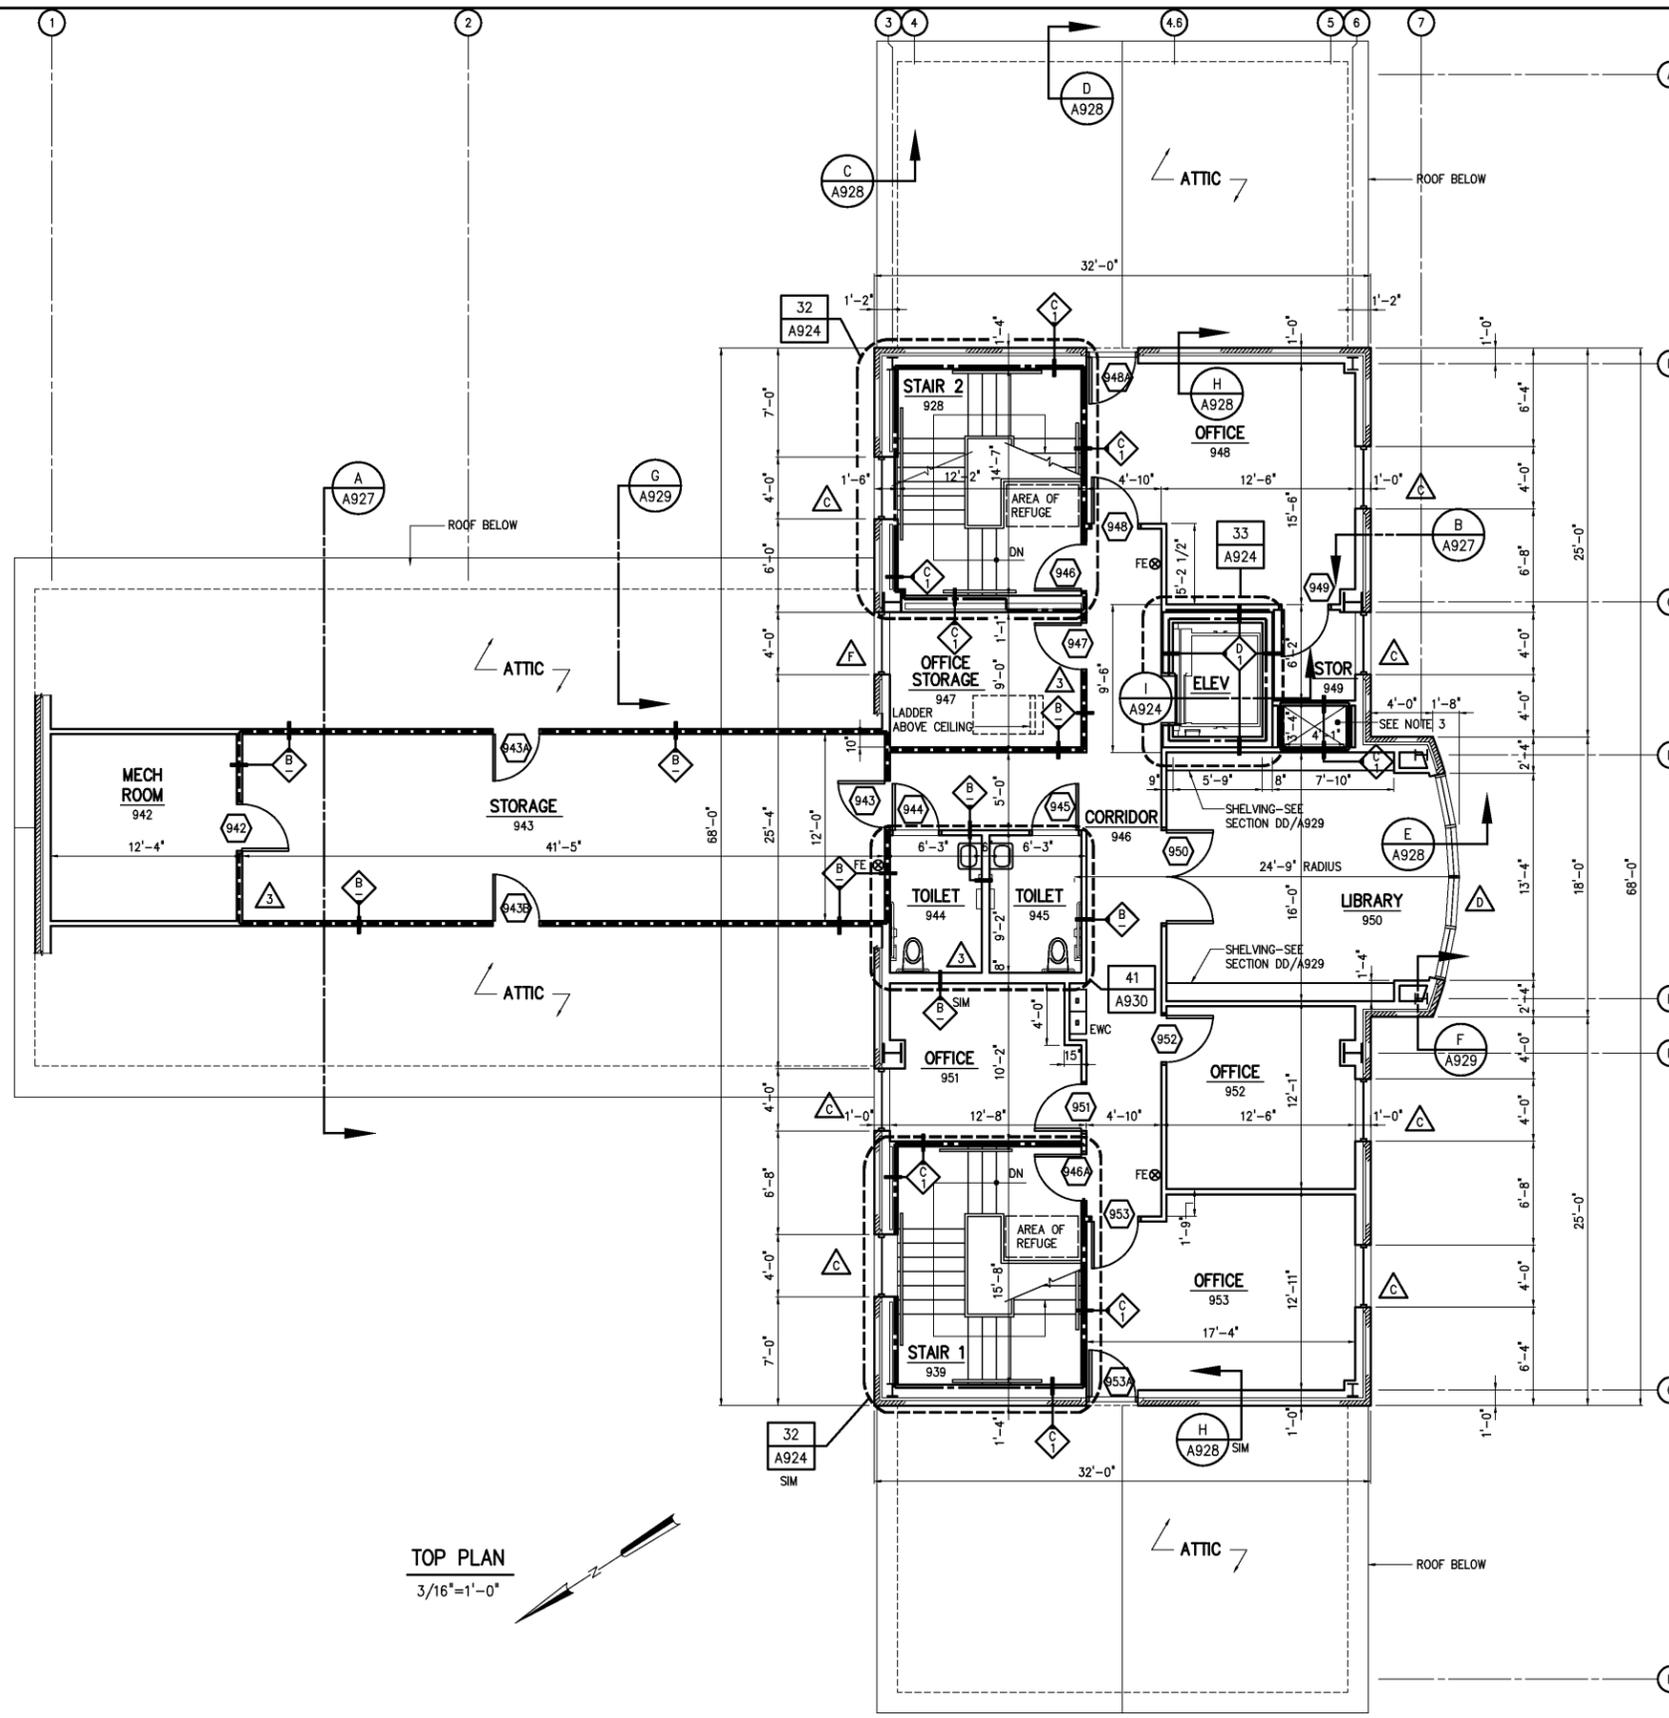

TOP PLAN  
3/16" = 1'-0"

**LEGEND:**

- 1-HOUR RATED WALL
- SMOKE PARTITION-SEE PARTITION TYPE B

DESIGNED	LU
DRAWN	ALB
CHECKED	
PROJ. ENGR.	H & S
APPROVED	

THIS DOCUMENT ORIGINALLY ISSUED FOR CONSTRUCTION AND SEALED BY ROBERT S. DIFIORE, SEAL NO. 22769

**RECORD DRAWING**

THIS DRAWING HAS BEEN MODIFIED TO REFLECT FIELD CHANGES REPORTED BY THE CONTRACTOR OR ANOTHER PARTY, BUT NOT VERIFIED BY THE CERTIFYING ENGINEER. THIS DOCUMENT ORIGINALLY ISSUED AND SEALED BY WILLIAM H. RUSSELL, SEAL NUMBER 008532. THIS MEDIA SHALL NOT BE CONSIDERED A CERTIFIED DOCUMENT.

THIS DOCUMENT ORIGINALLY ISSUED FOR CONSTRUCTION AND SEALED BY RONALD L. TAYLOR, SEAL NO. 024649

**HAZEN AND SAWYER**  
Environmental Engineers & Scientists  
4011 WestChase Blvd, Raleigh, North Carolina 27607

**CITY OF ROANOKE**  
VIRGINIA  
REGIONAL WATER POLLUTION CONTROL PLANT  
PROCESS TRAIN IMPROVEMENTS

ADMINISTRATION BUILDING  
ARCHITECTURAL  
TOP PLAN

THE SCALE BAR SHOWN BELOW MEASURES ONE INCH LONG ON THE ORIGINAL DRAWING.	DATE	JANUARY 2004
	H & S JOB NUMBER	30788C
	CONTRACT NUMBER	C
	DRAWING NUMBER	A921