



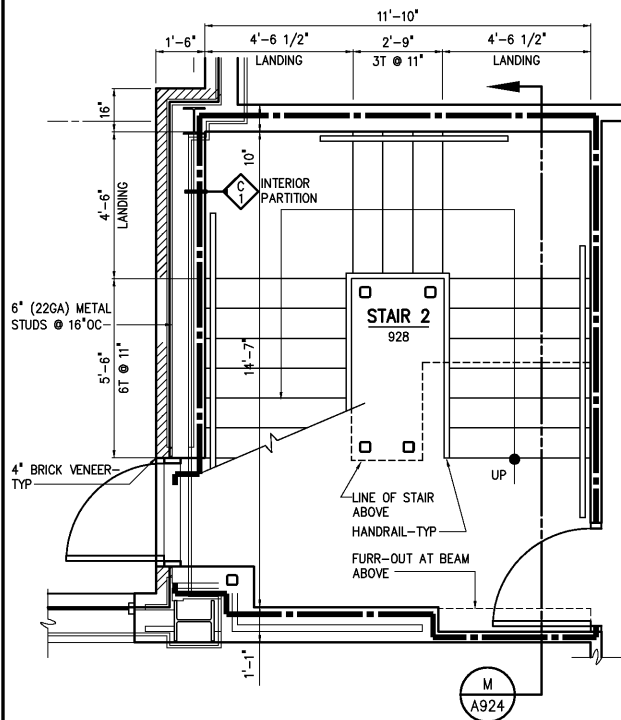


TYPICAL STAIR - BOTTOM PLAN

DETAIL 31
3/8"=1'-0" A920

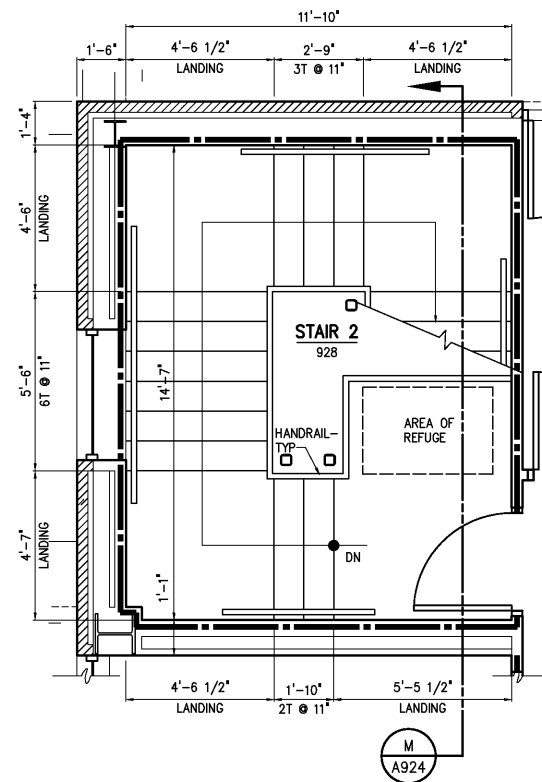


TYPICAL STAIR - TOP PLAN

DETAIL 32
3/8"=1'-0" A921

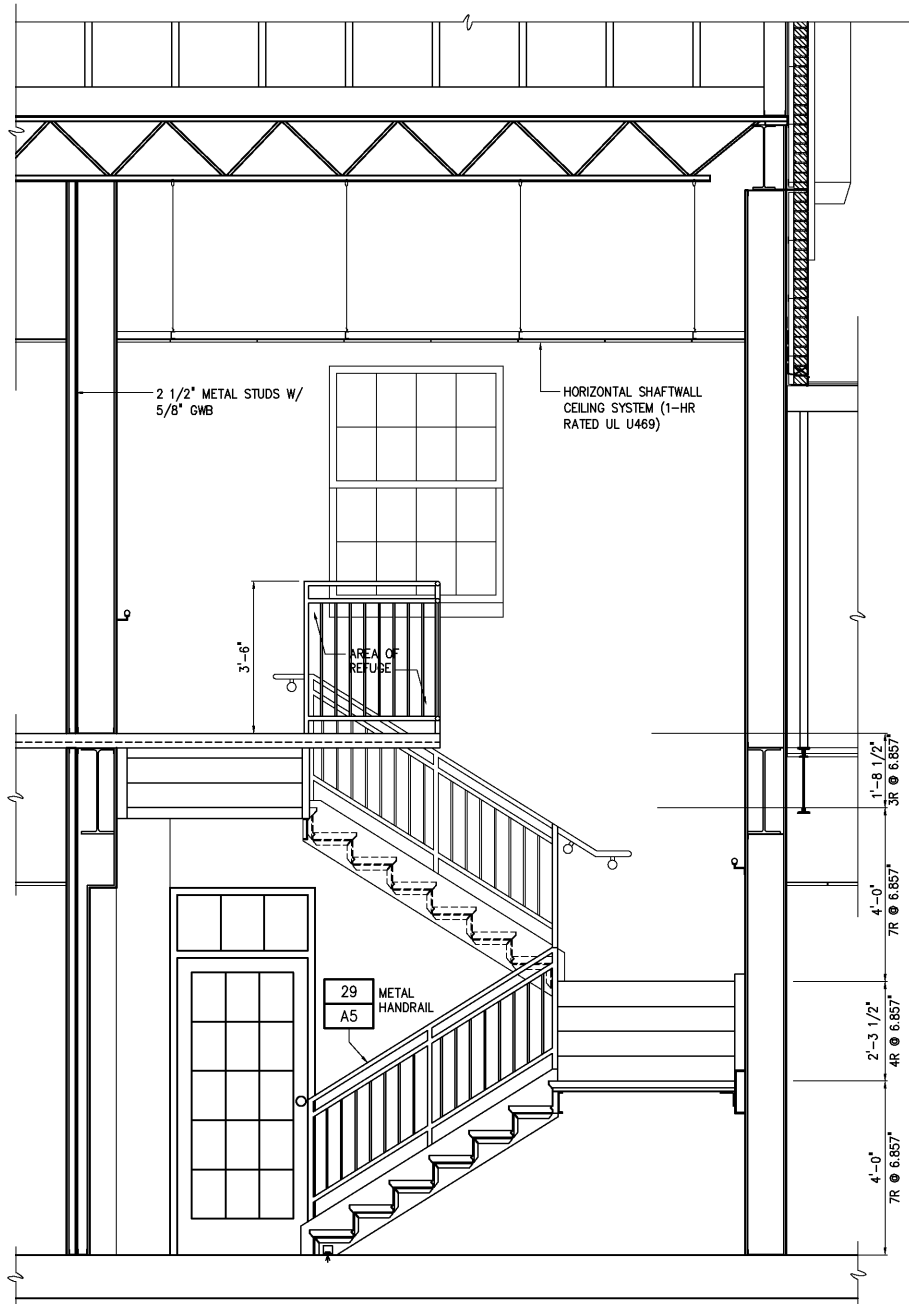


TYPICAL STAIR

SECTION M
1/2"=1'-0" A924

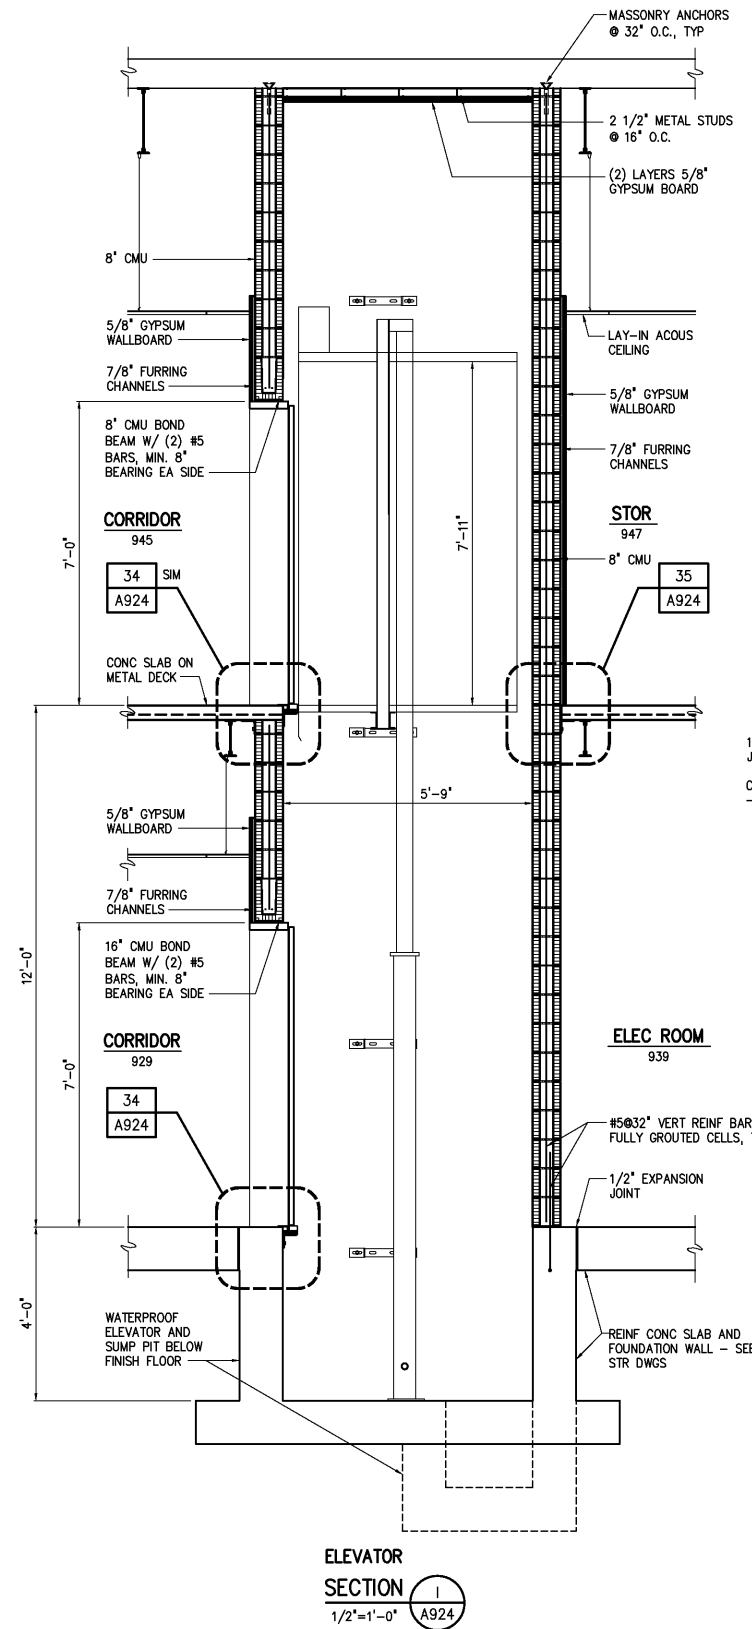


ELEVATOR

SECTION I
1/2"=1'-0" A924

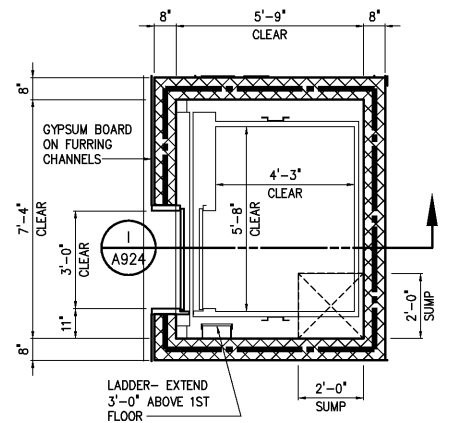


ELEVATOR PLAN

DETAIL 33
3/8"=1'-0" A920

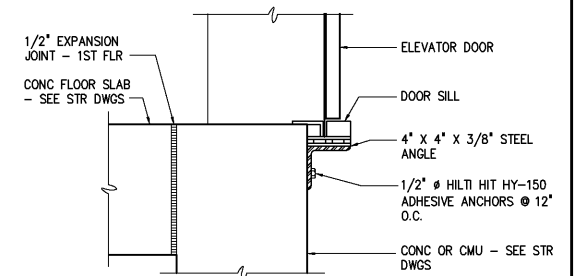

DETAIL 34
1 1/2"=1'-0" A924

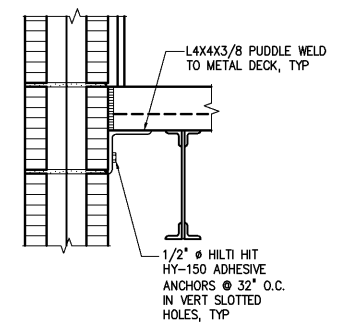

DETAIL 35
1 1/2"=1'-0" A924

3	RECORD DRAWING	JAN 2006	RLT	DESIGNED	LU
2	CONSTRUCTION	JAN 2004	RLT	DRAWN	ALB
1	REGULATORY APPROVAL	NOV 2003	RLT	CHECKED	
NO.	ISSUED FOR	DATE	BY	PROJ. ENGR.	H & S
				APPROVED	

THIS DOCUMENT ORIGINALLY ISSUED FOR CONSTRUCTION AND SEALED BY ROBERT S. DIFIORE, SEAL NO. 22769

RECORD DRAWING

THIS DRAWING HAS BEEN MODIFIED TO REFLECT FIELD CHANGES REPORTED BY THE CONTRACTOR OR ANOTHER PARTY, BUT NOT VERIFIED BY THE CERTIFYING ENGINEER. THIS DOCUMENT ORIGINALLY ISSUED AND SEALED BY WILLIAM H. RUSSELL, SEAL NUMBER 008532. THIS MEDIA SHALL NOT BE CONSIDERED A DESIGN DOCUMENT.

THIS DOCUMENT ORIGINALLY ISSUED FOR CONSTRUCTION AND SEALED BY RONALD L. TAYLOR, SEAL NO. 024649

HAZEN AND SAWYER
Environmental Engineers & Scientists
4011 WestChase Blvd, Raleigh, North Carolina 27607

CITY OF ROANOKE
VIRGINIA
REGIONAL WATER POLLUTION CONTROL PLANT
PROCESS TRAIN IMPROVEMENTS

ADMINISTRATION BUILDING
ARCHITECTURAL
STAIR AND ELEVATOR PLANS AND DETAILS

THE SCALE BAR SHOWN BELOW MEASURES ONE INCH LONG ON THE ORIGINAL DRAWING.	DATE	JANUARY 2004
	H & S JOB NUMBER	30788C
	CONTRACT NUMBER	C
	DRAWING NUMBER	A924