




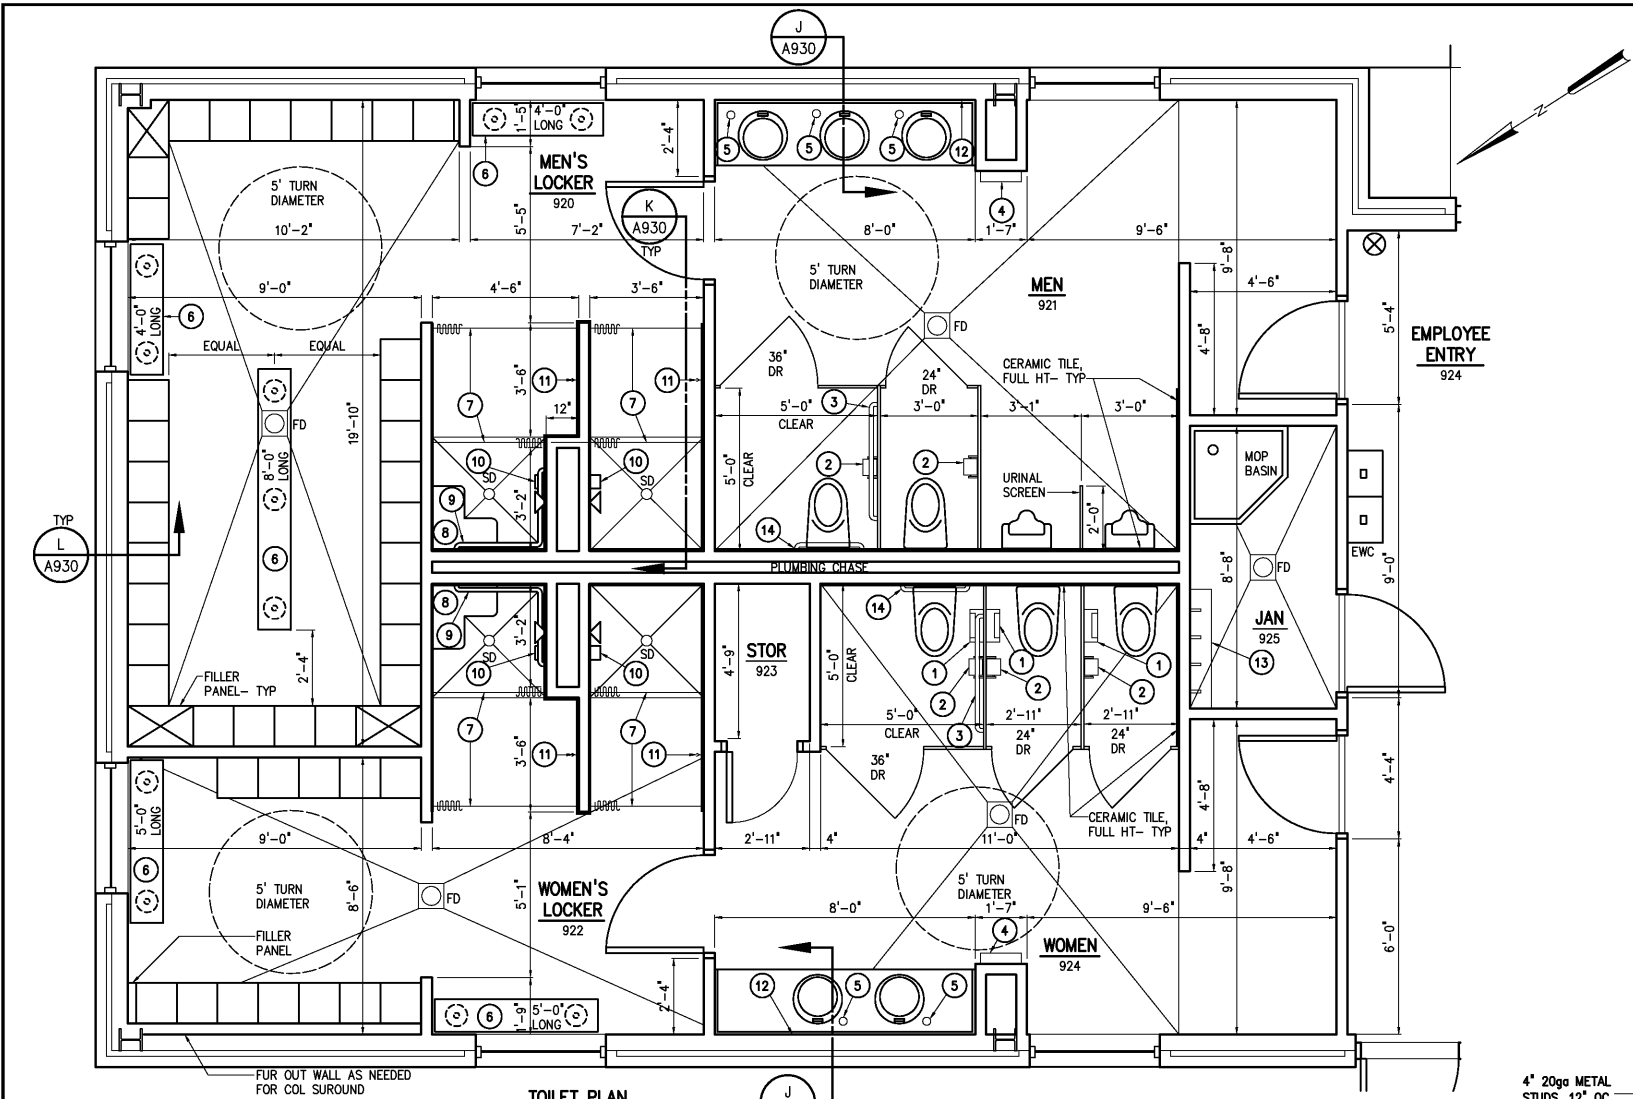

TOILET PLAN
DETAIL 40
3/8"=1'-0" A930

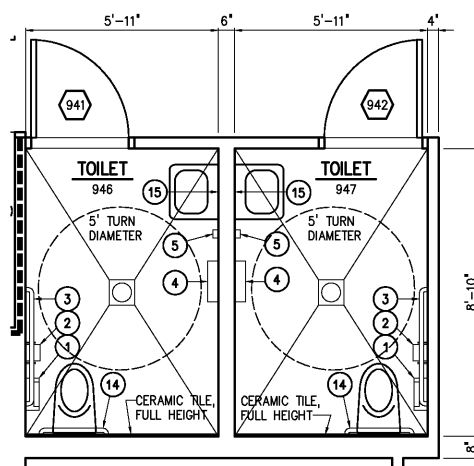


TOILET PLAN
DETAIL 41
3/8"=1'-0" A930

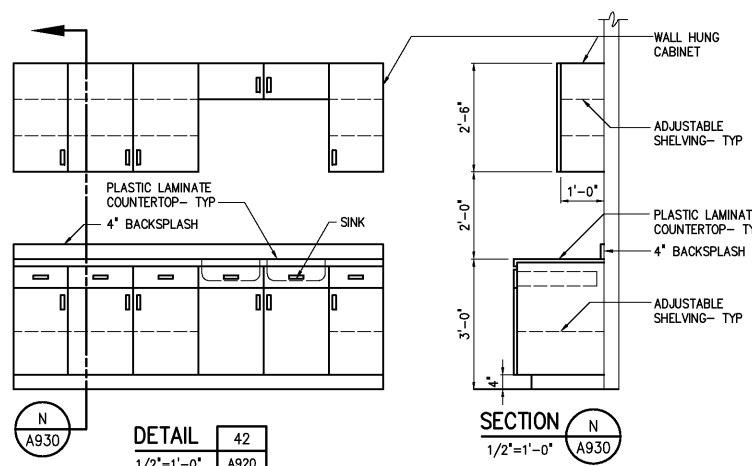


DETAIL 42
1/2"=1'-0" A920
SECTION N
1/2"=1'-0" A930


TOILET ACCESSORY SCHEDULE		
No	DESCRIPTION	MTG. HEIGHT
1	SANITARY NAPKIN DISPOSAL	TOP AT 34"
2	TOILET TISSUE DISPENSER	CENTER AT 19"
3	42" GRAB BAR	33" TO 36"
4	PAPER TOWEL DISPENSER AND DISPOSAL	40" TO DISPENSER
5	SOAP DISPENSER	40"
6	12" WIDE OAK BENCH	18"
7	SHOWER CURTAIN AND ROD	80"
8	FOLDING SHOWER SEAT	18"
9	SHOWER GRAB BAR	33" - 36"
10	SOAP DISH	40"
11	ROBE HOOK	54"
12	MIRROR FULL WIDTH OF COUNTER TOP 48" HIGH	---
13	SHELF WITH MOP AND BROOM HOLDER	66" TO SHELF
14	24" GRAB BAR	33" TO 36"
15	24" X 36" MIRROR	40"

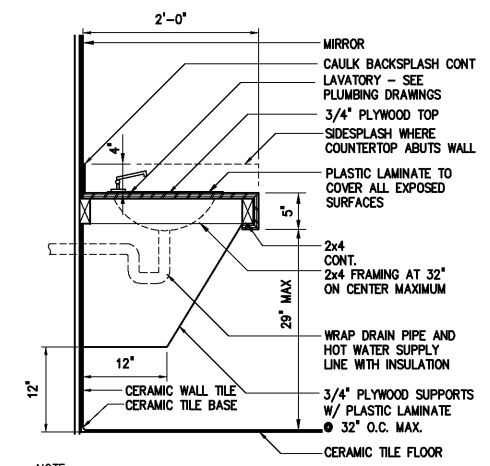


NOTE: PROVIDE FINISHED END PANELS WHERE END PANELS ARE EXPOSED TO VIEW.

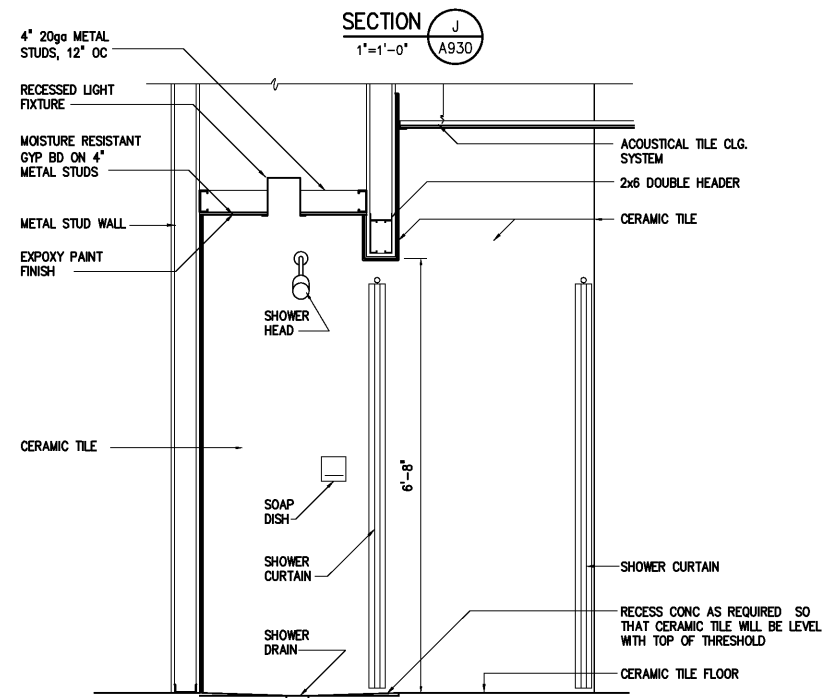


SECTION K
3/4"=1'-0" A930

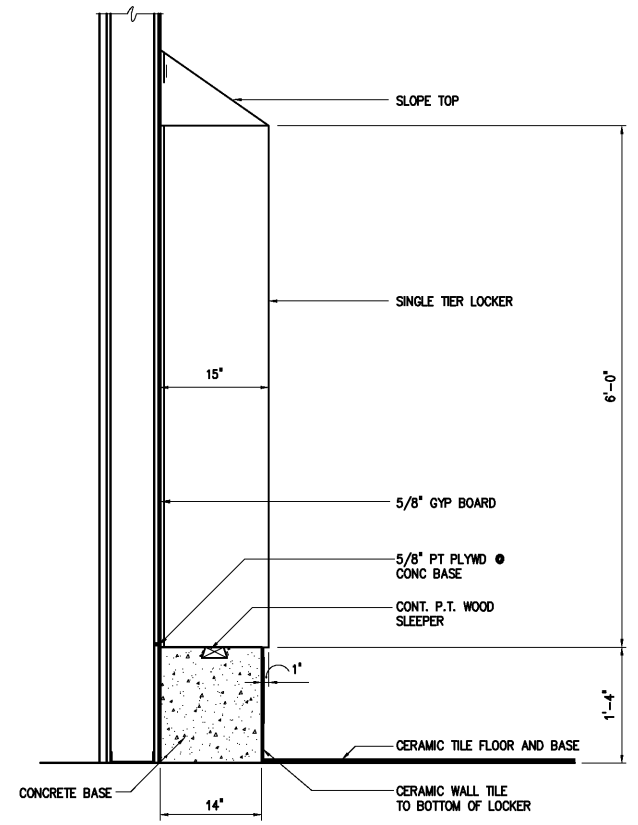

SECTION L
3/4"=1'-0" A930

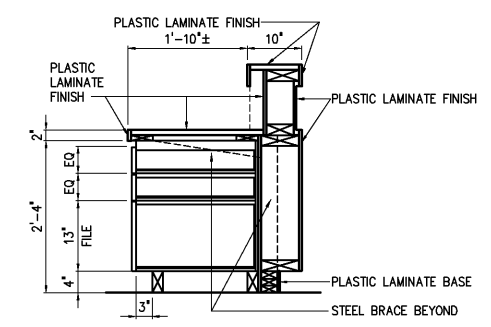

CASEWORK SECTION
Z
3/4"=1'-0" A920

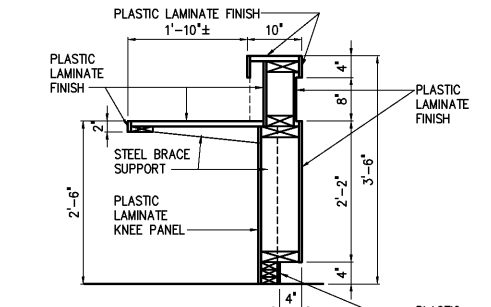

CASEWORK SECTION
AA
3/4"=1'-0" A920

DESIGNED	LU
DRAWN	ALB
CHECKED	
PROJ. ENGR.	H & S
APPROVED	
NO.	
3	RECORD DRAWING
2	CONSTRUCTION
1	REGULATORY APPROVAL
NO.	ISSUED FOR
	DATE
	BY

THIS DOCUMENT ORIGINALLY ISSUED FOR CONSTRUCTION AND SEALED BY ROBERT S. DIFIORE, SEAL NO. 22769

RECORD DRAWING

THIS DRAWING HAS BEEN MODIFIED TO REFLECT FIELD CHANGES REPORTED BY THE CONTRACTOR OR ANOTHER PARTY, BUT NOT VERIFIED BY THE CERTIFYING ENGINEER. THIS DOCUMENT ORIGINALLY ISSUED AND SEALED BY WILLIAM H. RUSSELL, SEAL NUMBER 008532. THIS MEDIA SHALL NOT BE CONSIDERED A CERTIFIED DOCUMENT.

HAZEN AND SAWYER
Environmental Engineers & Scientists
4011 WestChase Blvd, Raleigh, North Carolina 27607

CITY OF ROANOKE
VIRGINIA
REGIONAL WATER POLLUTION CONTROL PLANT
PROCESS TRAIN IMPROVEMENTS

ADMINISTRATION BUILDING
ARCHITECTURAL
PARTIAL PLANS AND DETAILS

THE SCALE BAR SHOWN BELOW MEASURES ONE INCH LONG ON THE ORIGINAL DRAWING.	DATE	JANUARY 2004
	H & S JOB NUMBER	30788C
	CONTRACT NUMBER	C
	DRAWING NUMBER	A930