


- NOTES:
- 1 REMOVE BRICK PARTITION WALL AS INDICATED ON DEMOLITION PLAN AS REQUIRED FOR OPENINGS. PROVIDE LINTELS WHERE OPENINGS OCCUR.
 - 2 REMOVE DOOR, DOOR HARDWARE, AND DOOR FRAME IN ITS ENTIRETY.
 - 3 REMOVE WINDOW AND WINDOW FRAME IN IT'S ENTIRETY. PREPARE OPENING FOR NEW WINDOW.
 - 4 REMOVE METAL LOCKERS.
 - 5 REMOVE PLUMBING FIXTURES AND TOILET ACCESSORIES. CAP EXISTING PLUMBING AT CONCRETE SLAB (SEE PLUMBING DRAWINGS).
 - 6 REMOVE SHOWER STALL.
 - 7 REMOVE EXISTING CONCRETE SLAB AS NEEDED FOR THE INSTALLATION OF NEW PLUMBING FIXTURES (SEE PLUMBING DRAWINGS).
 - 8 EXISTING FLOOR FINISHING MATERIAL TO REMAIN. PREPARE FLOOR FOR NEW FLOOR FINISH.
 - 9 REMOVE EXISTING SUSPENDED CEILING SYSTEM IN IT'S ENTIRETY.
 - 10 REMOVE LIGHT FIXTURES (SEE ELECTRICAL DRAWINGS).
 - 11 REMOVE HVAC SUPPLY AND RETURN DIFFUSERS (SEE HVAC DRAWINGS).
 - 12 REMOVE WOOD BENCH.
 - 13 RELOCATE EXISTING AIR COMPRESSOR. SEE A961 FOR NEW LOCATION. REMOVE 4" HIGH CONCRETE PAD AND REPAIR FLOOR.
 - 14 RELOCATE EXISTING METAL SHELVING AND METAL PALLET RACKS. SEE A961 FOR NEW LOCATION.
 - 15 REMOVE BRICK WALL TO 7'-4" HEIGHT TO CREATE BULKHEAD, SEE DETAIL 152/A964. WB LINTEL SHALL BE INSTALLED PRIOR TO REMOVAL OF BRICK BELOW. BRICK WALL TO REMAIN AT MEZZANINE LEVEL.
 - 16 EXISTING TRENCH DRAIN TO REMAIN.
 - 17 REMOVE EXISTING UNIT KITCHEN INCLUDING PLUMBING AND ELECTRICAL.
 - 18 REMOVE EXISTING BUILT-UP ROOF SYSTEM AND RIGID ROOF INSULATION TO EXISTING CONCRETE DECK. PREPARE DECK FOR NEW ROOFING SYSTEM.
 - 19 REMOVE EXISTING 3'-0" x 3'-0" LOUVER. PREPARE OPENING FOR NEW MASONRY INFILL.
 - 20 REMOVE EXISTING 5'-0" x 4'-0" WINDOW. PREPARE OPENING FOR NEW MASONRY INFILL.
 - 21 REMOVE DOOR, AND DOOR HARDWARE IN ITS ENTIRETY. DOOR FRAME TO REMAIN.

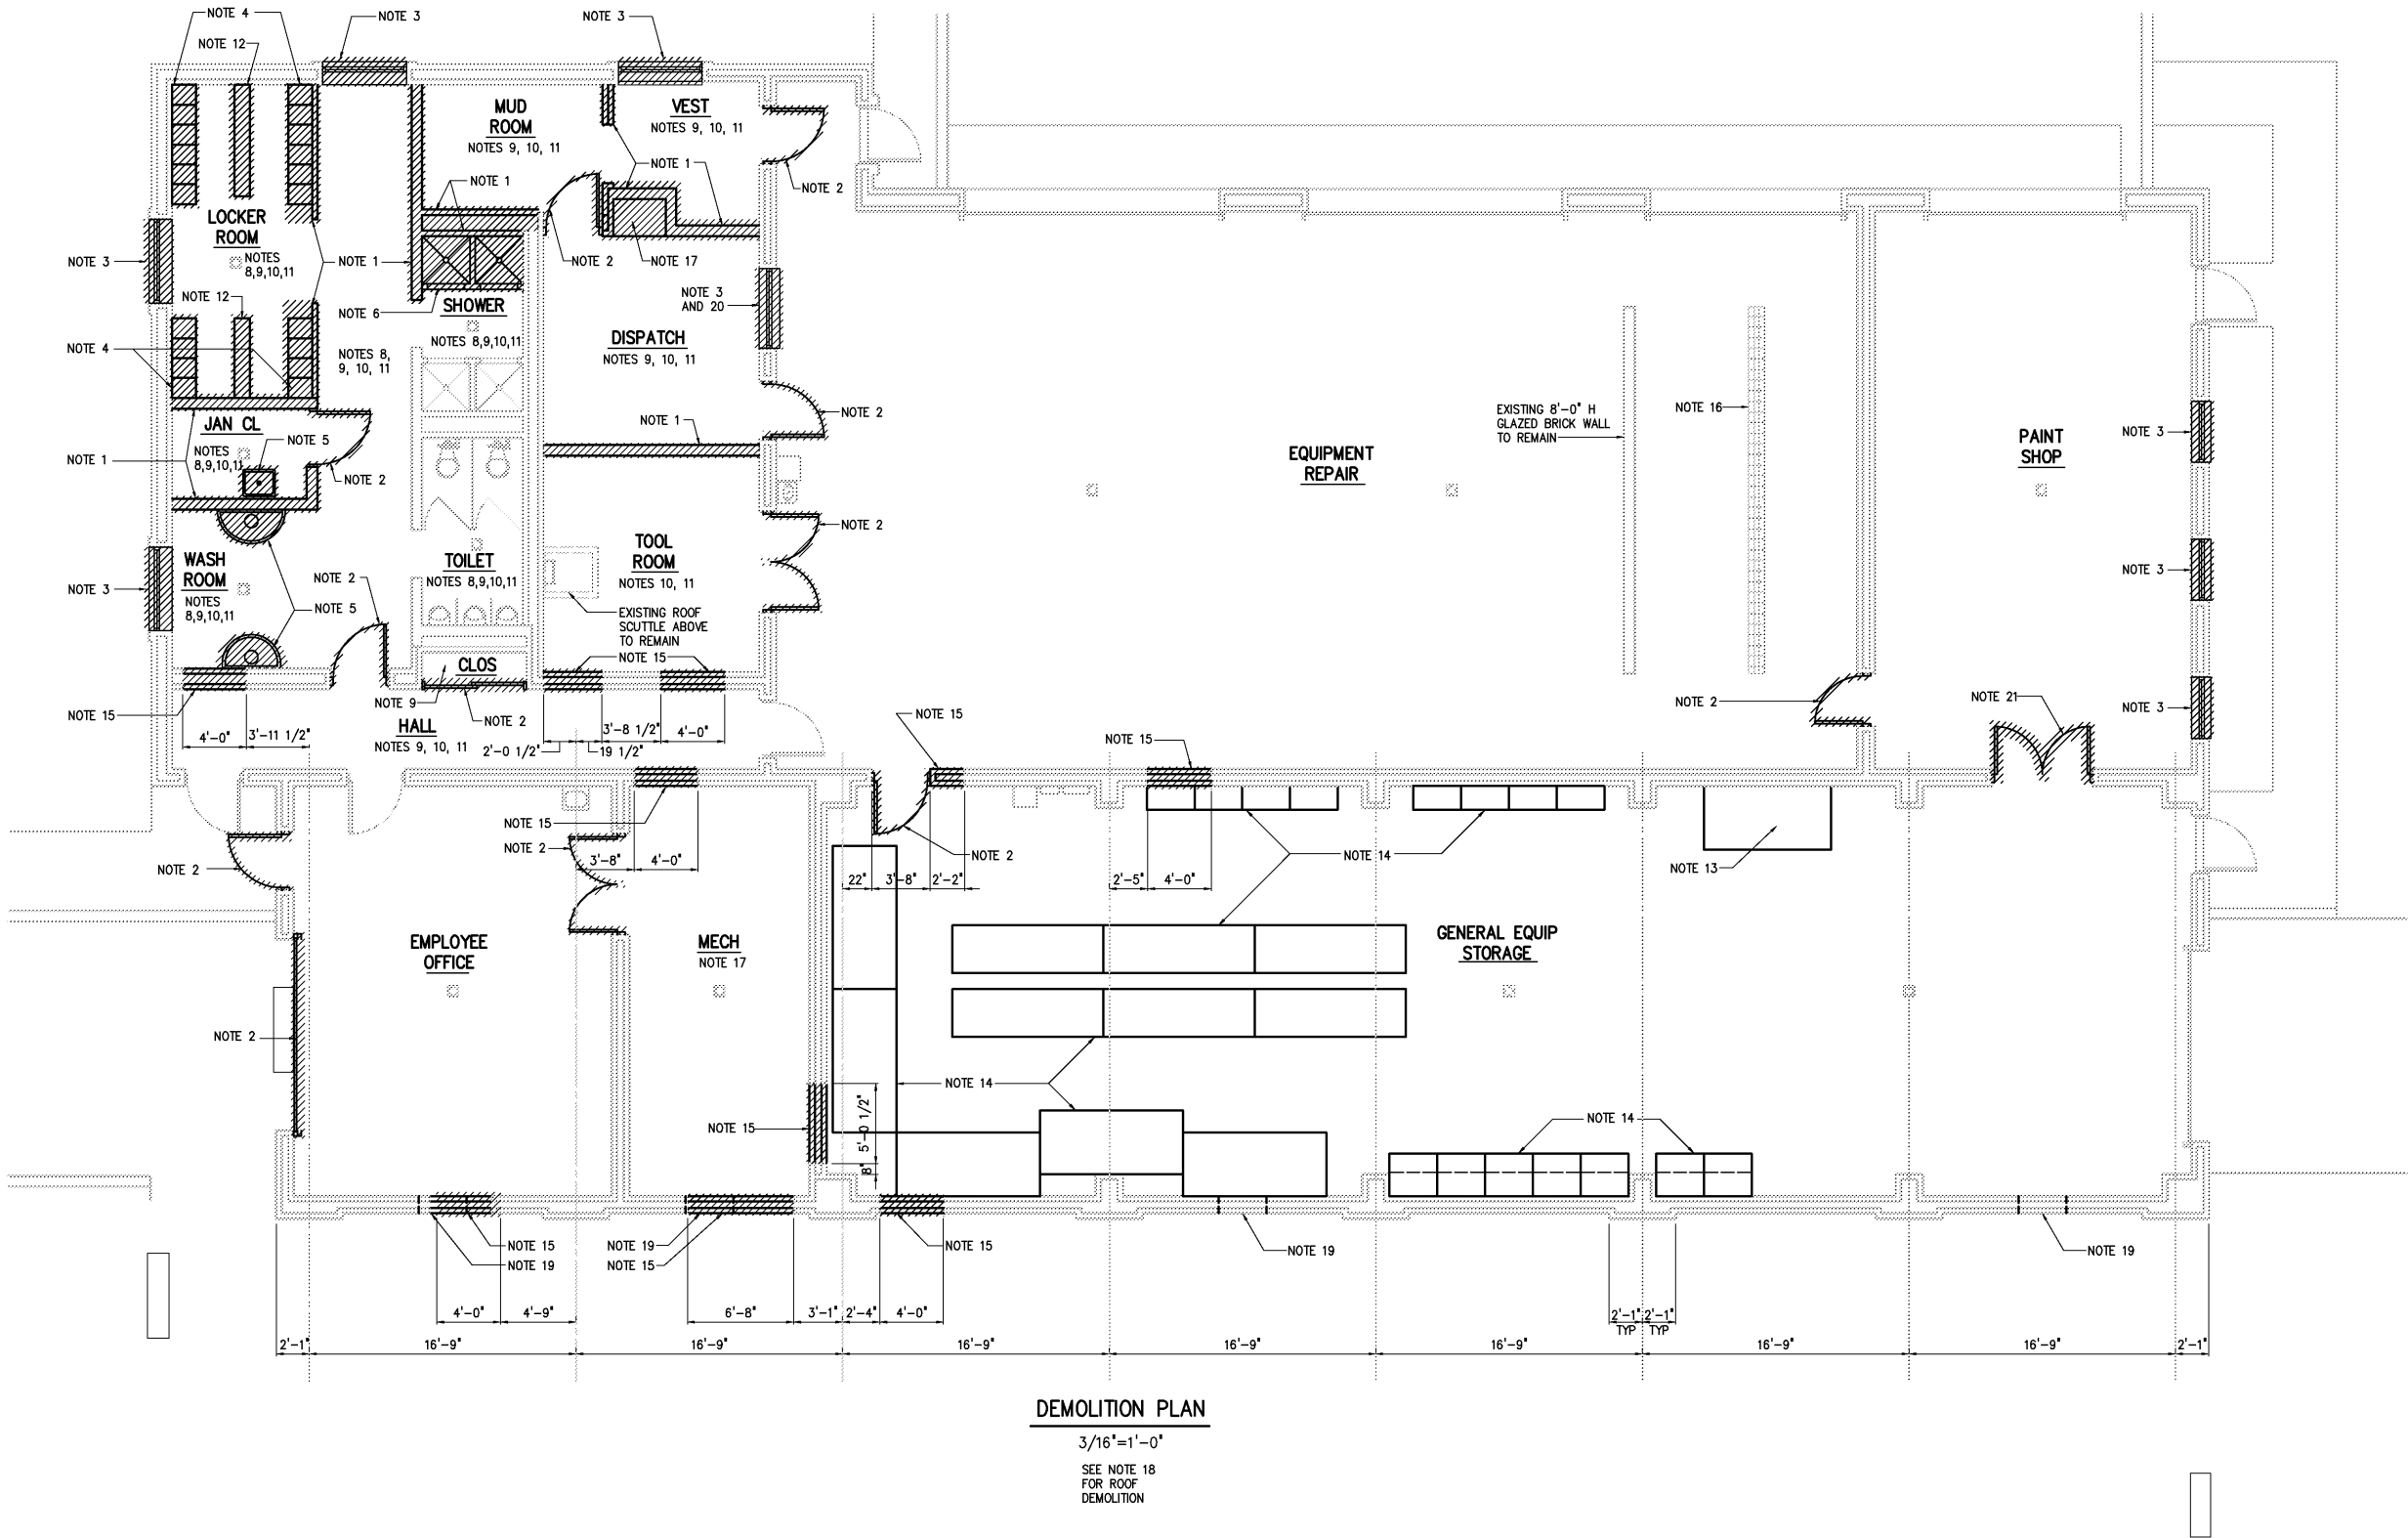

				DESIGNED	WHR	RECORD DRAWING	THIS DOCUMENT ORIGINALLY ISSUED FOR CONSTRUCTION AND SEALED BY ROBERT S. DIFIORE, SEAL NO. 22769	HAZEN AND SAWYER Environmental Engineers & Scientists 4011 WestChase Blvd, Raleigh, North Carolina 27607	CITY OF ROANOKE VIRGINIA	MAINTENANCE BUILDING MODIFICATIONS	THE SCALE BAR SHOWN BELOW MEASURES ONE INCH LONG ON THE ORIGINAL DRAWING.	DATE	JANUARY 2004	
				DRAWN	ALB							H & S JOB NUMBER	30788C	
				CHECKED								CONTRACT NUMBER	DRAWING NUMBER	
				PROJ. ENGR.	DAN							C	A960	
3	RECORD DRAWING	JAN 2006	RLT	APPROVED										
2	CONSTRUCTION	JAN 2004	RLT											
1	REGULATORY APPROVAL	NOV 2003	RLT											
NO.	ISSUED FOR	DATE	BY											