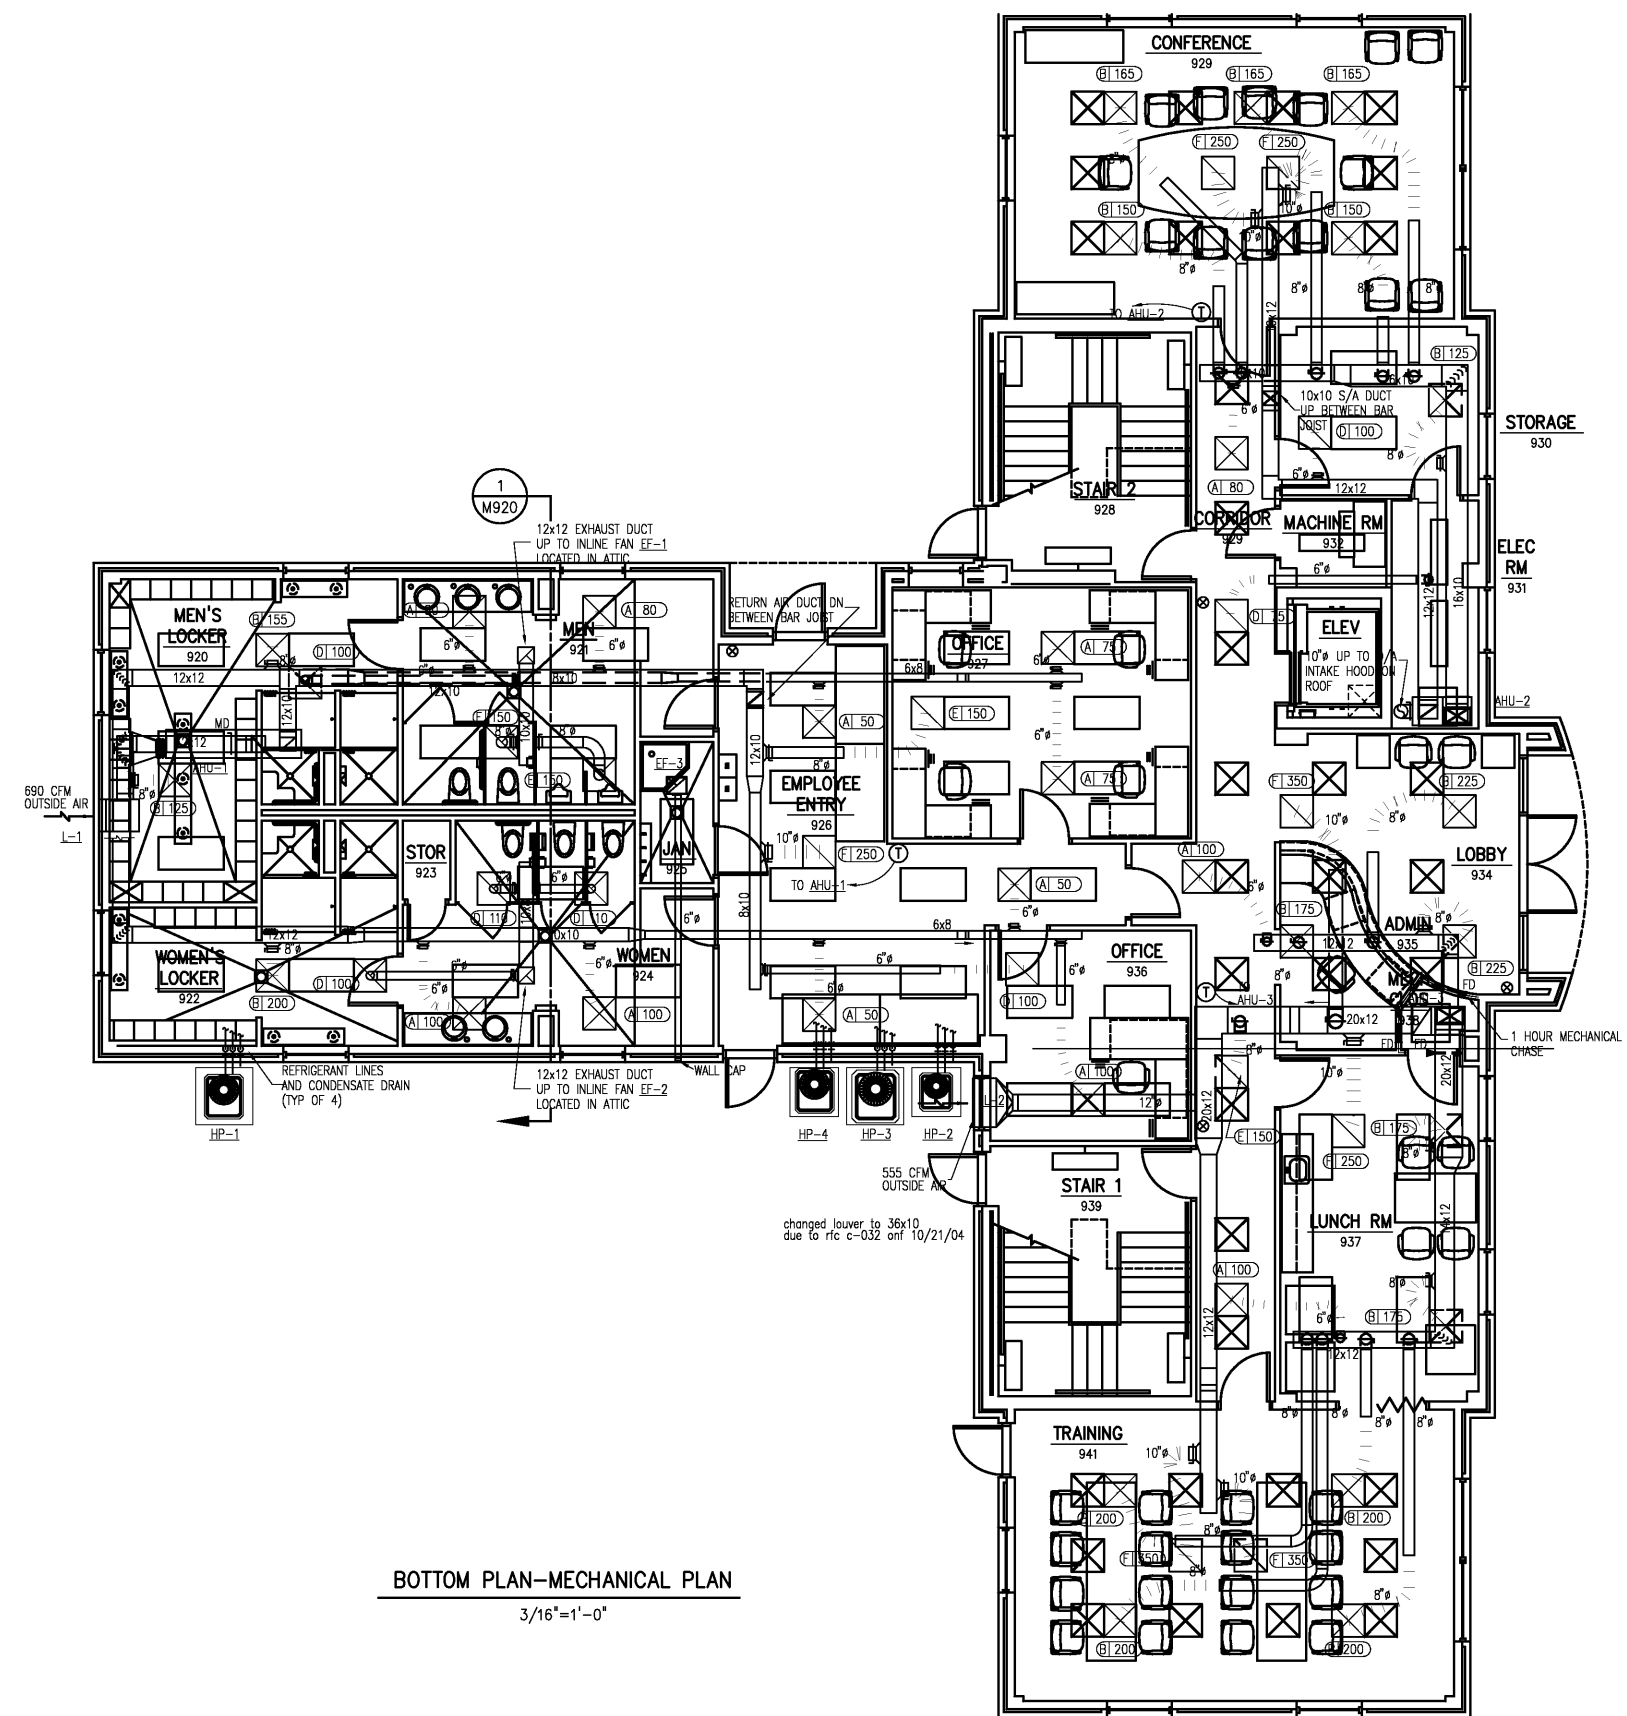



$$3/16'' = 1' - 0''$$

				DESIGNED _____ RDM	RECORD DRAWING THIS DOCUMENT ORIGINALLY ISSUED FOR CONSTRUCTION AND SEALED BY W. GINGER SCOGGINS, SEAL NUMBER 0402 033234. THIS MEDIA SHALL NOT BE CONSIDERED A CERTIFIED DOCUMENT	EDI Engineered Designs, Inc. 1011 Schaub Dr. Suite 201 Raleigh, North Carolina 27606 Office: 919.851.8481 Fax: 919.851.9703	HAZEN AND SAWYER Environmental Engineers & Scientists 4011 WestChase Blvd, Raleigh, North Carolina 27607	CITY OF ROANOKE VIRGINIA	REGIONAL WATER POLLUTION CONTROL PLANT ADMINISTRATION AND MAINTENANCE BUILDINGS	ADMINISTRATION BUILDING MECHANICAL BOTTOM PLAN AND SECTION	THE SCALE BAR SHOWN BELOW MEASURES ONE INCH LONG ON THE ORIGINAL DRAWING.	DATE JANUARY 2004			
				DRAWN _____ RDM								H & S JOB NUMBER 30788C			
				CHECKED _____										CONTRACT NUMBER C	DRAWING NUMBER M920
3	RECORD DRAWING	JAN 2006		PROJ. ENGR. _____ H & S											
2	CONSTRUCTION	JAN 2004													
1	REGULATORY APPROVAL	NOV 2003													
NO.	ISSUED FOR	DATE	BY	APPROVED											