


**SANITARY WASTE  
RISER DIAGRAM**  
DETAIL 1  
NOT TO SCALE P-924

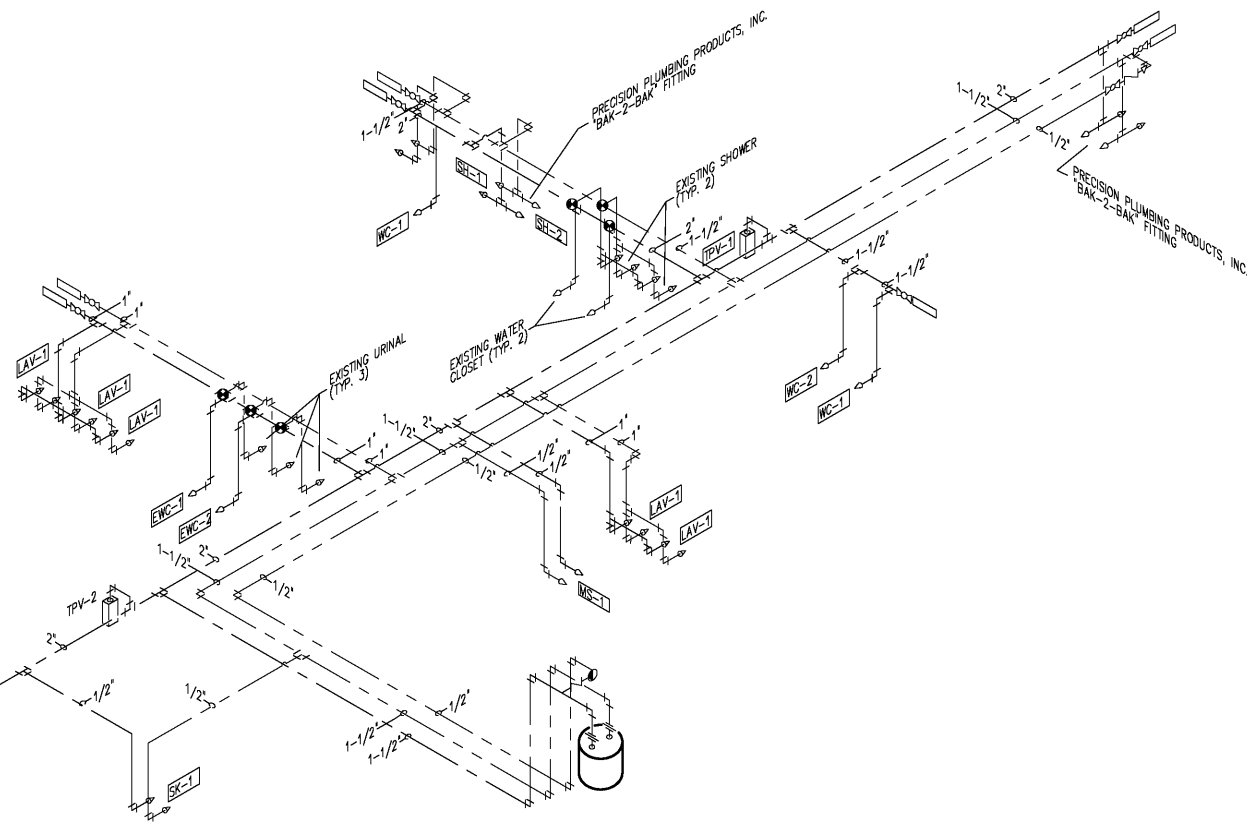

**DOMESTIC WATER  
RISER DIAGRAM**  
DETAIL 2  
NOT TO SCALE P-924

**NOTES:**

1. ALL POTABLE WATER SYSTEM PIPING BELOW SLAB SHALL BE SEAMLESS TYPE "K" COPPER TUBING AND COMPLY WITH ASTM B88-B8A.

DESIGNED	RDM
DRAWN	RDM
CHECKED	
PROJ. ENGR.	H & S
APPROVED	
NO.	ISSUED FOR
DATE	BY

RECORD DRAWING	ED I
THIS DOCUMENT ORIGINALLY ISSUED FOR CONSTRUCTION AND SEALED BY M. GINGER SOGGINS, SEAL NUMBER 0402 033234. THIS MEDIA SHALL NOT BE CONSIDERED A CERTIFIED DOCUMENT	Engineered Designs, Inc. 1011 Schaub Dr. Suite 201 Raleigh, North Carolina 27606 Office: 919.851.8481 Fax: 919.851.9703

HAZEN AND SAWYER
Environmental Engineers & Scientists 4011 WestChase Blvd, Raleigh, North Carolina 27607

CITY OF ROANOKE VIRGINIA
REGIONAL WATER POLLUTION CONTROL PLANT ADMINISTRATION AND MAINTENANCE BUILDINGS

MAINTENANCE BUILDING PLUMBING RISER DIAGRAMS
--

THE SCALE BAR SHOWN BELOW MEASURES ONE INCH LONG ON THE ORIGINAL DRAWING.	DATE JANUARY 2004 H & S JOB NUMBER 30788C CONTRACT NUMBER C DRAWING NUMBER P964
---	--