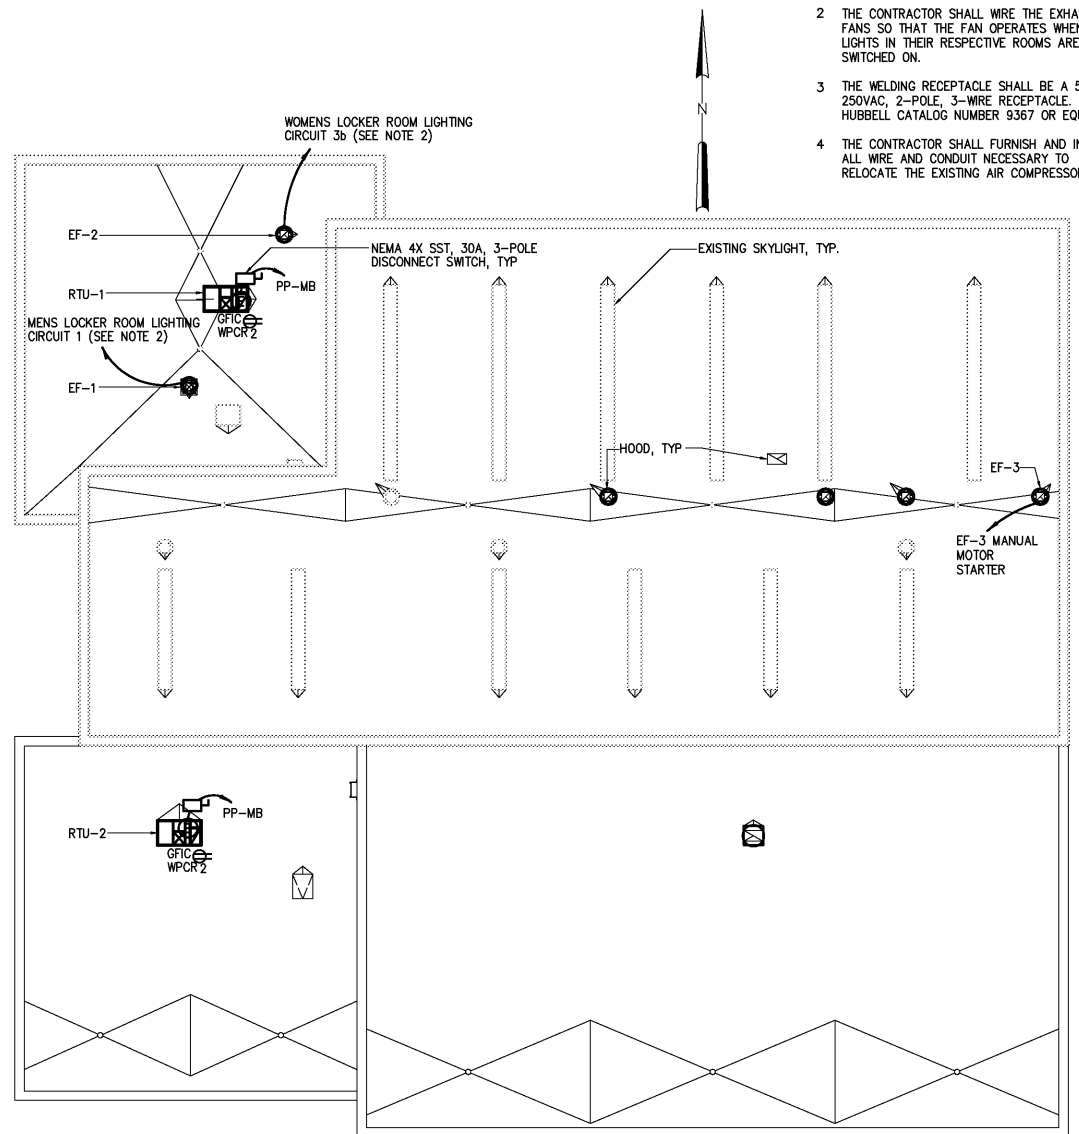
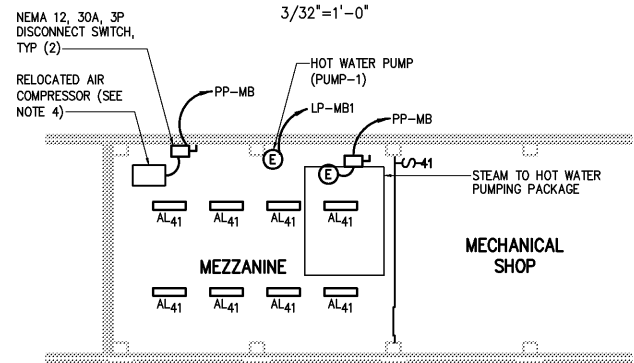


- 1 MOUNT ALL RECEPTACLES IN THE SHOP SPACES 12 INCHES ABOVE WORK BENCH.
- 2 THE CONTRACTOR SHALL WIRE THE EXHAUST FANS SO THAT THE FAN OPERATES WHEN THE LIGHTS IN THEIR RESPECTIVE ROOMS ARE SWITCHED ON.
- 3 THE WELDING RECEPTACLE SHALL BE A 50A, 250VAC, 2-POLE, 3-WIRE RECEPTACLE. HUBBELL CATALOG NUMBER 9367 OR EQUAL.
- 4 THE CONTRACTOR SHALL FURNISH AND INSTALL ALL WIRE AND CONDUIT NECESSARY TO RELOCATE THE EXISTING AIR COMPRESSOR.


$$3/32'' = 1' - 0''$$

$$3/32'' = 1' - 0''$$

				DESIGNED	BRL
				DRAWN	DJG
				CHECKED	
3	RECORD DRAWING	JAN 2006	RLT	PROJ. ENGR.	DAN
2	CONSTRUCTION	JAN 2004	RLT		
1	REGULATORY APPROVAL	NOV 2003	RLT		
NO.	ISSUED FOR	DATE	BY	APPROVED	

DESIGNED \_\_\_\_\_ BRL  
DRAWN \_\_\_\_\_ DJG  
CHECKED \_\_\_\_\_  
PROJ. ENGR. \_\_\_\_\_ DAN  
APPROVED \_\_\_\_\_

THIS DOCUMENT ORIGINALLY ISSUED  
FOR CONSTRUCTION AND SEALED BY  
ROBERT S. DIFIORE, SEAL NO. 22769

THIS DOCUMENT ORIGINALLY ISSUED  
FOR CONSTRUCTION AND SEALED BY  
RONALD L. TAYLOR, SEAL NO. 024649

THIS DRAWING HAS BEEN MODIFIED TO REFLECT FIELD CHANGES REPORTED BY THE CONTRACTOR OR ANOTHER PARTY, BUT NOT VERIFIED BY THE CERTIFYING ENGINEER. THIS DOCUMENT ORIGINALLY ISSUED AND SEALED BY GERALD J. RATASKY, 026535. THIS MEDIA SHALL NOT BE CONSIDERED A CERTIFIED DOCUMENT.

**HAZEN AND SAWYER**  
Environmental Engineers & Scientists  
4011 WestChase Blvd, Raleigh, North Carolina 27607

CITY OF ROANOKE  
VIRGINIA

## REGIONAL WATER POLLUTION CONTROL PLANT PROCESS TRAIN IMPROVEMENTS

ELECTRICAL  
POWER PLANS

THE SCALE BAR	DATE	JANUARY 2004
---------------	------	--------------

SHOWN BELOW MEASURES ONE	H & S JOB NUMBER	30788C
-----------------------------	---------------------	--------

INCH LONG ON THE ORIGINAL DRAWING.	CONTRACT NUMBER	DRAWING NUMBER
	C	E962