



PERSPECTIVE VIEW

NOTE: ALL TEMPORARY BERMS, SWALES AND LEVEL SPREADER DITCH MUST RECEIVE TEMPORARY SEEDING IMMEDIATELY AFTER INSTALLATION

0227012

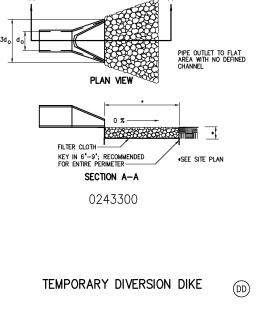

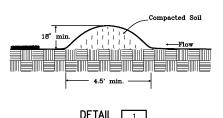

DETAIL	1
NTS	D3

				DESIGNED	H&S
				DRAWN	H&S
				CHECKED	
3	RECORD DRAWING	JAN 2006	RLT	PROJ. ENGR	H&S
2	CONSTRUCTION	JAN 2004	RLT		
1	REGULATORY APPROVAL	NOV 2003	RLT		
NO.	ISSUED FOR	DATE	BY	APPROVED	

THIS DOCUMENT ORIGINALLY ISSUED FOR CONSTRUCTION AND SEALED BY ROBERT S. DIFIORE, SEAL NO. 22769

THIS DOCUMENT ORIGINALLY ISSUED
FOR CONSTRUCTION AND SEALED BY
RONALD L. TAYLOR, SEAL NO. 024649

CONSIDER
CONS

RECORD DRAWING

0227014

THIS DRAWING HAS BEEN MODIFIED TO REFLECT FIELD CHANGES REPORTED BY THE CONTRACTOR OR ANOTHER PARTY, BUT NOT VERIFIED BY THE CERTIFYING ENGINEER. THIS DOCUMENT ORIGINALLY ISSUED AND SEALED BY DAVID A. NAILOR, 025465. THIS MEDIA SHALL NOT BE CONSIDERED A CERTIFIED DOCUMENT.

HAZEN AND SAWYER Environmental Engineers & Scientists 4011 WestChase Blvd, Raleigh, North Carolina 27607

CITY OF ROANOKE VIRGINIA

REGIONAL WATER POLLUTION CONTROL PLANT PROCESS TRAIN IMPROVEMENTS

MISCELLANEOUS STA	NDARD [DETAILS

	THE SCALE BAR	DATE JANUARY 2004		
	SHOWN BELOW MEASURES ONE INCH LONG ON THE ORIGINAL DRAWING.	H & S JOB NUMBER	30788C	
		CONTRACT NUMBER	DRAWING NUMBER D3	
		J	50	