


ROANOKE RIVER

EXHAUST PITS

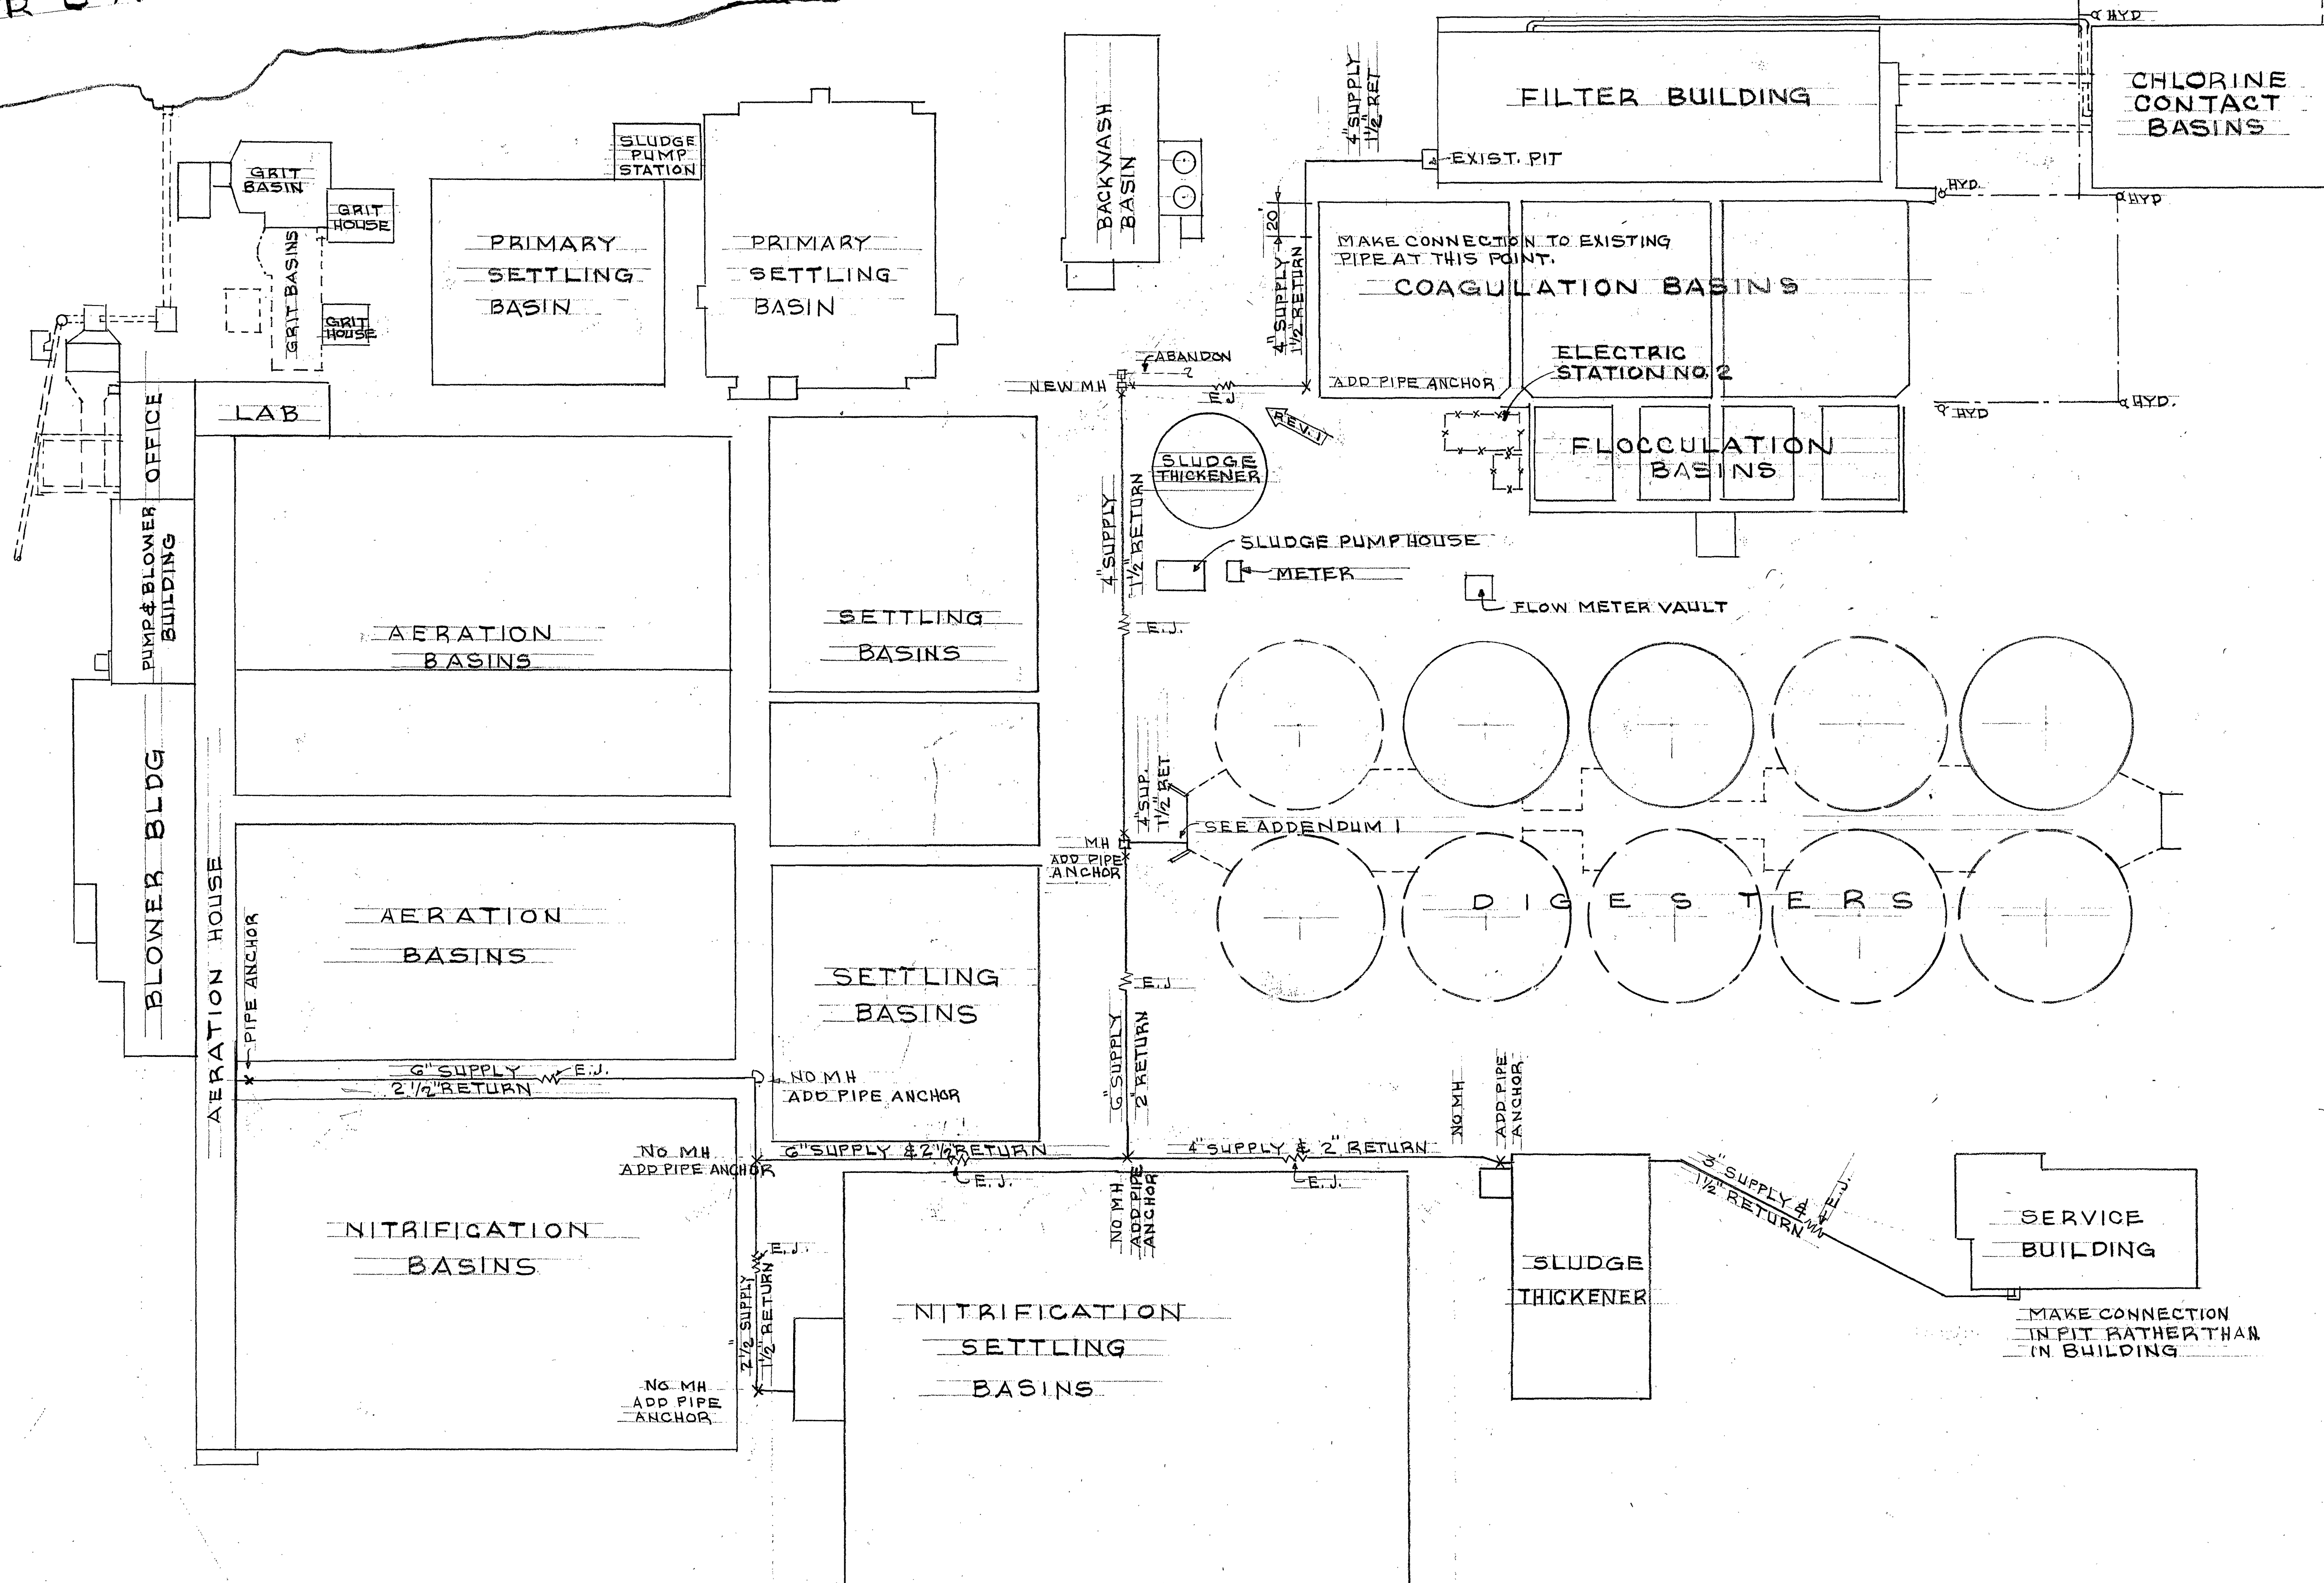

SITE STEAM PIPE LAYOUT

APPROXIMATE SCALE: 1" = 50.0'

8-17-97	1	REAPVERTISED	L.B.C.
DATE	REV	DESCRIPTION	BY
Charles M. Buffin			
STEAM PIPE REPLACEMENT			L.B.C.
WATER POLLUTION CONTROL			
PLANT			
1402 BENNINGTON ST., S.E.			10-9-96
ROANOKE, VIRGINIA			19-96-B
OFFICE OF CITY ENGINEER			1
CITY OF ROANOKE, VIRGINIA			2

"Ric-wil Prefabricated Insulated Pipe Conduit"
16 ga spirally corrugated