


NOTES:

1. EQUIP 1200 AMP FRAME MAIN BREAKER WITH 1000 AMP PLUG.
2. SEE BAF MANUFACTURER'S SHOP DRAWINGS FOR SCOPE OF EQUIPMENT, CONDUIT AND WIRES TO BE PROVIDED BY BAF MANUFACTURER.

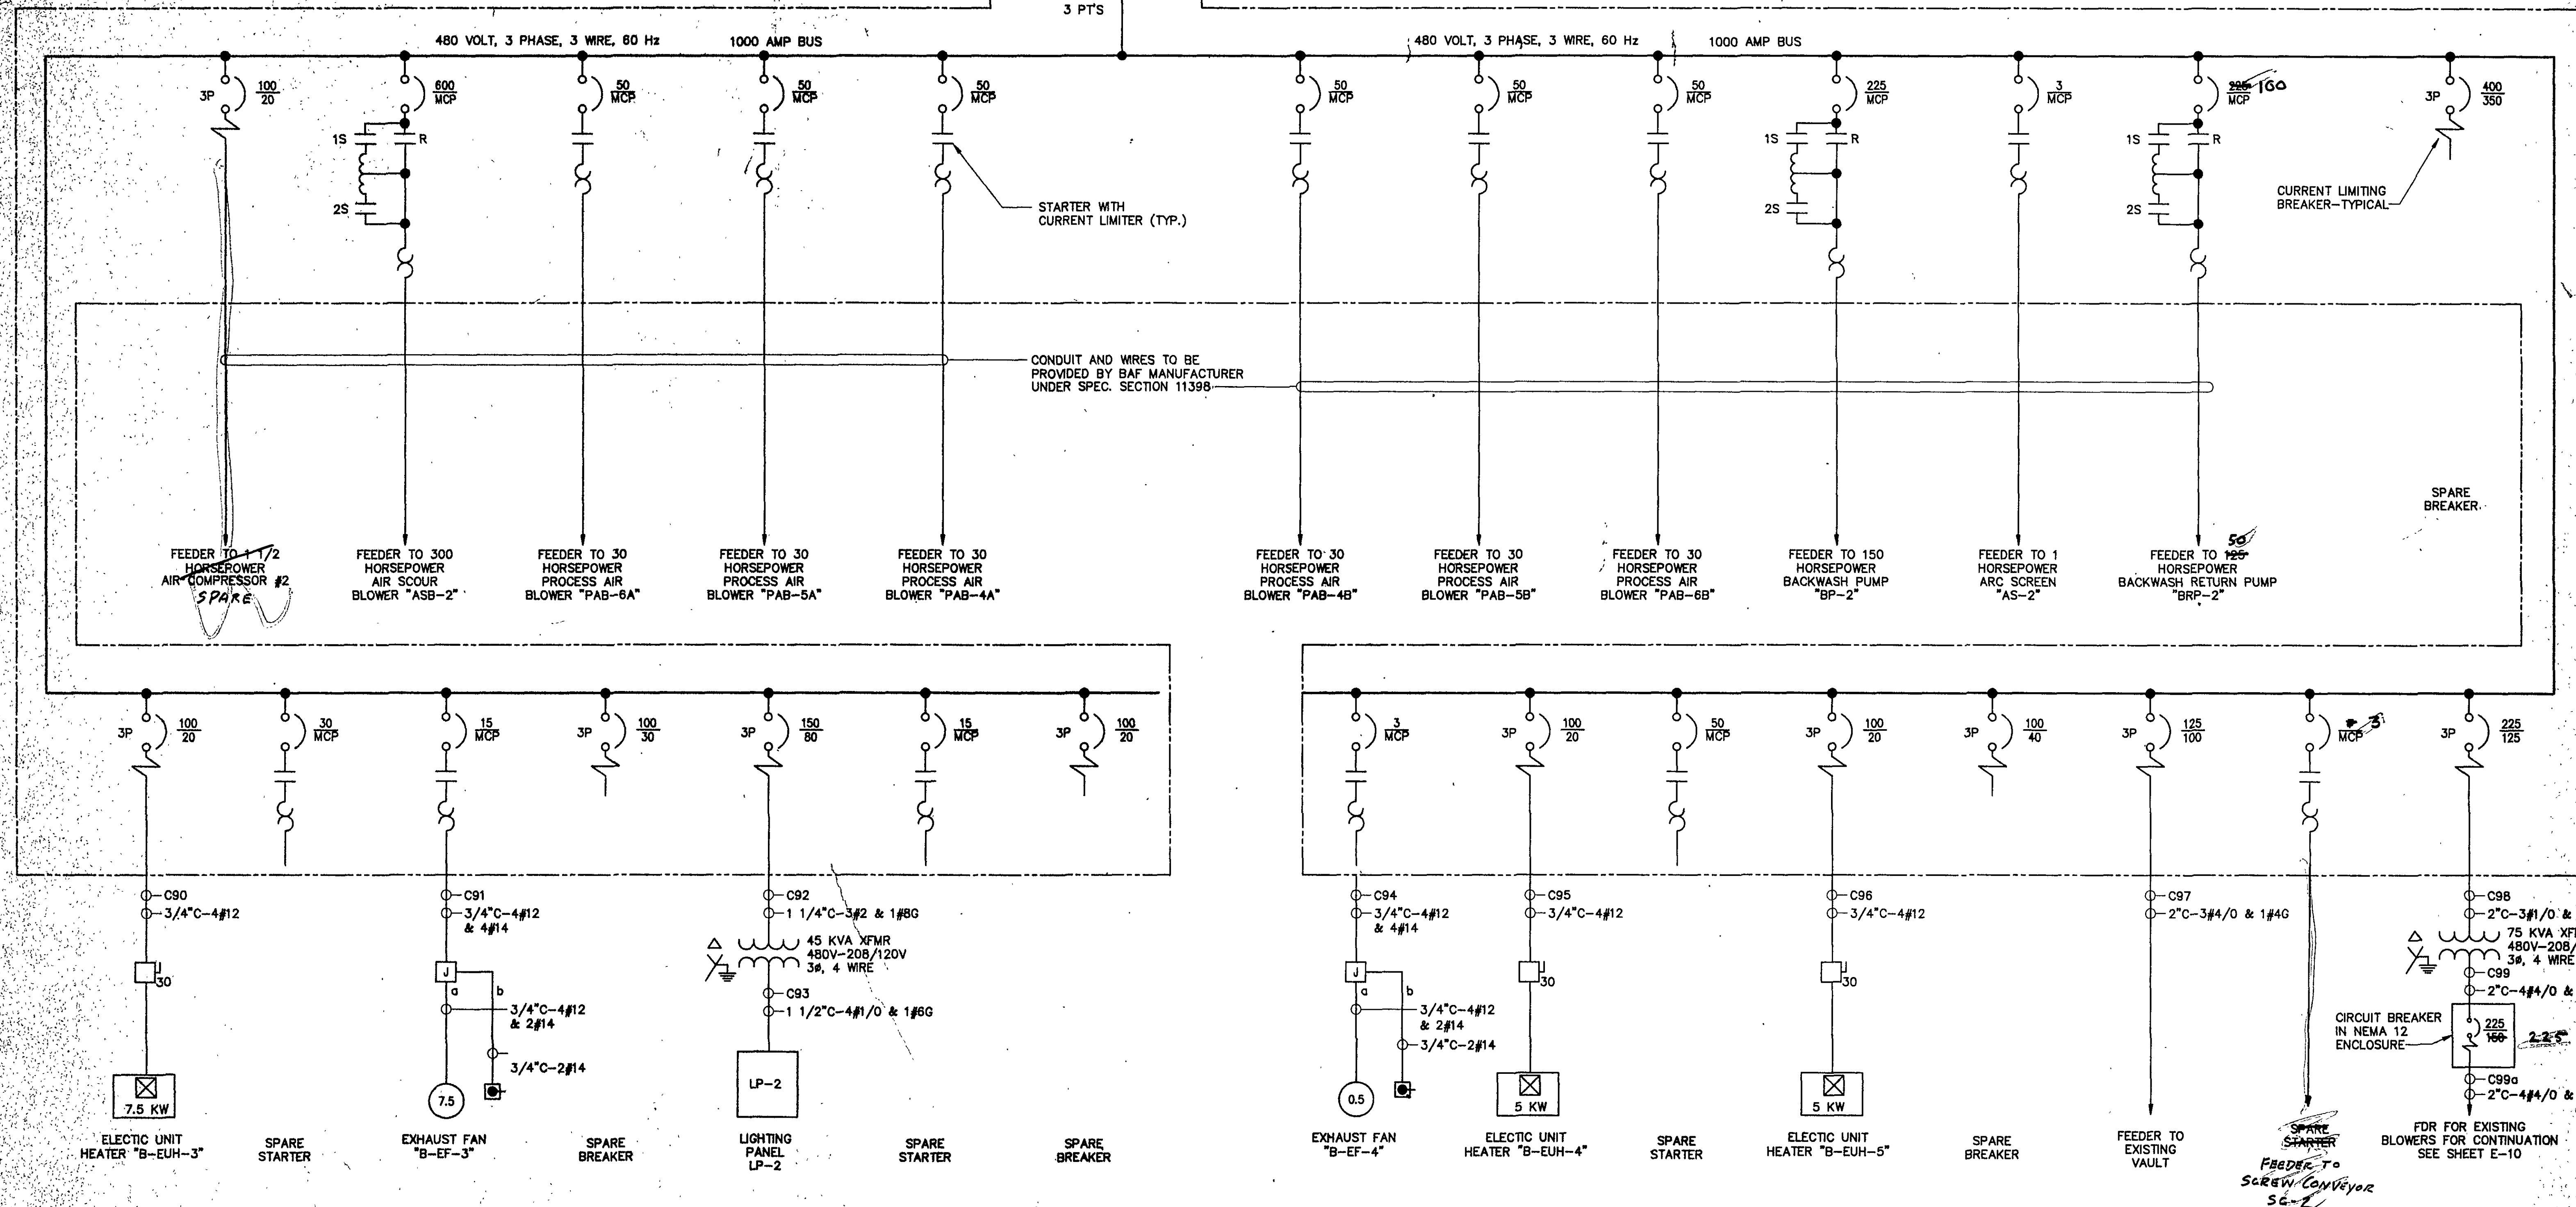

RECORD DRAWINGS

BIOLOGICAL AERATED FILTER
MCC-11 ONE LINE DIAGRAM

SCALE: NONE

CITY OF ROANOKE, VIRGINIA
WATER POLLUTION
CONTROL PLANT
UPGRADE AND EXPANSION

COPYRIGHT © 1997
MALCOLM PIRNIE, INC.
DATE MAY 1997
E SHEET 9 OF 36
CAD REF. NO. 0060E684