




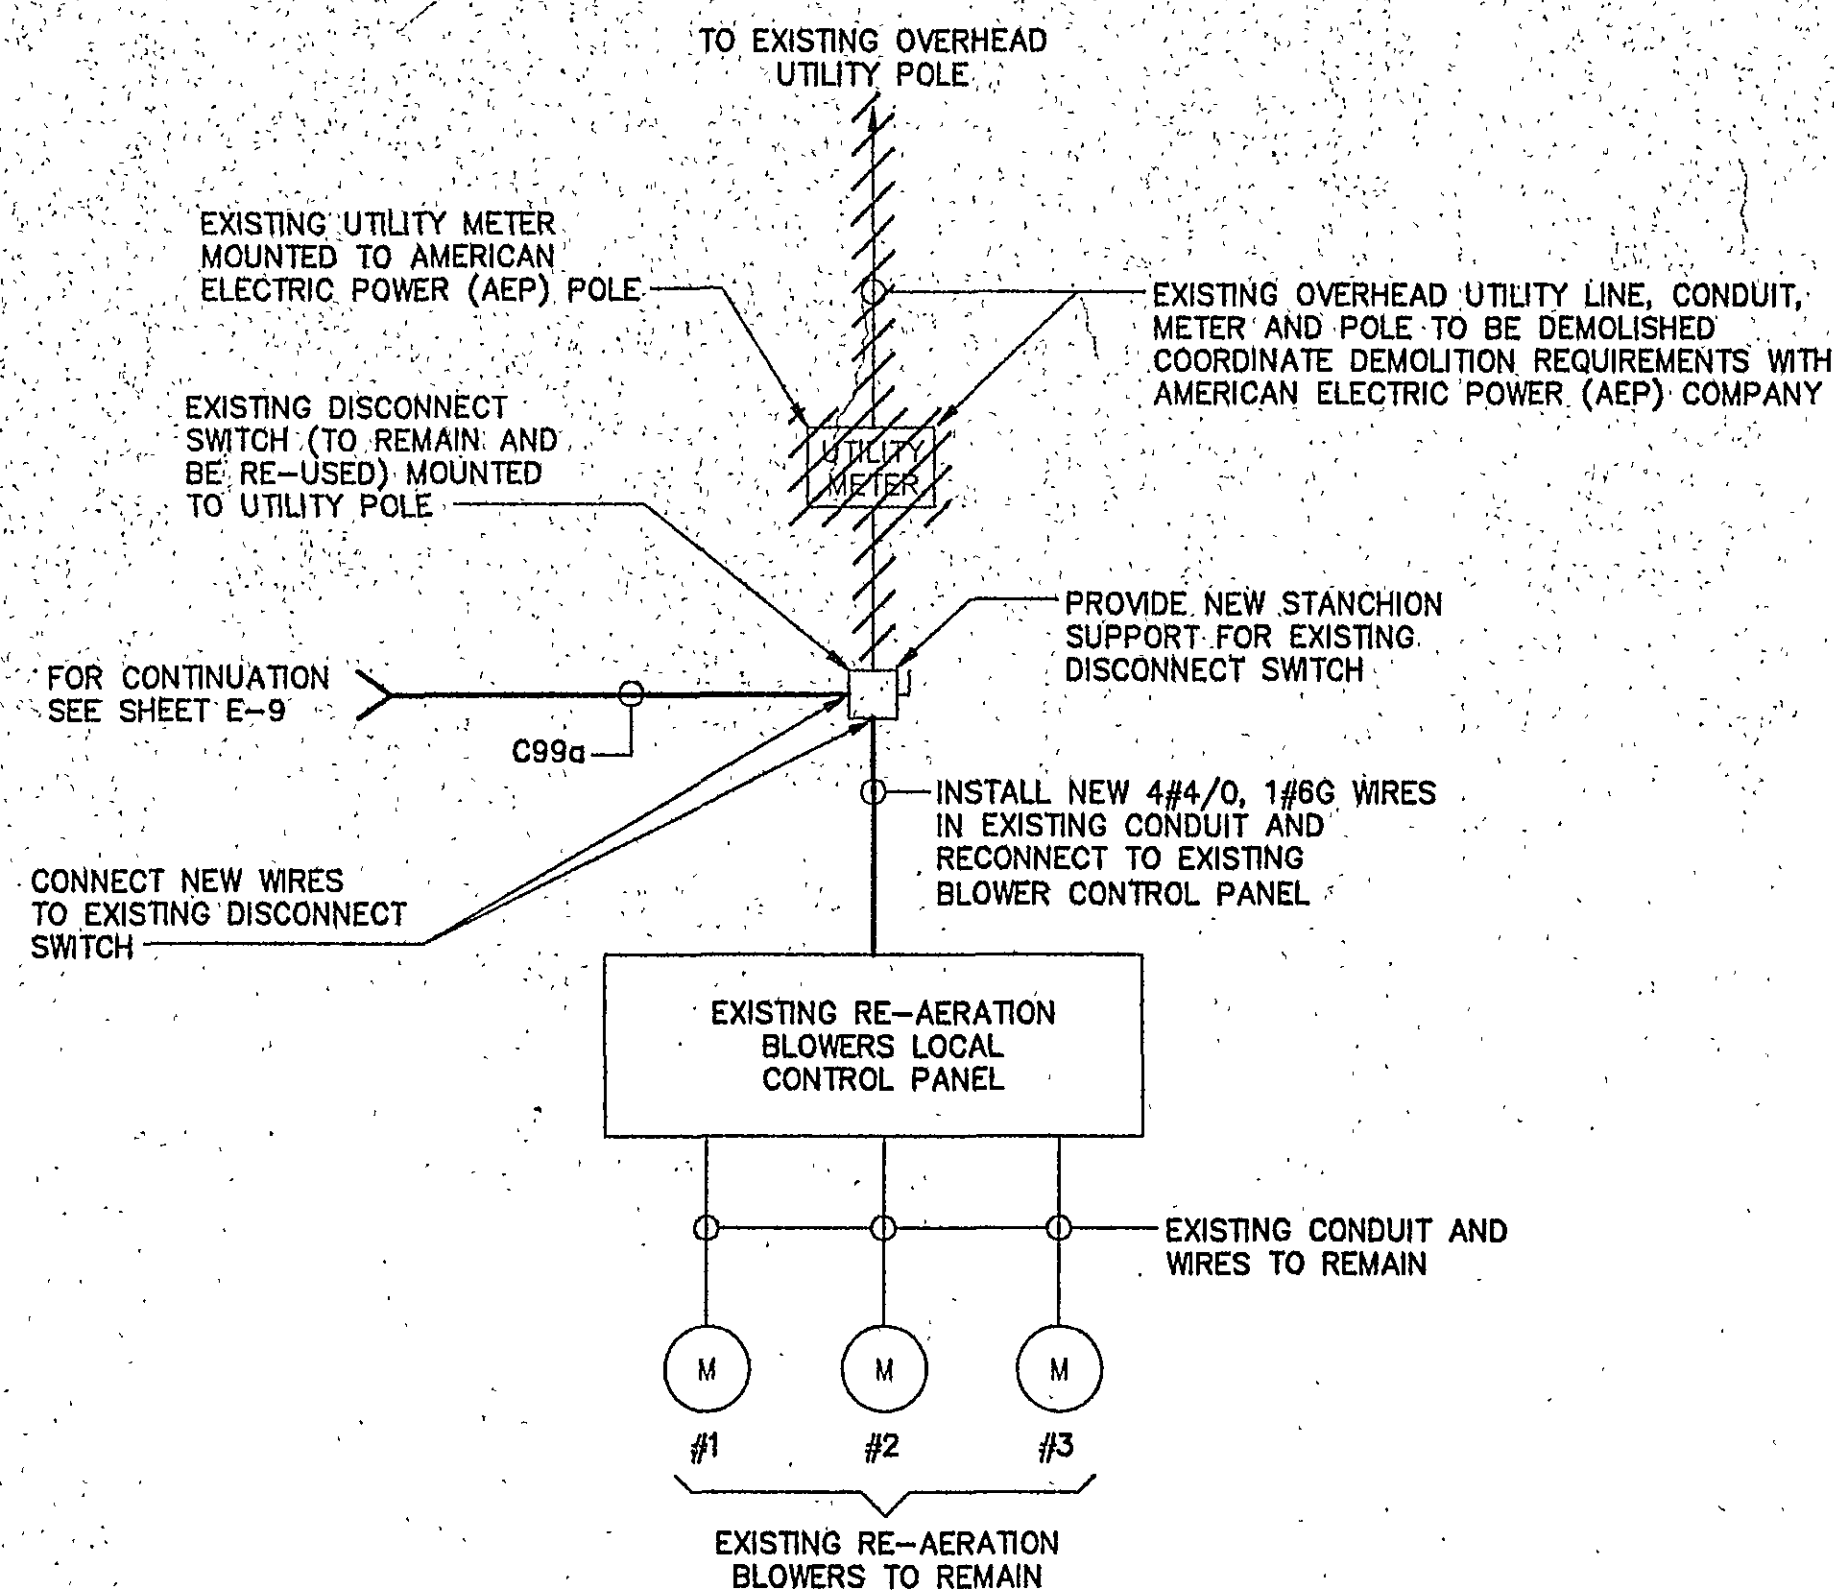

RE-FEED EXISTING RE-AERATION BLOWERS
MODIFICATION DIAGRAM

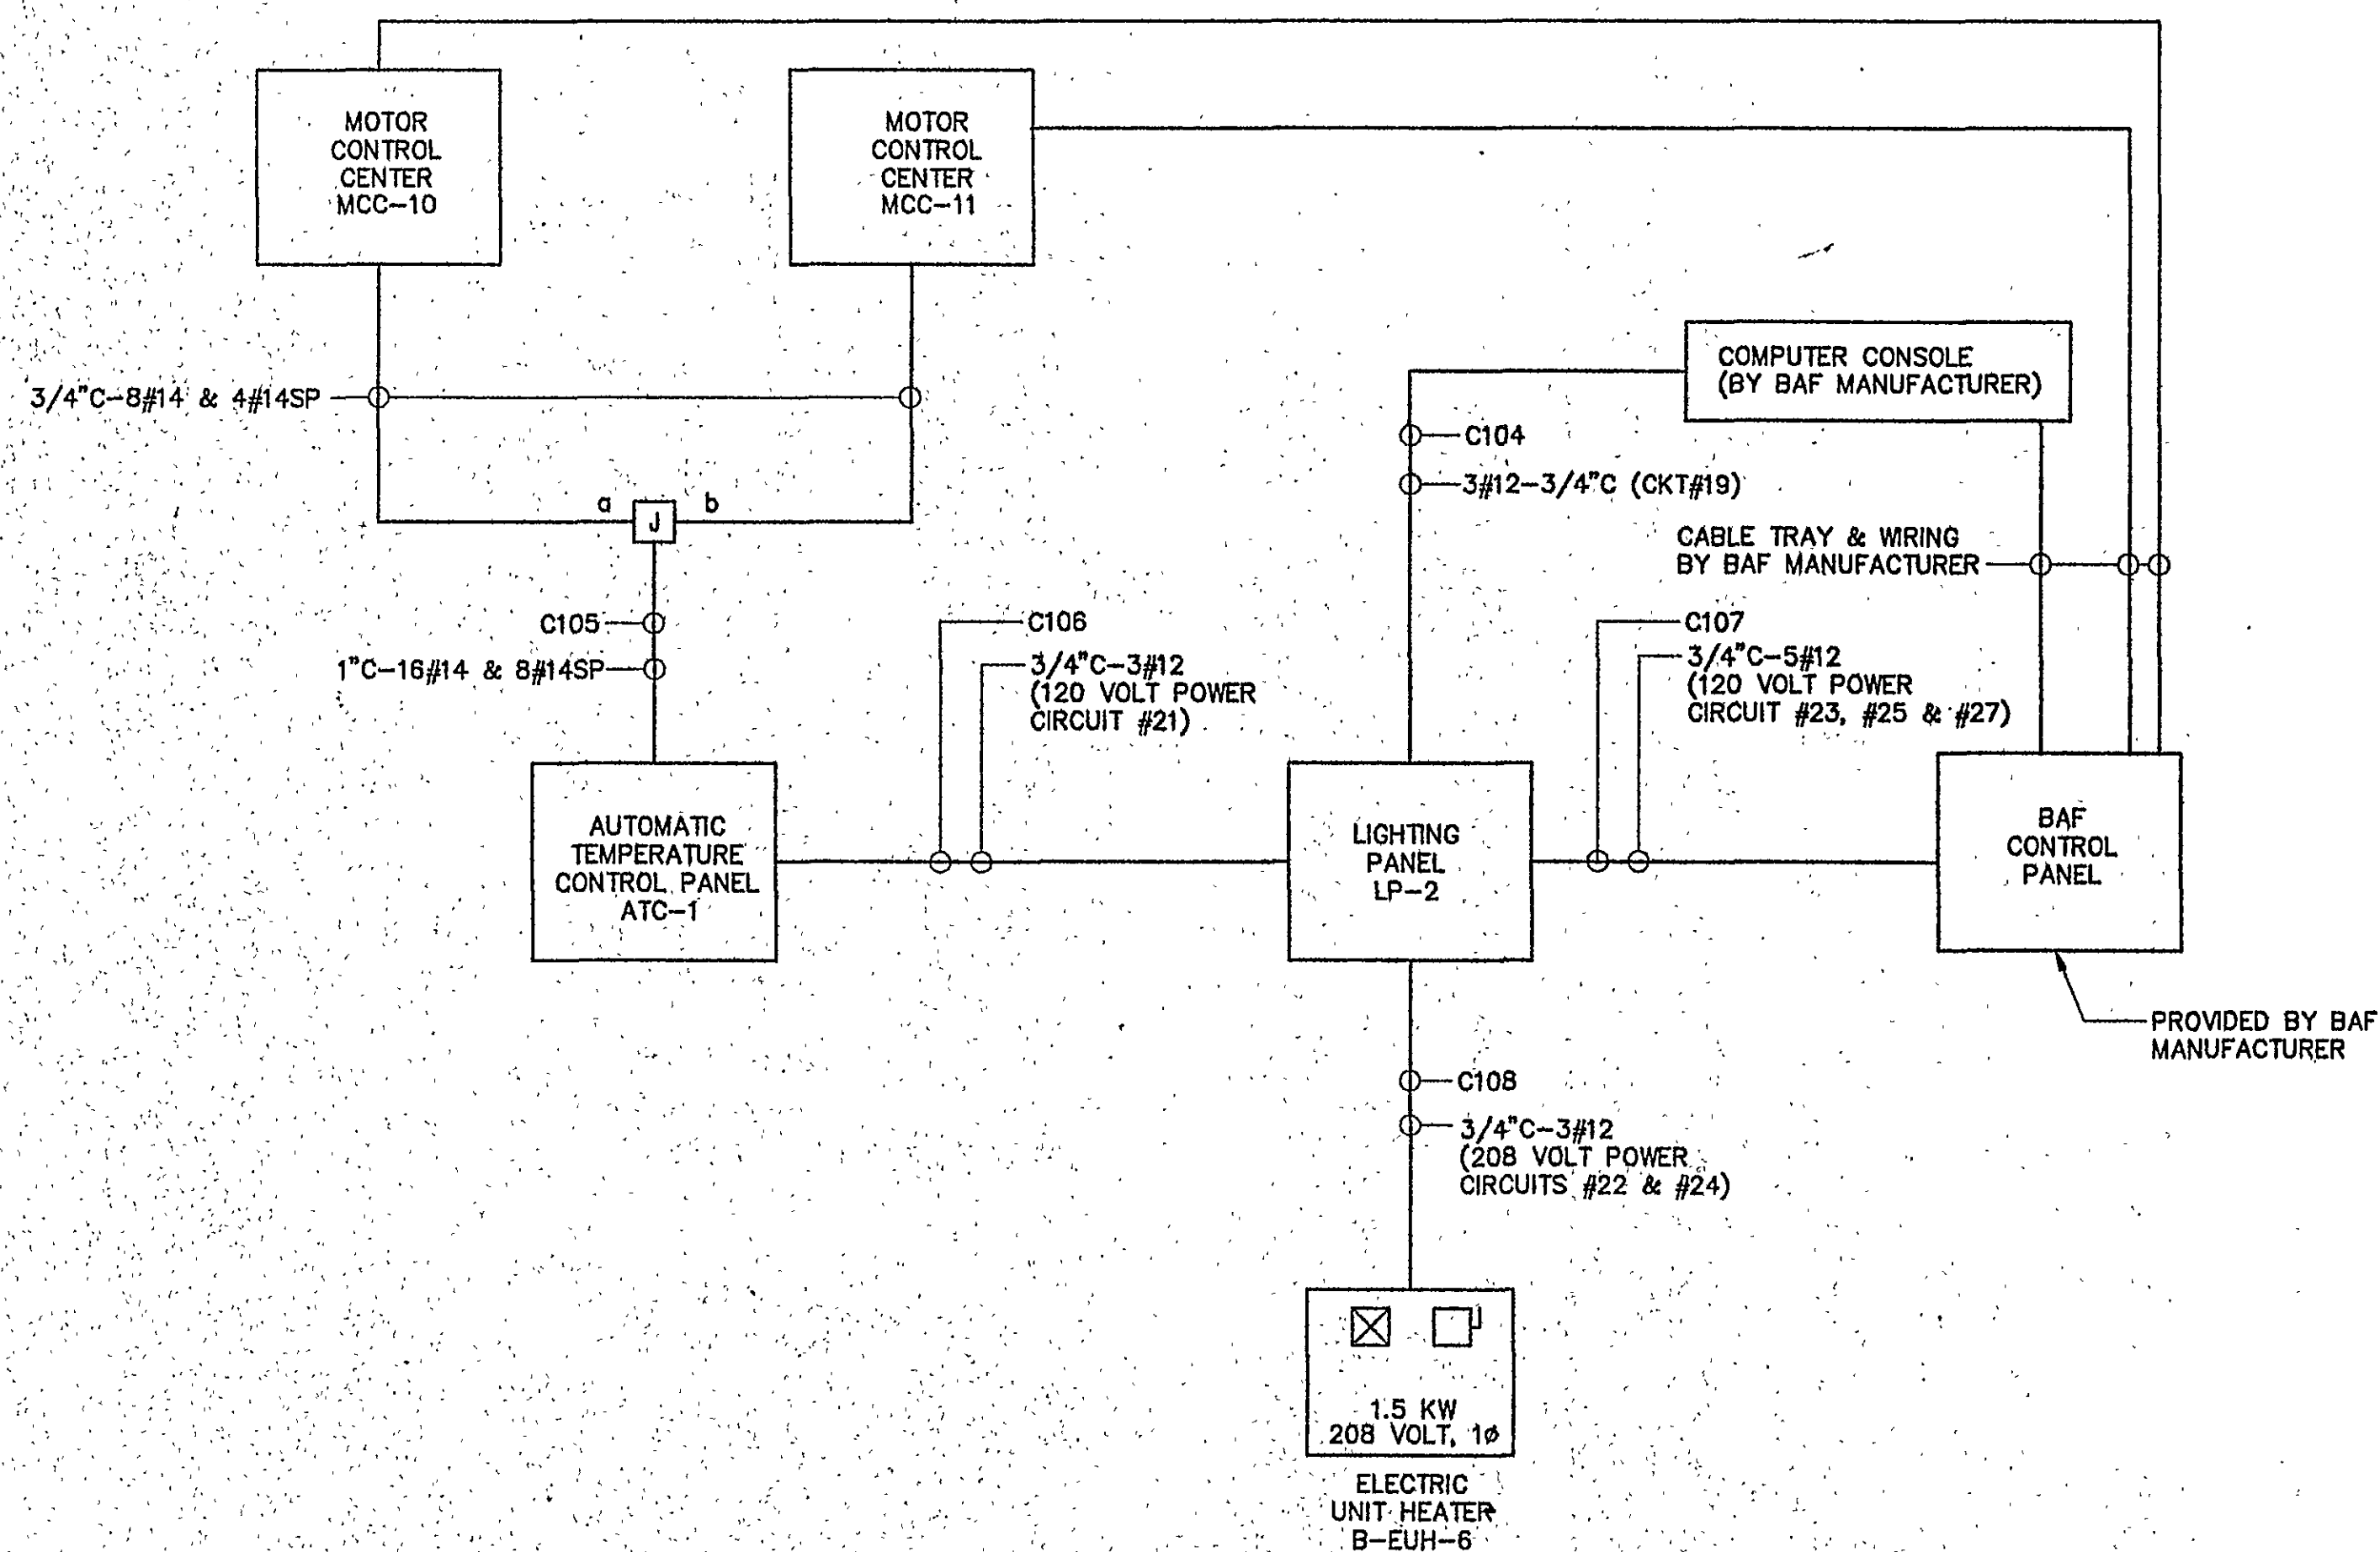


INTERCONNECTION DIAGRAM

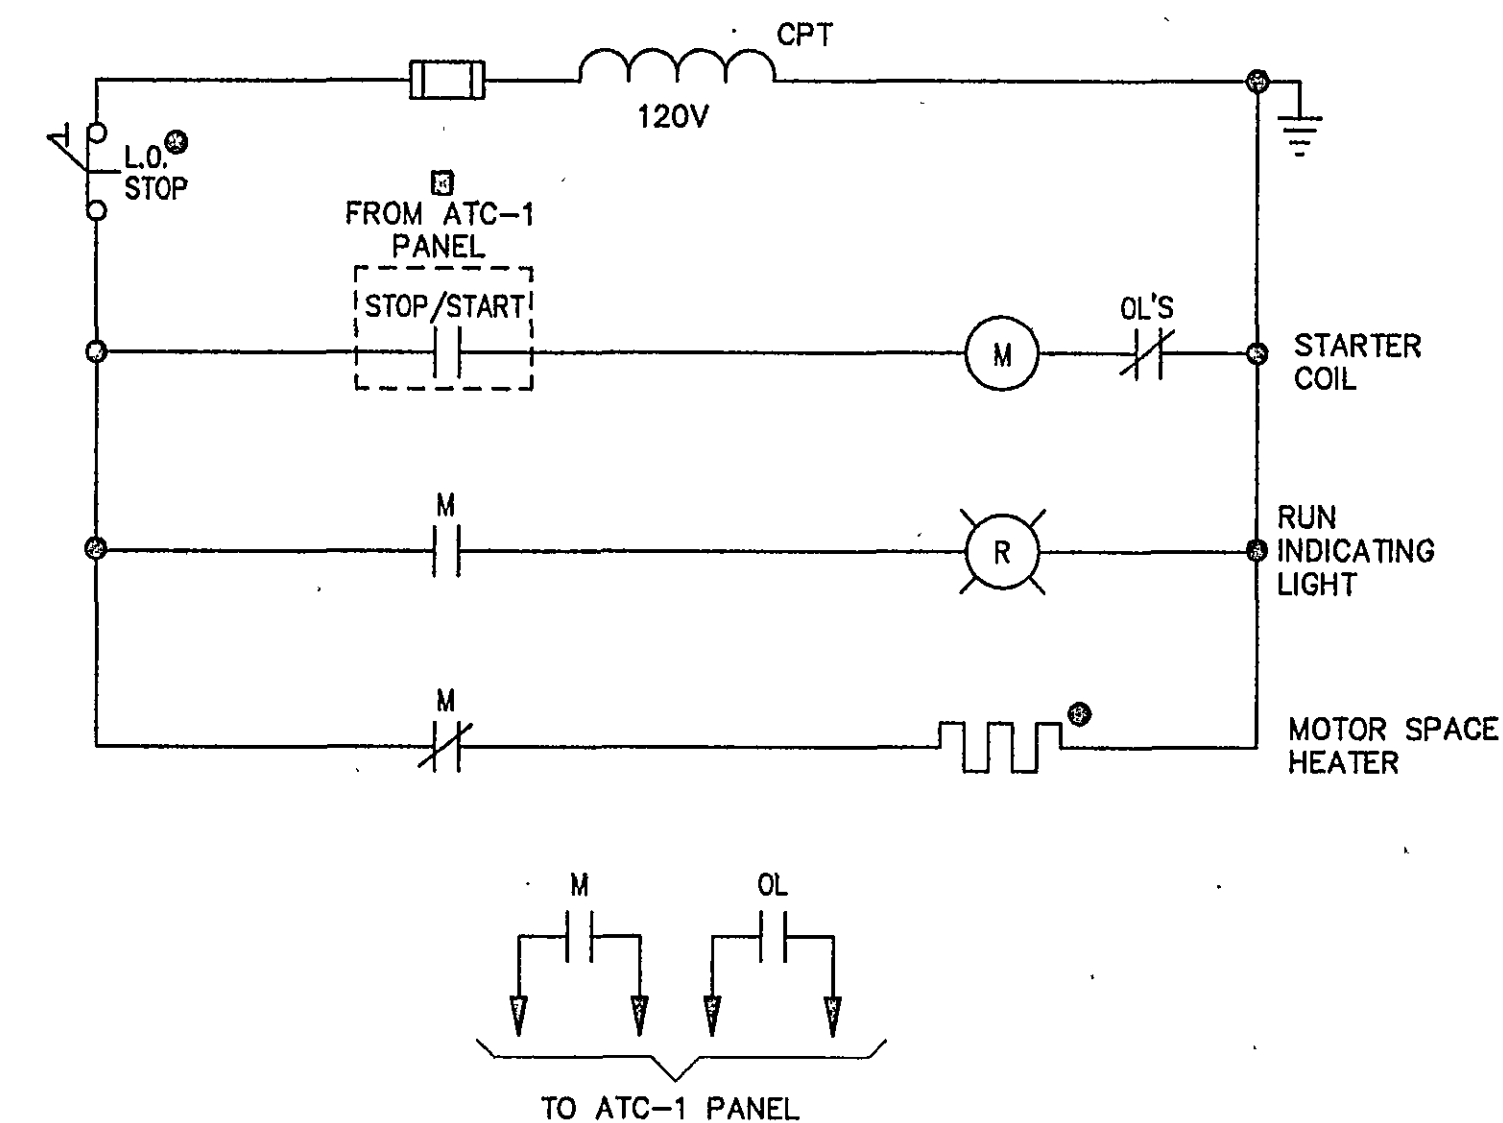

TYPICAL HVAC CONTROL SCHEMATIC

1. TYPICAL FOR EXHAUST FANS B-EF-1, B-EF-2, B-EF-3 & B-EF-4

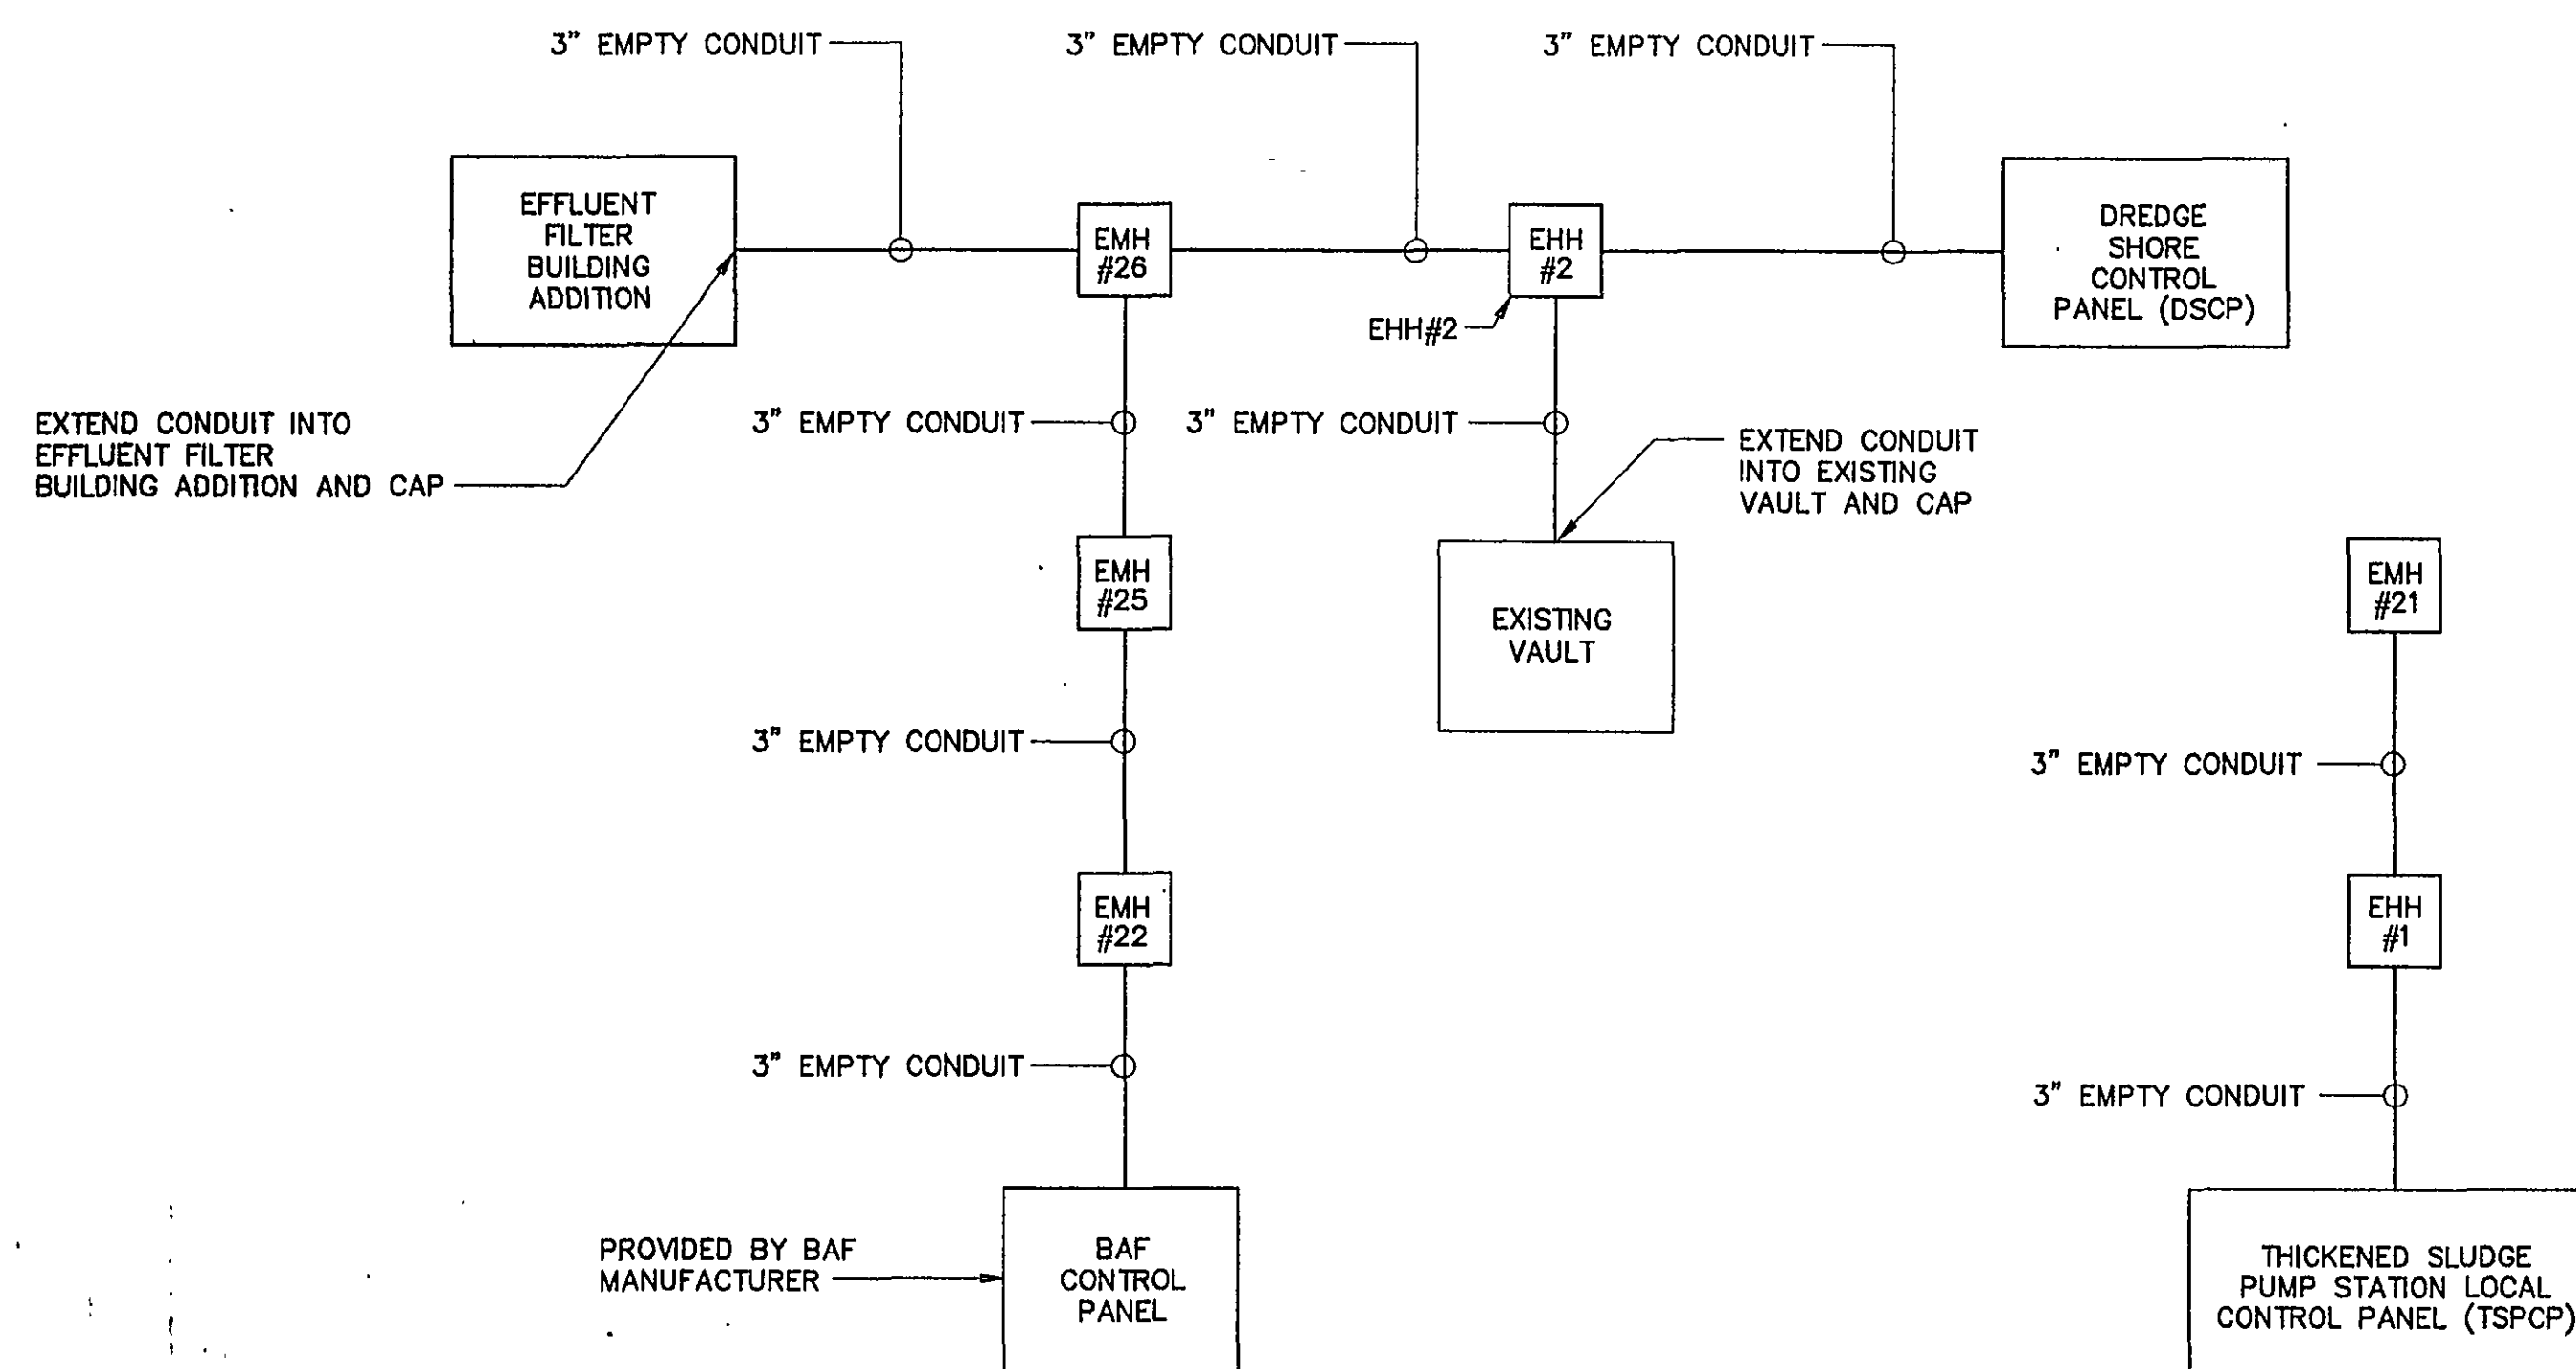


FUTURE SCADA
INTERCONNECTION DIAGRAM

(NOTE: SCADA CONDUITS TO BE RIGID STEEL REGARDLESS OF INSTALLATION)

RECORD DRAWINGS

7/5/1 06002685 E:ACAD (PROJ) 06002685 06002685 Scale: 1:1 Date: 05/02/1997 Time: 11:28

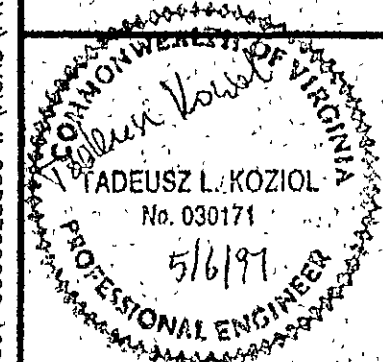

**MALCOLM
PIRNIÉ**
11832 Rook Landing Drive, Suite 400
Newport News, Virginia 23606

NO.	BY	DATE	REVISIONS	REMARKS

DES: GJM
DWN: GJM
CKD: TK



CITY OF ROANOKE, VIRGINIA
WATER POLLUTION
CONTROL PLANT
UPGRADE AND EXPANSION

BIOLOGICAL AERATED FILTER
INTERCONNECTION DIAGRAMS
AND CONTROL SCHEMATICS
SCALE: NONE

COPYRIGHT © 1997
MALCOLM PIRNIÉ, INC.
DATE: MAY 1997
E SHEET 10 OF 36
CAD REF. NO. 0060E685