



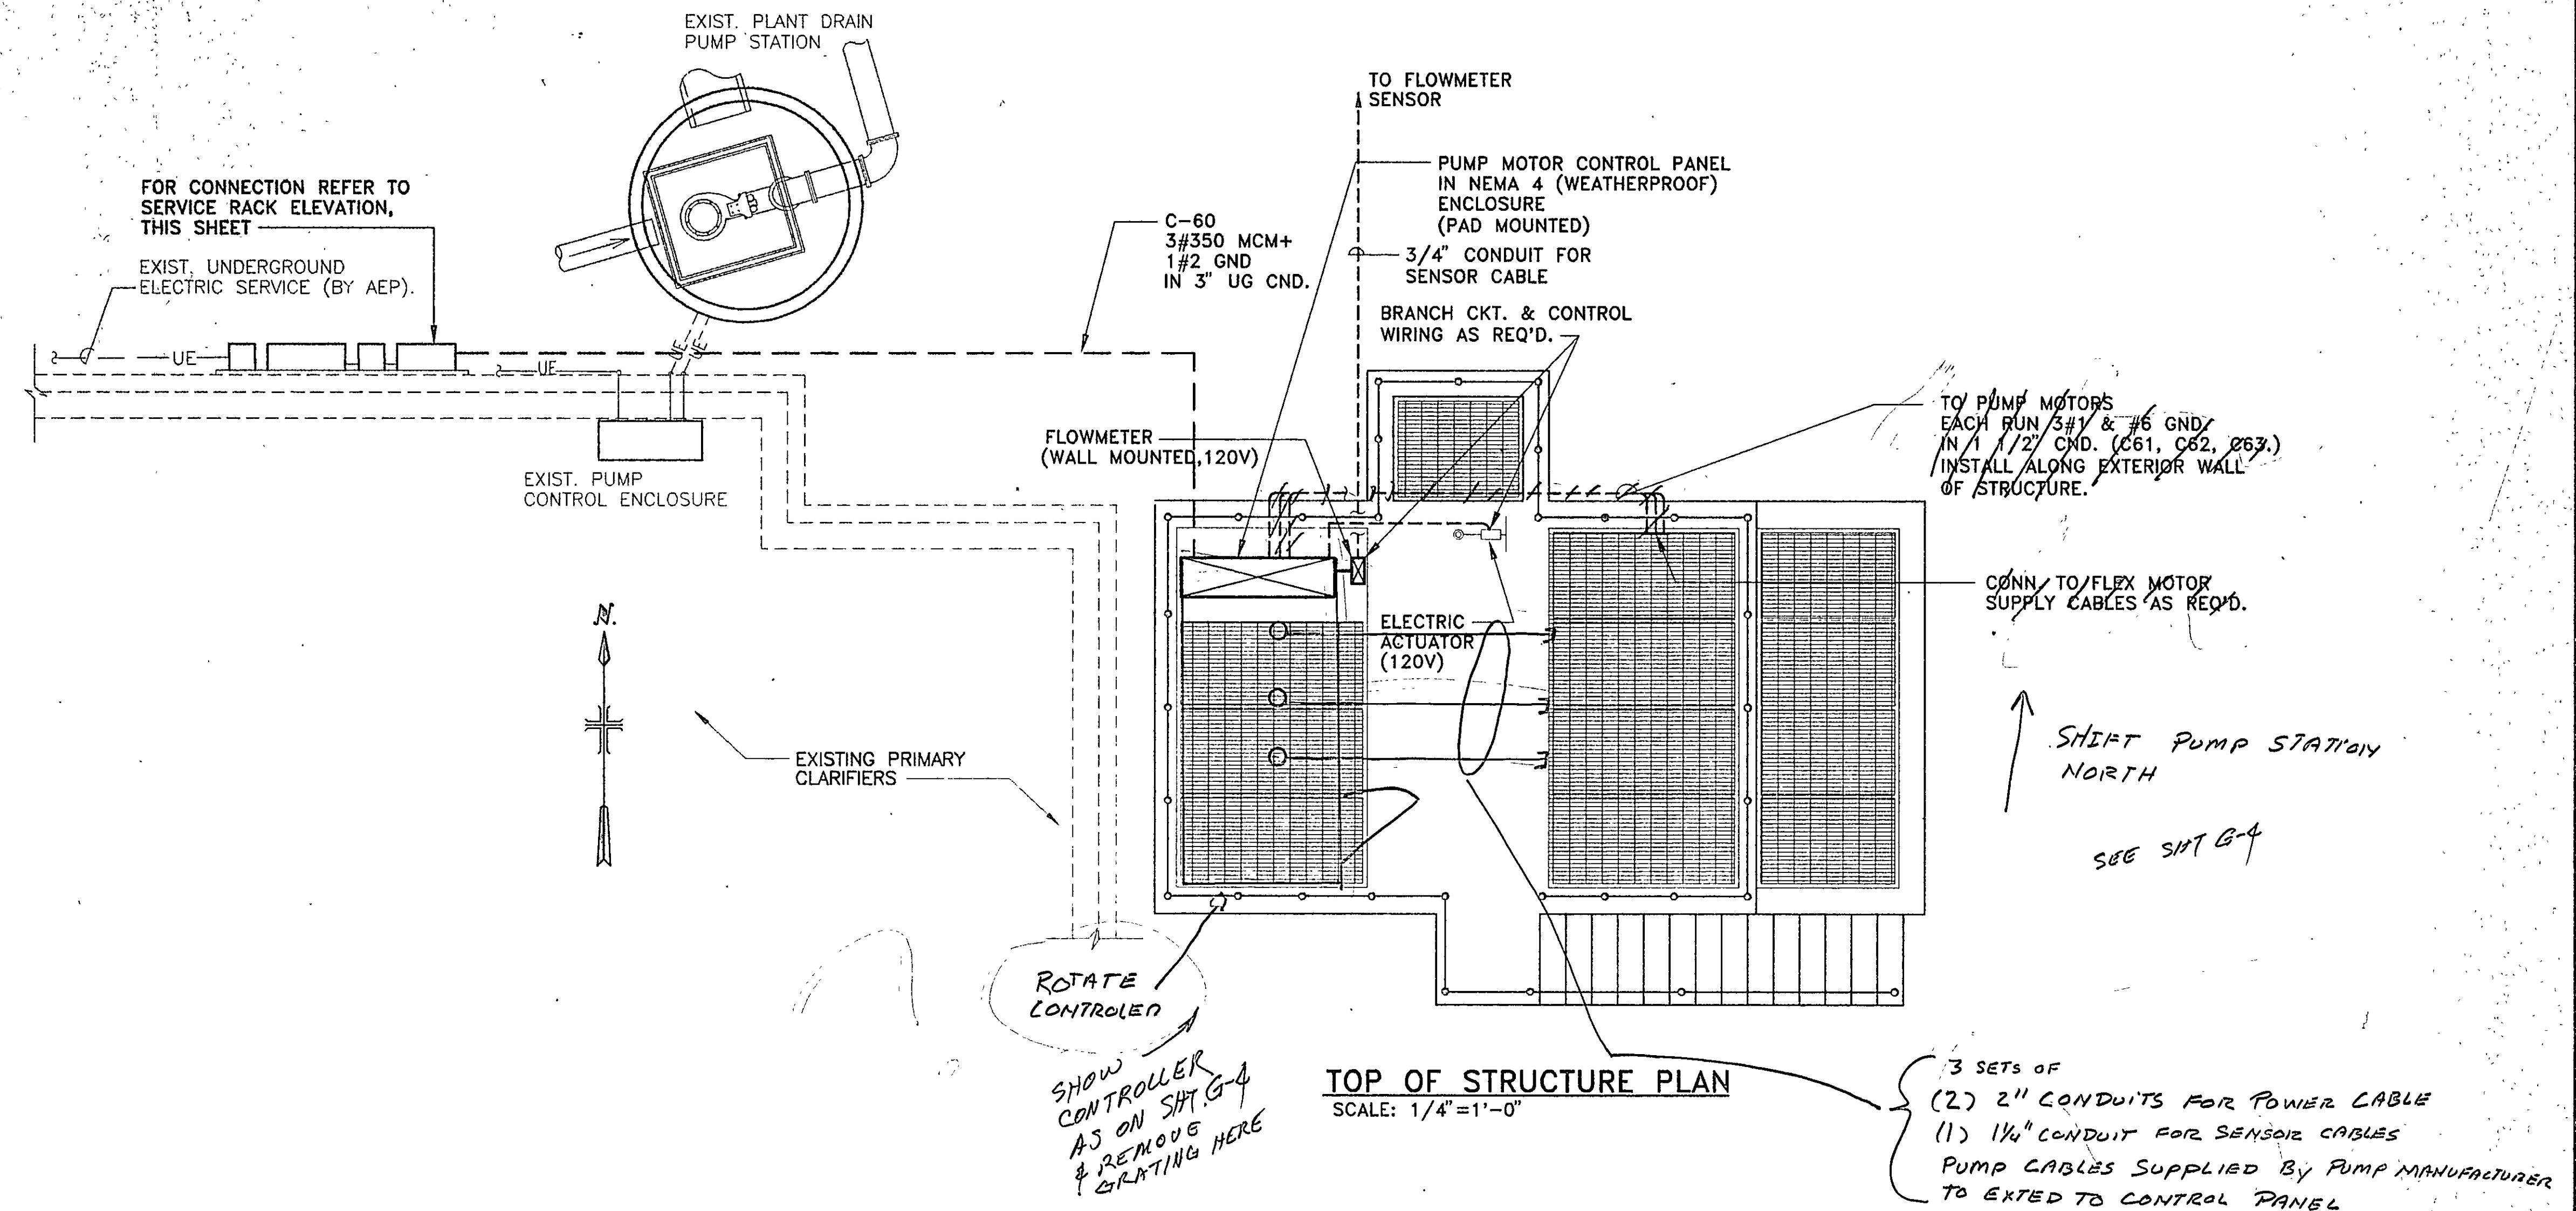

NOTES:

- 1 400A FUSIBLE SWITCH WITH 300A FUSES (NEMA4)
- 2 3 #350MCM + 1 #2/0 GND. IN 3" CND.
- 3 TO PUMP MOTOR CONTROL CENTER (UG)
- 4 EXISTING WIRING TROUGH
- 5 CONNECT TO EXIST. GROUND.

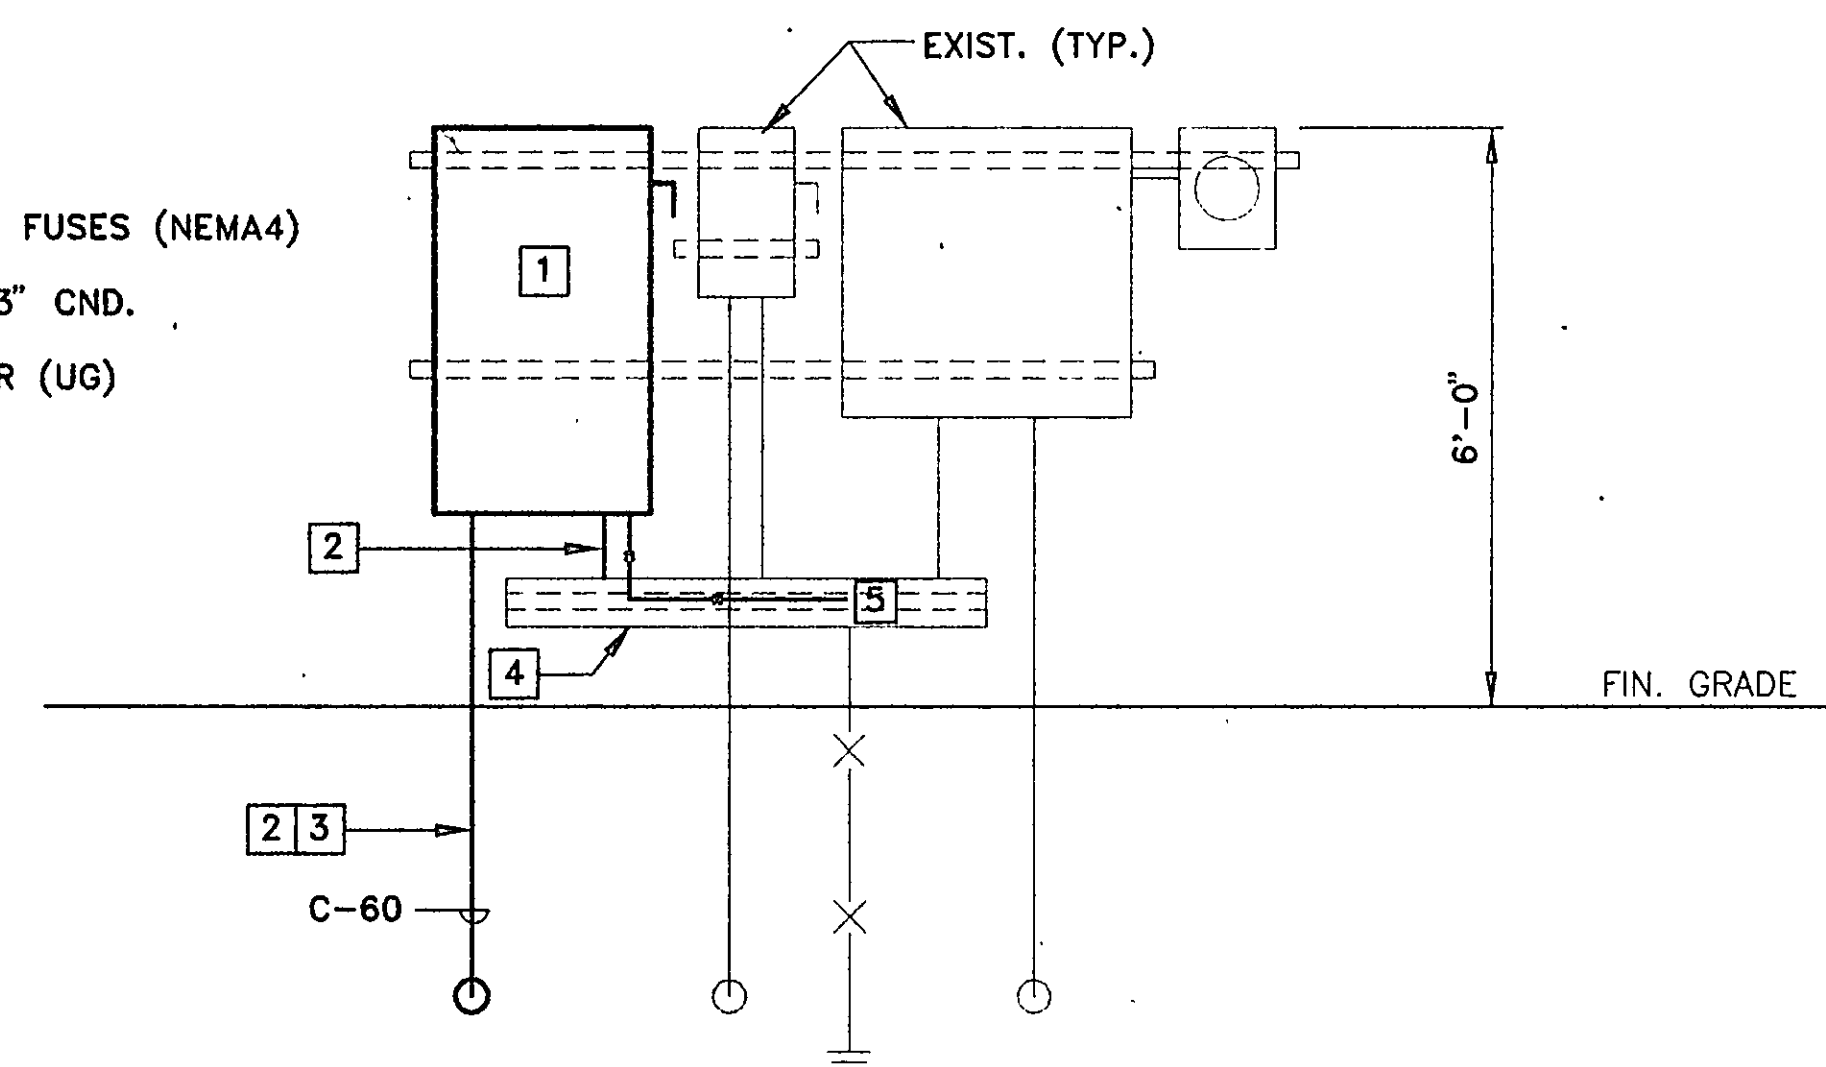

SERVICE RACK ELEVATION
NOT TO SCALE

RECORD DRAWINGS