

1. EQUIP BREAKERS WITH THE FOLLOWING PLUGS:

- a. MAIN BREAKER: 2000 AMP PLUG
- b. INFLUENT PUMP #1: 600 AMP PLUG
- c. FUTURE INFLUENT PUMP #2: 600 AMP PLUG
- d. EXISTING ADMIN BUILDING MCC: 800 AMP PLUG
- e. DISTRIBUTION PANELBOARD DR-1: 225 AMP PLUG
- f. SPARE BREAKERS: 800 AMP PLUG

2. CONDUIT, WIRE AND CONNECTION REQUIREMENTS BETWEEN THE INFLUENT PUMP #1 VFD AND THE HARMONIC FILTER UNIT SHALL BE PROVIDED UNDER SPECIFICATION SECTION 16380 AND 16610.

3. CONTRACTOR SHALL DEMOLISH EXISTING FEEDER CABLES FOR EXISTING MCC 1951 AND REPLACE WITH NEW. RE-USE EXISTING CONDUITS FROM MCC 1951 TO EXISTING JUNCTION BOX (JUNCTION BOX TO BE RE-USED) AND INSTALL NEW CABLES (SIZE AS SHOWN ON DRAWING). ALL CONDUIT, WIRE, TRANSFORMERS ETC. FROM EXISTING JUNCTION BOX TO AEP OVERHEAD SERVICE POLE TO BE DEMOLISHED. COORDINATE DEMOLITION REQUIREMENTS WITH AMERICAN ELECTRIC POWER (AEP) COMPANY.

4. PROVIDE CABLE SUPPORT AND STRAIN RELIEF FITTINGS FOR PROPER TERMINATION IN TERMINAL BOX.

5. CONTRACTOR SHALL PROVIDE WIRING FROM ELECTRIC METER TO METERING CABINET AS DIRECTED BY AEP.



RECORD DRAWINGS

PLANT INFLUENT PUMP STATION SWITCHGEAR SG-3 ONE LINE DIAGRAM



SCALE: NONE

COPYRIGHT © 1997
MALCOLM PIRNIE, INC.

DATE MAY 1997

E SHEET 19 OF 3

CAD REF. NO. 0060E694

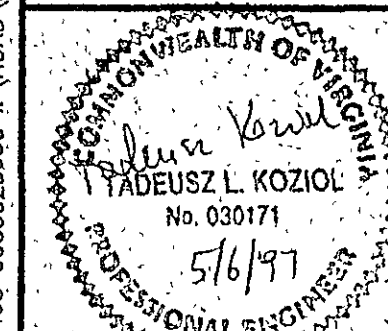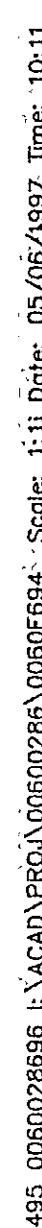

**MALCOLM
PIRNIE**
11892 Rock Landing Drive, Suite
Newport News, Virginia 23609

[illegible]

DES --- GJM
DWN --- GJM
TK



CITY OF ROANOKE, VIRGINIA
WATER POLLUTION
CONTROL PLANT
UPGRADE AND EXPANSION

PLANT INFLUENT PUMP STATION
SWITCHGEAR SG-3
ONE LINE DIAGRAM
SCALE: NONE