



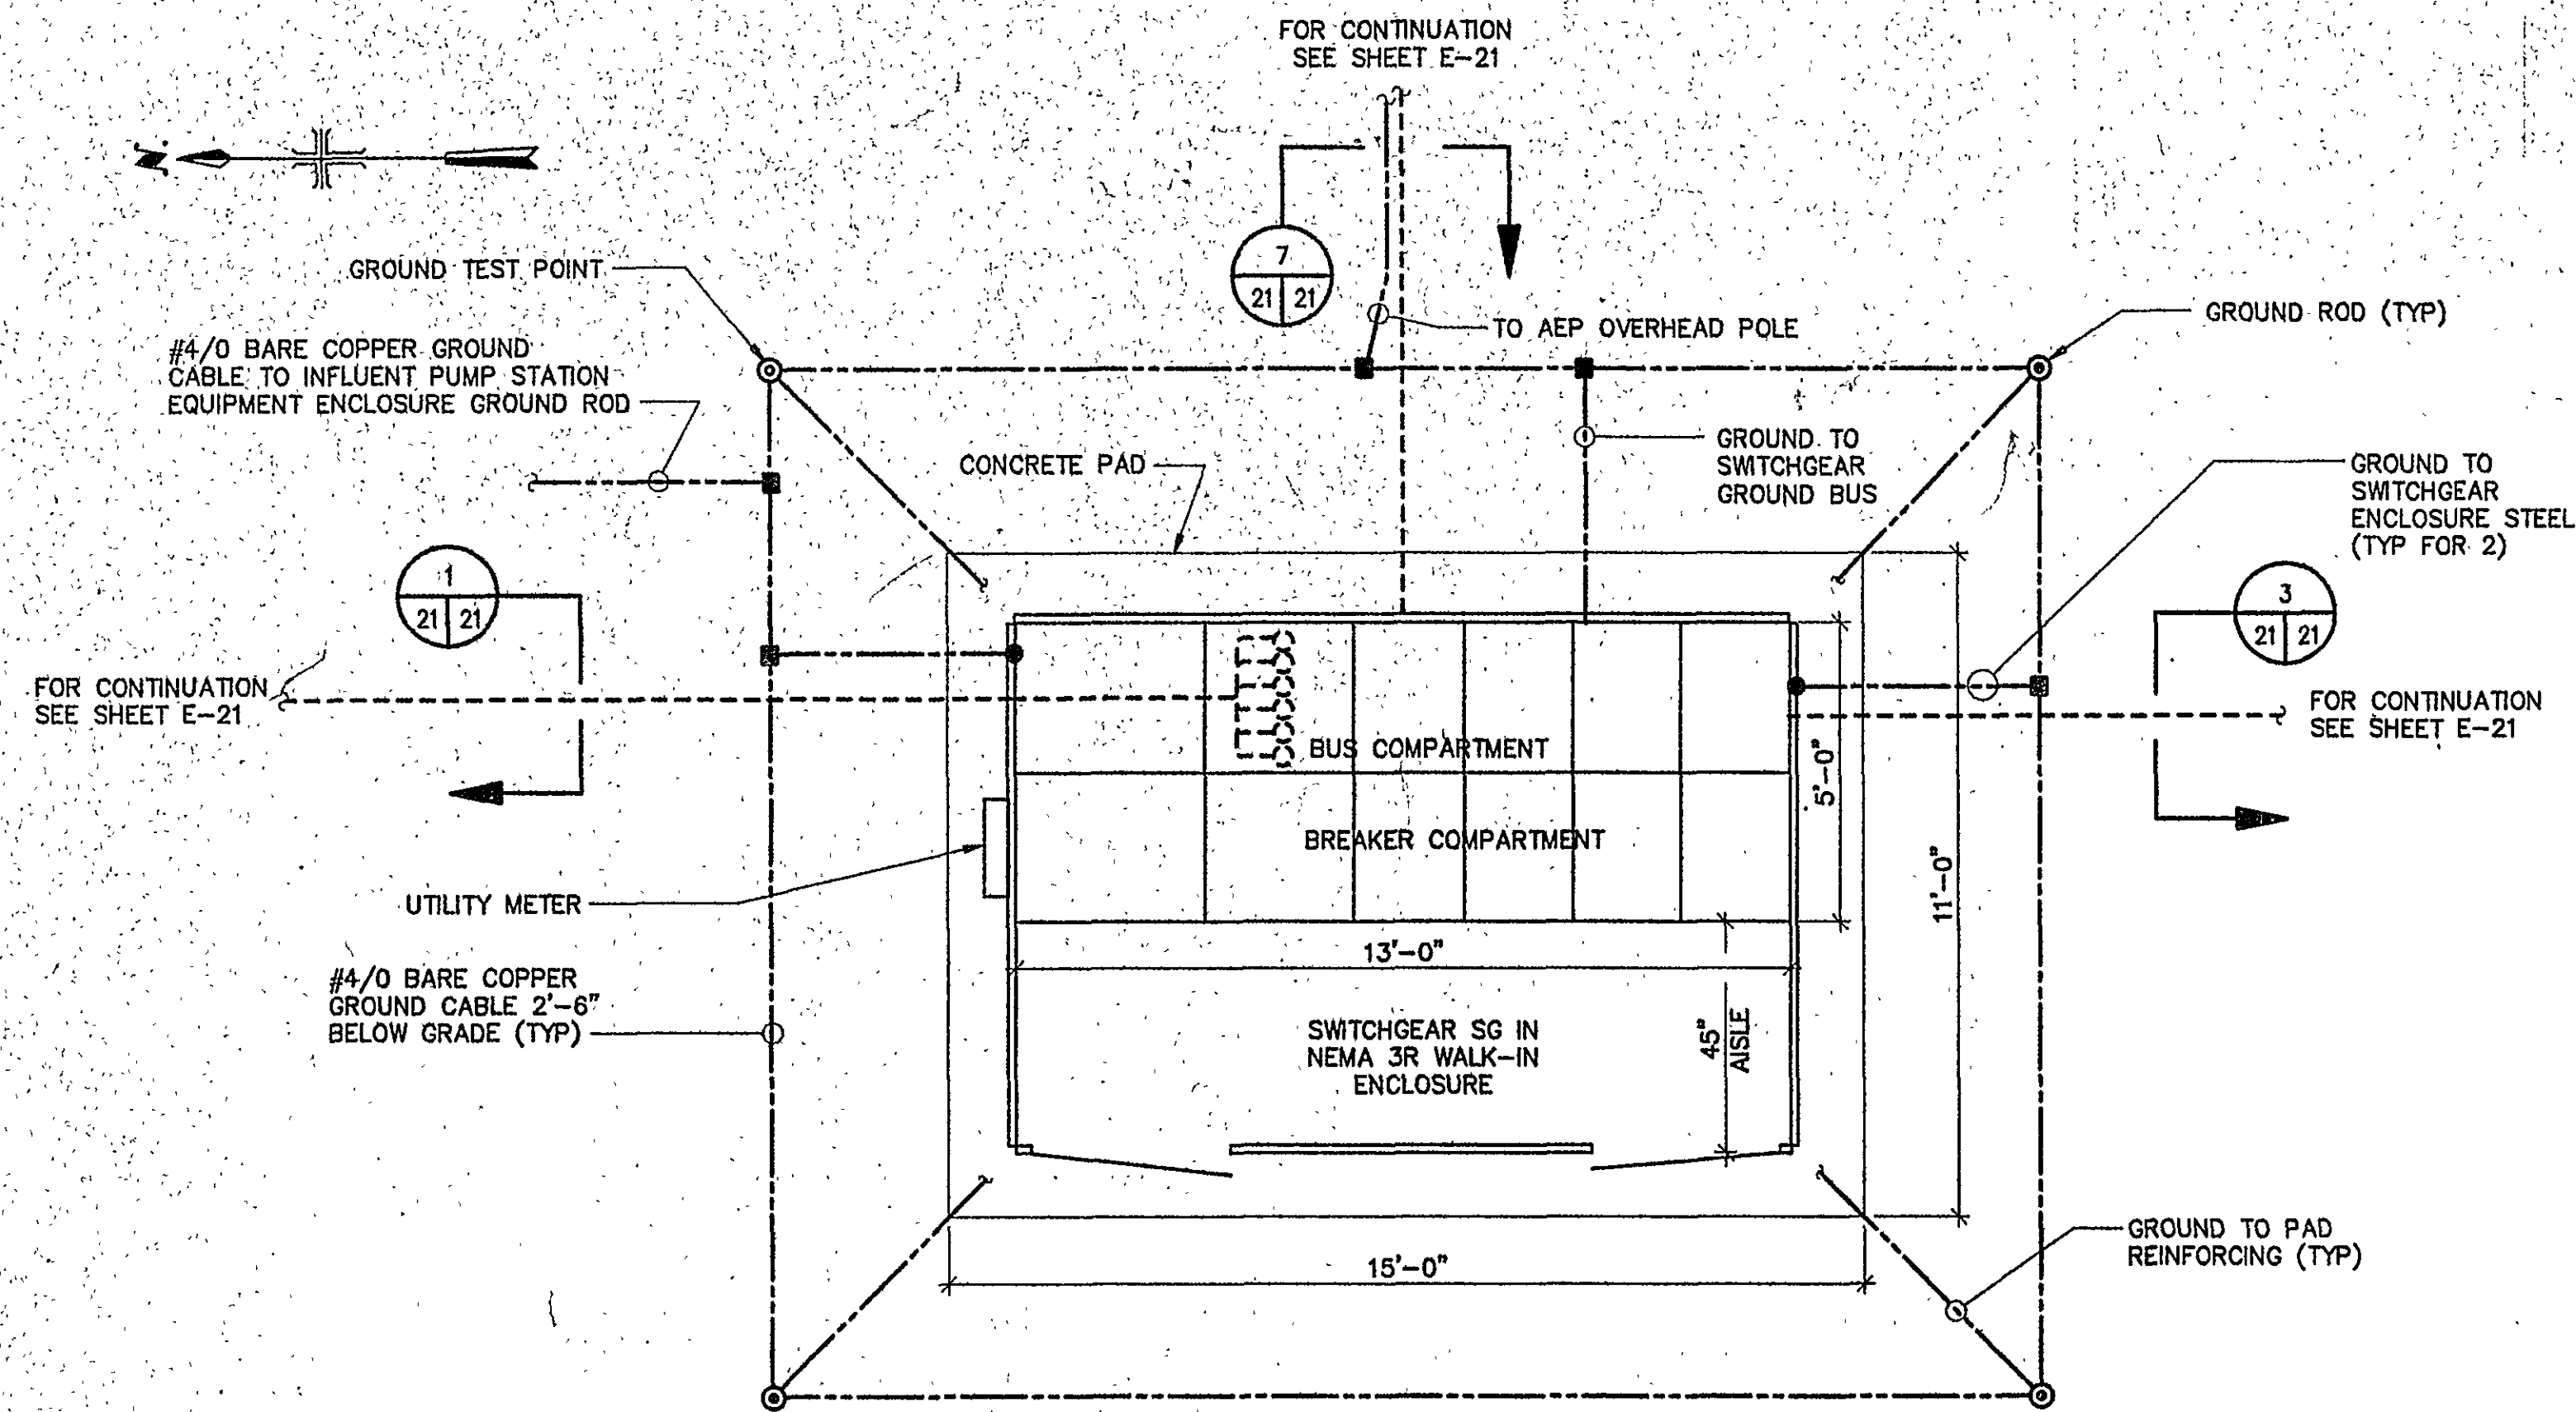


SWITCHGEAR SG-3 PLAN

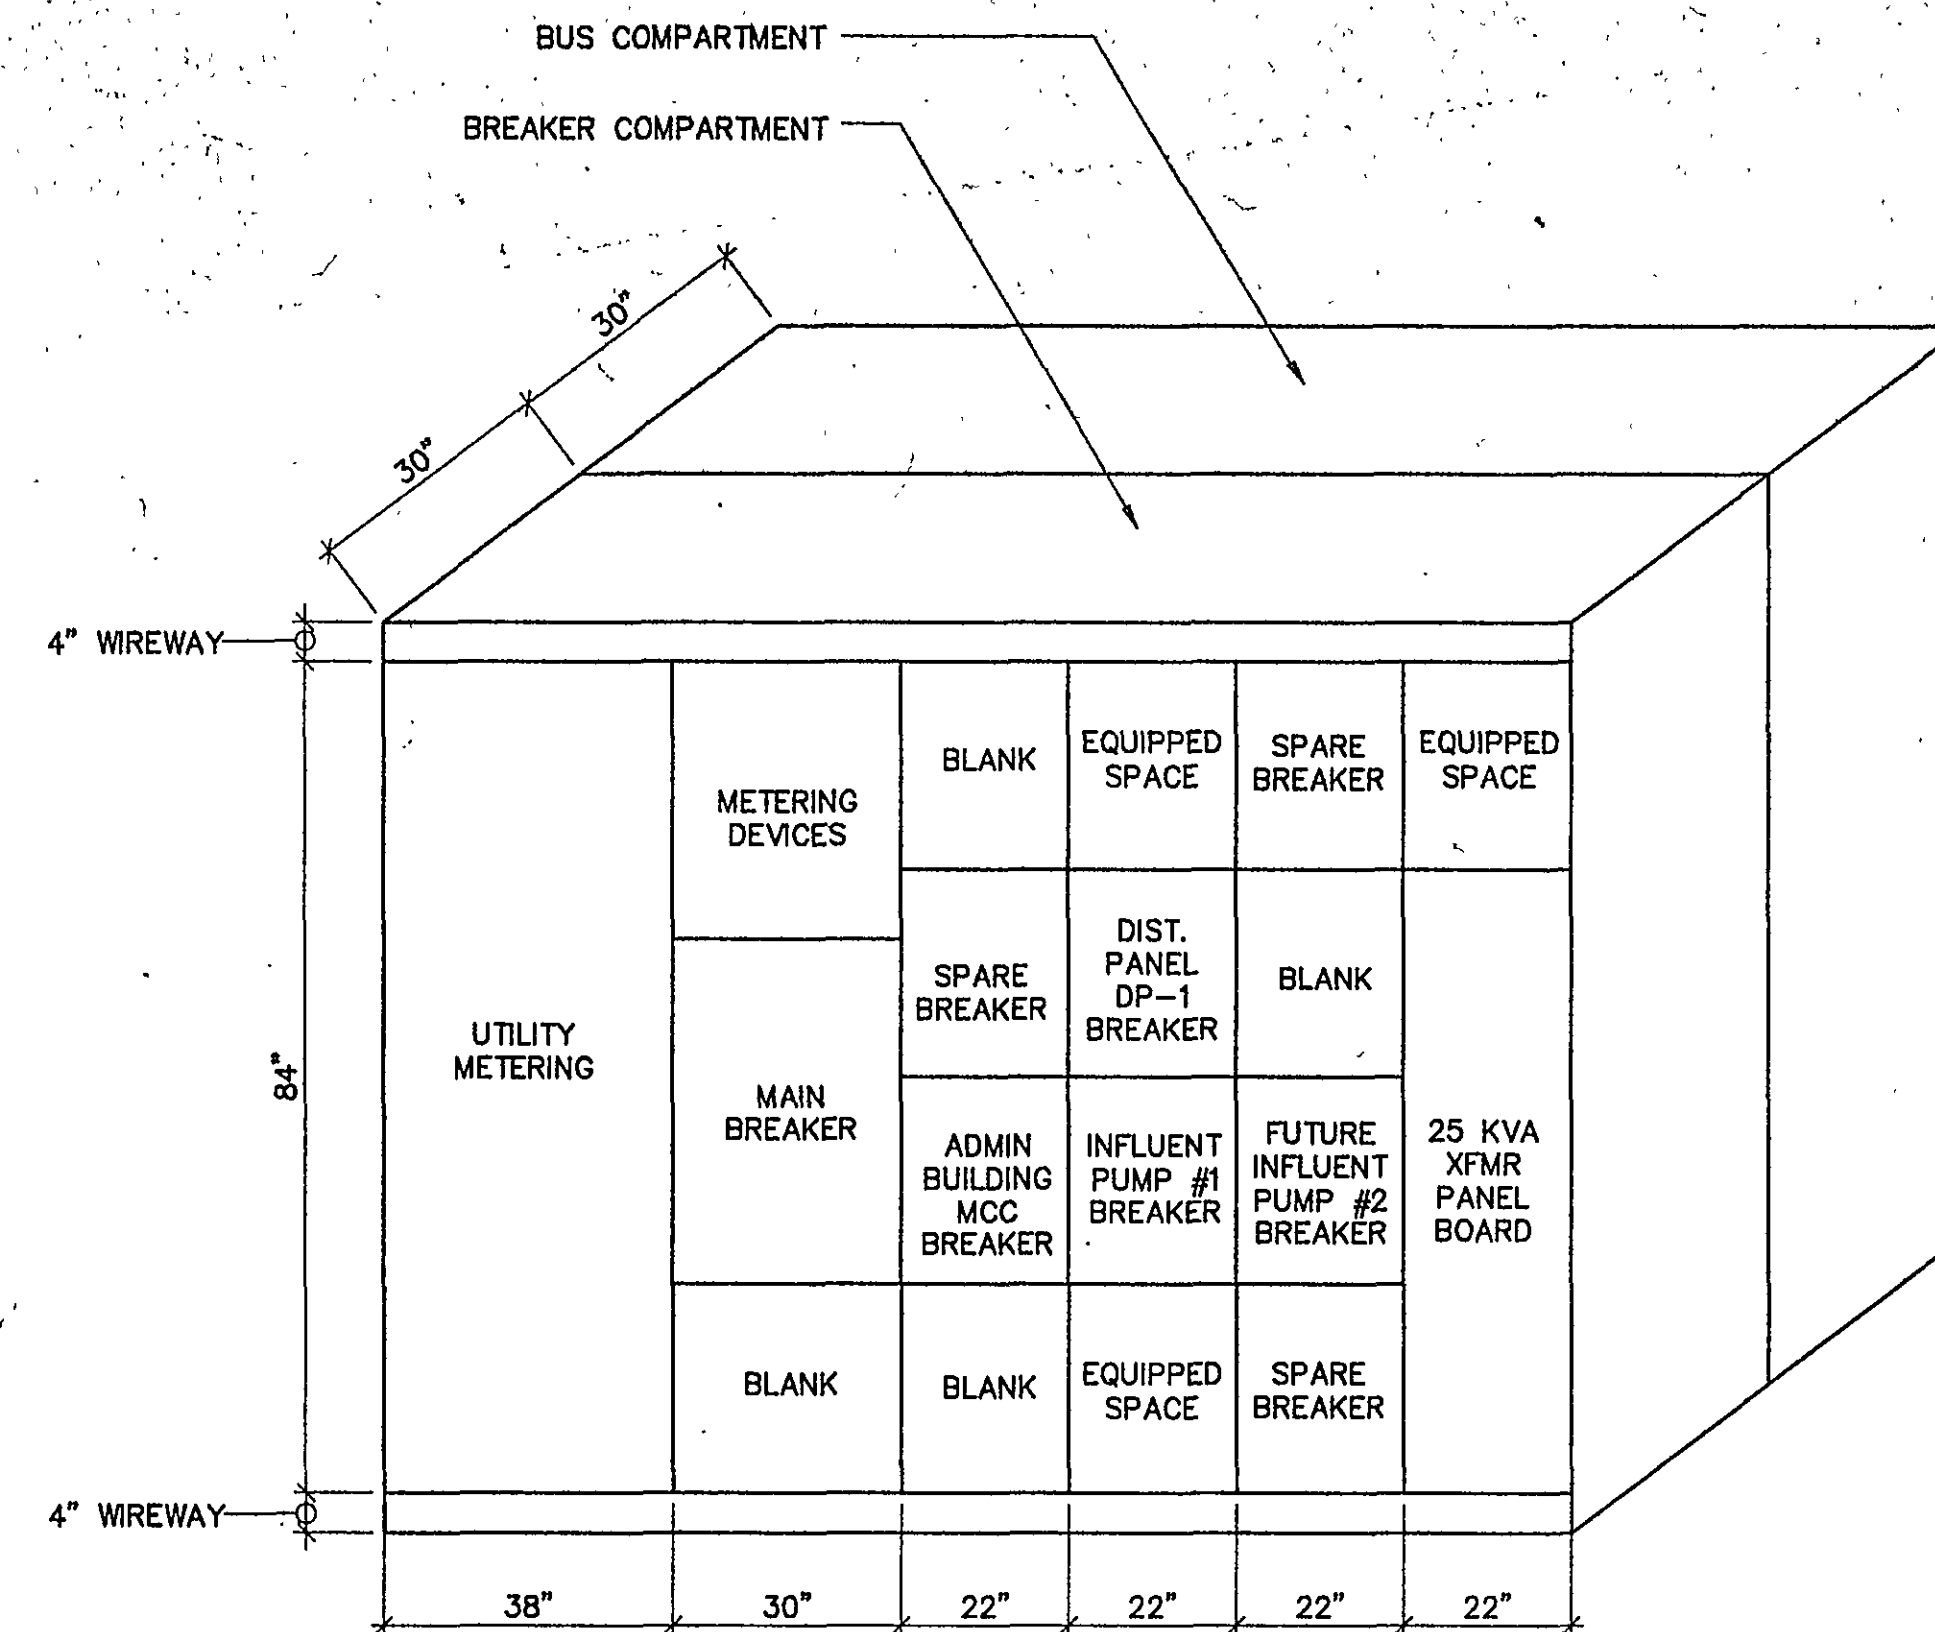

SWITCHGEAR SG-3 FRONT VIEW


N.T.S.
(SEE NOTE #3)
NOTE: EQUIPMENT PAD AND NEMA 3R WALK-ENCLOSURE NOT SHOWN

- NOTES:
1. FOR AREA CLASSIFICATION SEE SHEET E-21
 2. STUB CONDUITS UP INSIDE BUILDING AND ROUTE TO EQUIPMENT. SEE INTERCONNECTION DIAGRAM ON SHEET E-22 AND ONE LINE DIAGRAM ON SHEET E-19 FOR CONDUIT AND WIRE REQUIREMENTS. PROVIDE CONDUIT RULLING POINT (LBD FITTINGS OR PULL BOXES) AS REQUIRED.
 3. SWITCHGEAR SG-3 DIMENSIONS ARE APPROXIMATE AND MAY VARY BASED ON THE MANUFACTURER OF EQUIPMENT.
 4. COORDINATE THE INSTALLATION OF CONDUITS WITH HVAC LOUVER.

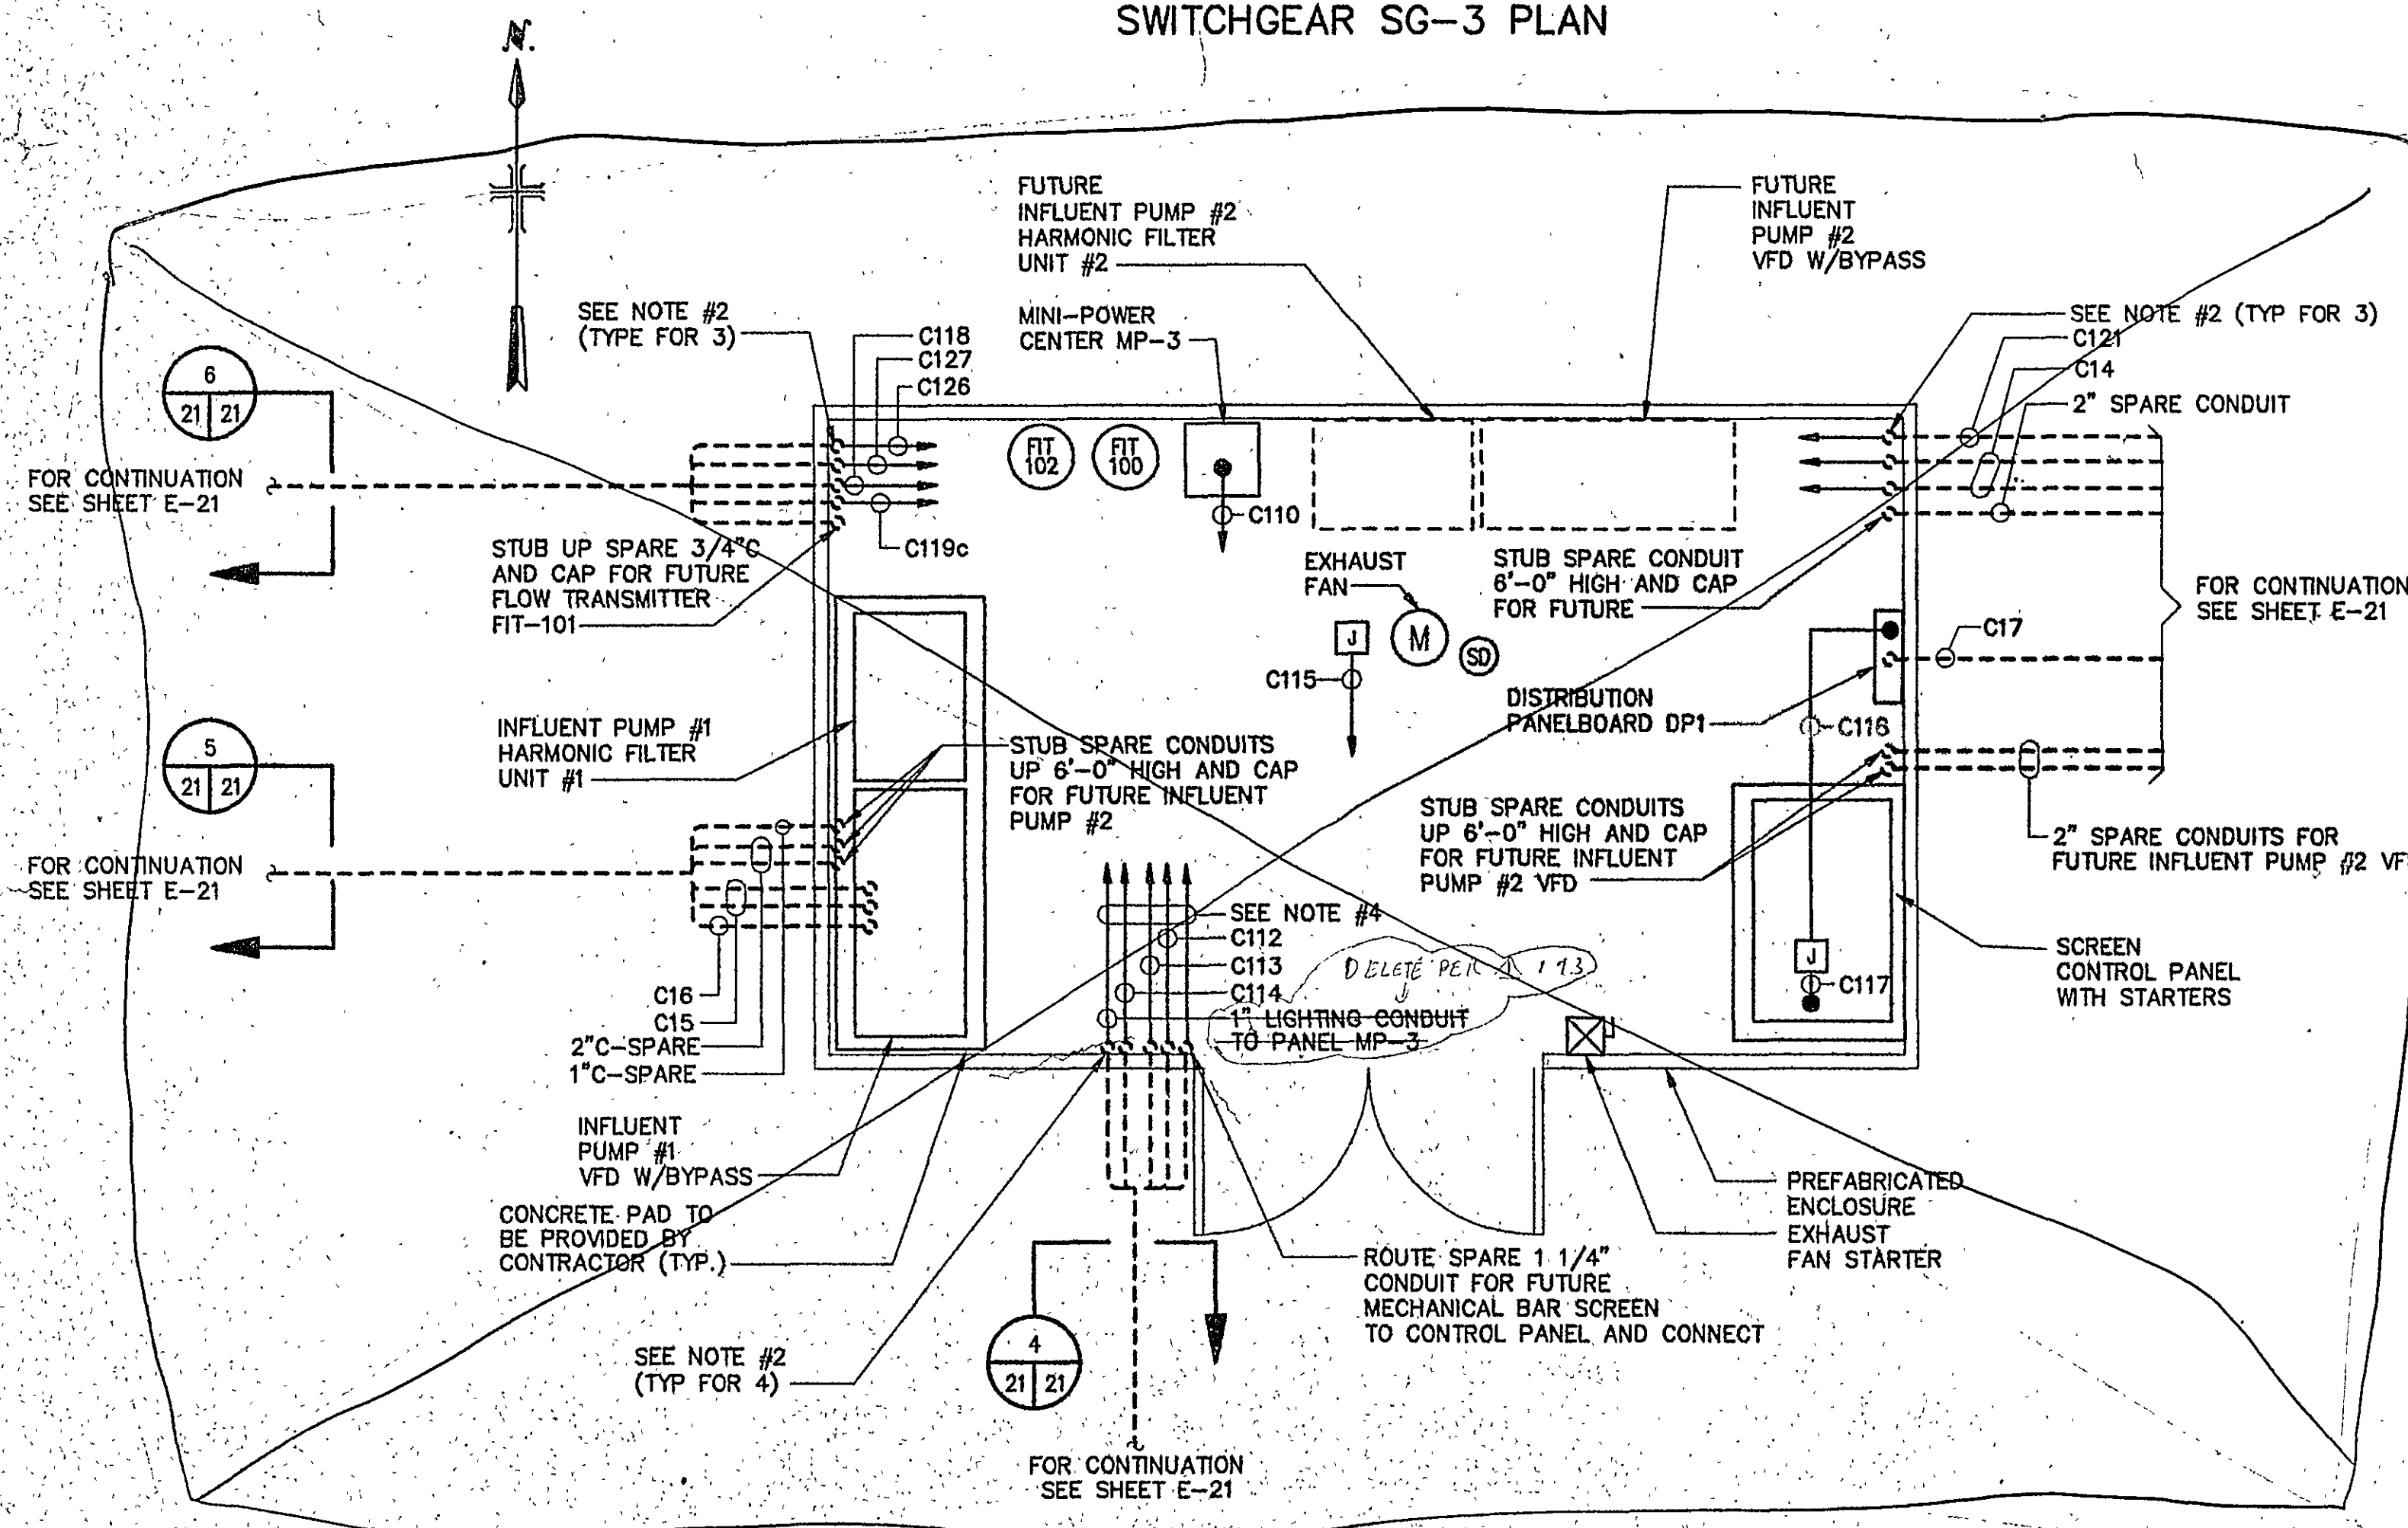

EQUIPMENT ENCLOSURE-POWER PLAN

SEE SHEET
E 20A

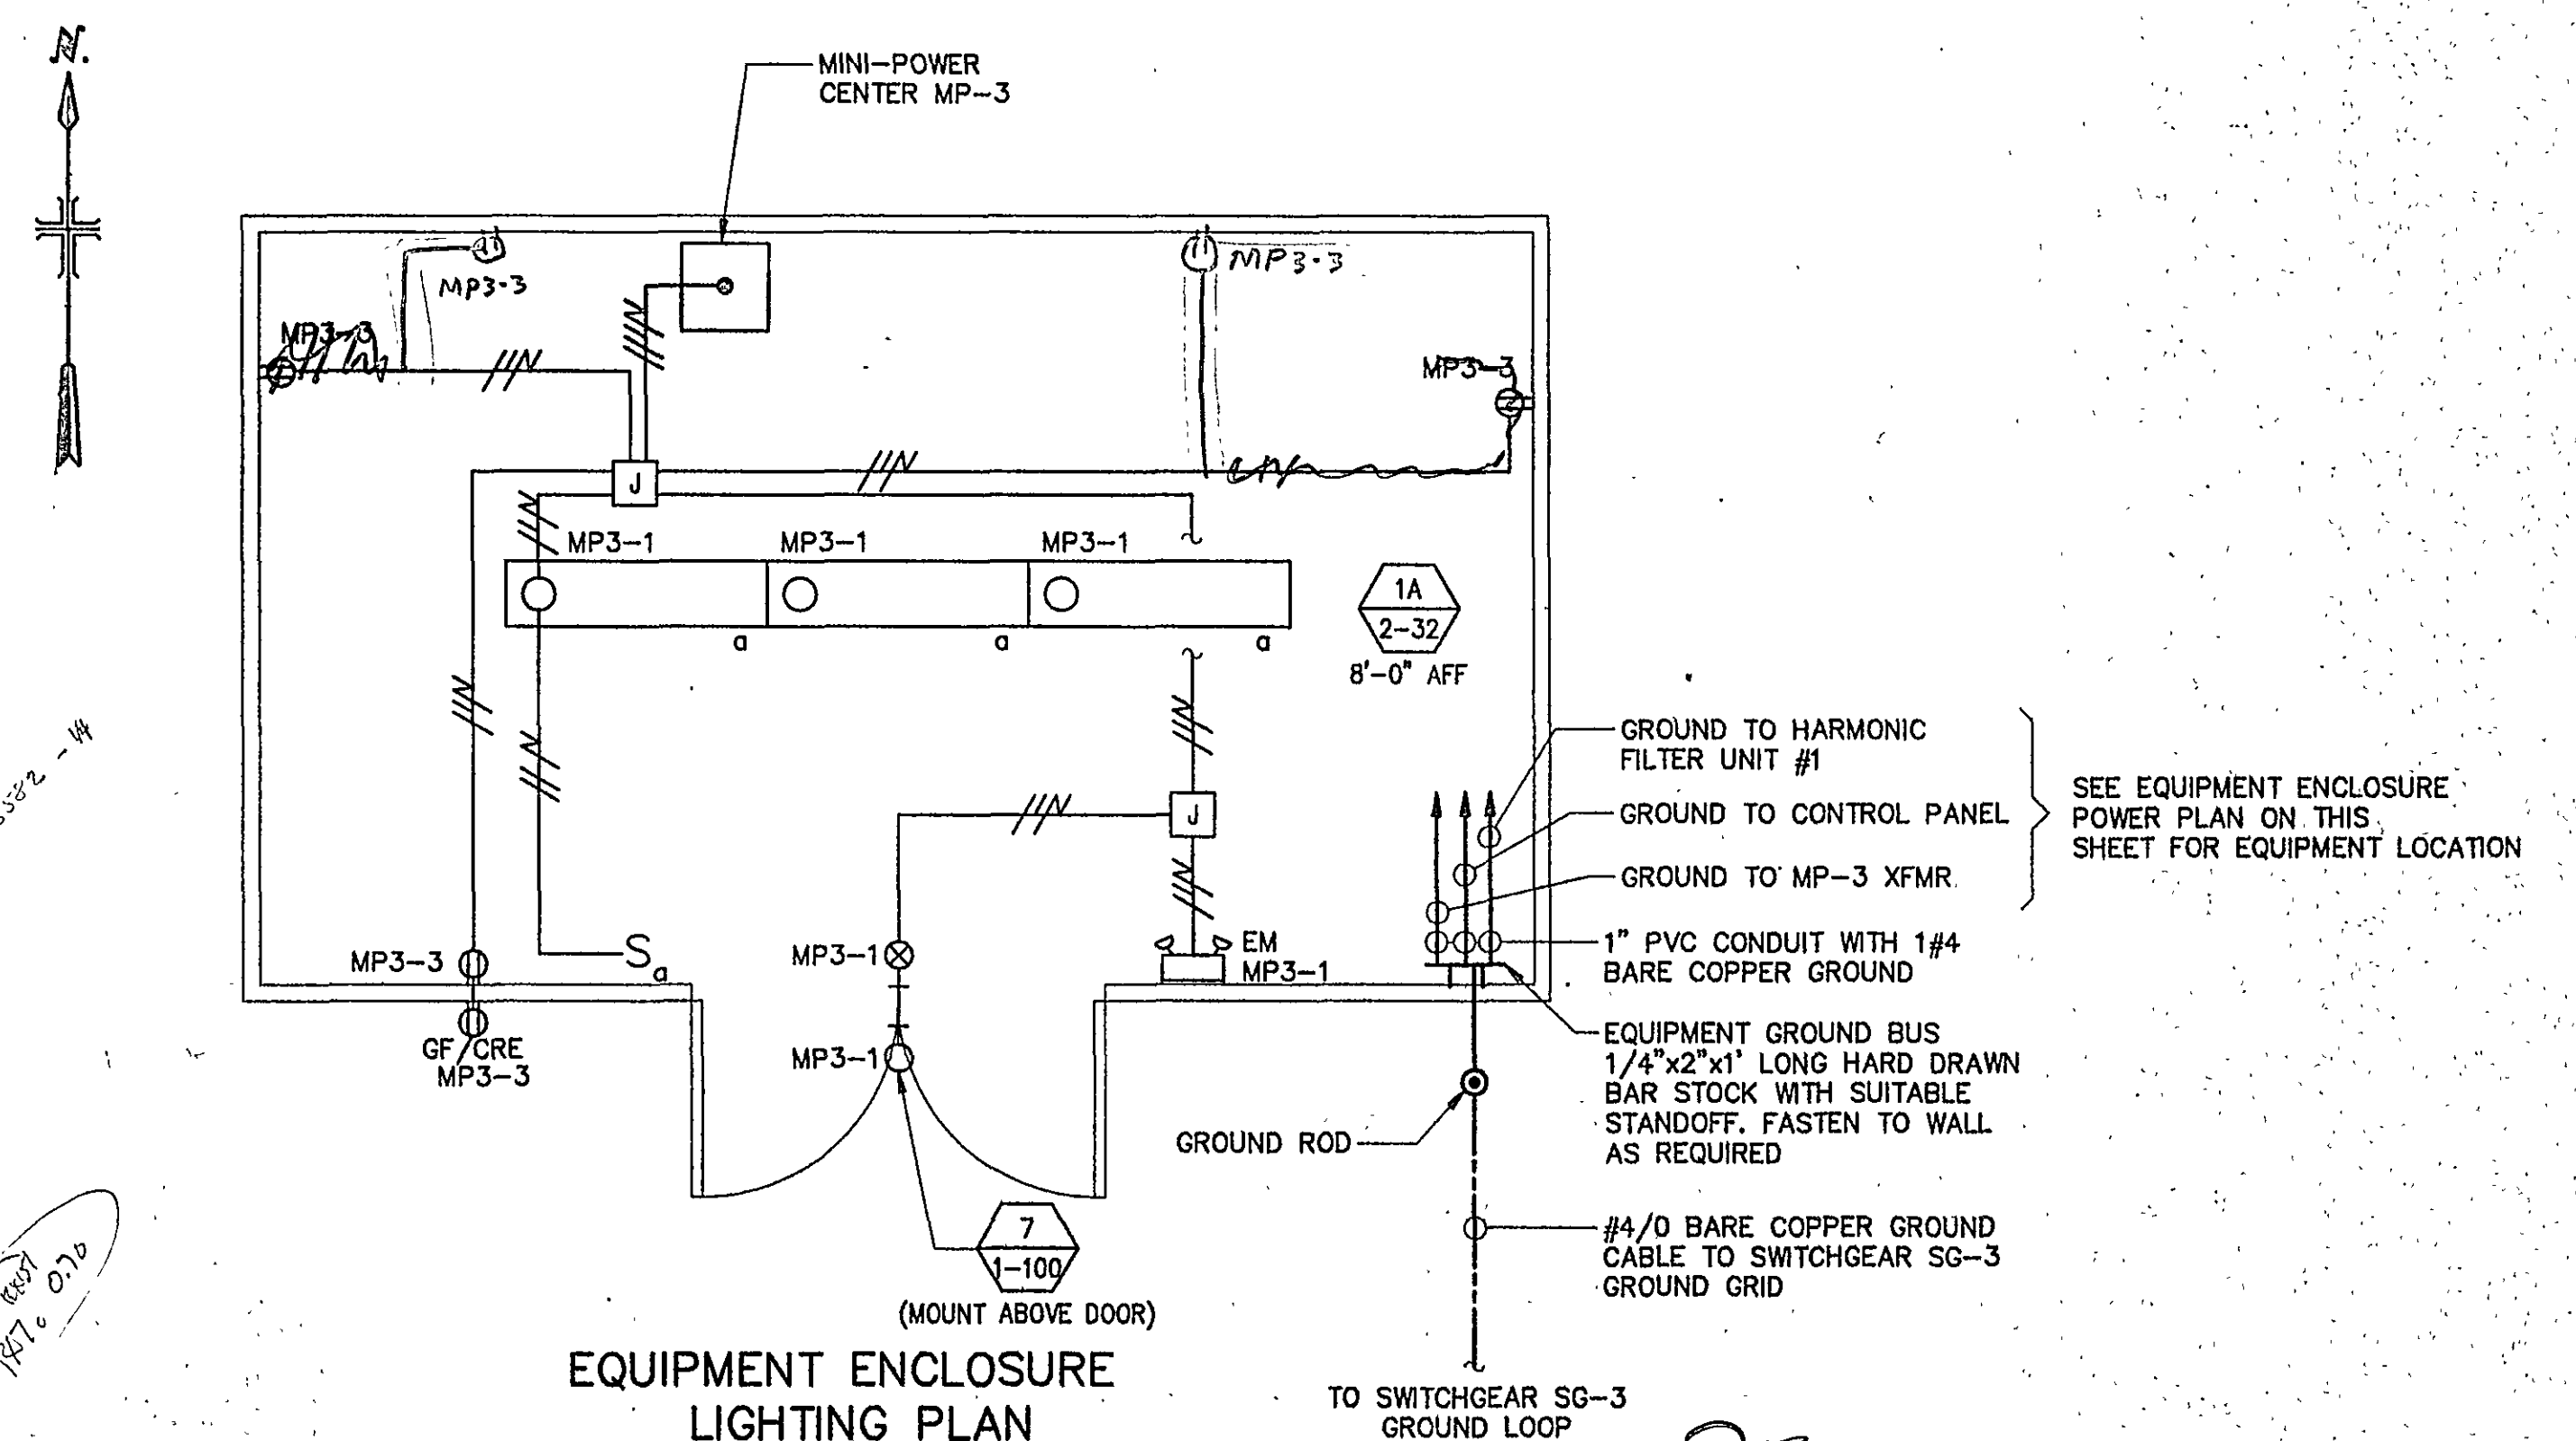

EQUIPMENT ENCLOSURE
LIGHTING PLAN

TO SWITCHGEAR SG-3
GROUND LOOP

RECORD DRAWING