



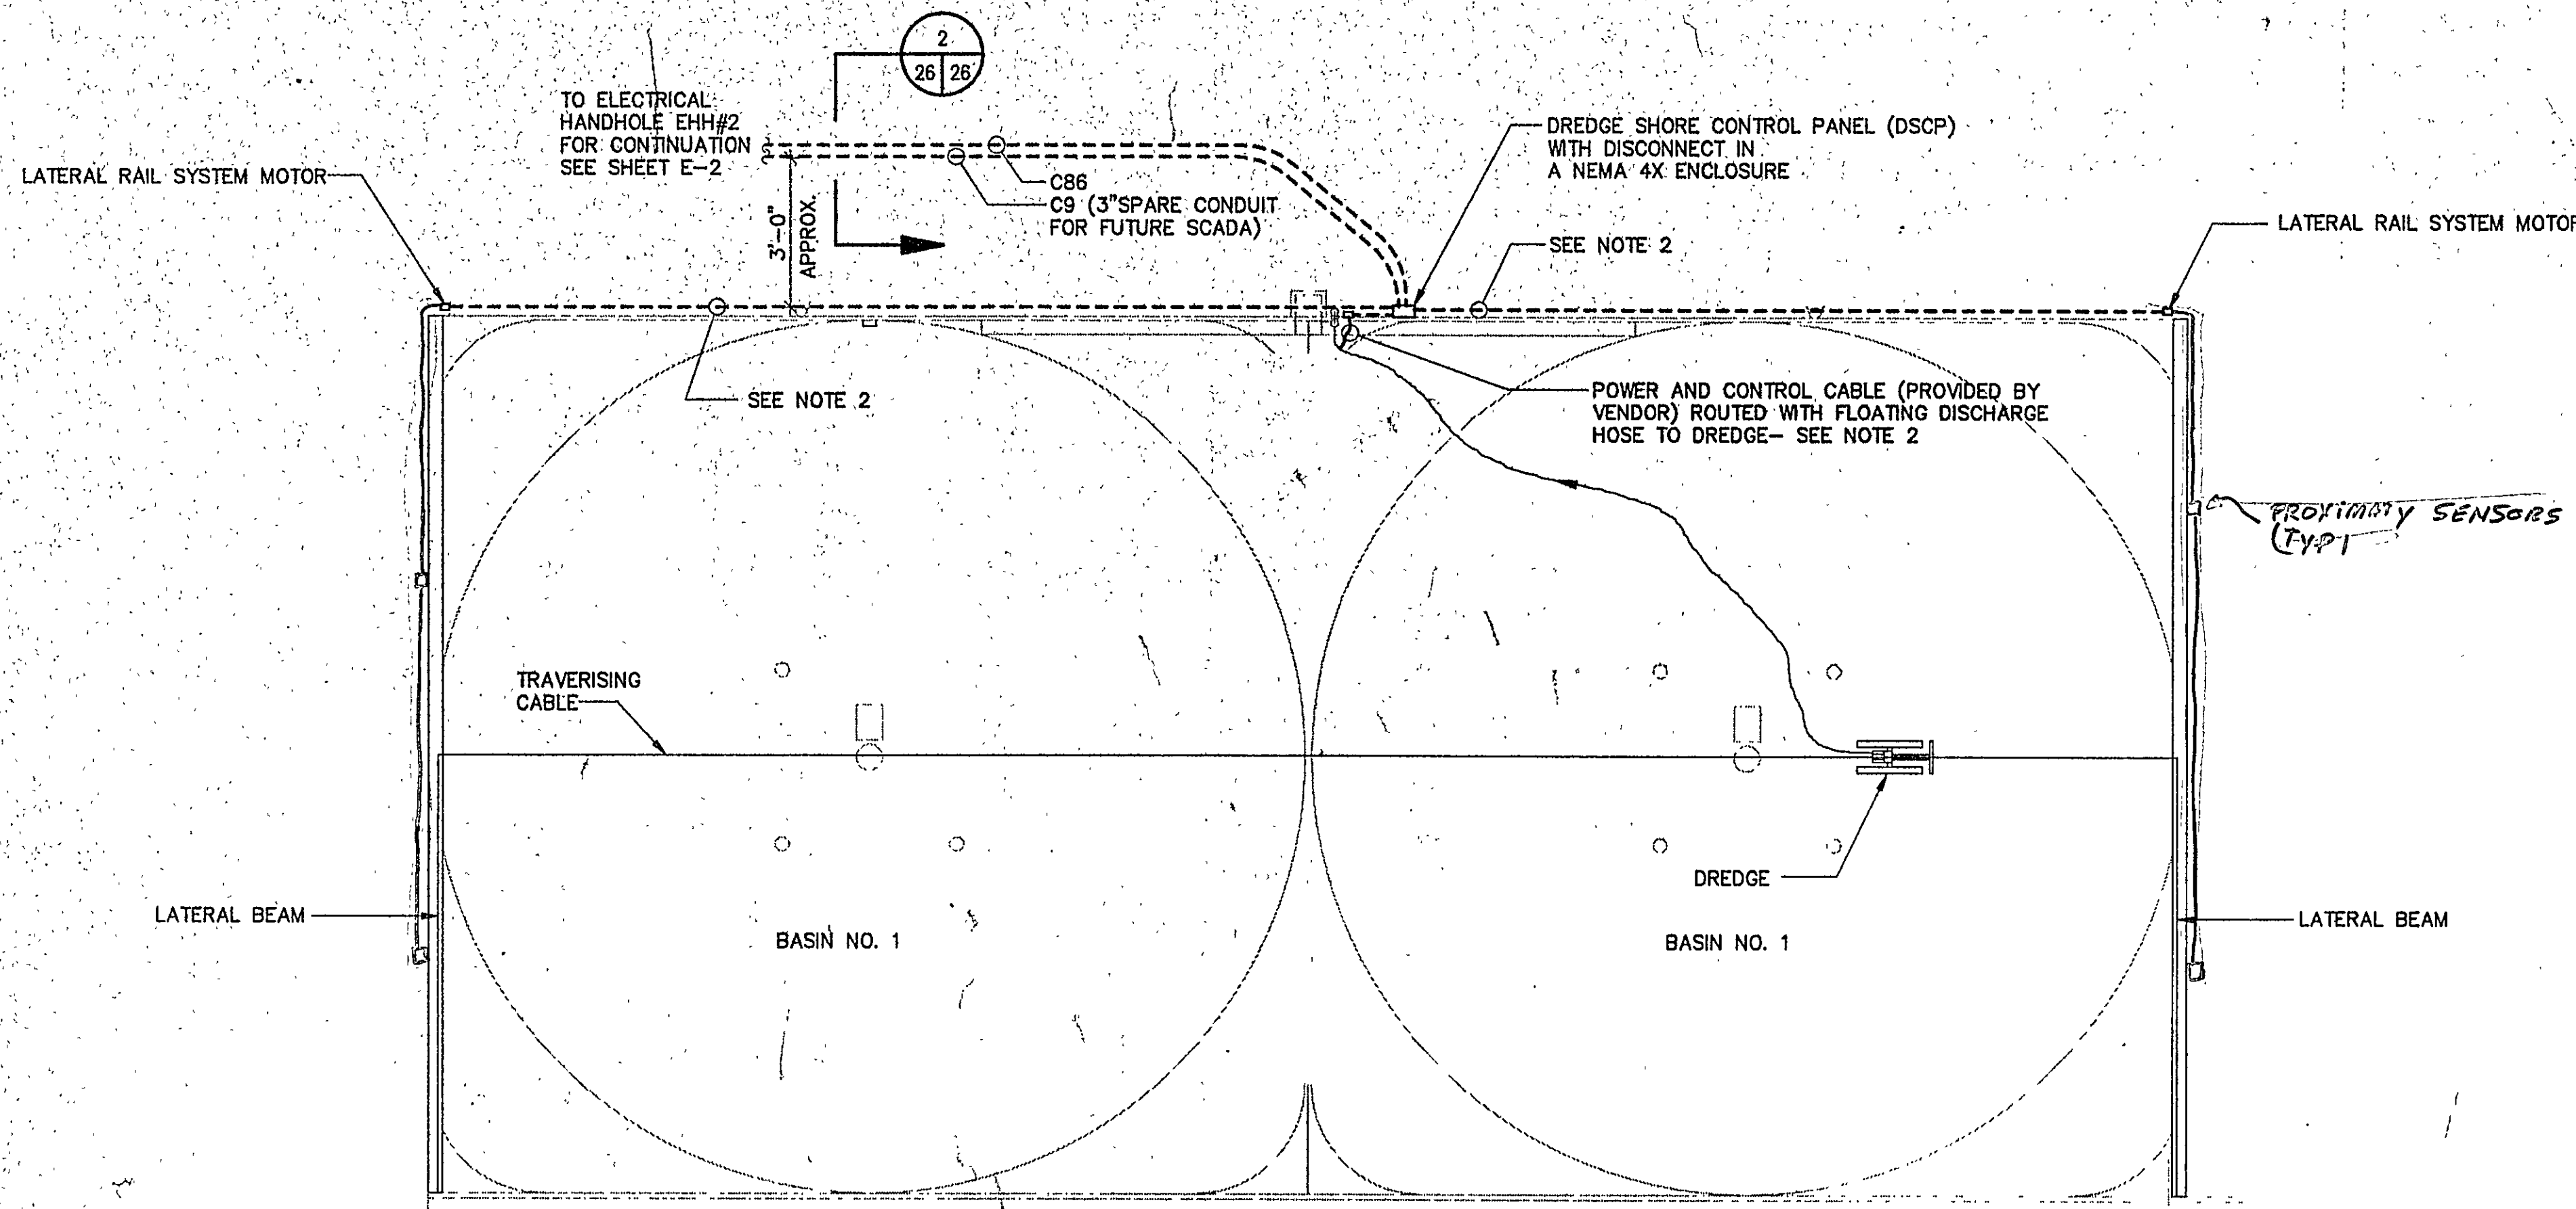


EQUALIZATION BASIN
PARTIAL PLAN
(SCALE: 1"=30'-0")


- NOTES:
1. AREA CLASSIFICATION:
a. OUTDOOR AREAS SHALL BE CONSIDERED WET LOCATIONS. ALL EXPOSED CONDUITS SHALL BE RIGID STEEL PVC COATED. ENCLOSURES SHALL MEET NEMA 4X REQUIREMENTS.
 2. ALL CONDUITS, WIRES, BOXES, ETC. FROM DREDGE SHORE CONTROL PANEL (DSCP) TO FIELD EQUIPMENT (FLOATING DREDGE HYDRAULIC PUMP ETC.) SHALL BE PROVIDED UNDER SPECIFICATION SECTION 11340.
 3. DISCONNECT EXISTING 3Ø, 480V FEEDER AND RECONNECT NEW FEEDER (C97).

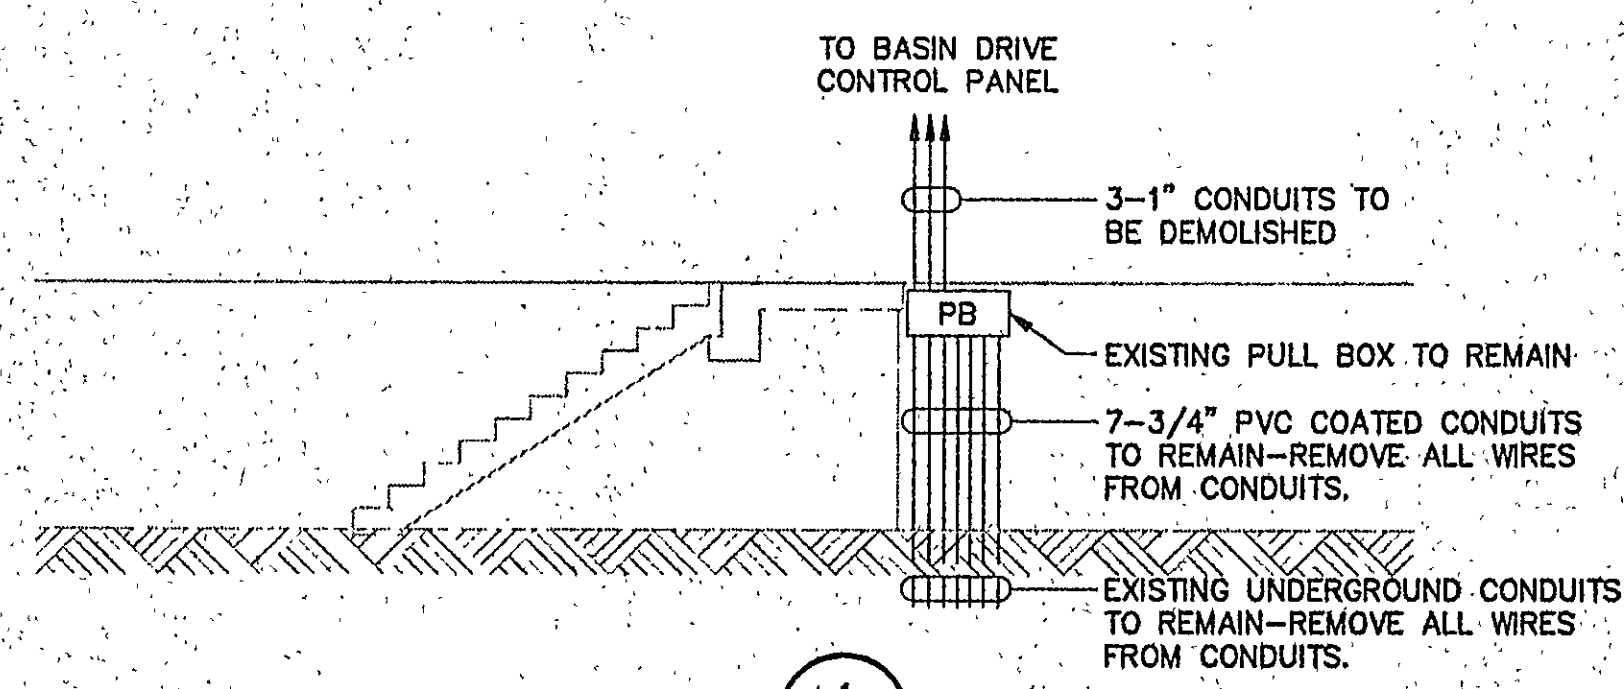

SECTION 1
26 26
N.T.S.

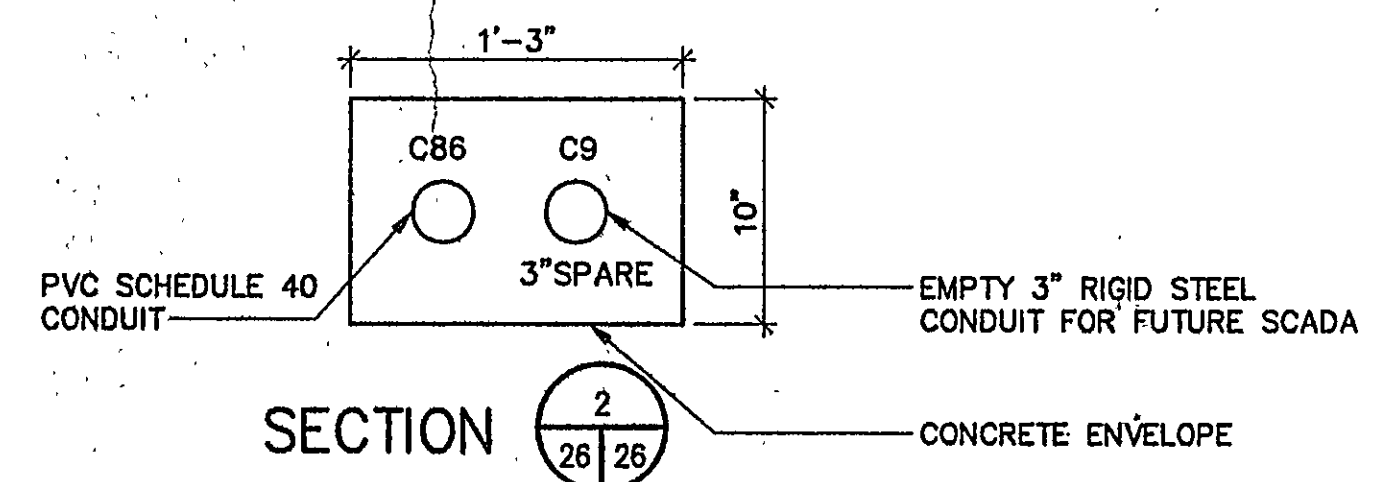

SECTION 2
26 26
N.T.S.

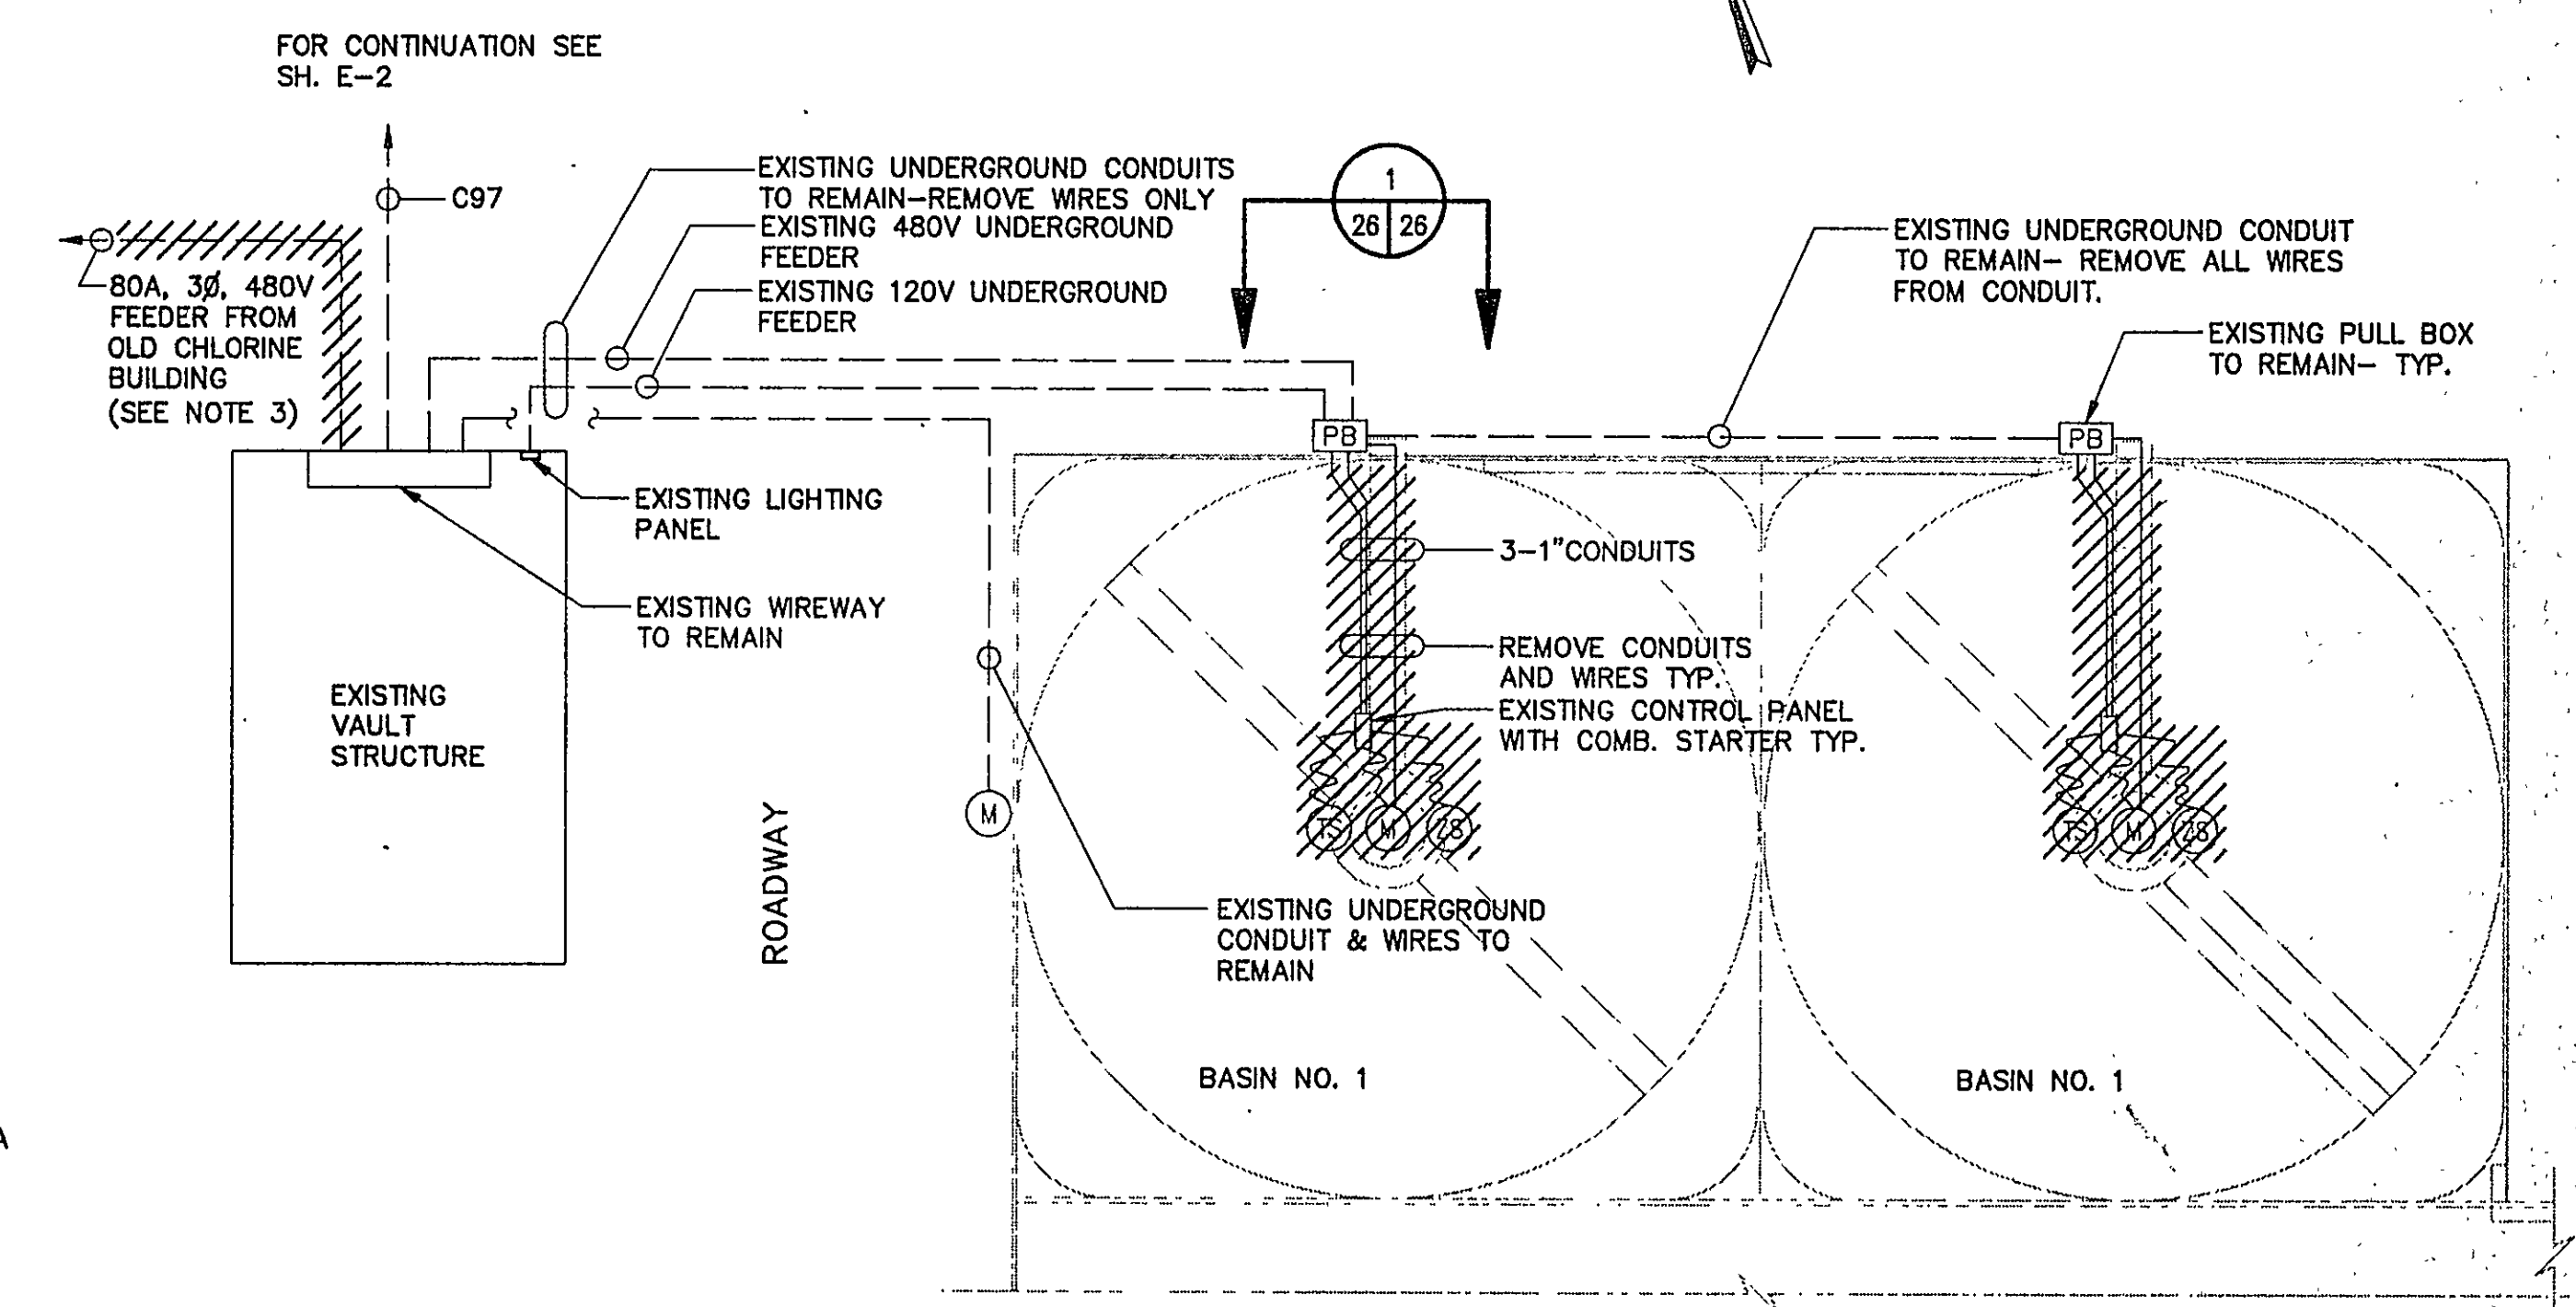

EQUALIZATION BASIN
DEMOLITION PLAN
(N.T.S.)

RECORD DRAWINGS

3937 0060028606 i:\ACAD\PROJ\06002865\0600E703 Scale: 1"=30'0" Date: 05/05/1997 Time: 08:29

MALCOLM PIRNIE 11898 Rock Landing Drive, Suite 400 Newport News, Virginia 23606	<table border="1"> <thead> <tr> <th colspan="4">REVISIONS</th> </tr> <tr> <th>NO.</th> <th>BY</th> <th>DATE</th> <th>REMARKS</th> </tr> </thead> <tbody> <tr><td> </td><td> </td><td> </td><td> </td></tr> <tr><td> </td><td> </td><td> </td><td> </td></tr> <tr><td> </td><td> </td><td> </td><td> </td></tr> </tbody> </table>		REVISIONS				NO.	BY	DATE	REMARKS													DES: GJM DWN: GJM CKD: TK	CITY OF ROANOKE, VIRGINIA WATER POLLUTION CONTROL PLANT UPGRADE AND EXPANSION	EQUALIZATION BASIN SLUDGE COLLECTION SYSTEM POWER LAYOUT SCALE: AS NOTED	COPYRIGHT © 1997 MALCOLM PIRNIE, INC. DATE: MAY 1997 E SHEET 26 OF 34 CAD REF. NO. 0060E703
	REVISIONS																									
	NO.	BY	DATE	REMARKS																						
3937 0060028606 i:\ACAD\PROJ\06002865\0600E703 Scale: 1"=30'0" Date: 05/05/1997 Time: 08:29																										
RECORD DRAWINGS																										
3937 0060028606 i:\ACAD\PROJ\06002865\0600E703 Scale: 1"=30'0" Date: 05/05/1997 Time: 08:29																										