



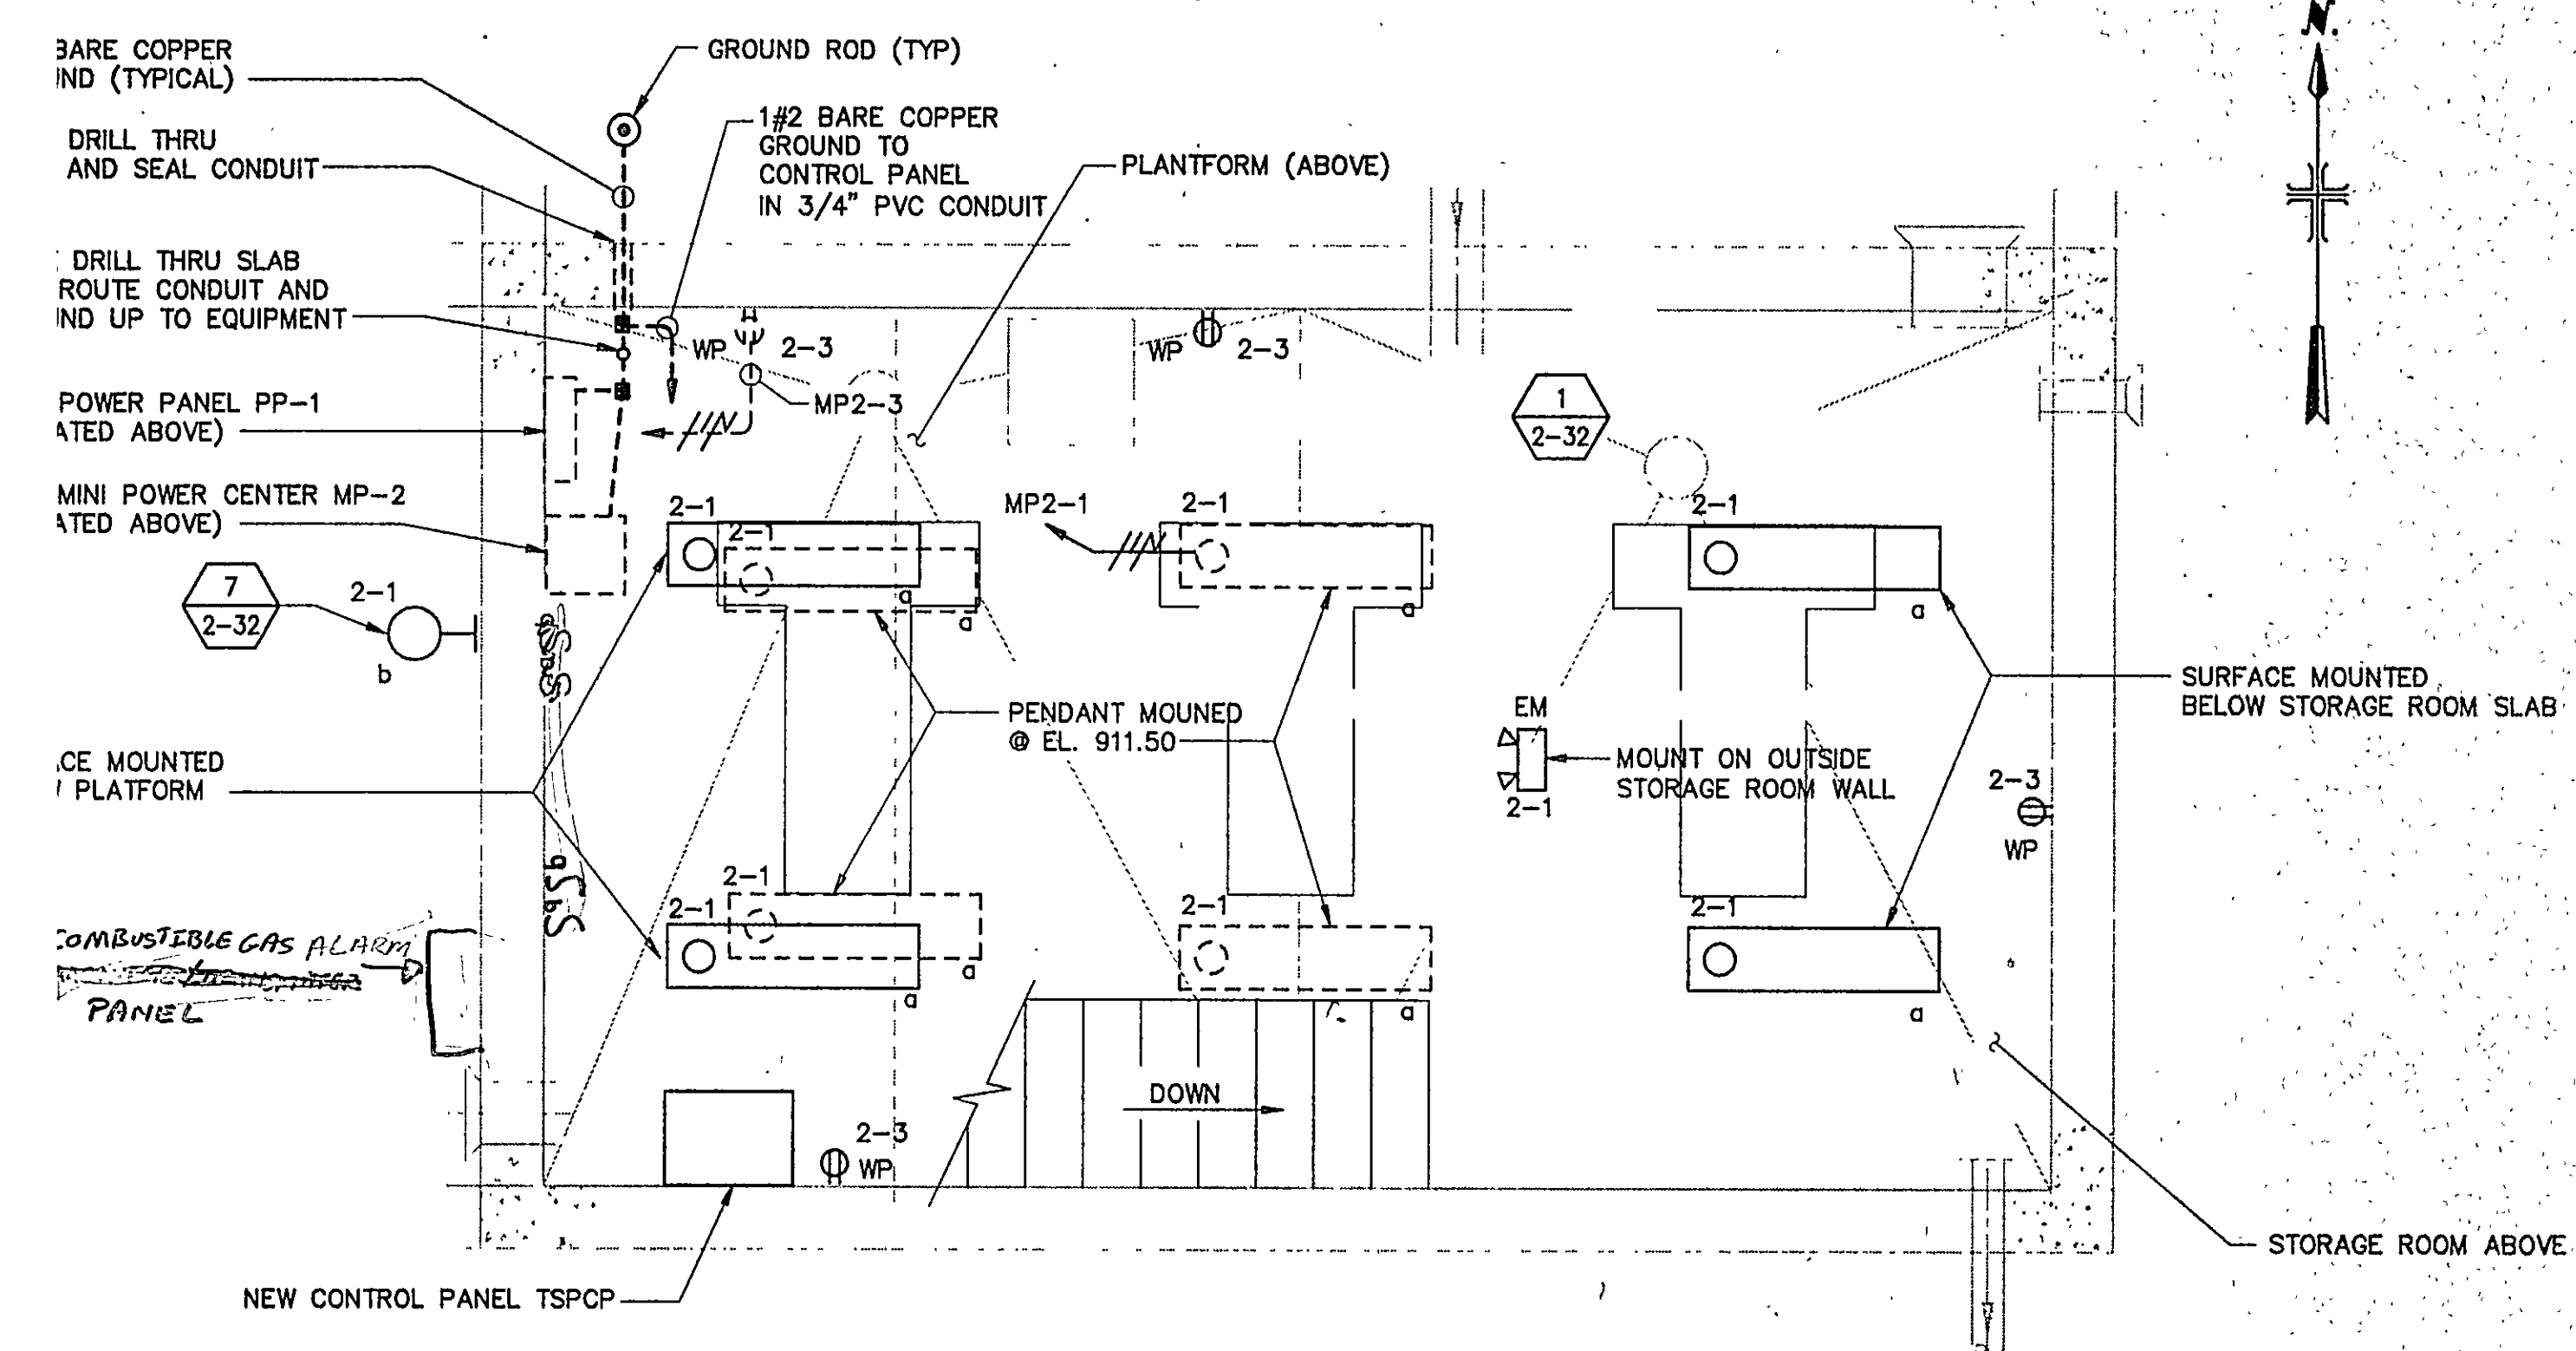

THICKENED SLUDGE PUMP STATION
LIGHTING PLAN @ EL. 895.25
(LOWER LEVEL)

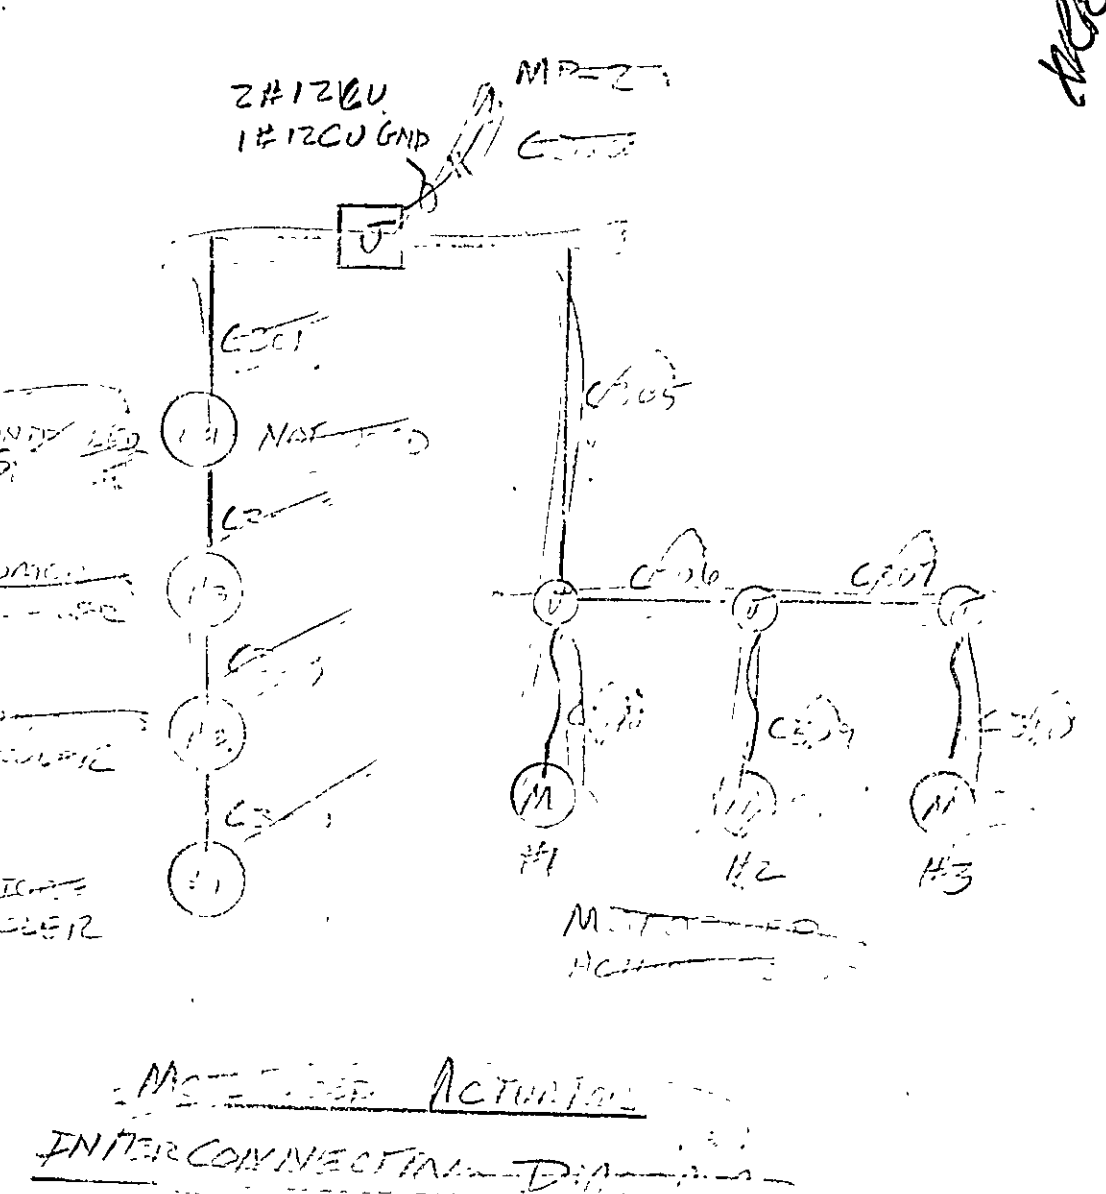

NOTES:

1. AREA CLASSIFICATION:

a. THE THICKENED SLUDGE PUMP STATION IS CONSIDERED A WET LOCATION. ALL MATERIALS, EQUIPMENT AND INCIDENTALS SHALL MEET NEMA 4X REQUIREMENTS. ALL EXPOSED CONDUITS SHALL BE PVC COATED RIGID STEEL.

$$X = -1.48$$
$$Y = 2.43$$
$$X = 0$$
$$Y = 0$$

C-300 - 2411, 11111111 11111111
 C-301 - (3) 51111111 11111111
 C-302 - (3) 51111111 71111111
 C-303 - (2) 51111111 71111111
 C-304 - (2) 51111111 71111111
 C-305 - (2) 51111111 71111111
 C-306 - (2) 51111111 71111111
 C-307 - (2) 51111111 71111111
 C-308 - (2) 51111111 71111111
 C-309 - (2) 51111111 71111111
 C-310 - (2) 51111111 71111111

RECORD DRAWINGS