


CITY OF ROANOKE, VIRGINIA




# WATER POLLUTION CONTROL PLANT UPGRADE AND EXPANSION

MAY 1997

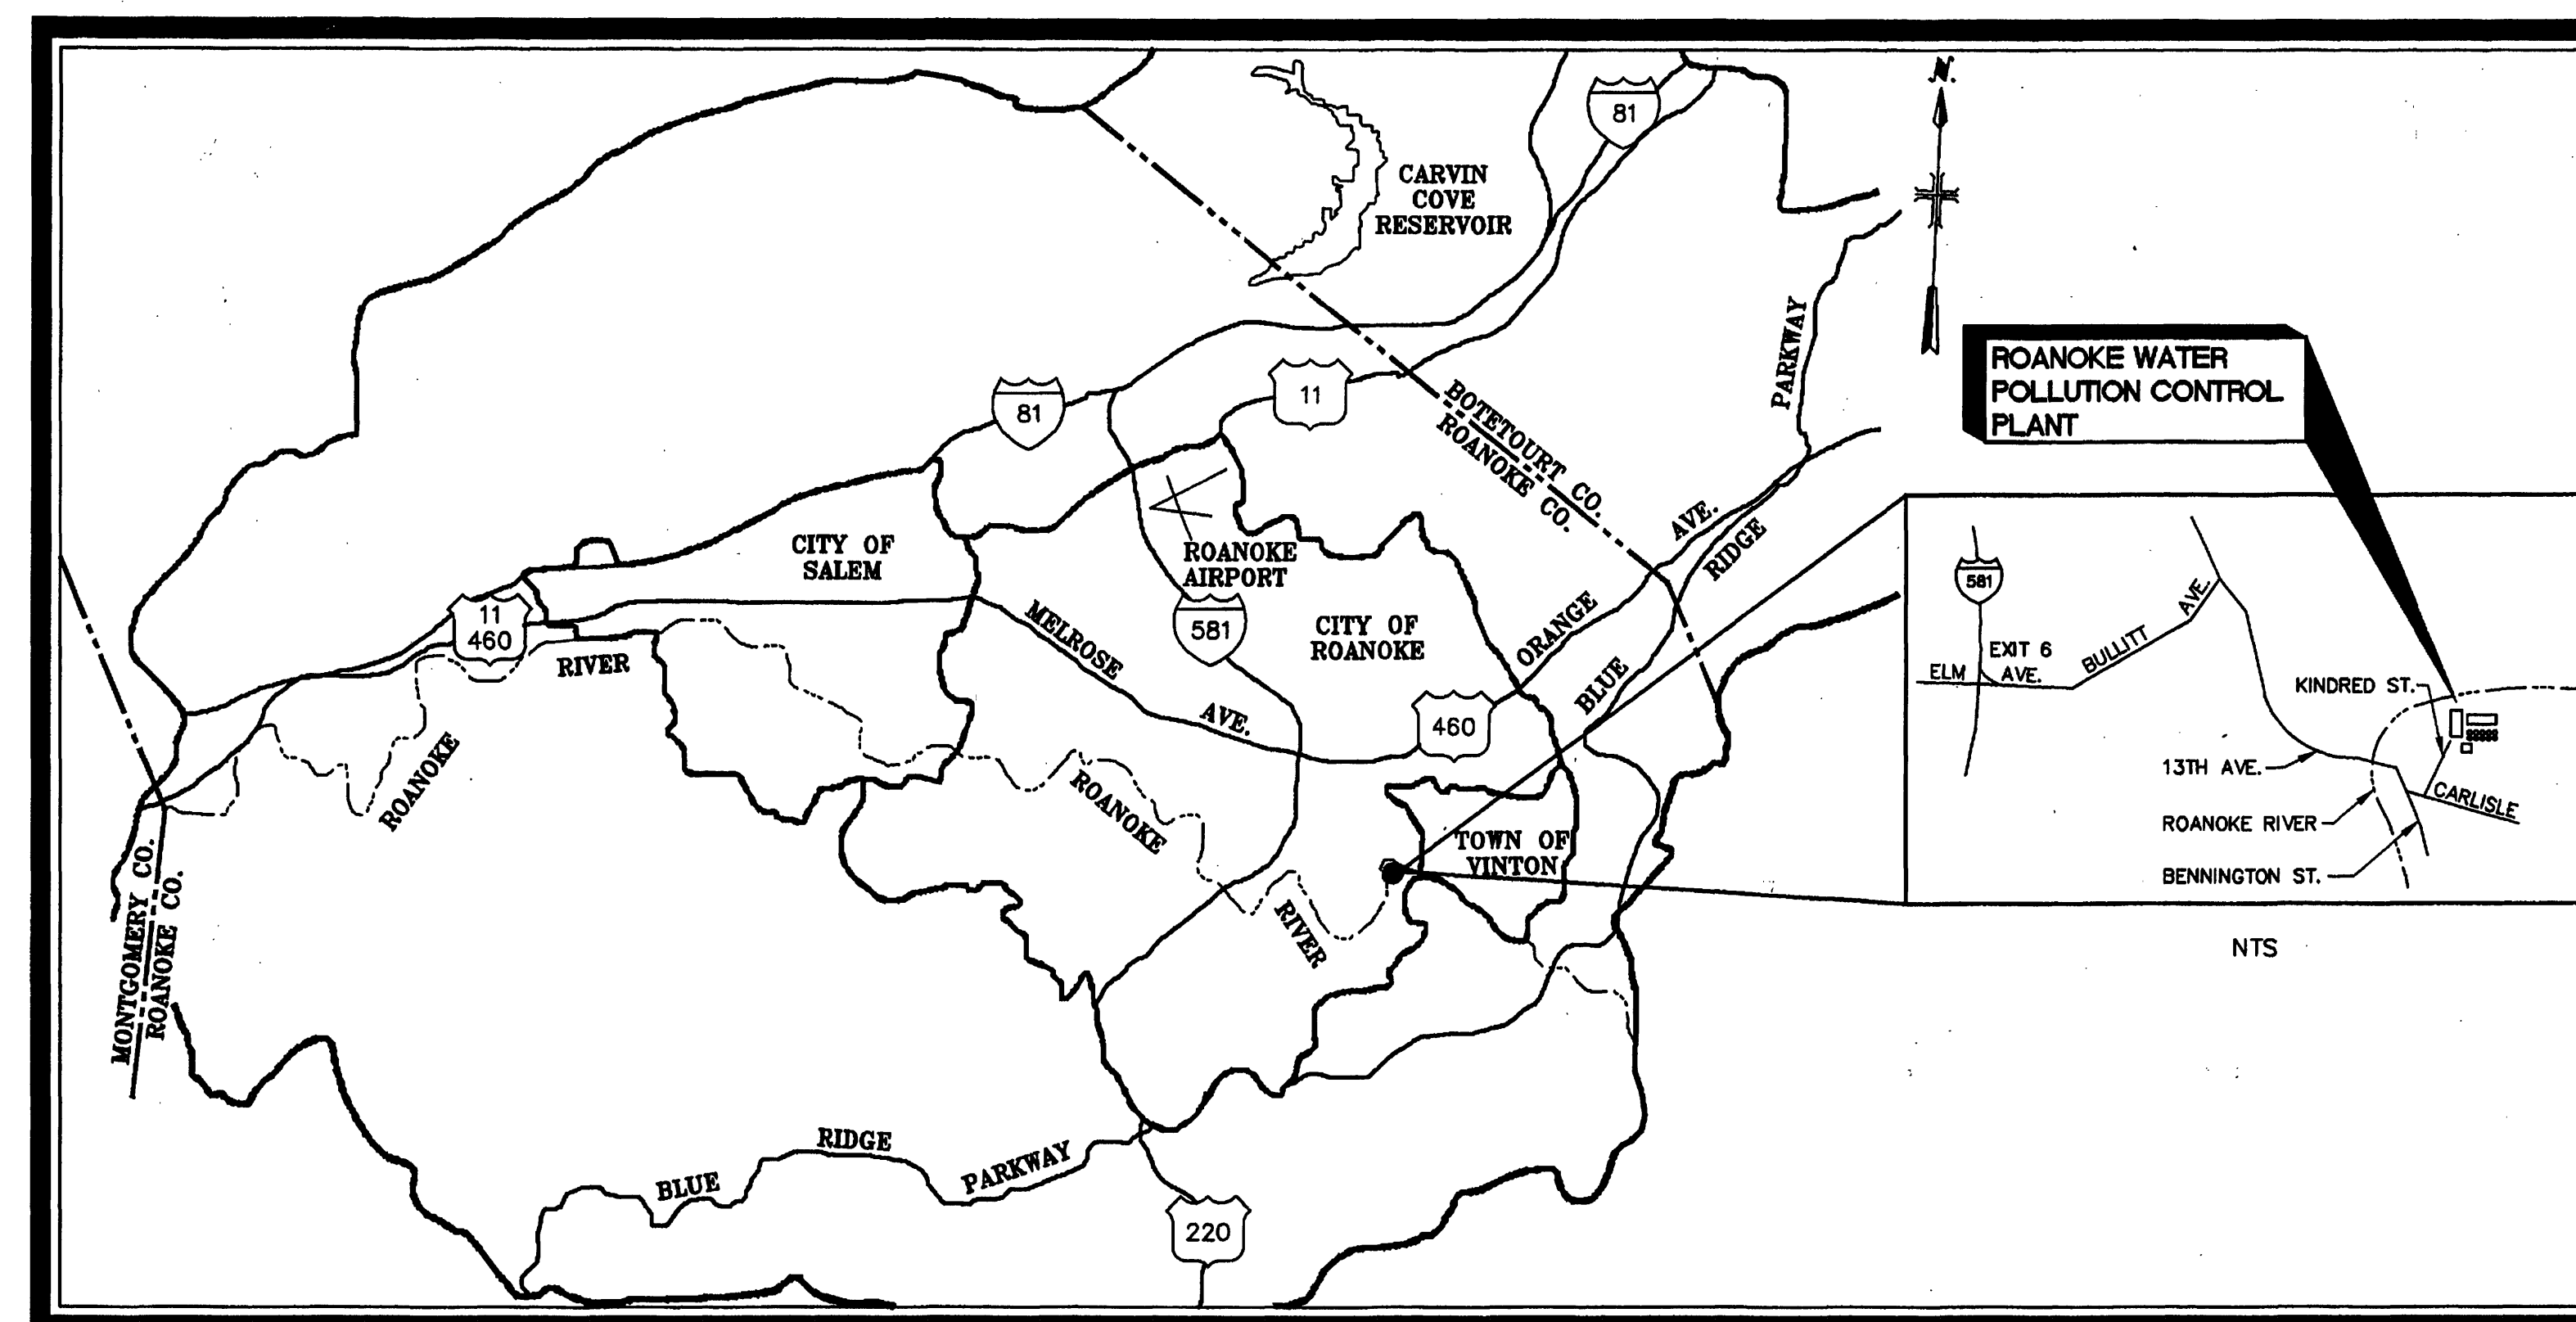

LOCATION PLAN

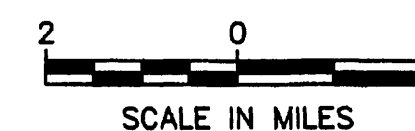

MALCOLM PIRNIE INC., ENVIRONMENTAL ENGINEERS, SCIENTISTS & PLANNERS

11832 ROCK LANDING DRIVE, SUITE 400  
NEWPORT NEWS, VIRGINIA 23606

WITH

MATTERN & CRAIG, CONSULTING ENGINEERS • SURVEYORS

701 FIRST STREET, S.W.  
ROANOKE, VIRGINIA 24016

RECORD DRAWINGS  
JANUARY 2000