


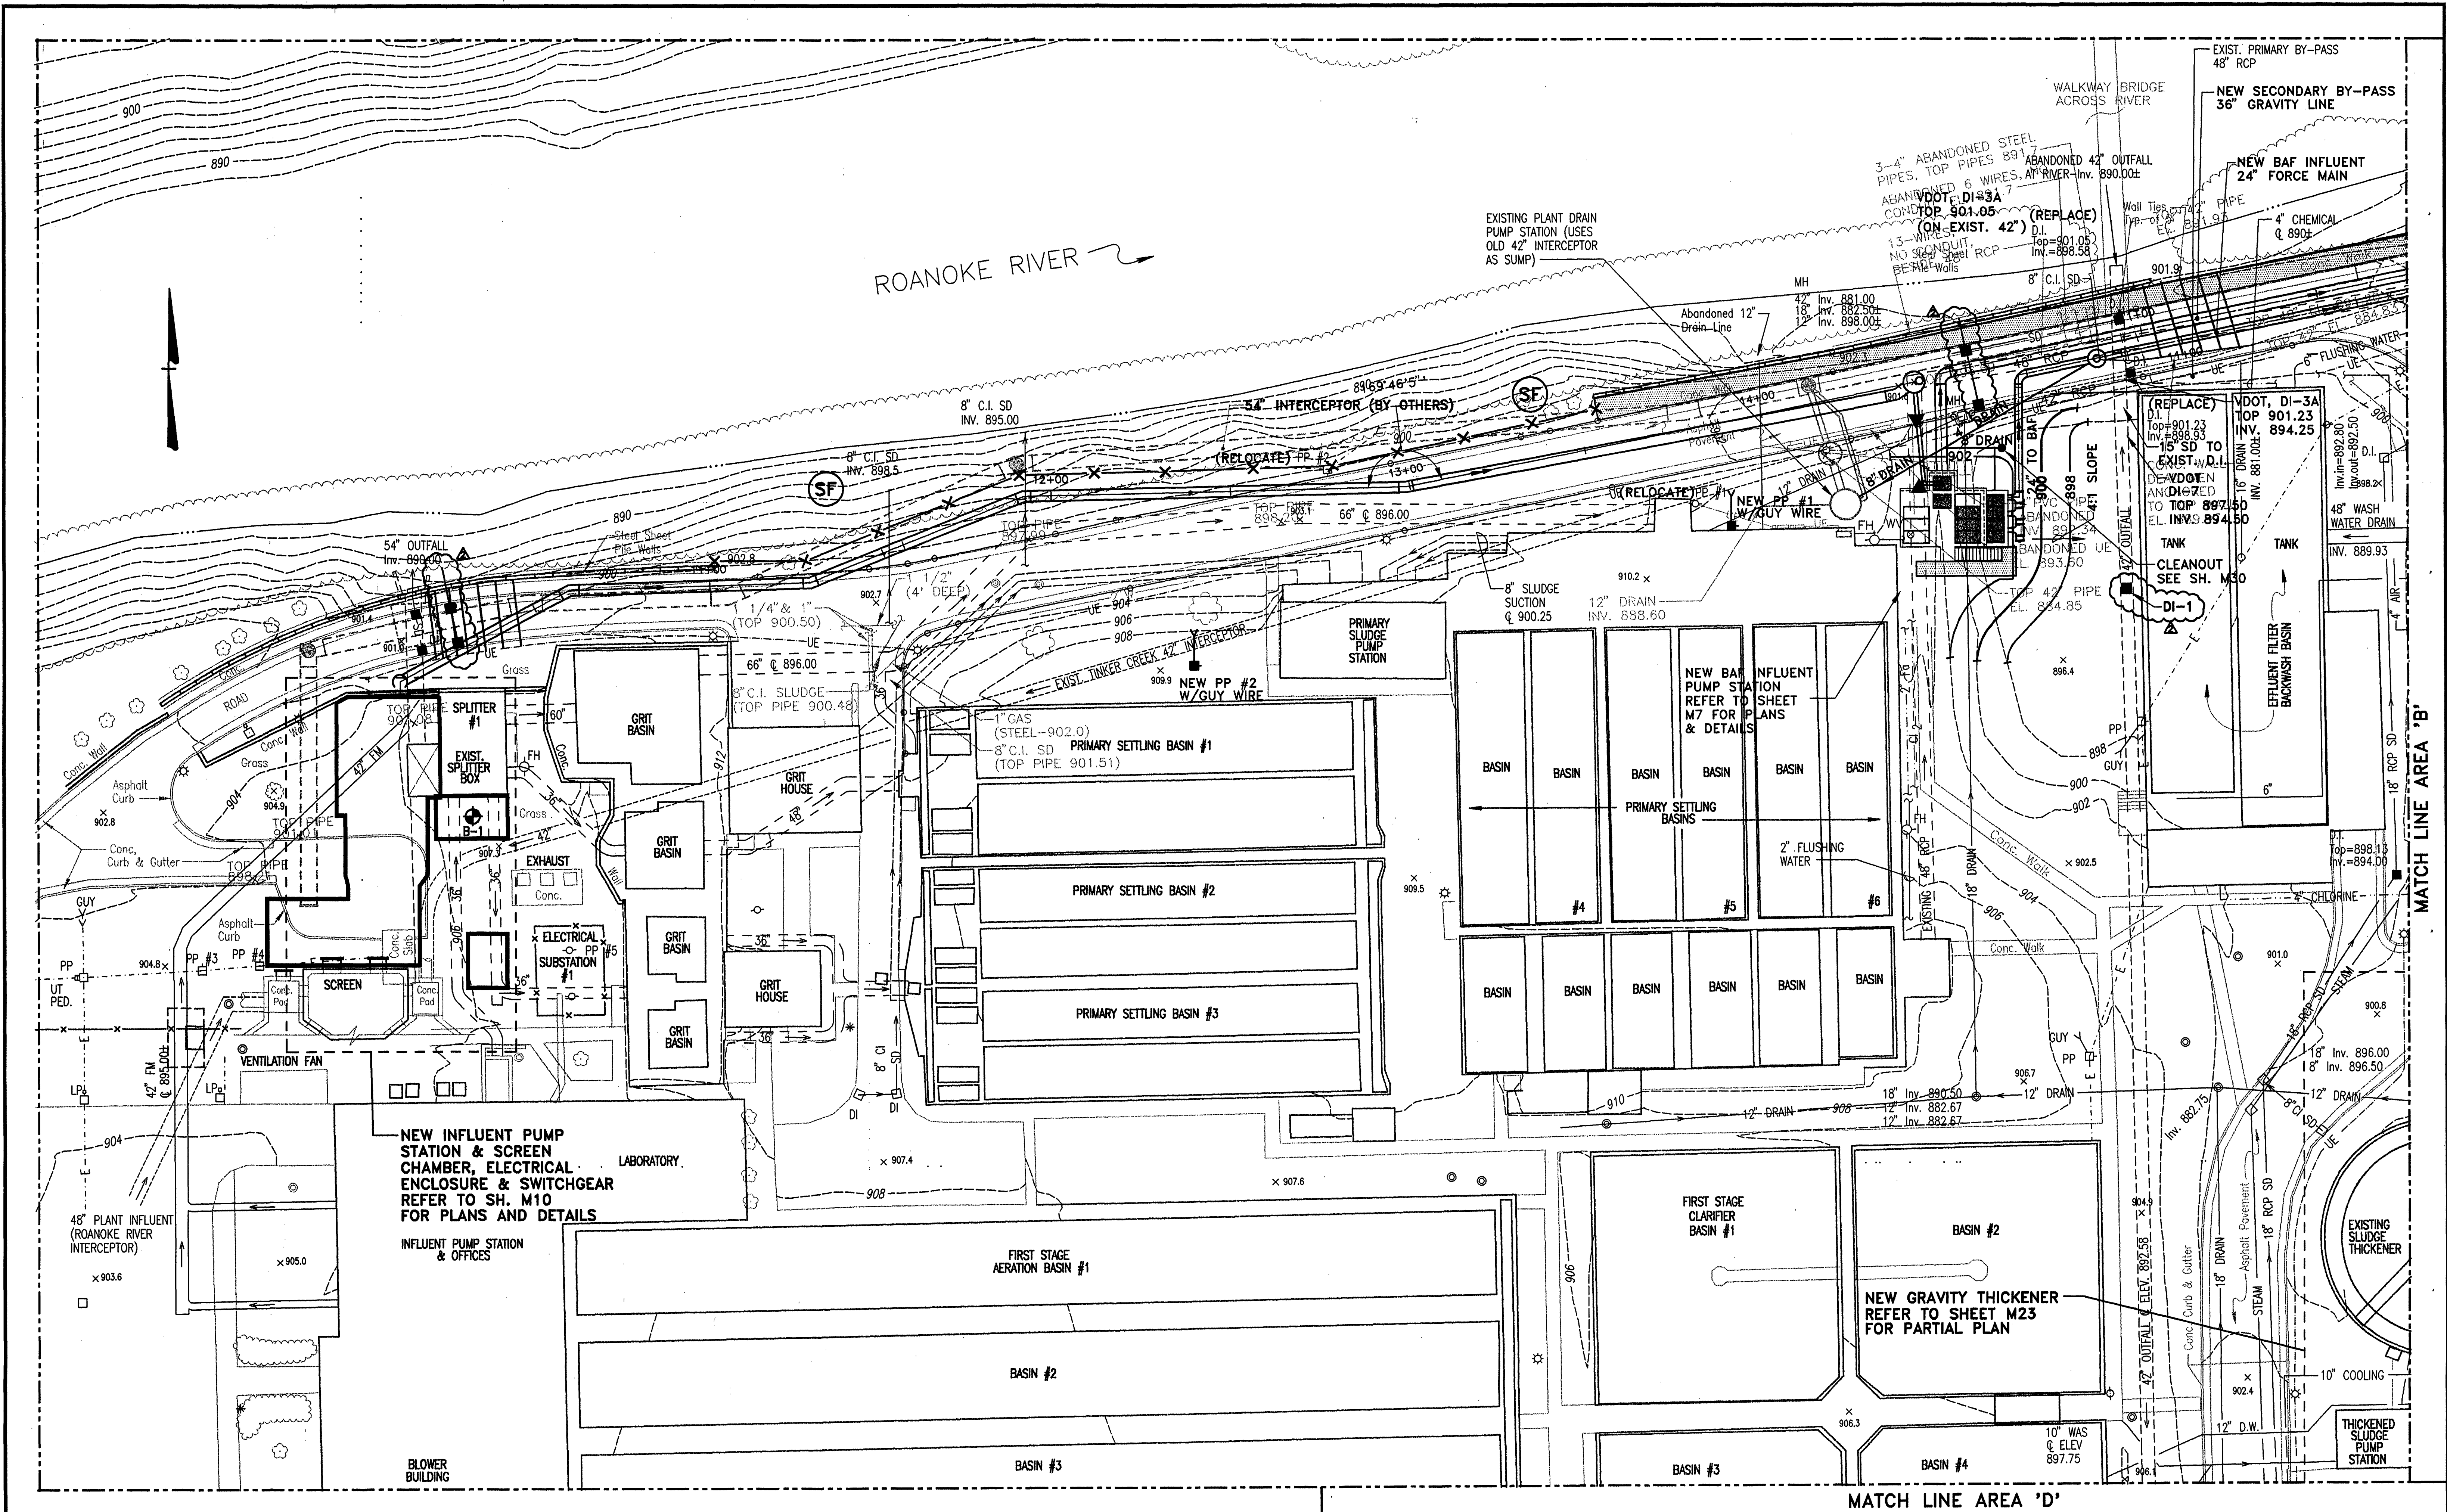

		<table border="1"> <thead> <tr> <th>NO.</th> <th>BY</th> <th>DATE</th> <th>REVISIONS</th> <th>REMARKS</th> </tr> </thead> <tbody> <tr> <td>2</td> <td>ARB</td> <td>JAN. 2000</td> <td>RECORD DRAWING</td> <td></td> </tr> </tbody> </table>		NO.	BY	DATE	REVISIONS	REMARKS	2	ARB	JAN. 2000	RECORD DRAWING		DES. WTA DWN. LDL/ARB CKD. SWH		CITY OF ROANOKE, VIRGINIA WATER POLLUTION CONTROL PLANT UPGRADE AND EXPANSION	SITE PLAN GRADING, STORM DRAINAGE, AND E&SC AREA 'A' 1"=20'	DATE MAY, 1997 G SHEET 10 OF 23 CAD REF. NO. G10.DWG
		NO.	BY	DATE	REVISIONS	REMARKS												
		2	ARB	JAN. 2000	RECORD DRAWING													