


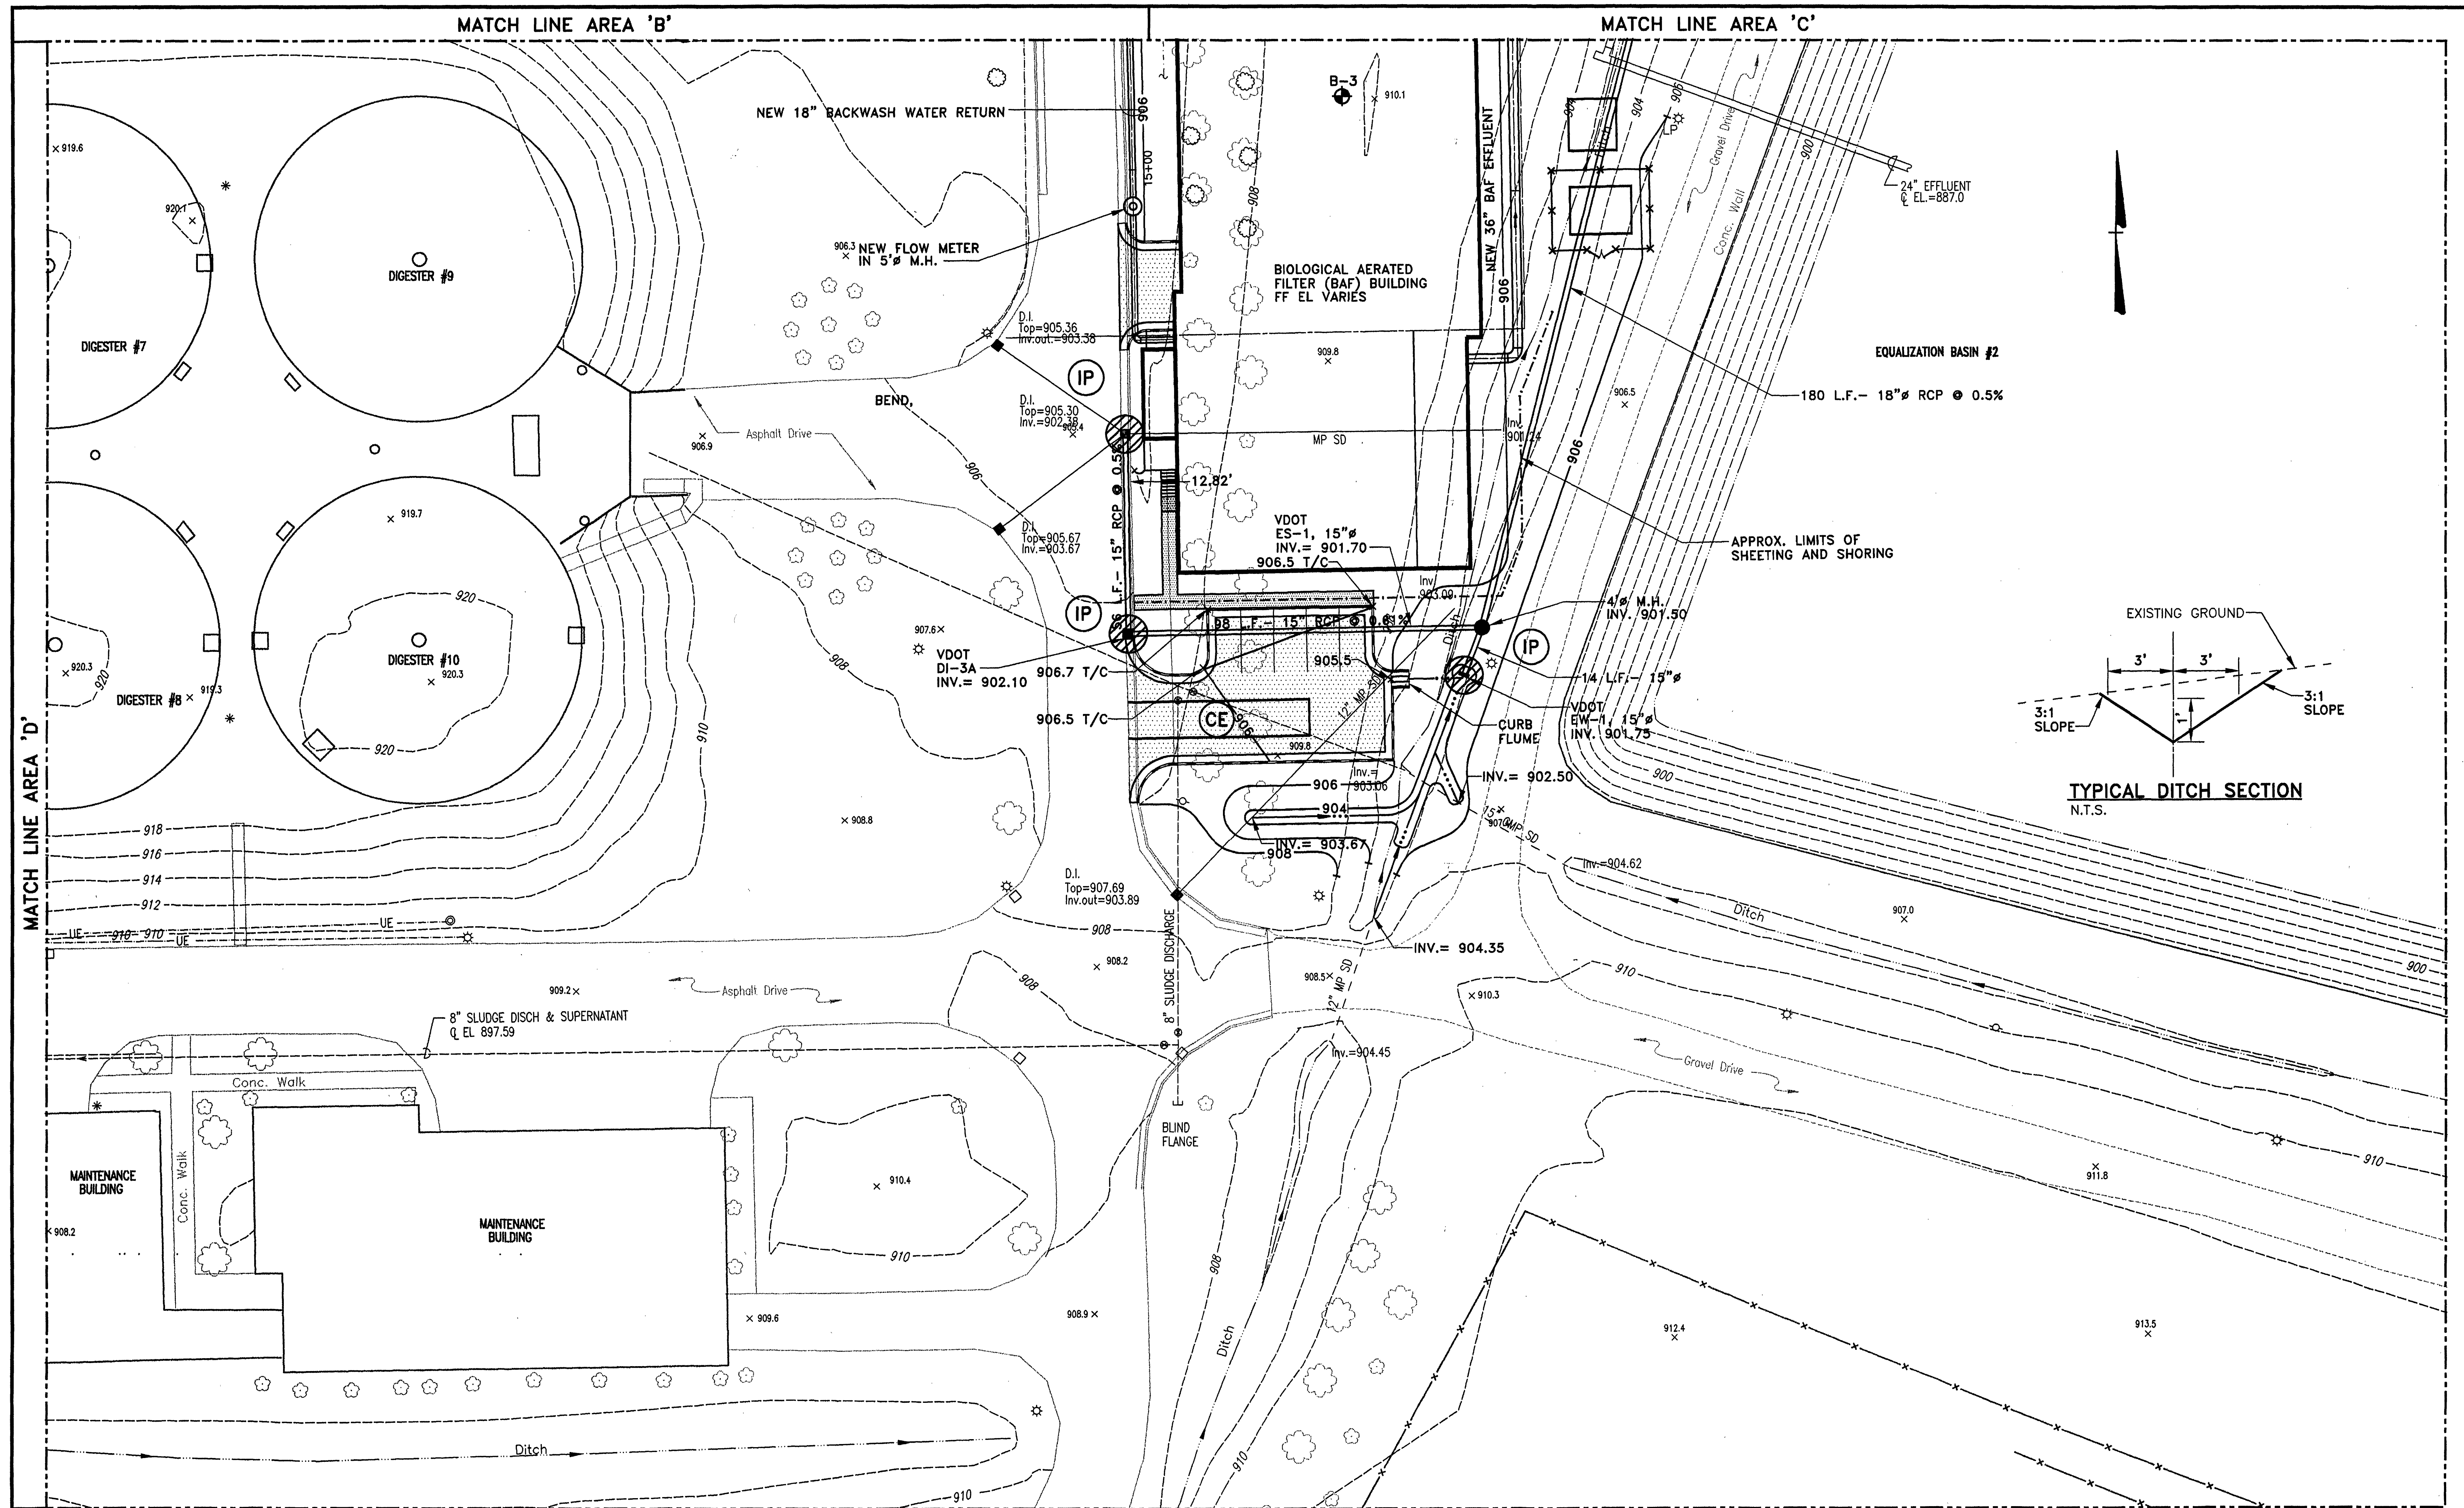

		NO.	BY	DATE	REVISIONS	REMARKS	DES. WTA DWN. LDL/ARB CKD. SWH		SITE PLAN GRADING, STORM DRAINAGE, AND E&SC AREA 'E' 1"=20'	DATE MAY, 1997 G SHEET 14 OF 23 CAD REF. NO. G14.DWG
		1	ARB	JAN. 2000	RECORD DRAWING					