


NO.	BY	DATE	REVISIONS	REMARKS
1	ARB	JAN. 2000	RECORD DRAWING	

DES: WTA  
DWN: MNT  
CKD: SWH

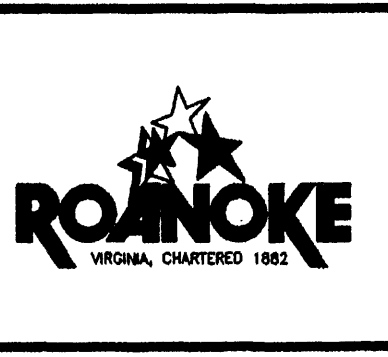

CITY OF ROANOKE, VIRGINIA  
WATER POLLUTION  
CONTROL PLANT  
UPGRADE AND EXPANSION

SITE PLAN  
EROSION AND SEDIMENT  
CONTROL DETAILS  
SCALE: NOT TO SCALE

DATE: MAY, 1997  
G SHEET 16 OF 23  
CAD REF. NO. G16.DWG