
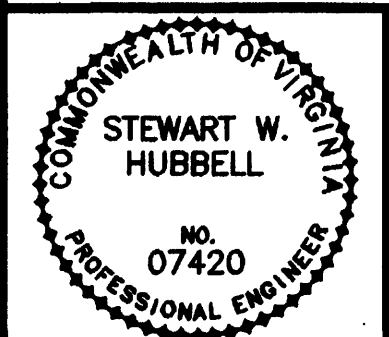


REVISIONS				
NO.	BY	DATE	REVISIONS	REMARKS
1	SWH	2/12/98	REVISED PROFILES	
2	ARB	JAN. 2000	RECORD DRAWING	

DES - WTA
 DWN - ARB
 CKD - SWH

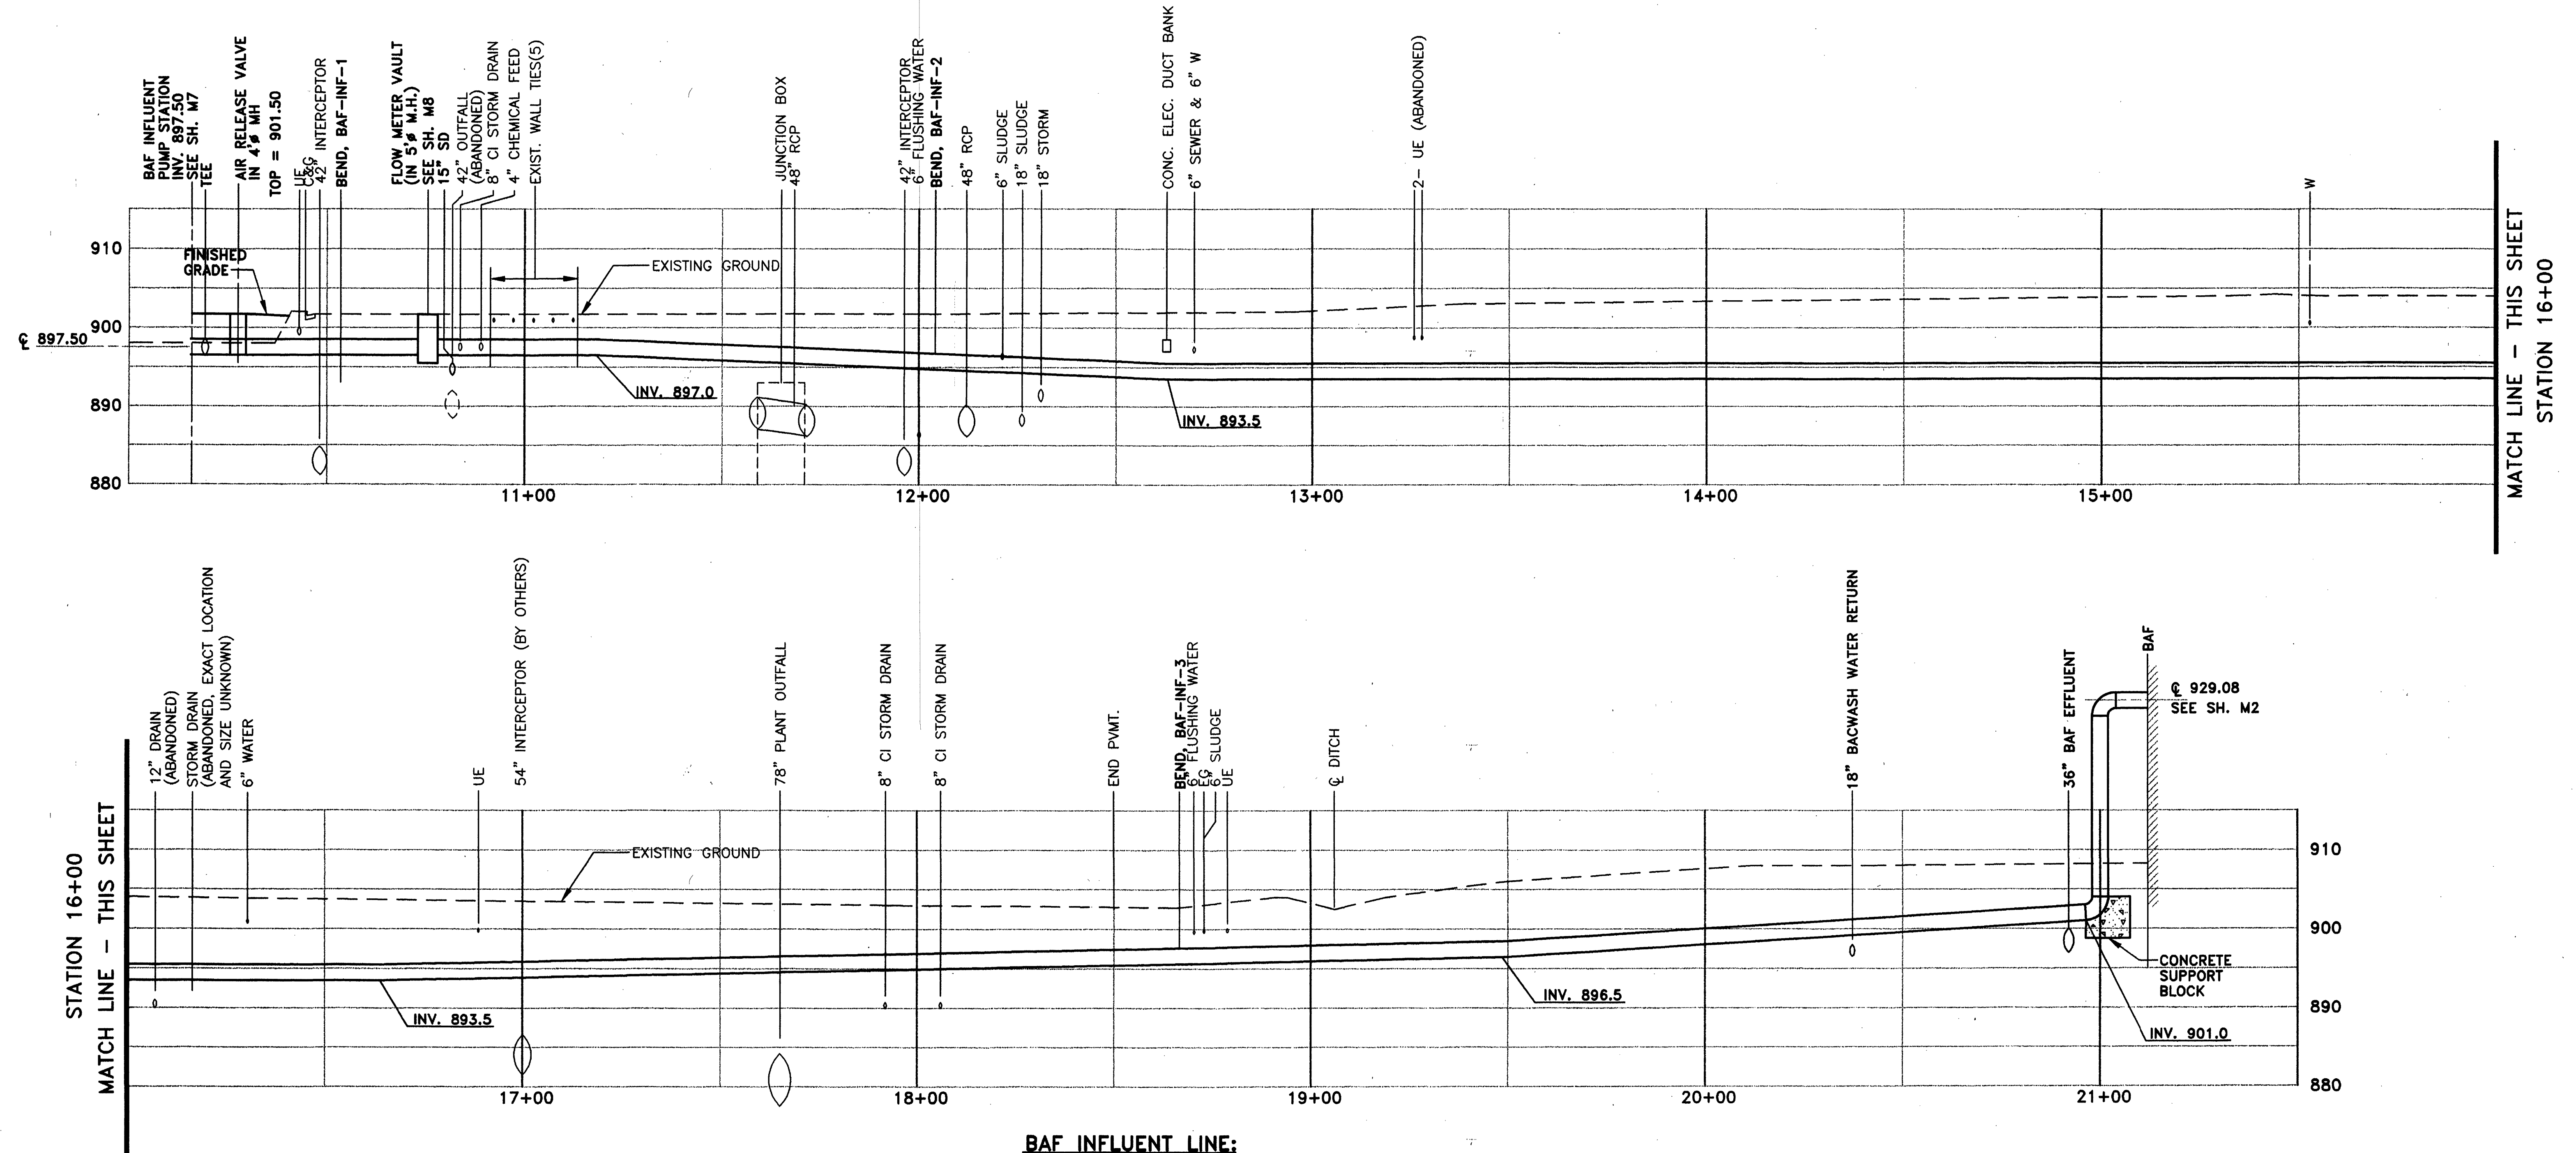

CITY OF ROANOKE, VIRGINIA
 WATER POLLUTION
 CONTROL PLANT
 UPGRADE AND EXPANSION

PROFILES

SCALE: 1"=20'H, 1"=10'V

DATE - MAY, 1997
 G SHEET 19 OF 23
 CAD REF. NO. G19.DWG