



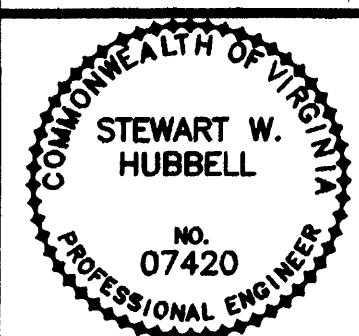

Mattern & Craig, Inc.
 CONSULTING ENGINEERS & SURVEYORS
 701 FIRST STREET, S.W.
 ROANOKE, VIRGINIA 24004
 800 545-5442
 800 545-5442 FAX

REVISIONS				REMARKS
NO.	BY	DATE		
1	ARB	JAN. 2000	RECORD DRAWING	

DES WTA
 DWN ARB
 CKD SWH

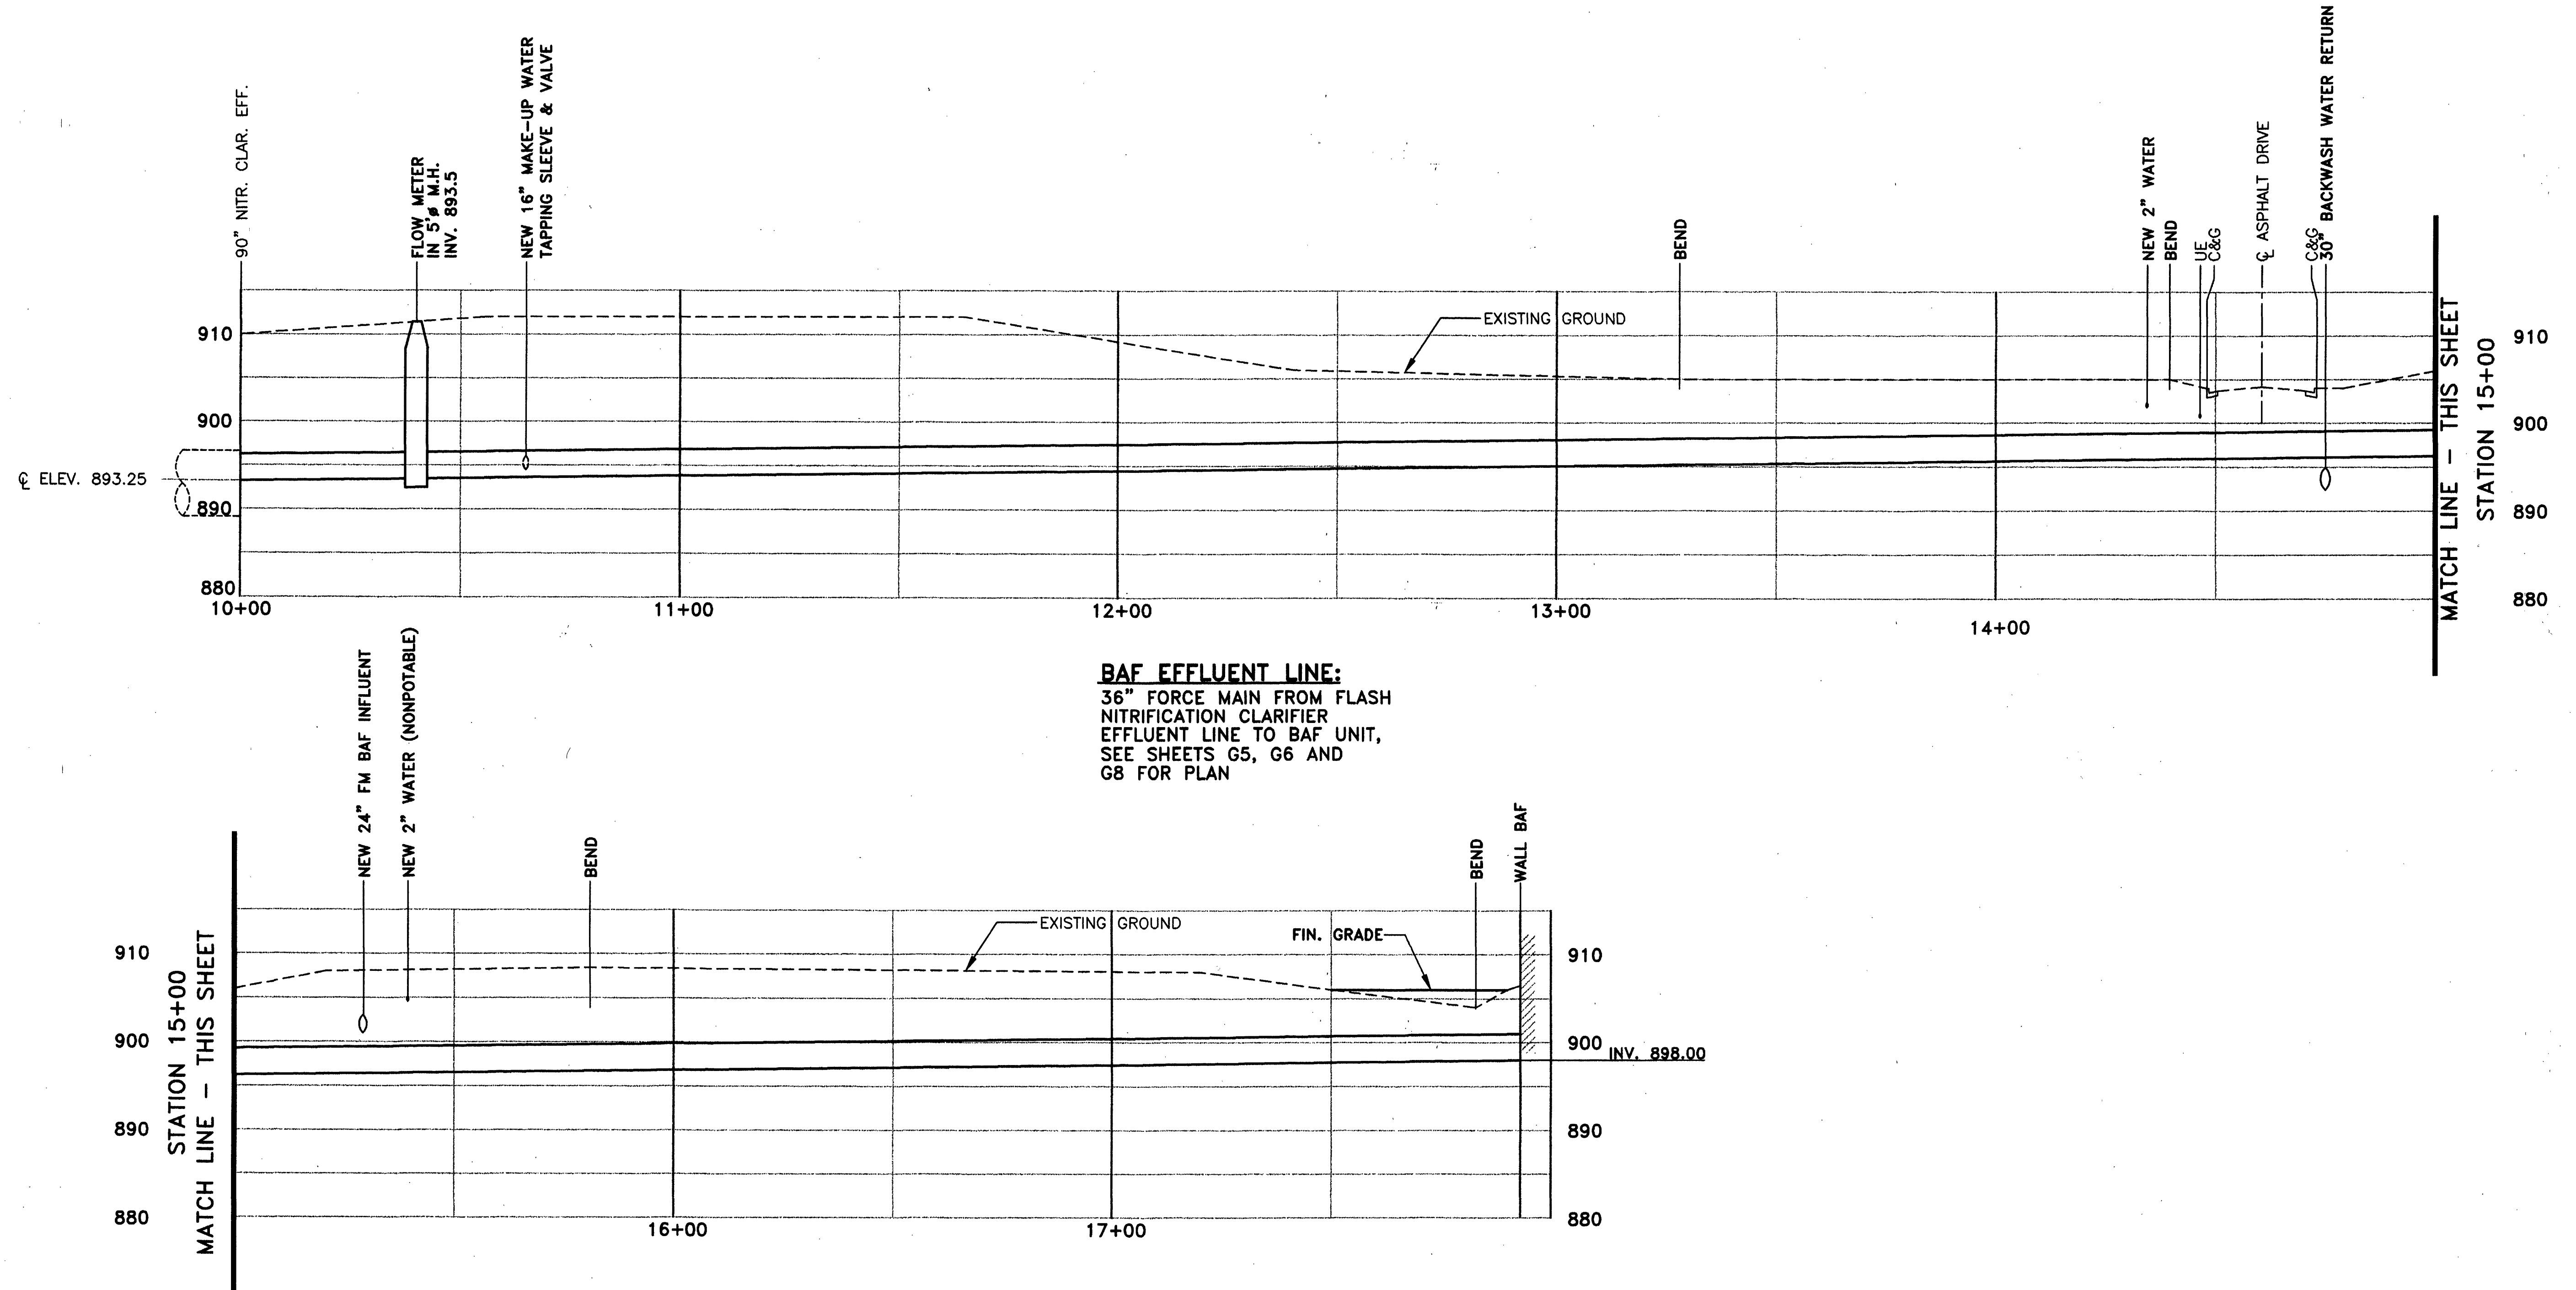

CITY OF ROANOKE, VIRGINIA
**WATER POLLUTION
 CONTROL PLANT
 UPGRADE AND EXPANSION**

PROFILES

SCALE: 1"=20'H, 1"=10'V

DATE MAY, 1997
G SHEET 20 OF 23
 CAD REF. NO. G20.DWG