




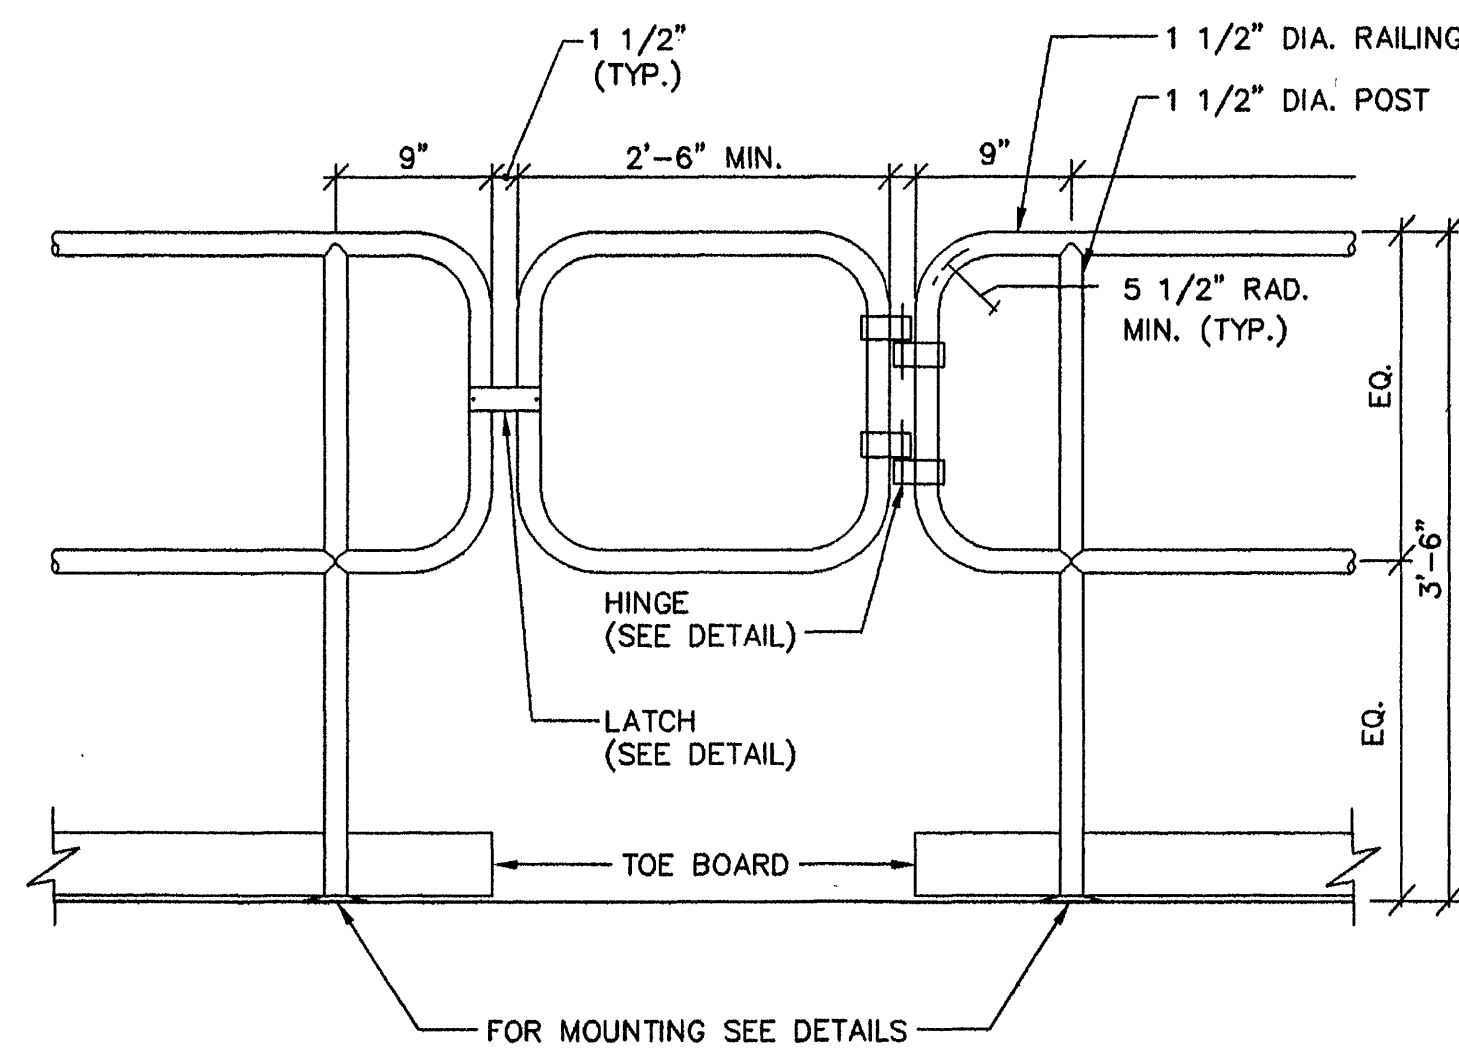


TYPICAL GATE

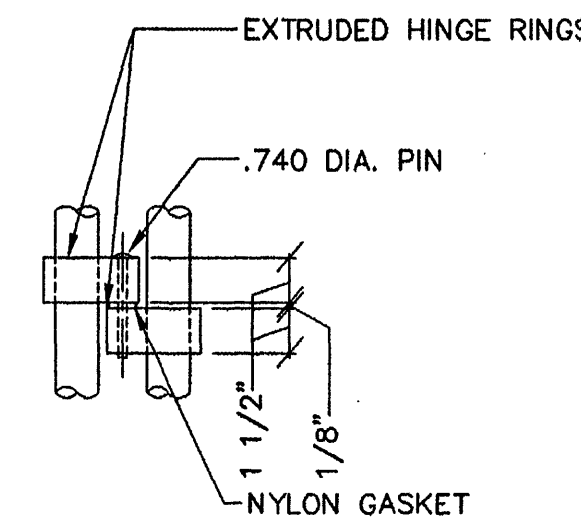


HINGE DETAIL

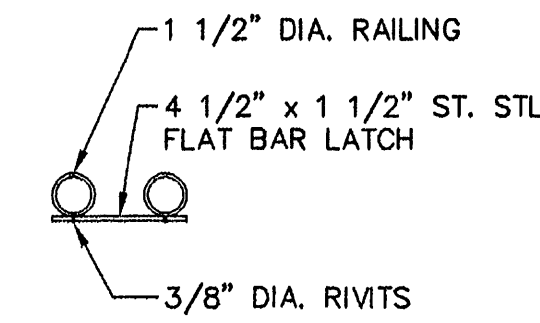


LATCH DETAIL

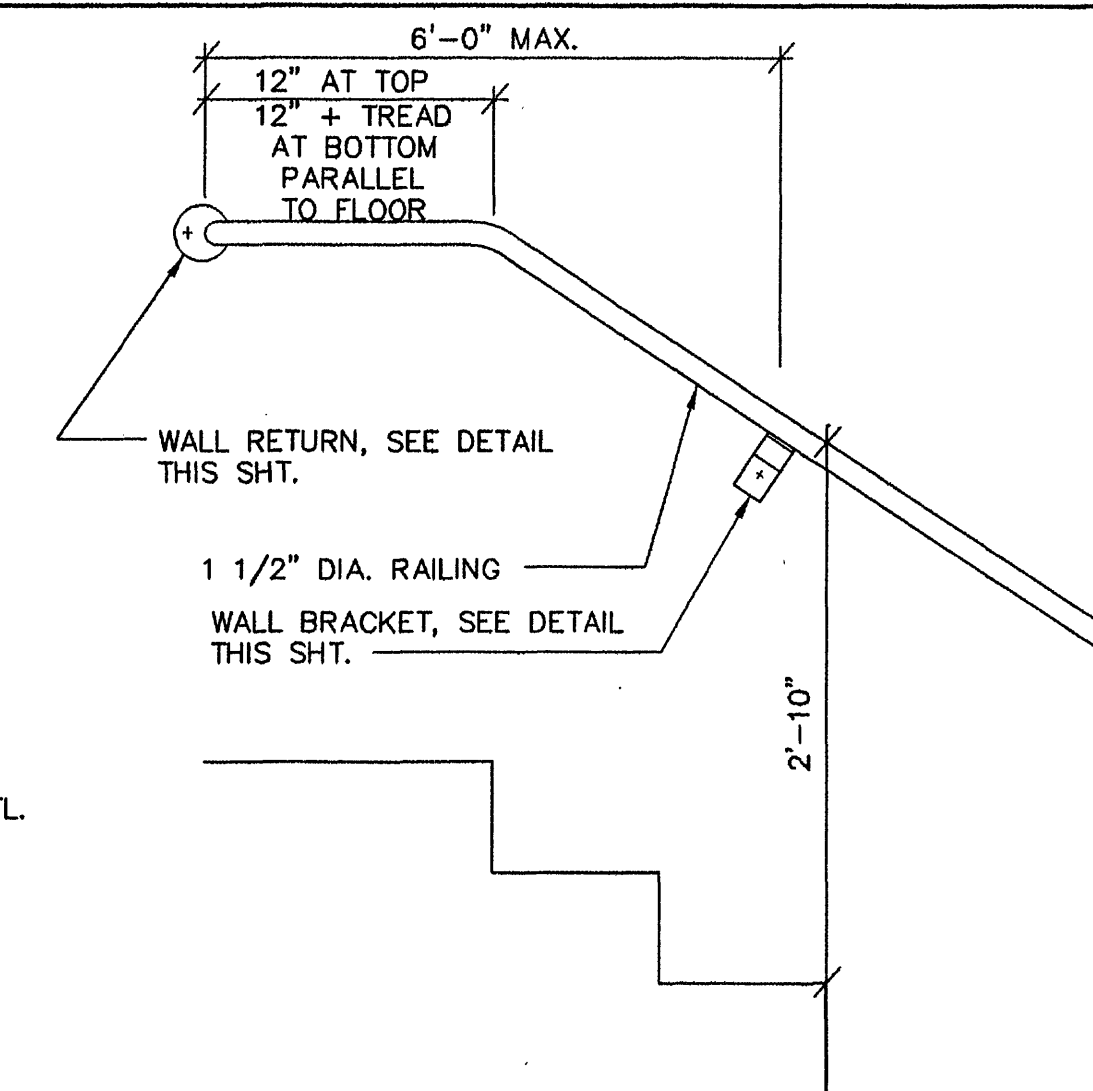


TYPICAL HANDRAIL DETAIL

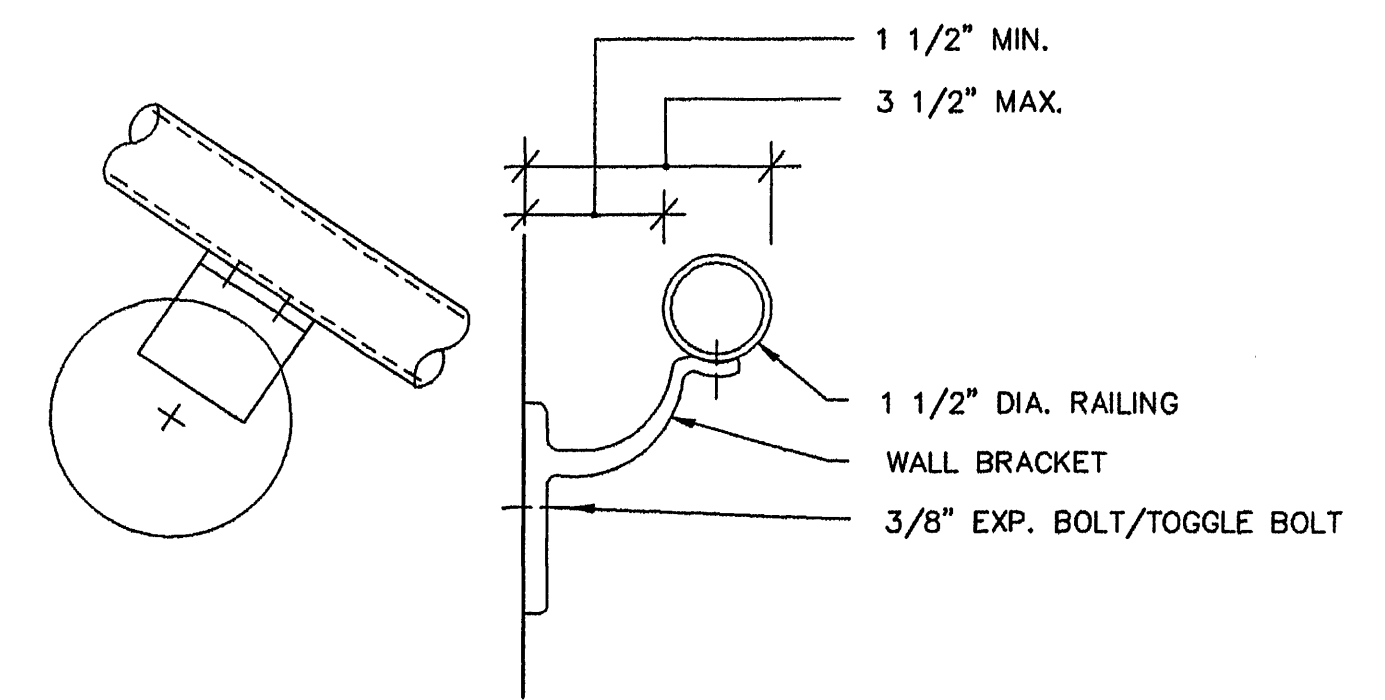


WALL BRACKET DETAIL

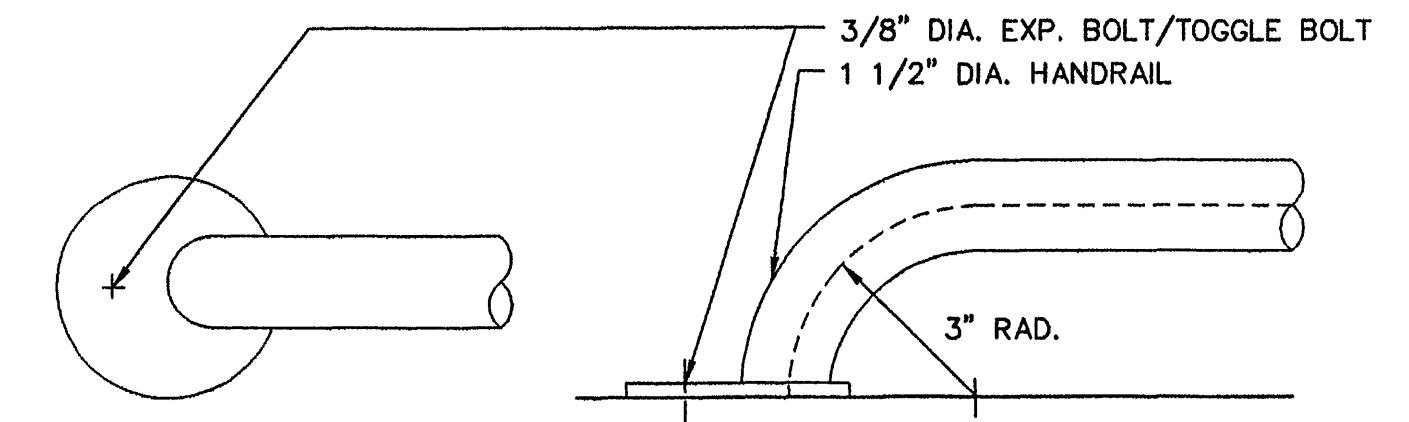


TYPICAL WALL RETURN DETAIL

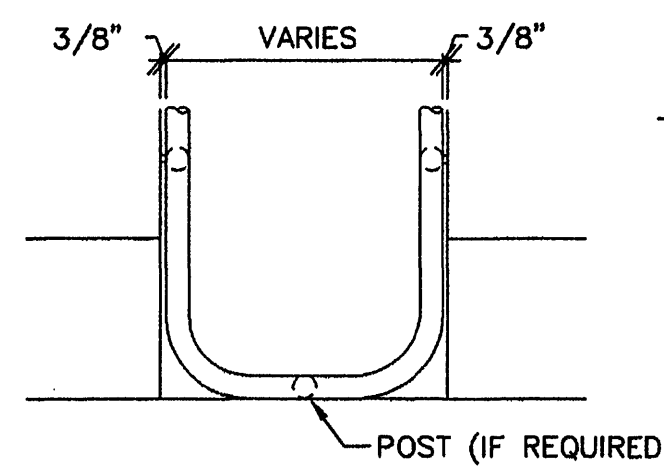


STAIR RETURN

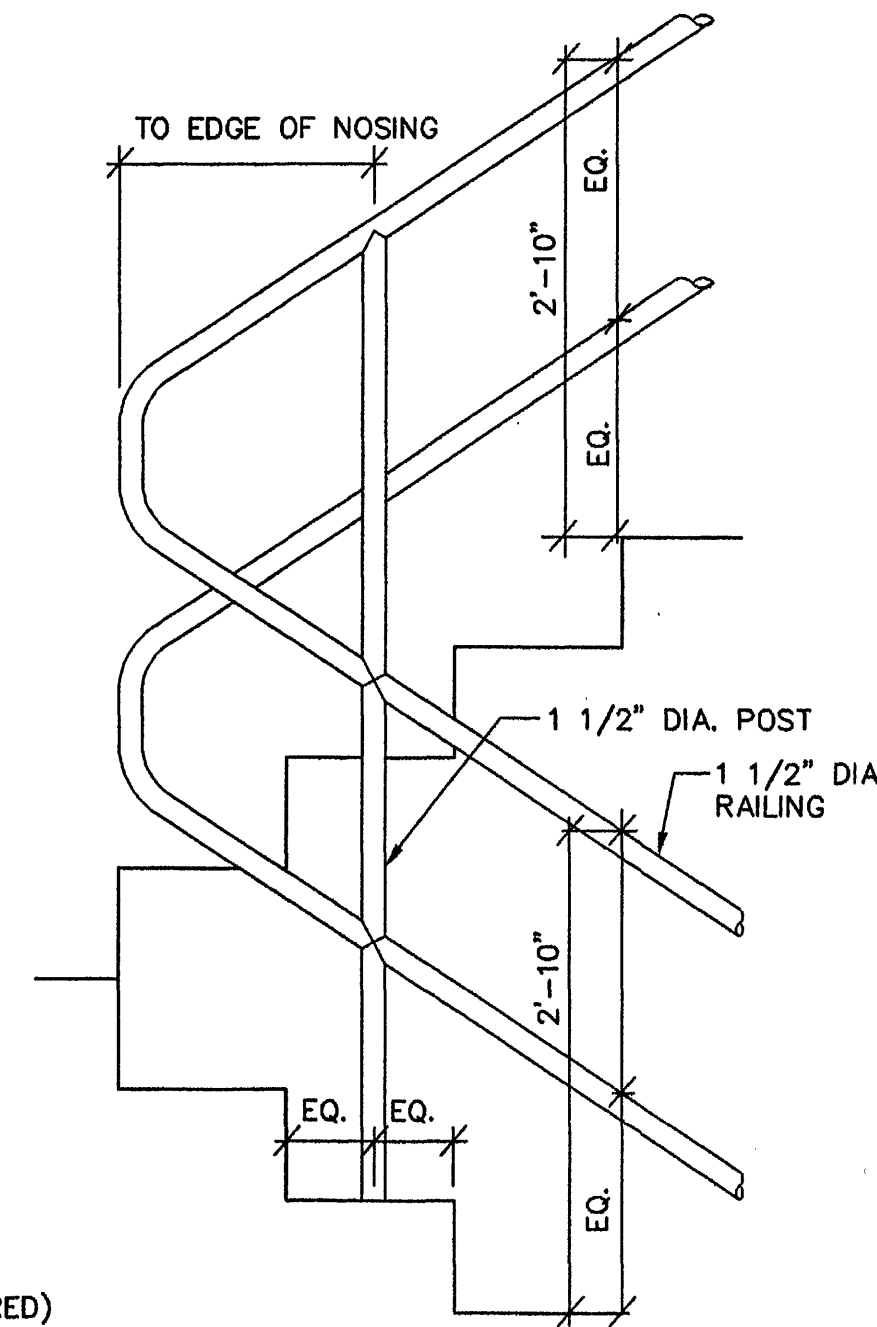

TYPICAL STAIR TURN

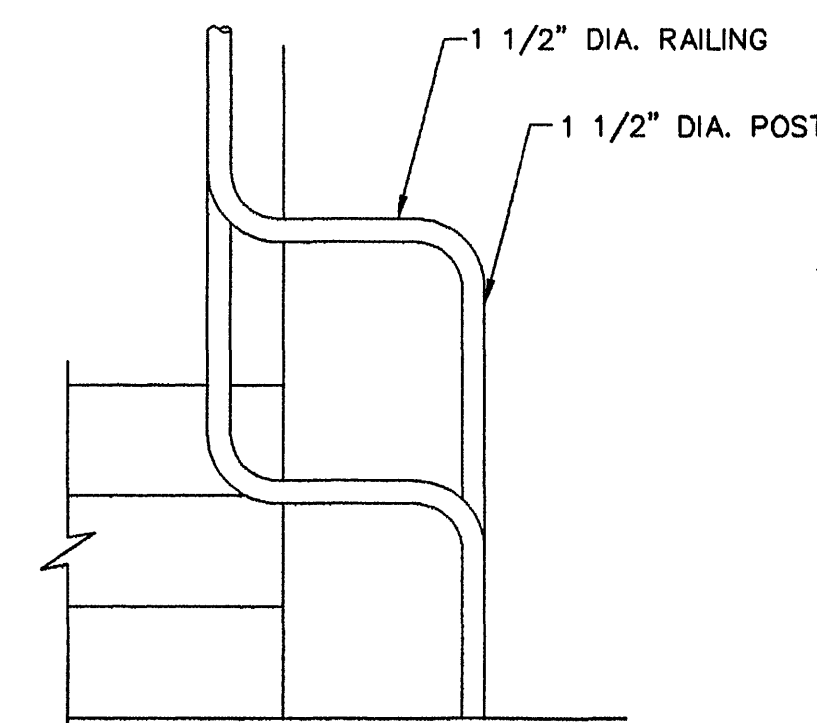


STAIR RETURN

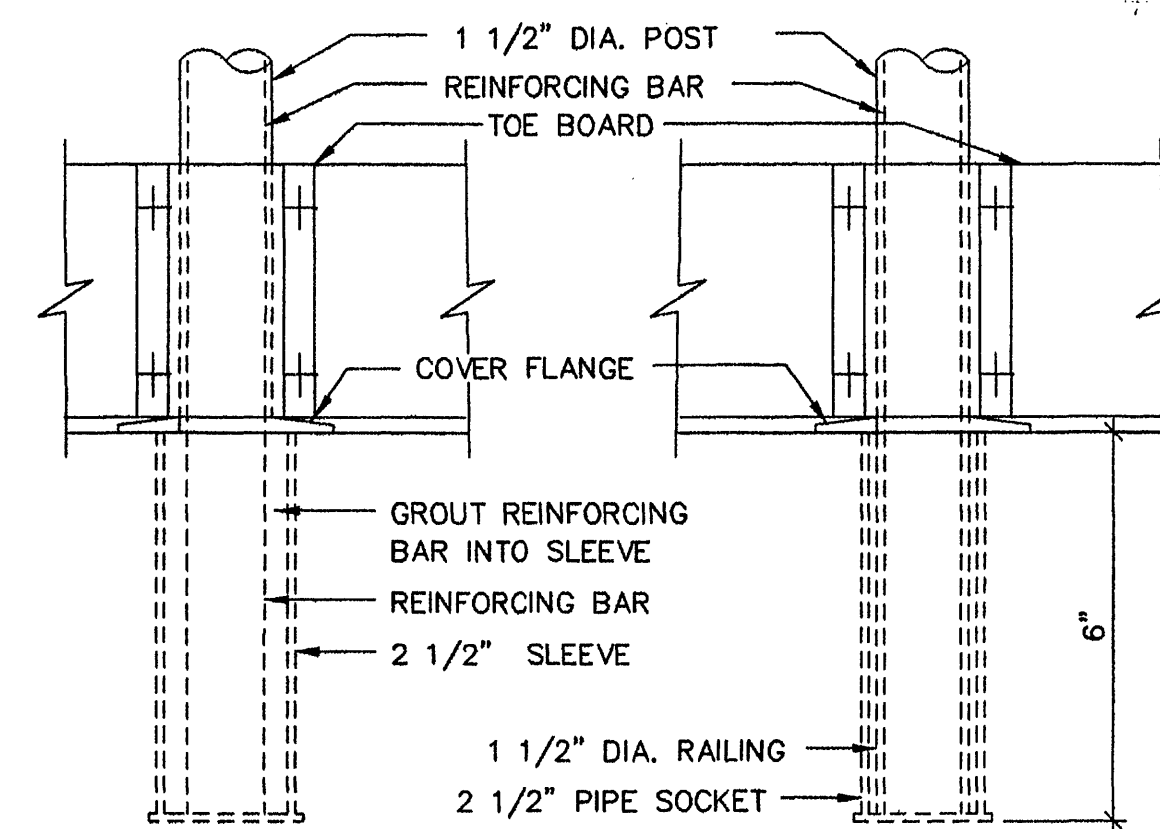


FIXED RAIL DETAIL


REMOVABLE RAIL DETAIL

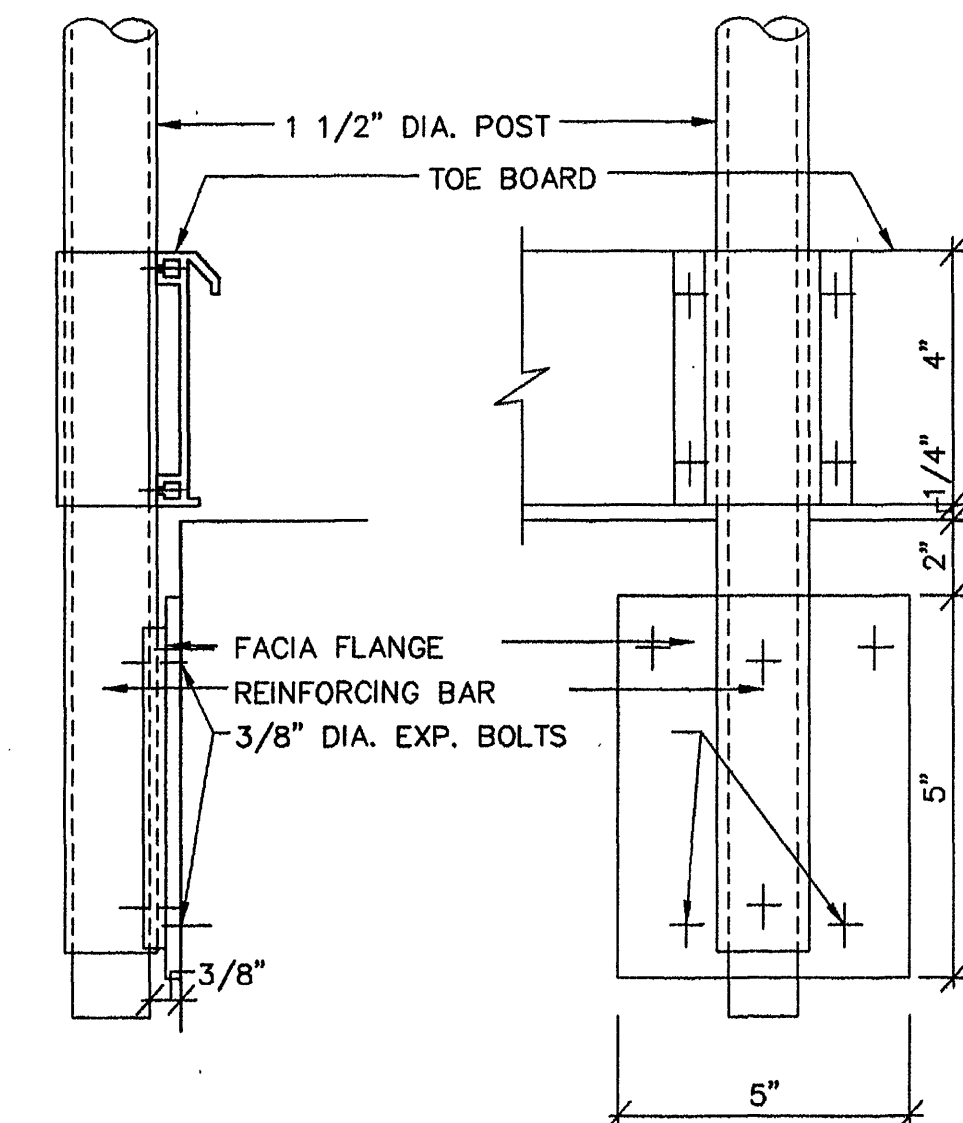


SIDE MOUNT DETAIL

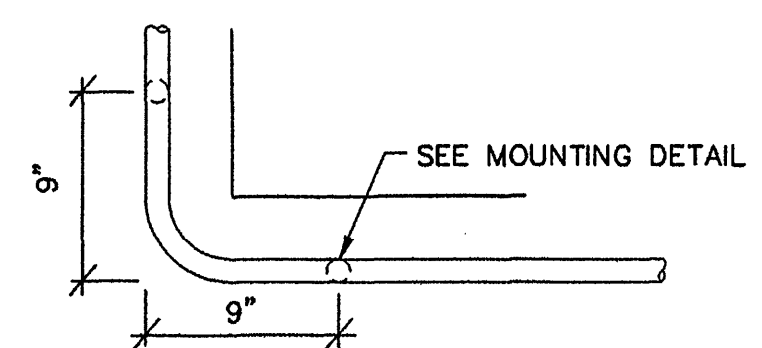


TYPICAL CORNER PLAN

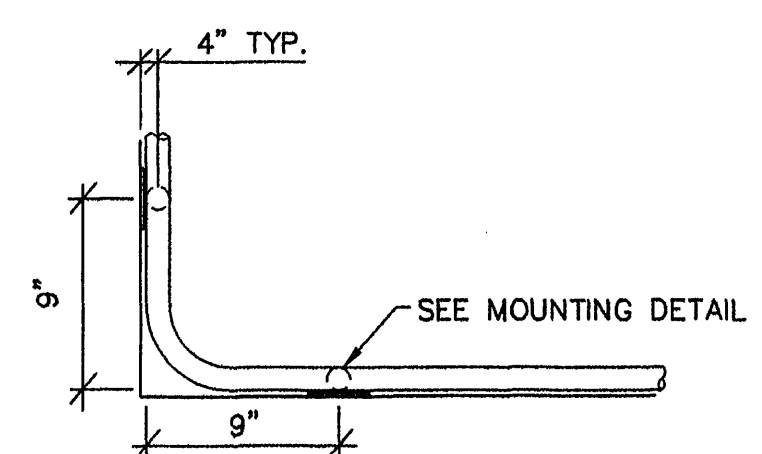


TYPICAL CORNER PLAN

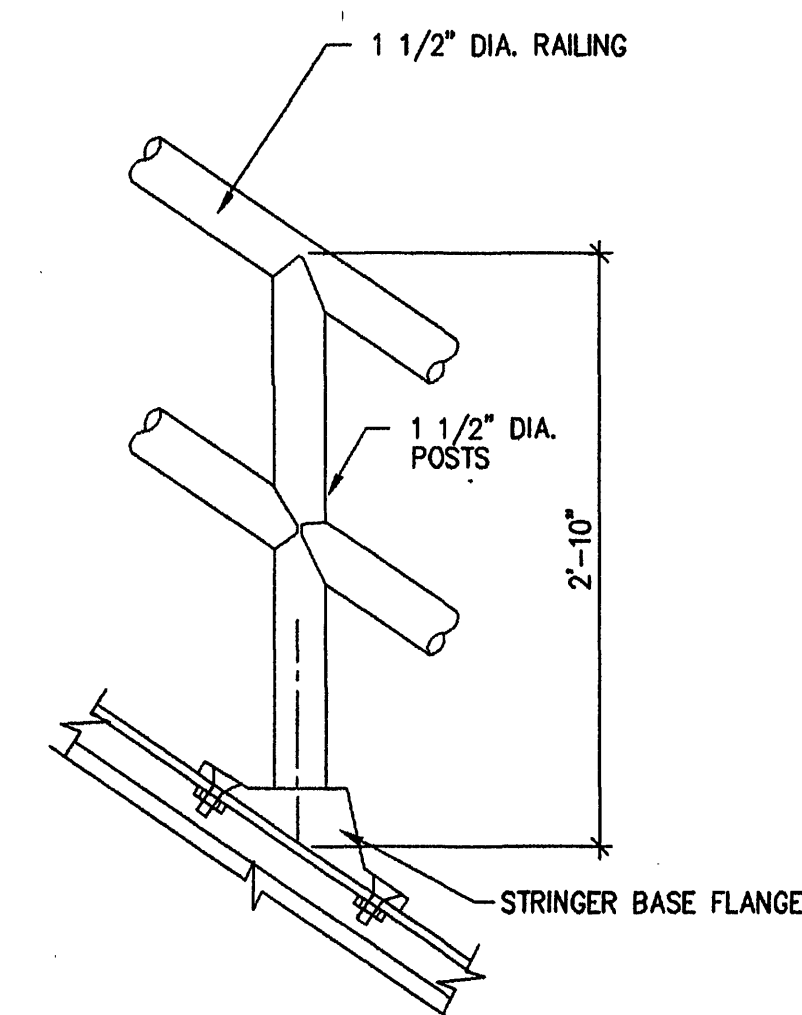


TYPICAL STRINGER MOUNT

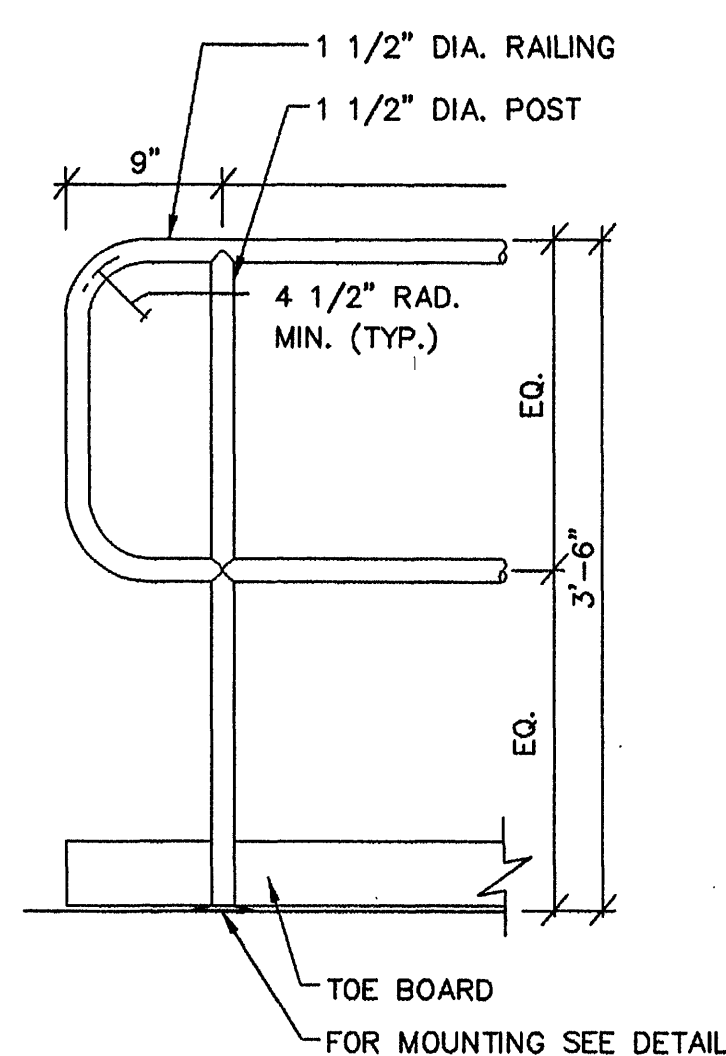


TYPICAL RAILING END

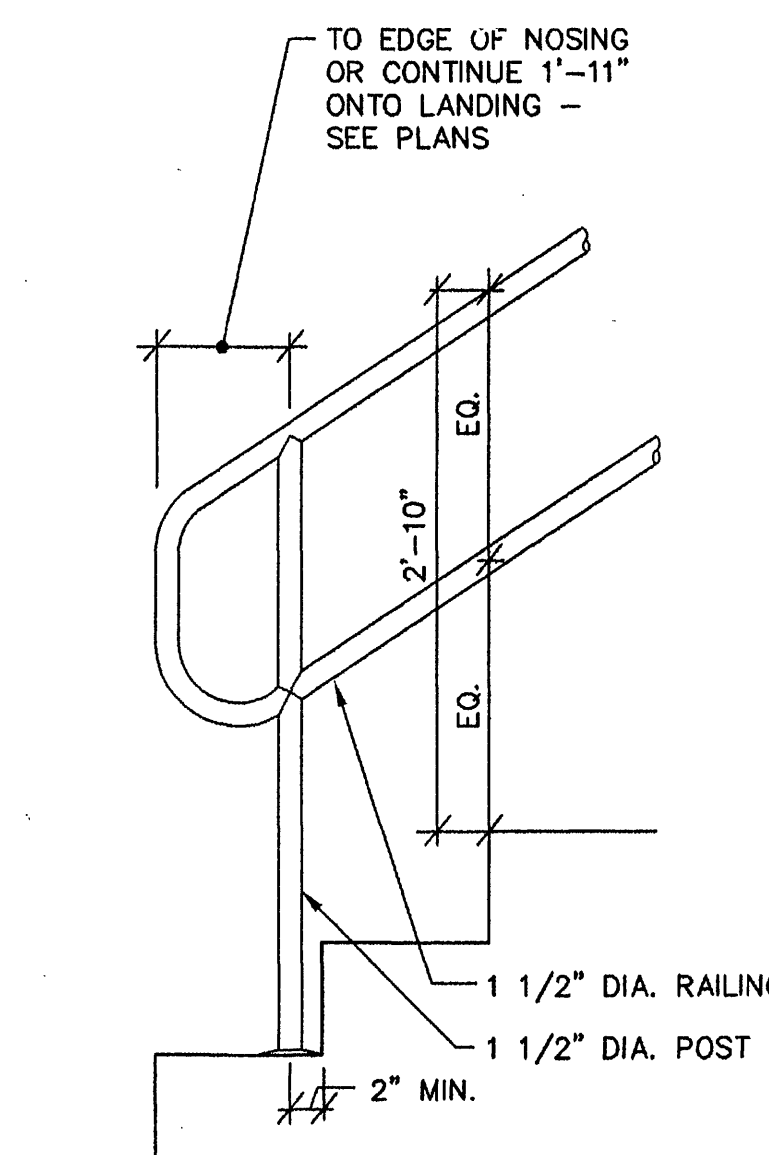


TYPICAL STAIR END

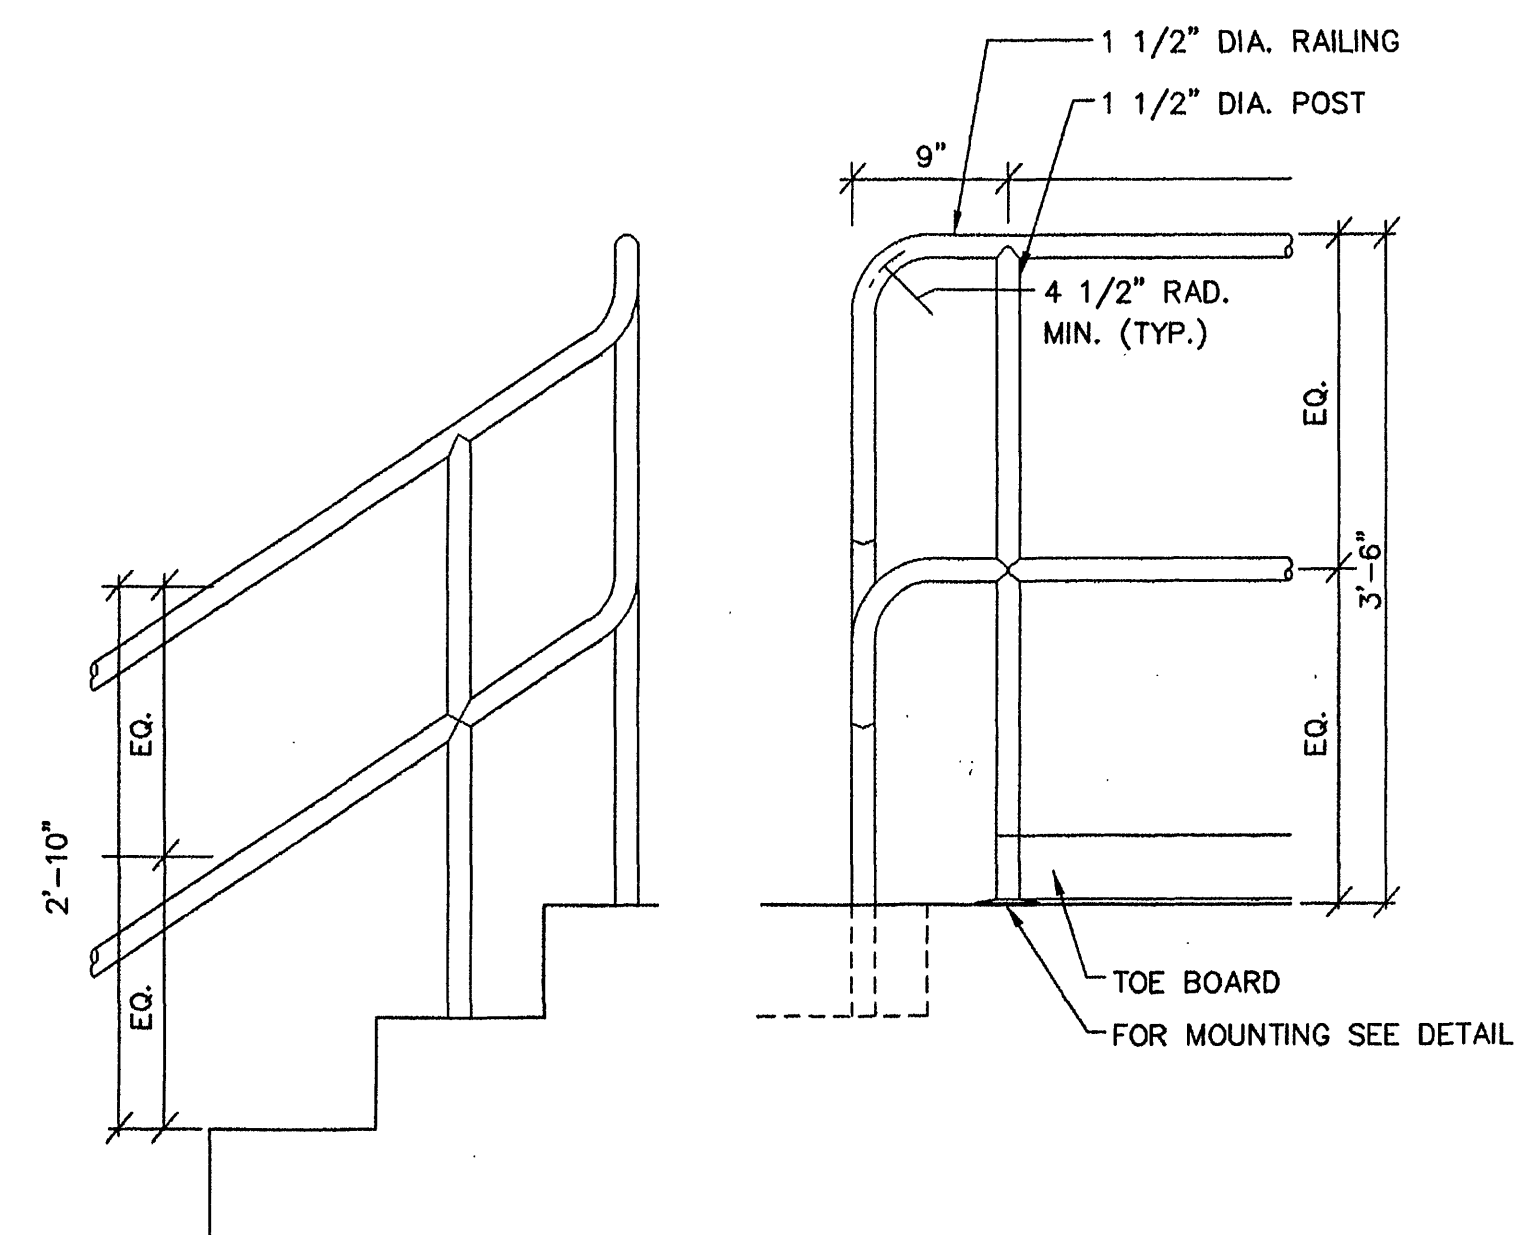

TYPICAL STAIR CORNER

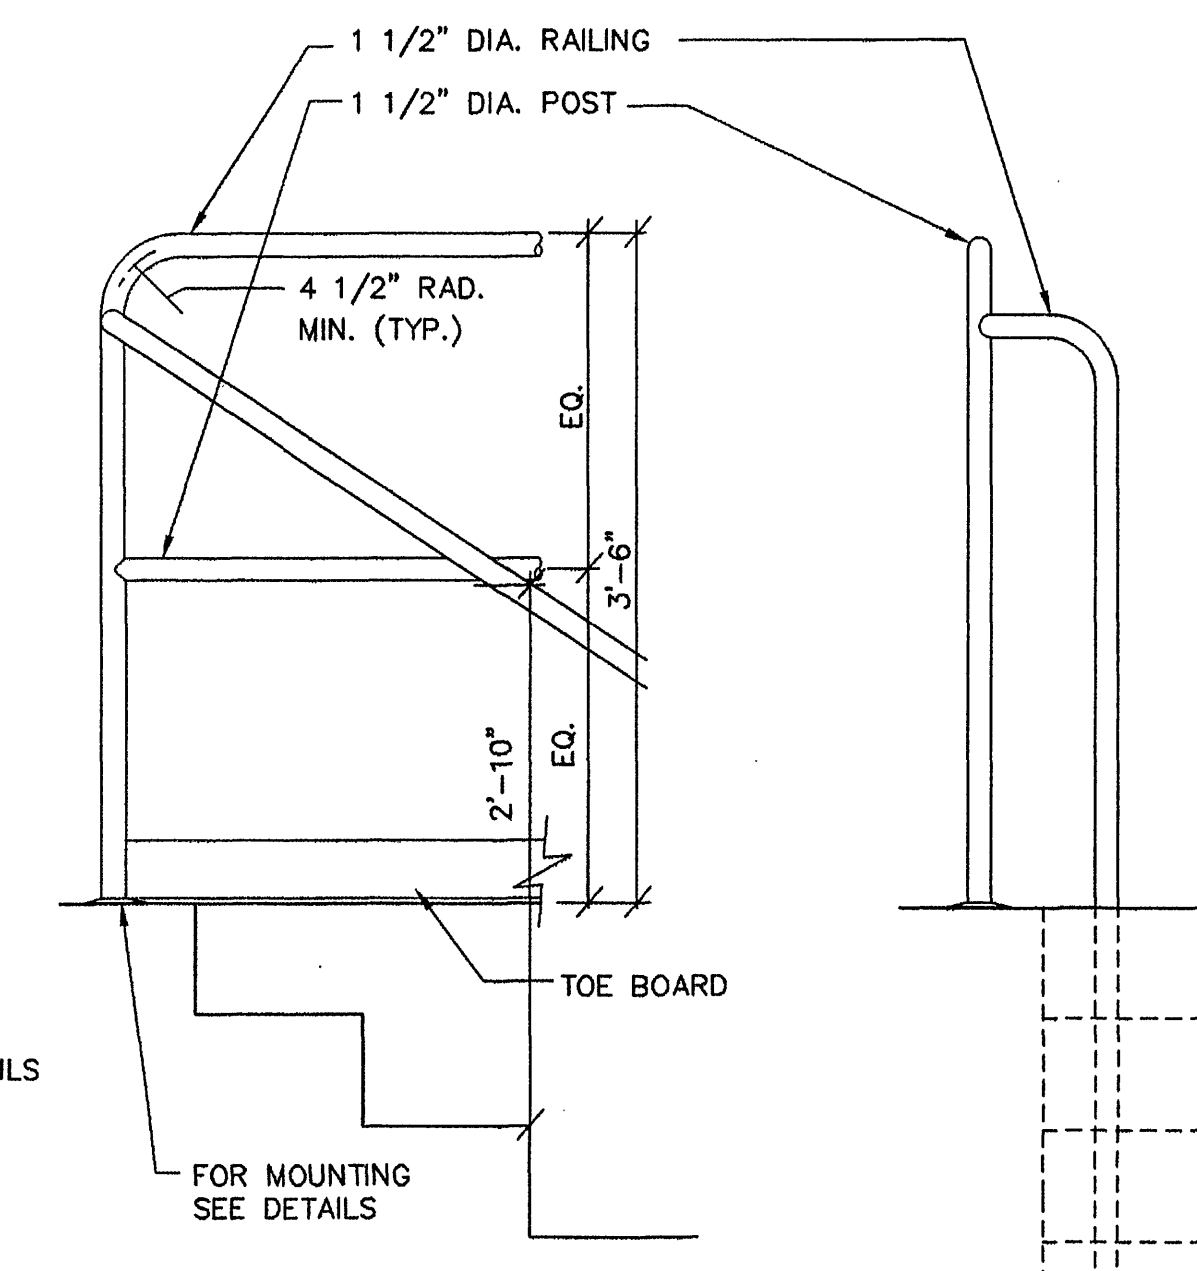

RAILING TO HANDRAIL

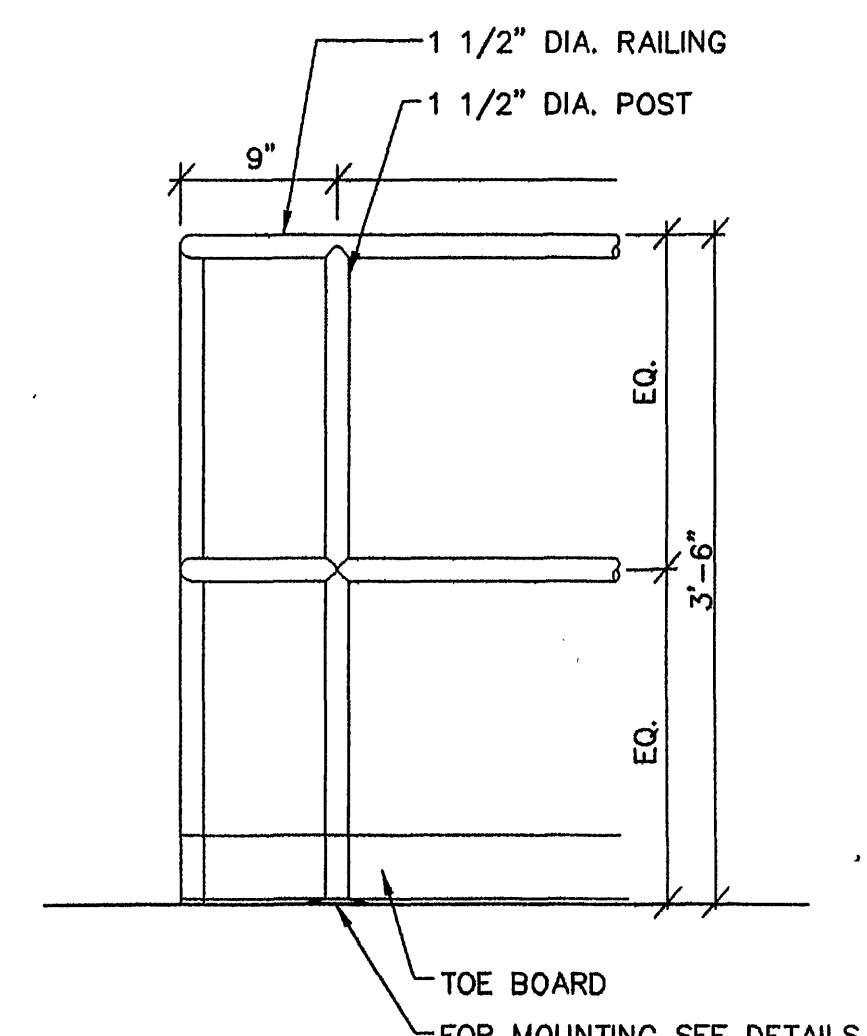

TYPICAL RAILING CORNER

MALCOLM PIRNIE
11832 Rock Landing Drive, Suite 400
Newport News, Virginia 23606

REVISIONS			
NO.	BY	DATE	REMARKS
1	ARB	JAN. 2000	RECORD DRAWING

DES - KML
DWN - WEC
CKD - GJJ



CITY OF ROANOKE, VIRGINIA
WATER POLLUTION
CONTROL PLANT
UPGRADE AND EXPANSION

RAILING AND HANDRAIL DETAILS

NOT TO SCALE

COPYRIGHT © 1997
MALCOLM PIRNIE, INC.
DATE MAY 1997
M SHEET 5 OF 26
CAD REF. NO. 0060M005