
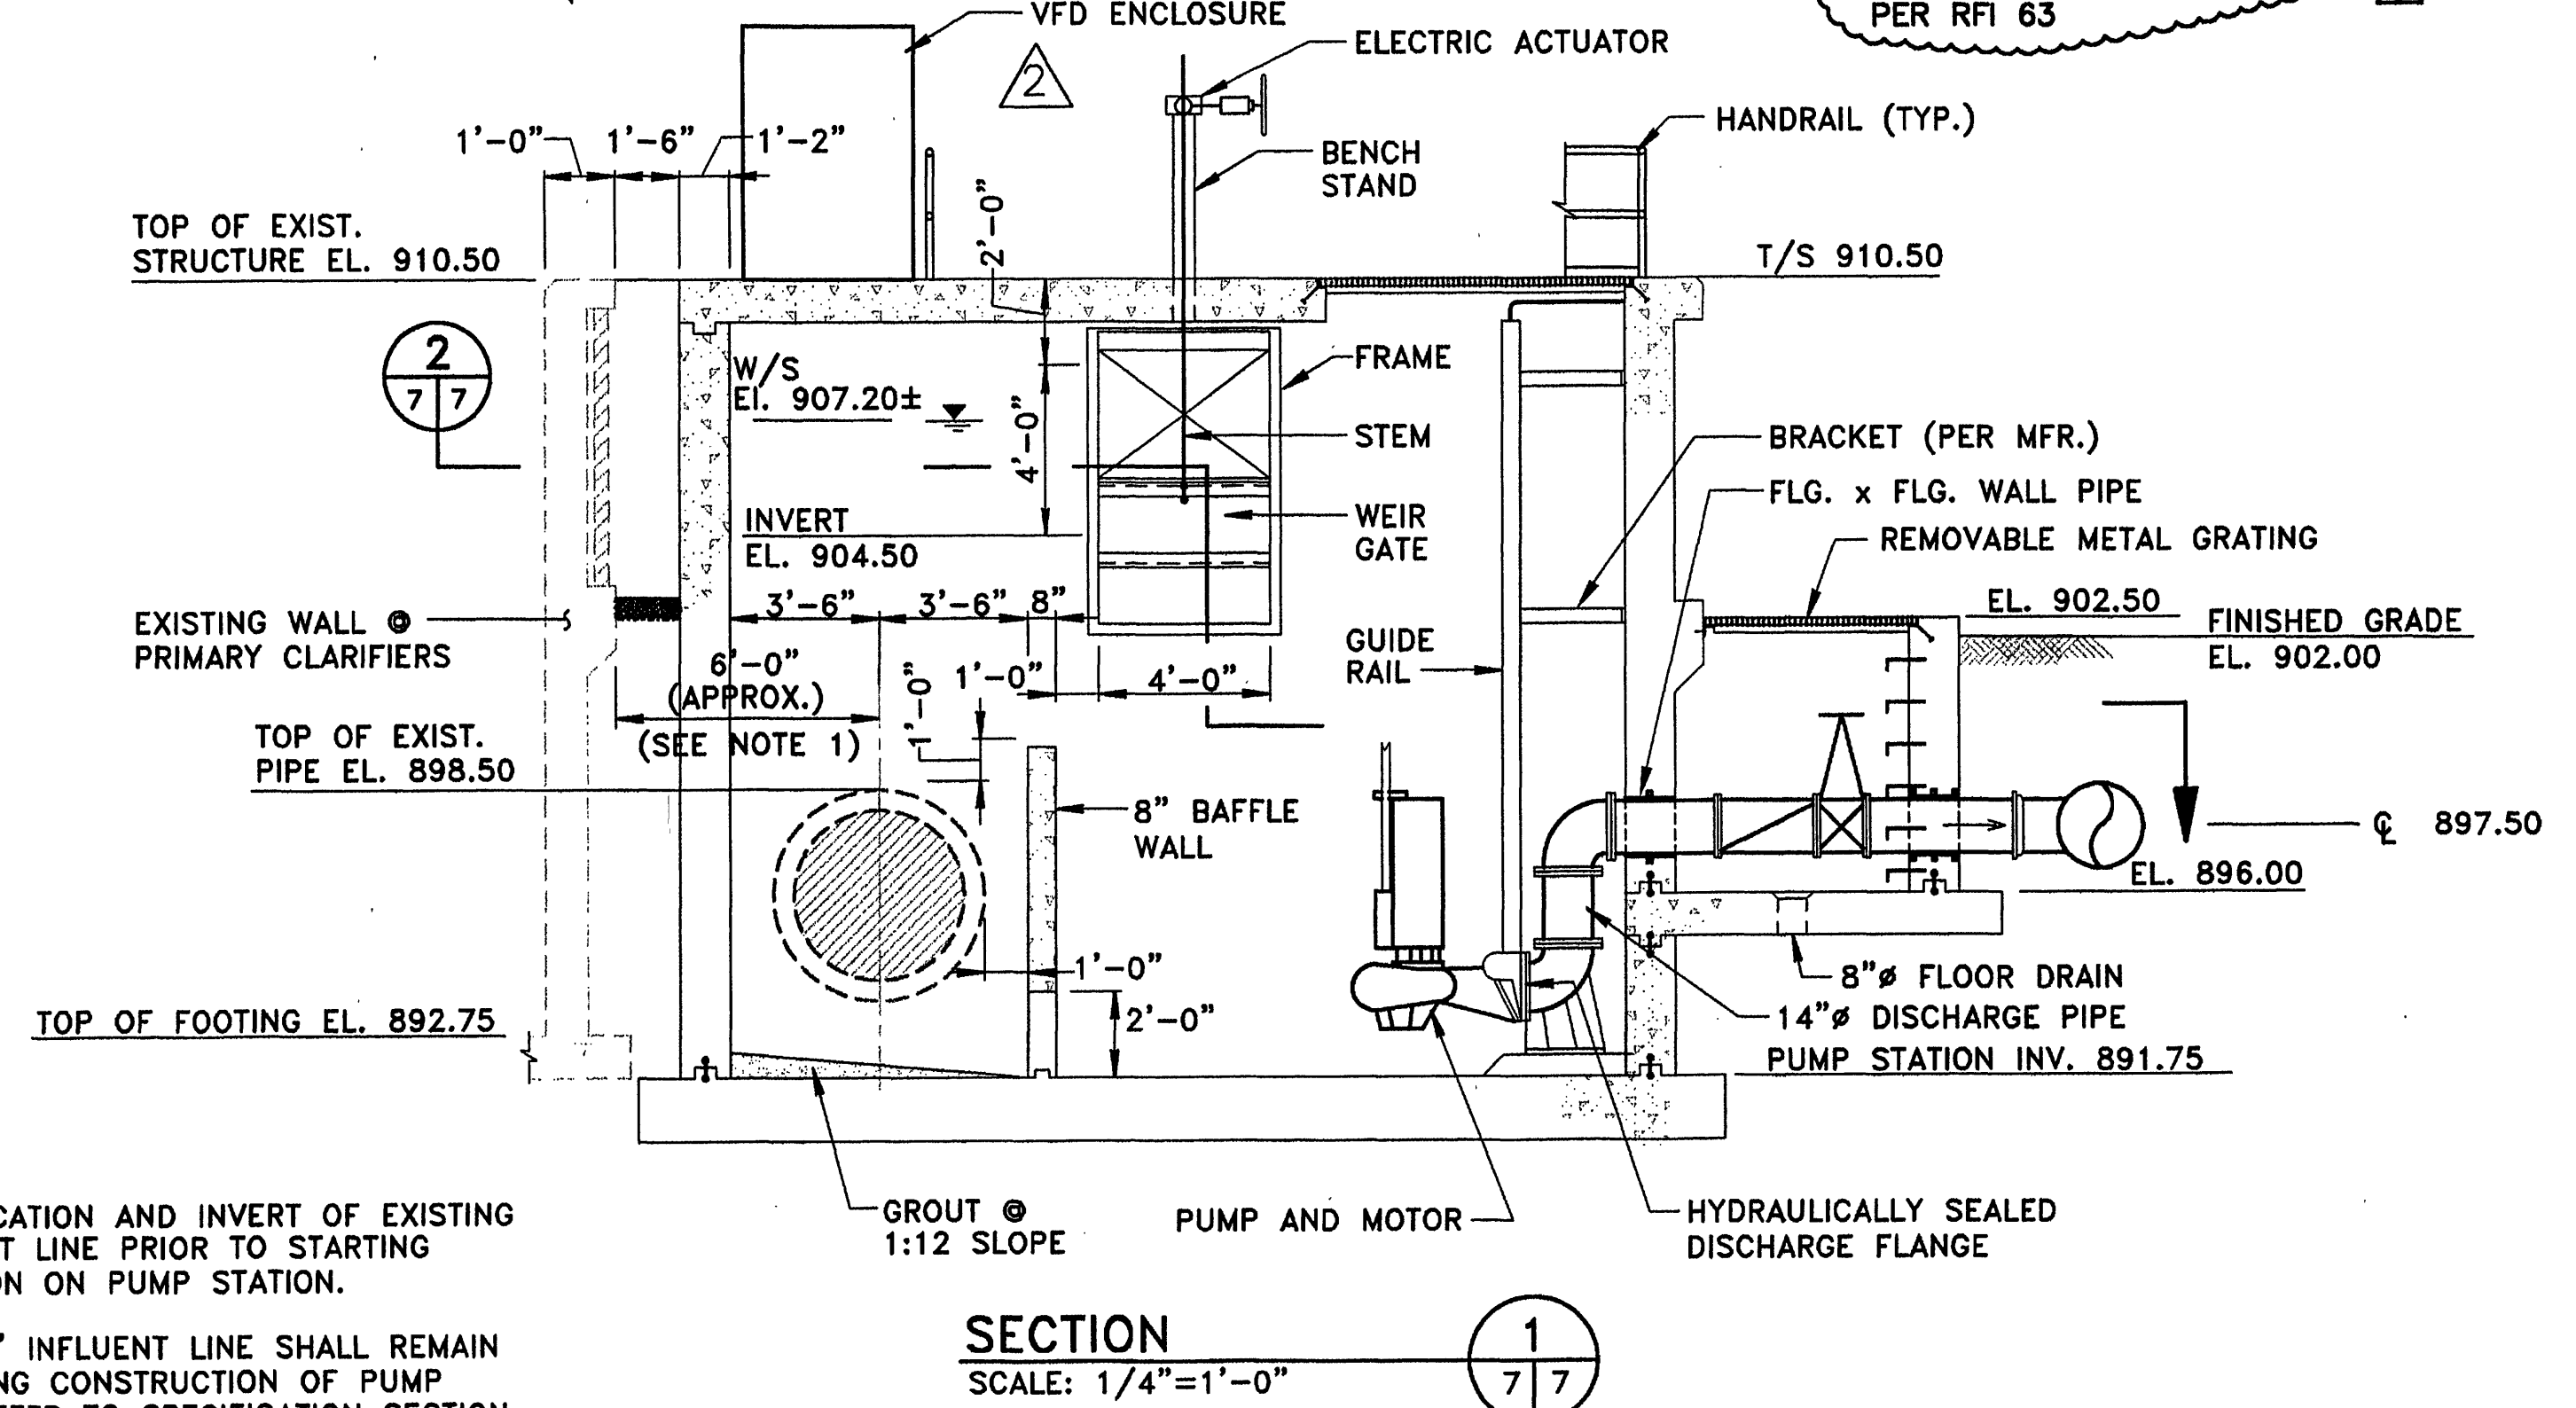
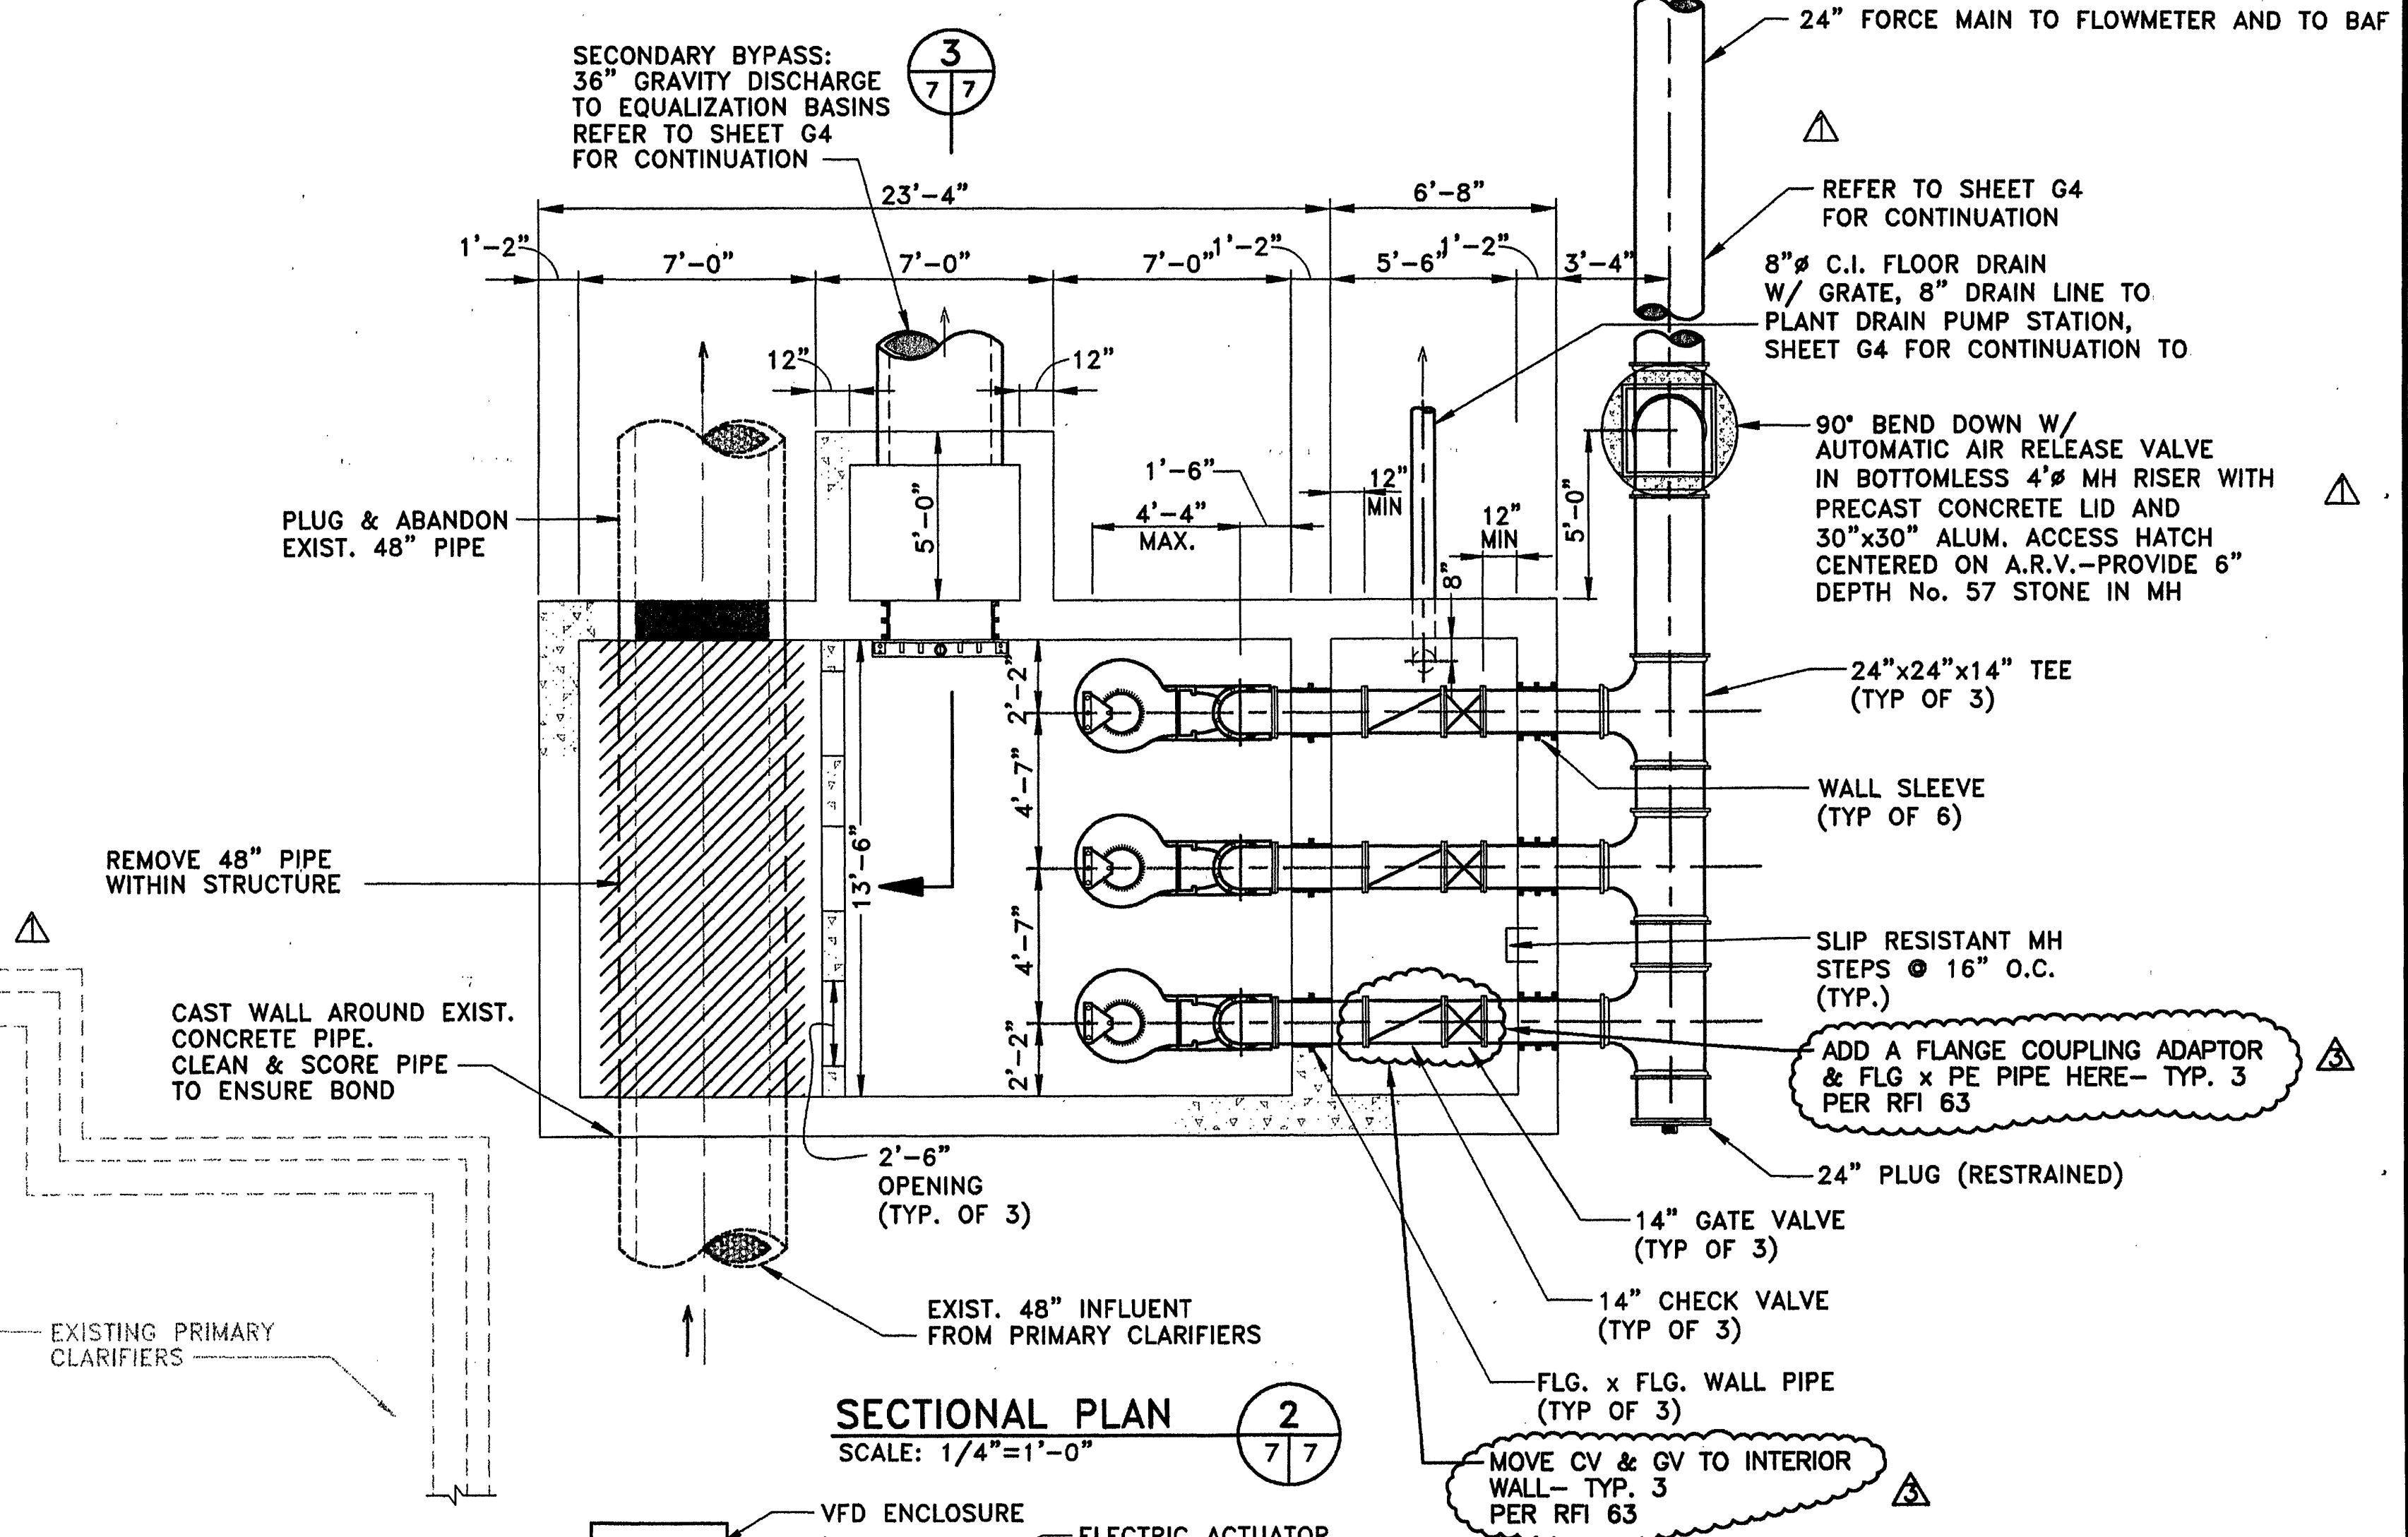
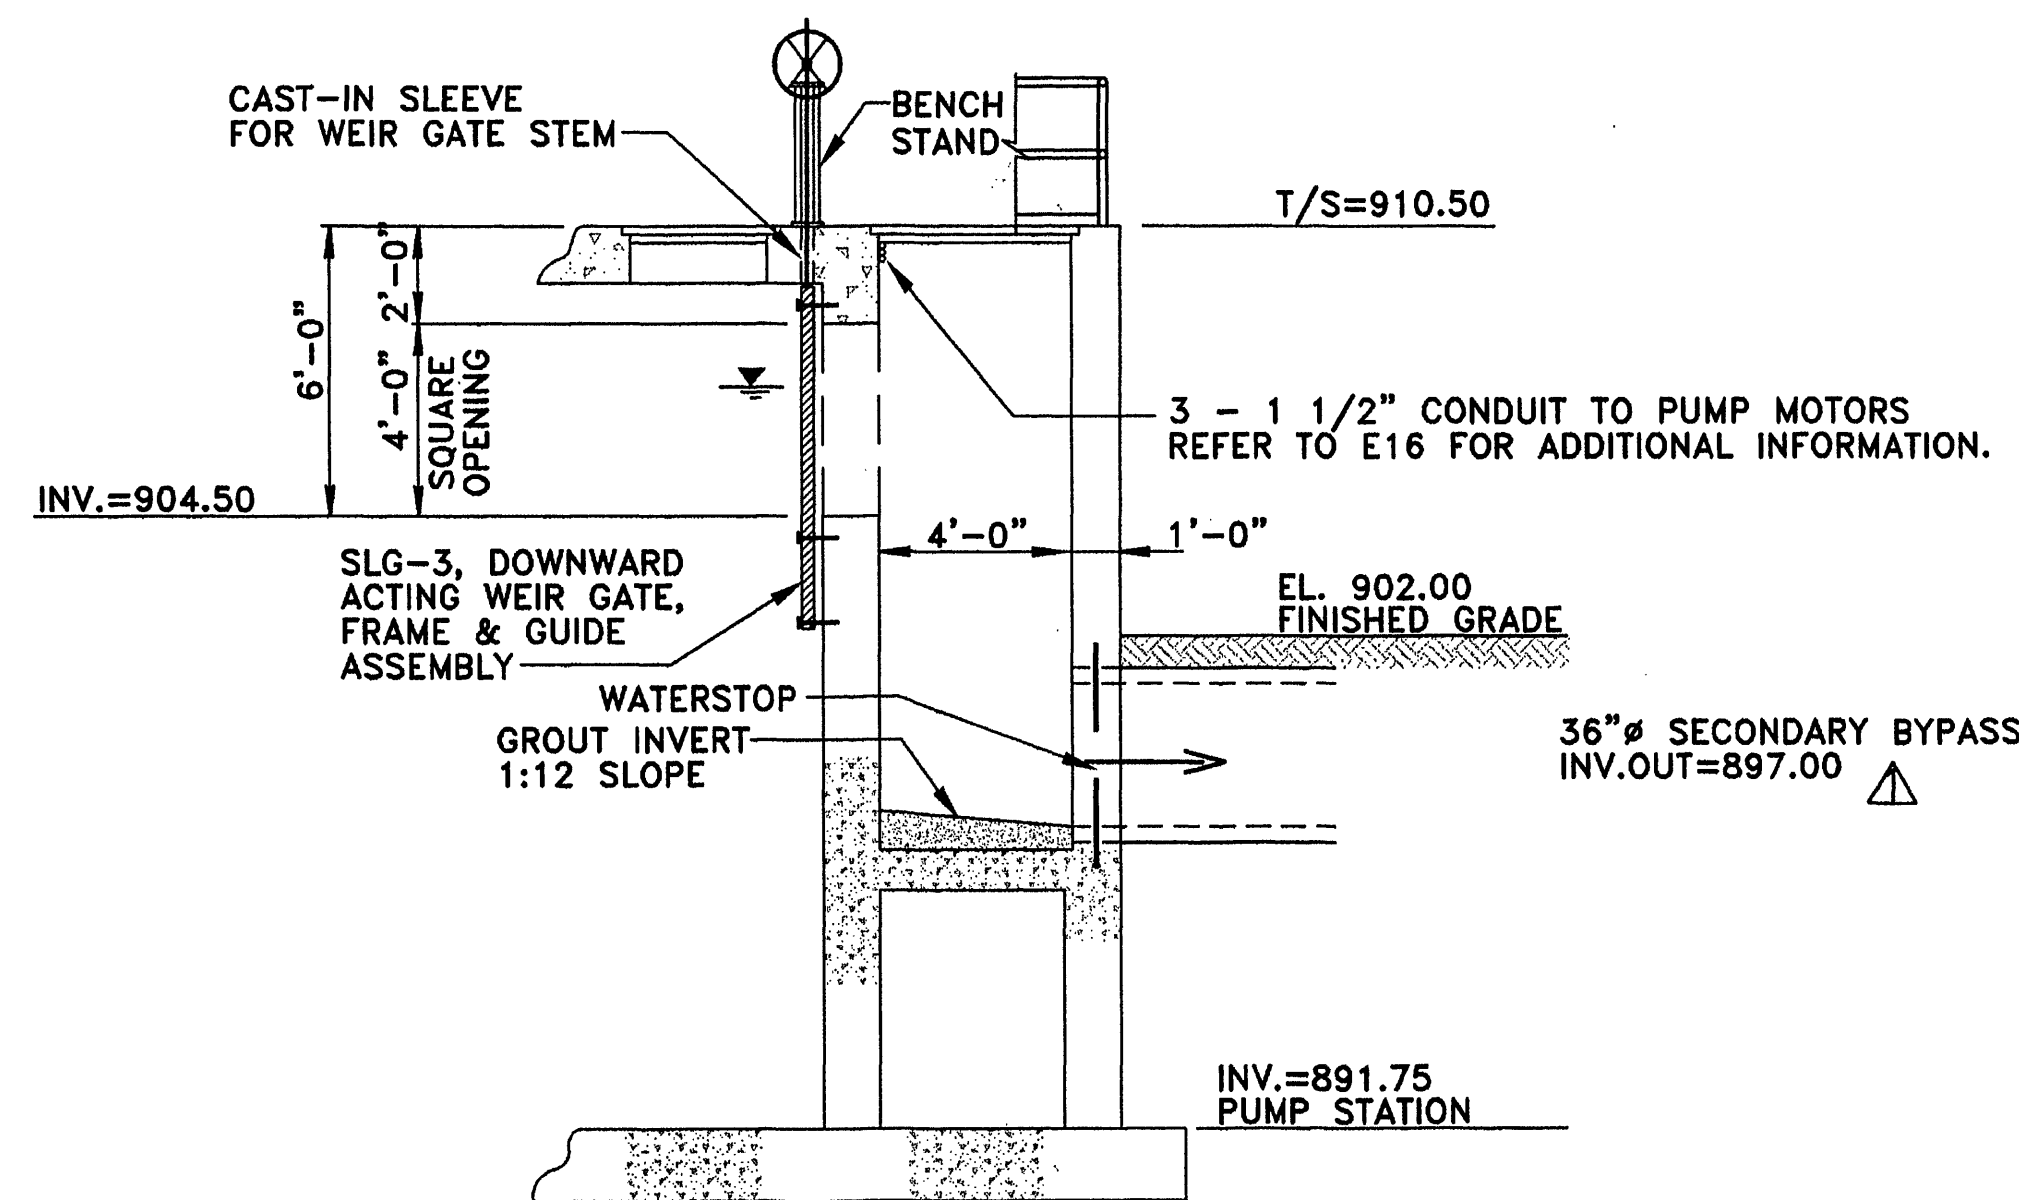


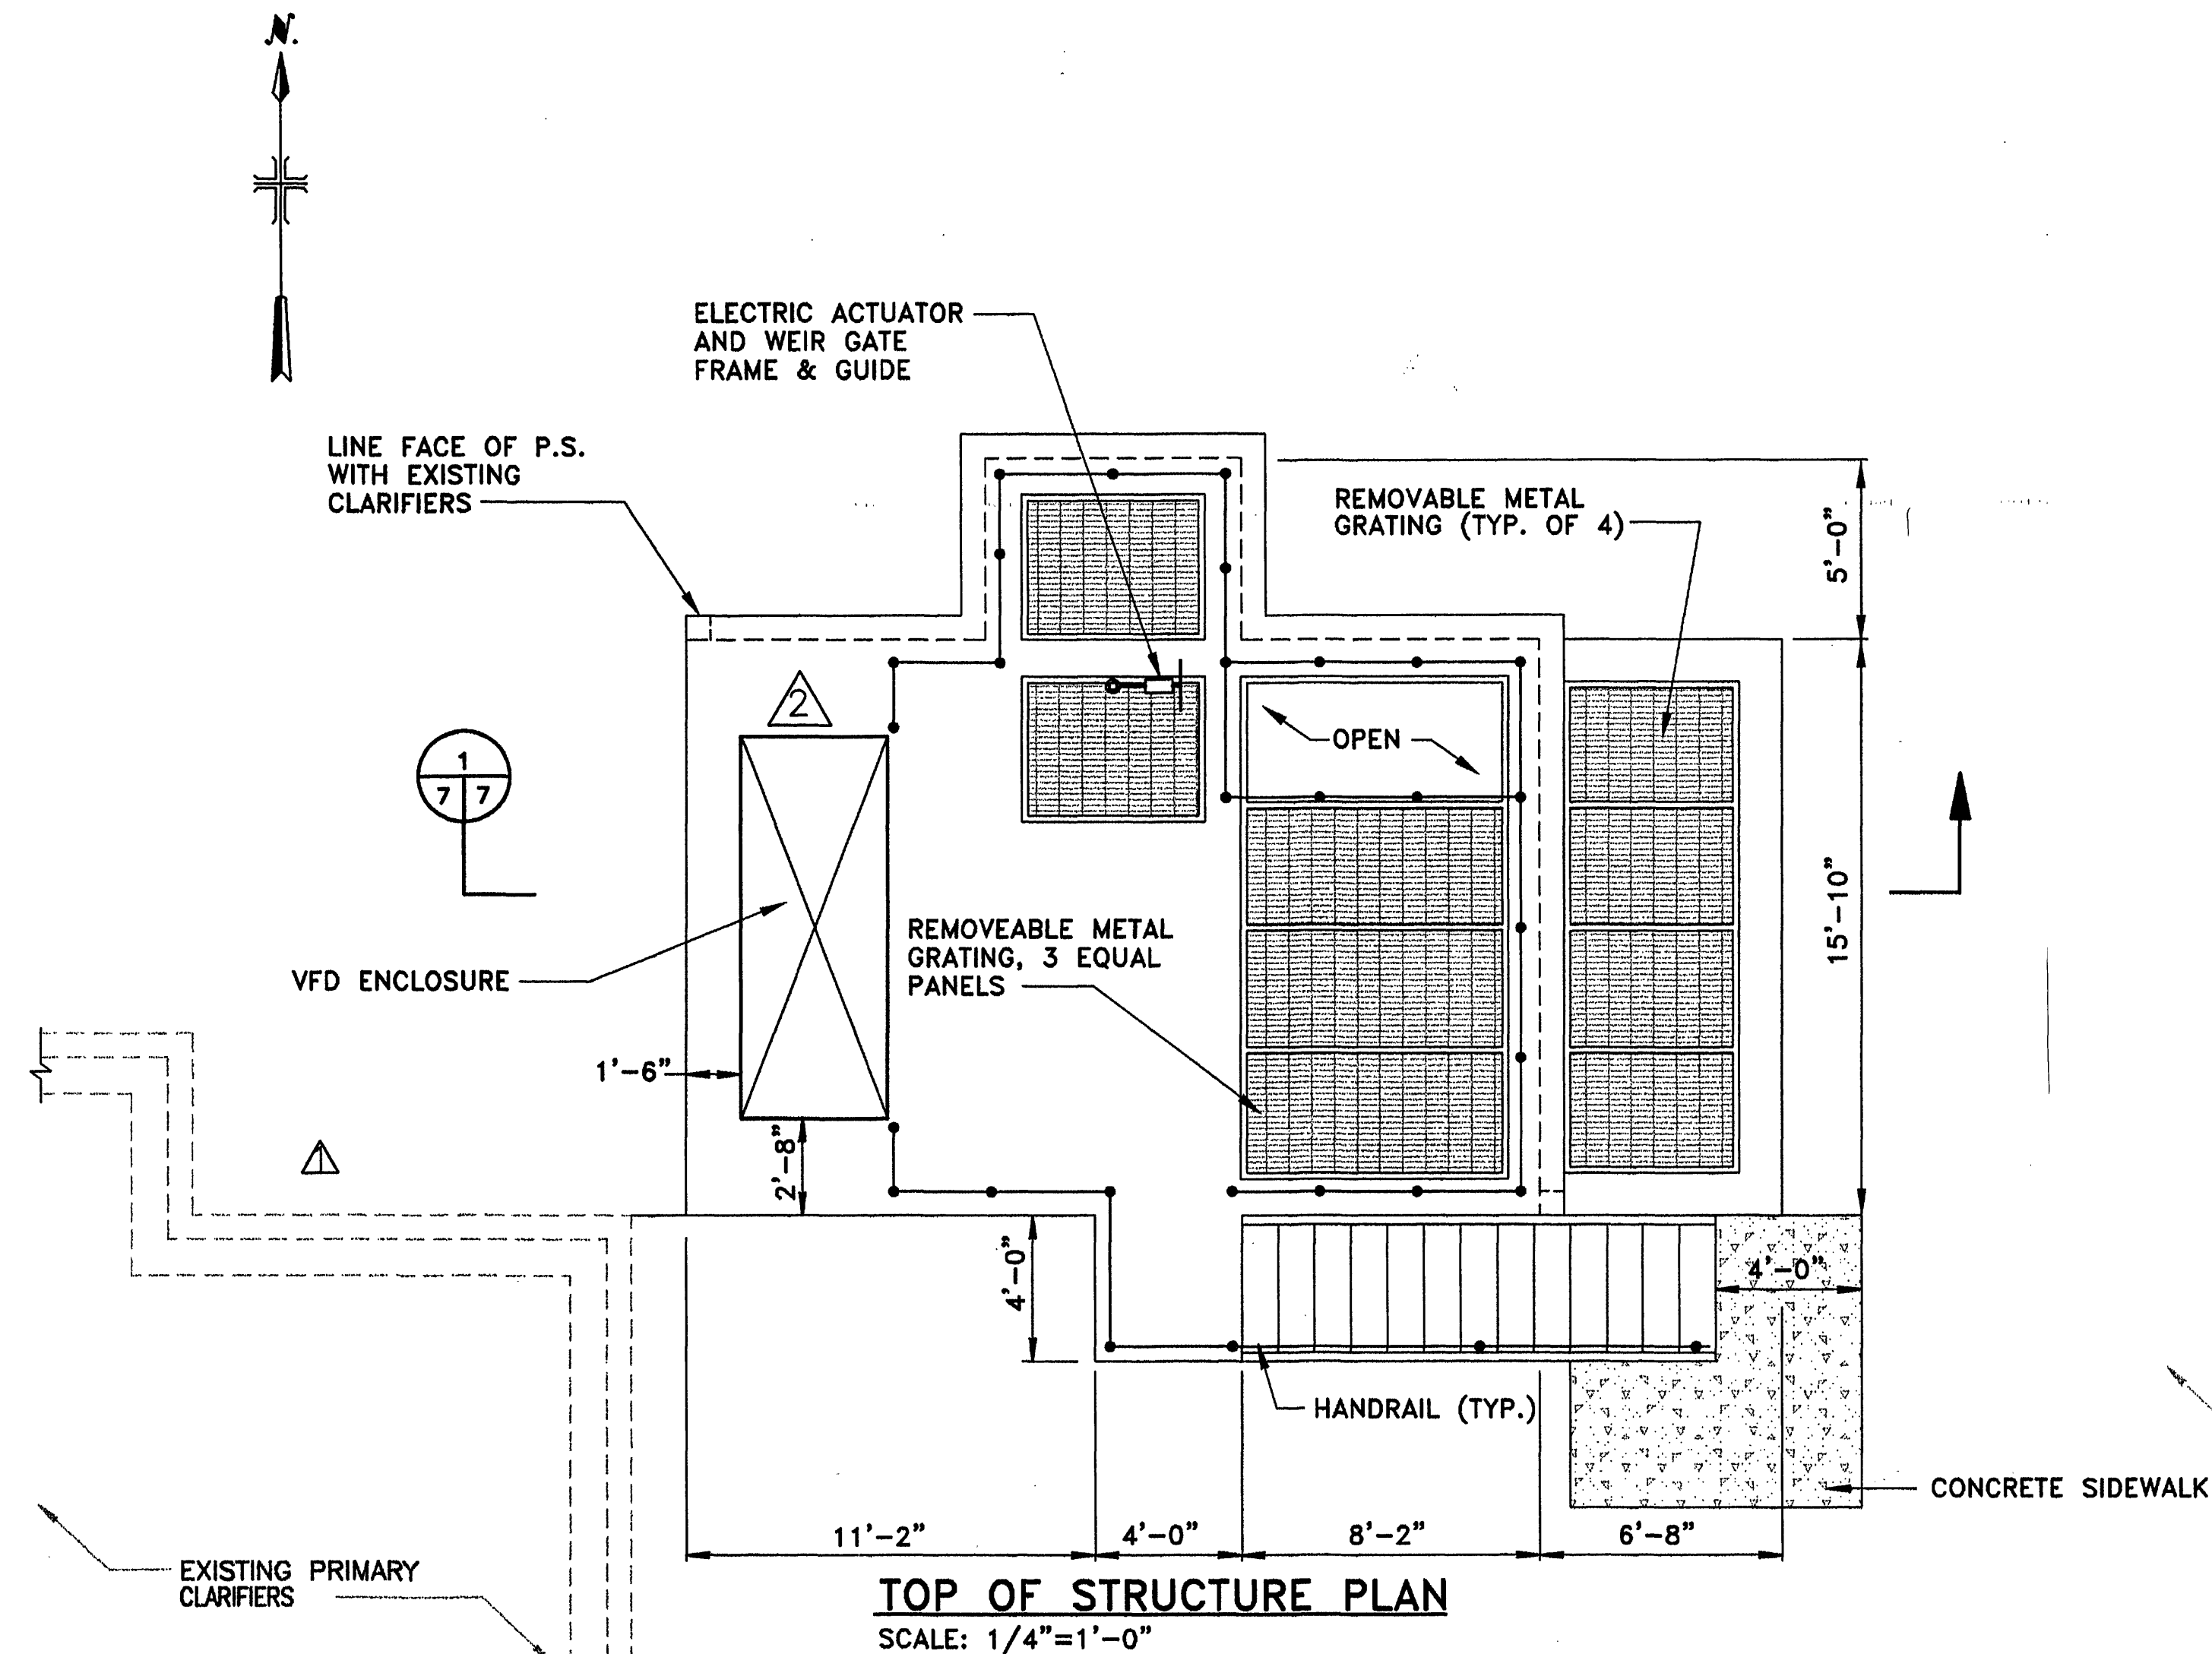

- NOTES**
1. CONFIRM LOCATION AND INVERT OF EXISTING 48" INFLUENT LINE PRIOR TO STARTING CONSTRUCTION ON PUMP STATION.
 2. EXISTING 48" INFLUENT LINE SHALL REMAIN ACTIVE DURING CONSTRUCTION OF PUMP STATION. REFER TO SPECIFICATION SECTION 01014 FOR ADDITIONAL INFORMATION.