



PLAN @ EL. 880.00

NOTES:

- * INDICATES DIMENSIONS TO BE FIELD VERIFIED OR TO BE COORDINATED WITH EQUIPMENT FURNISHED.
- APPROXIMATE LIMITS OF SHEETING AND SHORING ARE SHOWN ON SHEET M-12. SEE SPECIFICATION SECTION 02390 FOR DETAILS.
- AFTER COMPLETION OF NEW INFLUENT PUMP STATION, CONTRACTOR SHALL REMOVE STOP LOGS FROM 60" AND 54" PUMP STATION INFLUENT LINES.
- CONTRACTOR MUST PROVIDE TEMPORARY SCREENINGS REMOVAL DURING CONSTRUCTION OF INFLUENT PUMP STATION. SEE SPECIFICATIONS FOR DETAILS.
- EXISTING TINKER CREEK INTERCEPTOR MAY CONTAIN WASTEWATER. CONTRACTOR SHALL PROVIDE ALL NECESSARY PIPE PLUGS TO PREVENT SPILLAGE DURING PIPE REMOVAL.
- CONTRACTOR SHALL SLOPE GRADE ON EITHER SIDE OF THE PUMP STATION BETWEEN THE PIPE BOLLARDS TO PROVIDE A SMOOTH TRANSITION FOR VEHICULAR TRAFFIC.

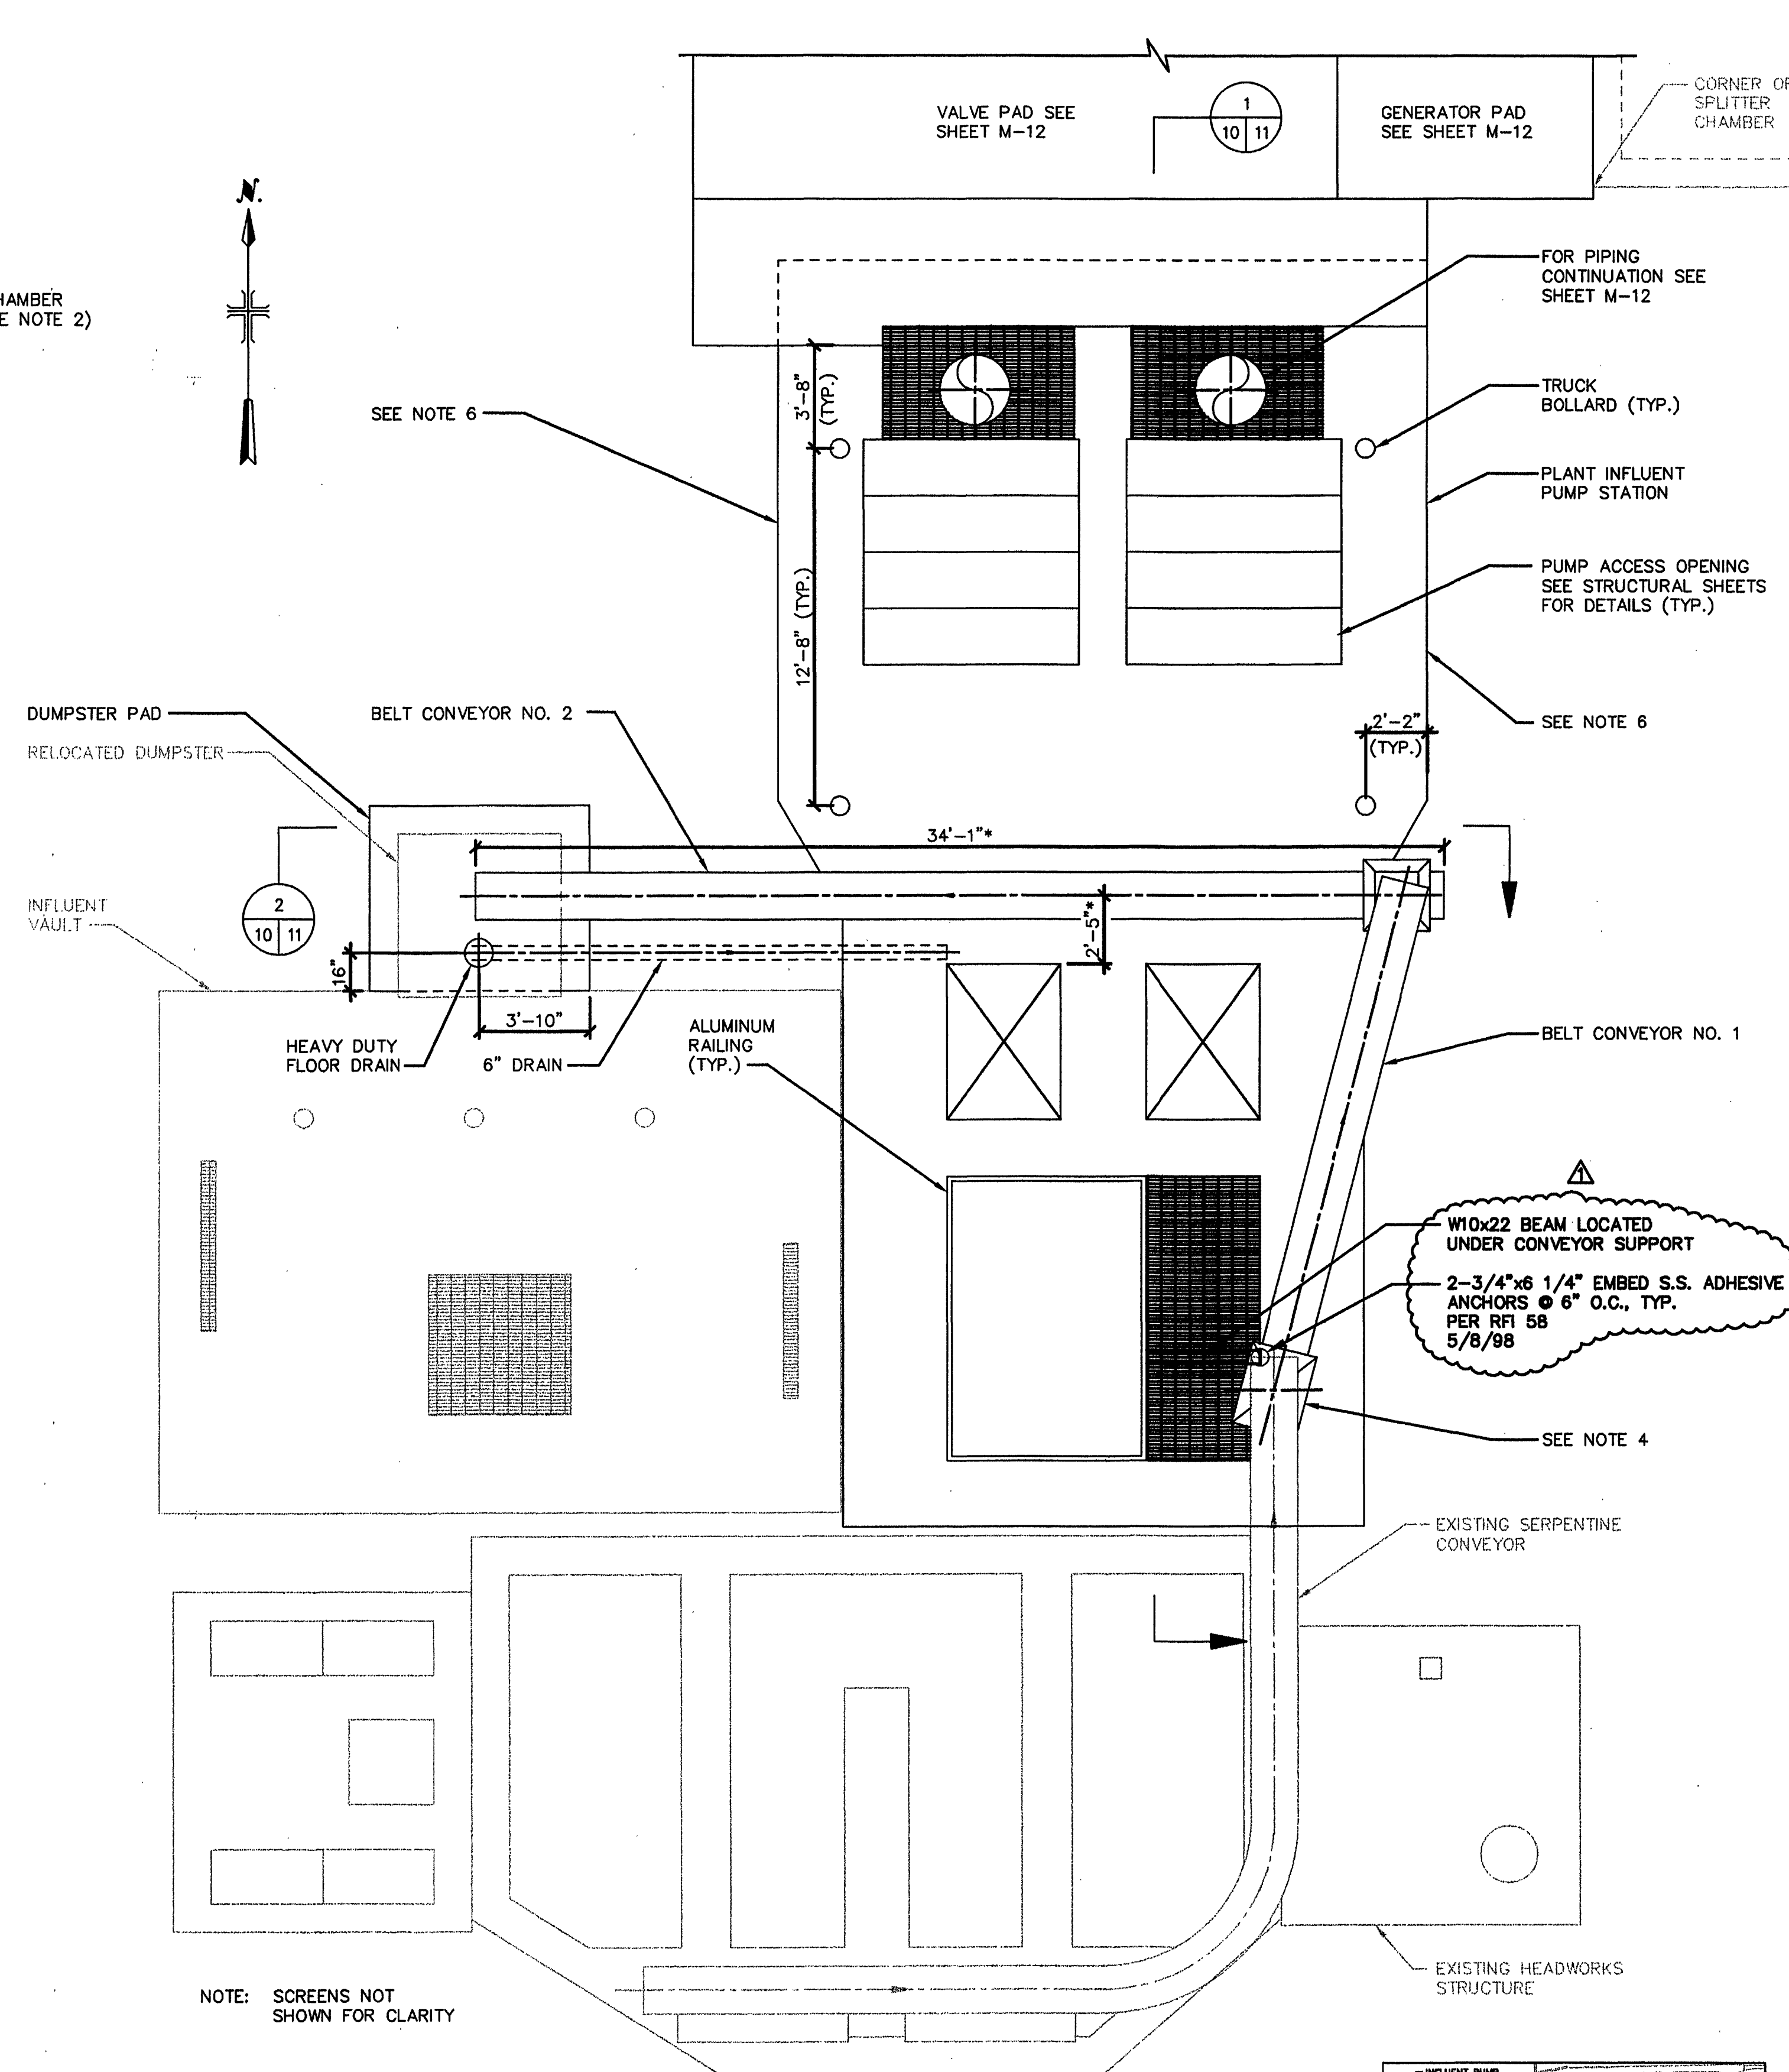

PLAN @ EL. 905.50

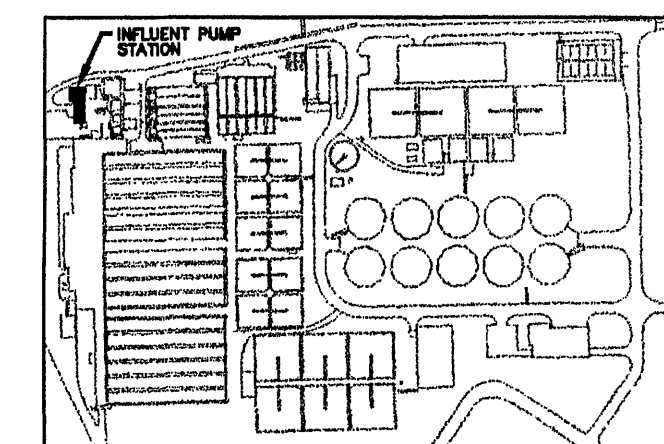

KEY PLAN
NTS

**MALCOLM
PIRNIE**

11832 Rock Landing Drive, Suite 400
Newport News, Virginia 23606

REVISIONS				REMARKS
NO.	BY	DATE	DESCRIPTION	
1	ARB	JAN. 2000	RECORD DRAWING	

DES - CWM
DWN - CWM
CKD - GJJ



CITY OF ROANOKE, VIRGINIA
**WATER POLLUTION
CONTROL PLANT
UPGRADE AND EXPANSION**

PLANT INFLUENT PUMP STATION

PLANS

SCALE: 1/4" = 1'-0"

COPYRIGHT © 1997
MALCOLM PIRNIE, INC.

DATE MAY 1997

M SHEET 10 OF 30

CAD REF. NO. 0060M010