
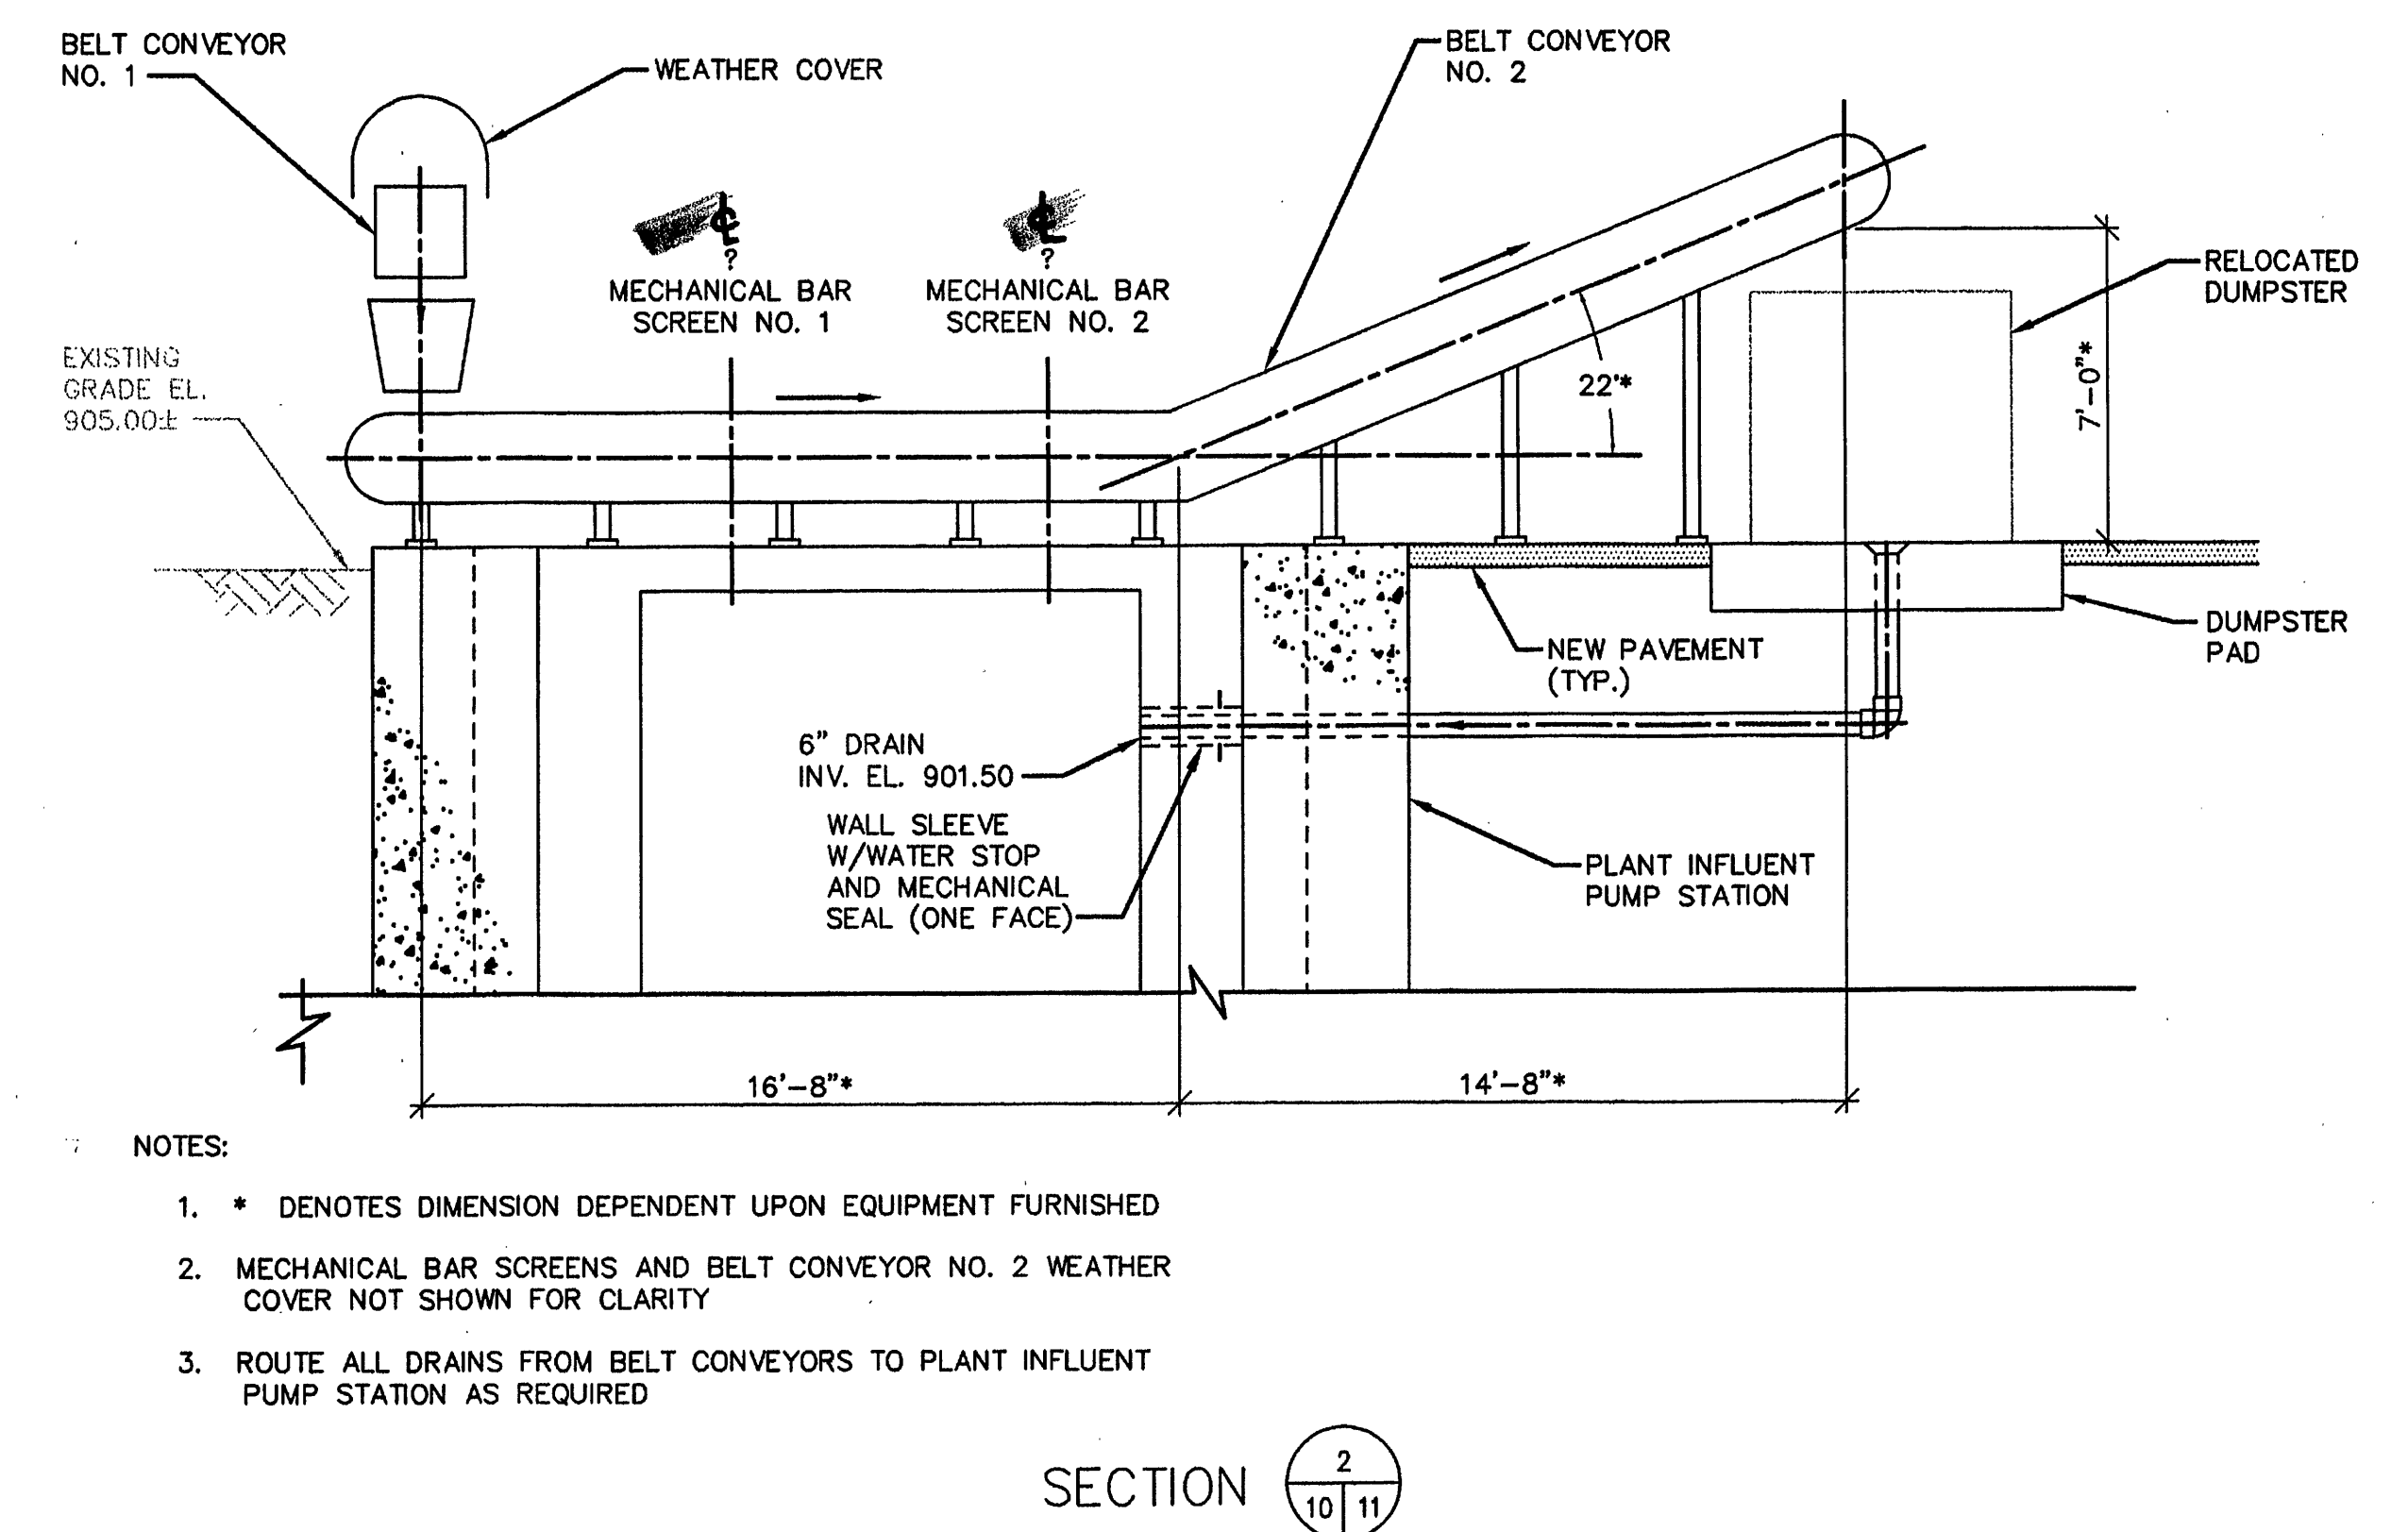


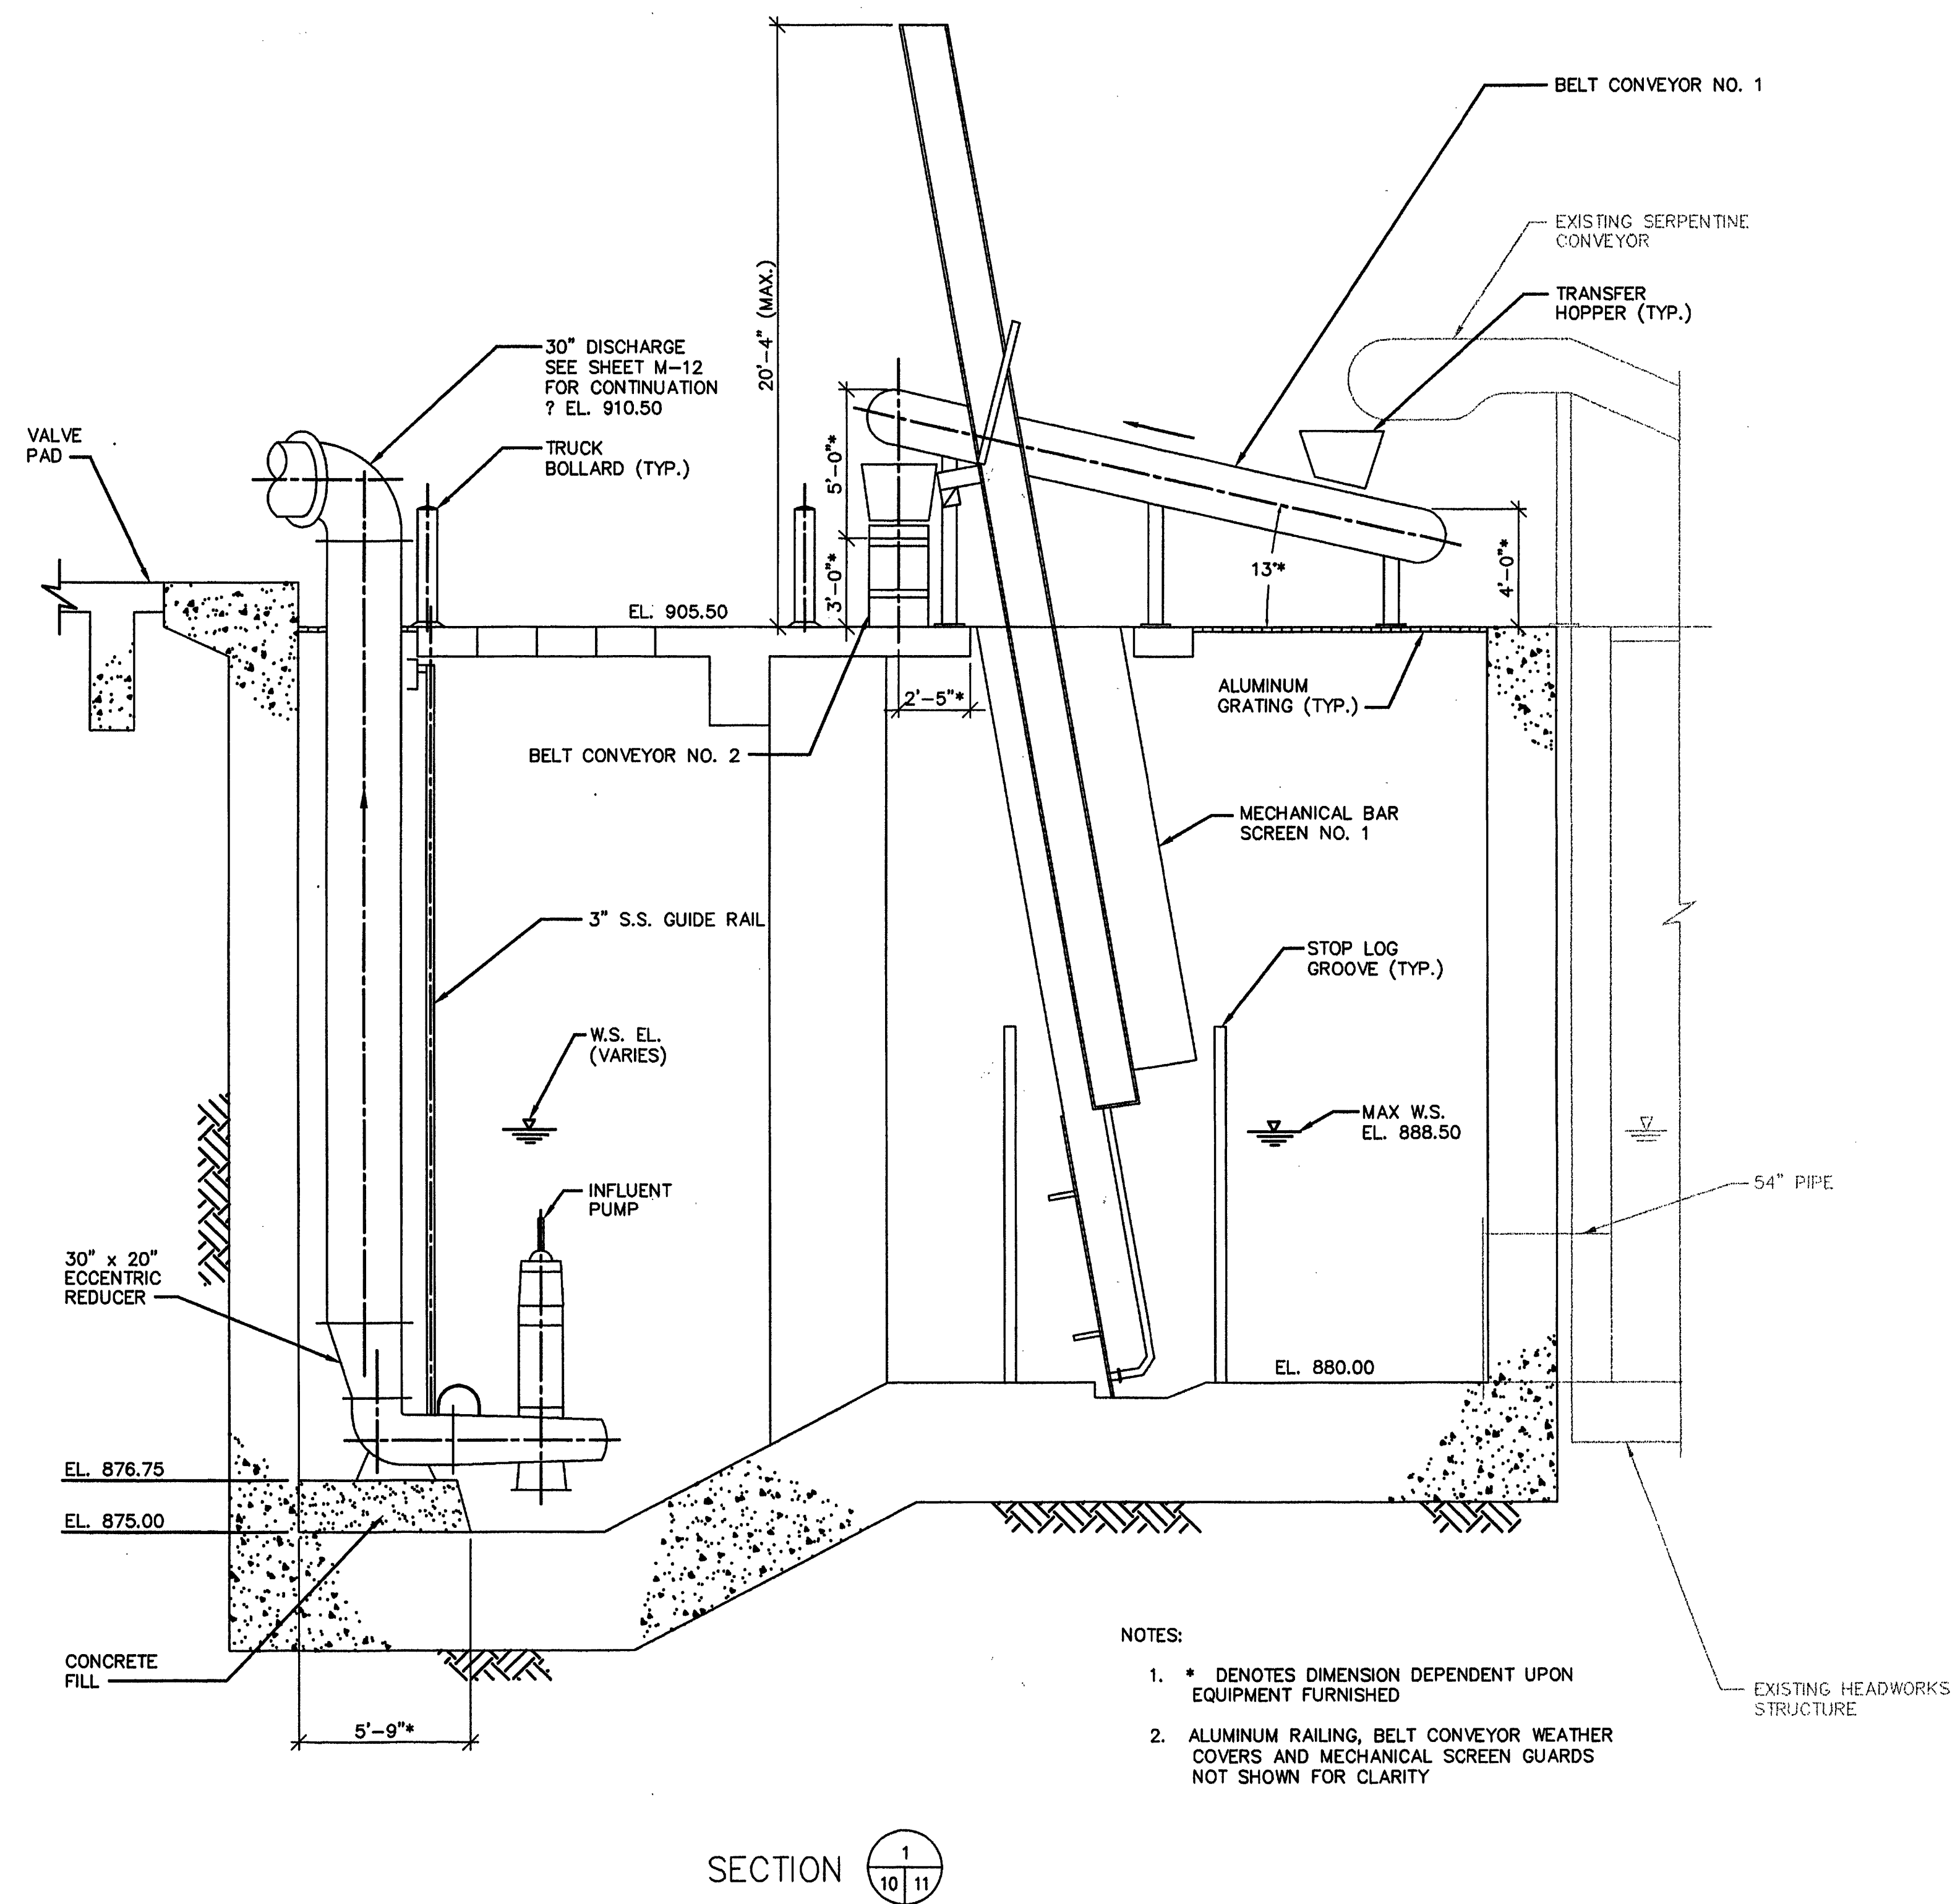

MALCOLM PIRNIE 11832 Rock Landing Drive, Suite 400 Newport News, Virginia 23606	REVISIONS				DES	-- CWM --	DWN	CWM / WEC	CKD	-- GUJ --	 ROANOKE VIRGINIA, CHARTERED 1802	CITY OF ROANOKE, VIRGINIA WATER POLLUTION CONTROL PLANT UPGRADE AND EXPANSION	PLANT INFLUENT PUMP STATION SECTIONS SCALE: 1/4" = 1'-0"	COPYRIGHT © 1997 MALCOLM PIRNIE, INC. DATE <u> MAY 1997 </u> M SHEET <u> 11 </u> OF <u> 30 </u> CAD REF. NO. <u>0060M011</u>
	NO.	BY	DATE	REMARKS										
	1	ARB	JAN. 2000	RECORD DRAWING										