

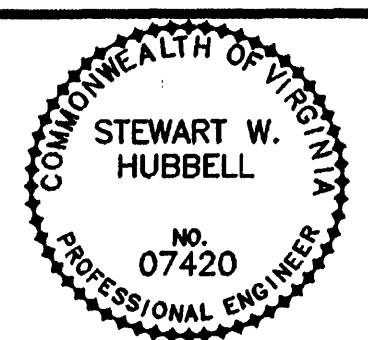


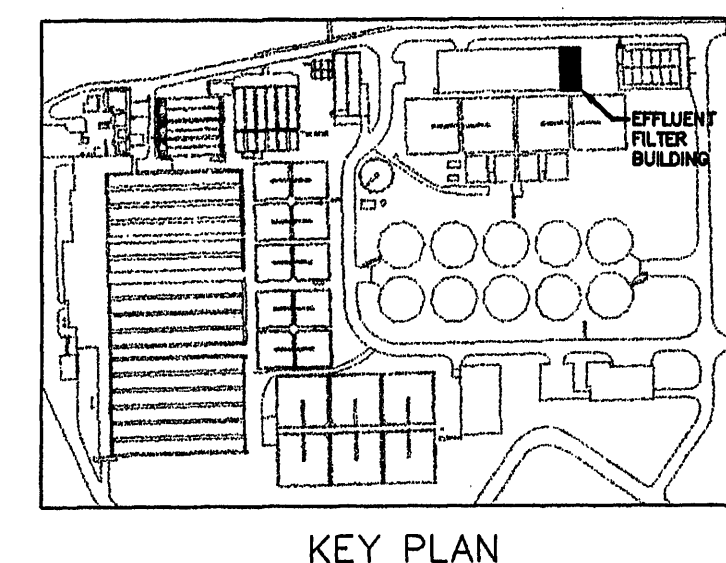

Mattern & Craig, Inc.
CONSULTING ENGINEERS - SURVEYORS
701 FIRST STREET, S.W.
ROANOKE, VIRGINIA 24004
540-345-2444
540-345-7081 FAX

REVISIONS				
NO.	BY	DATE	REVISIONS	REMARKS
1	SWH	JAN. 2000	RECORD DRAWING	

DES: BCC
DWN: ARB,LDL
CKD: SWH

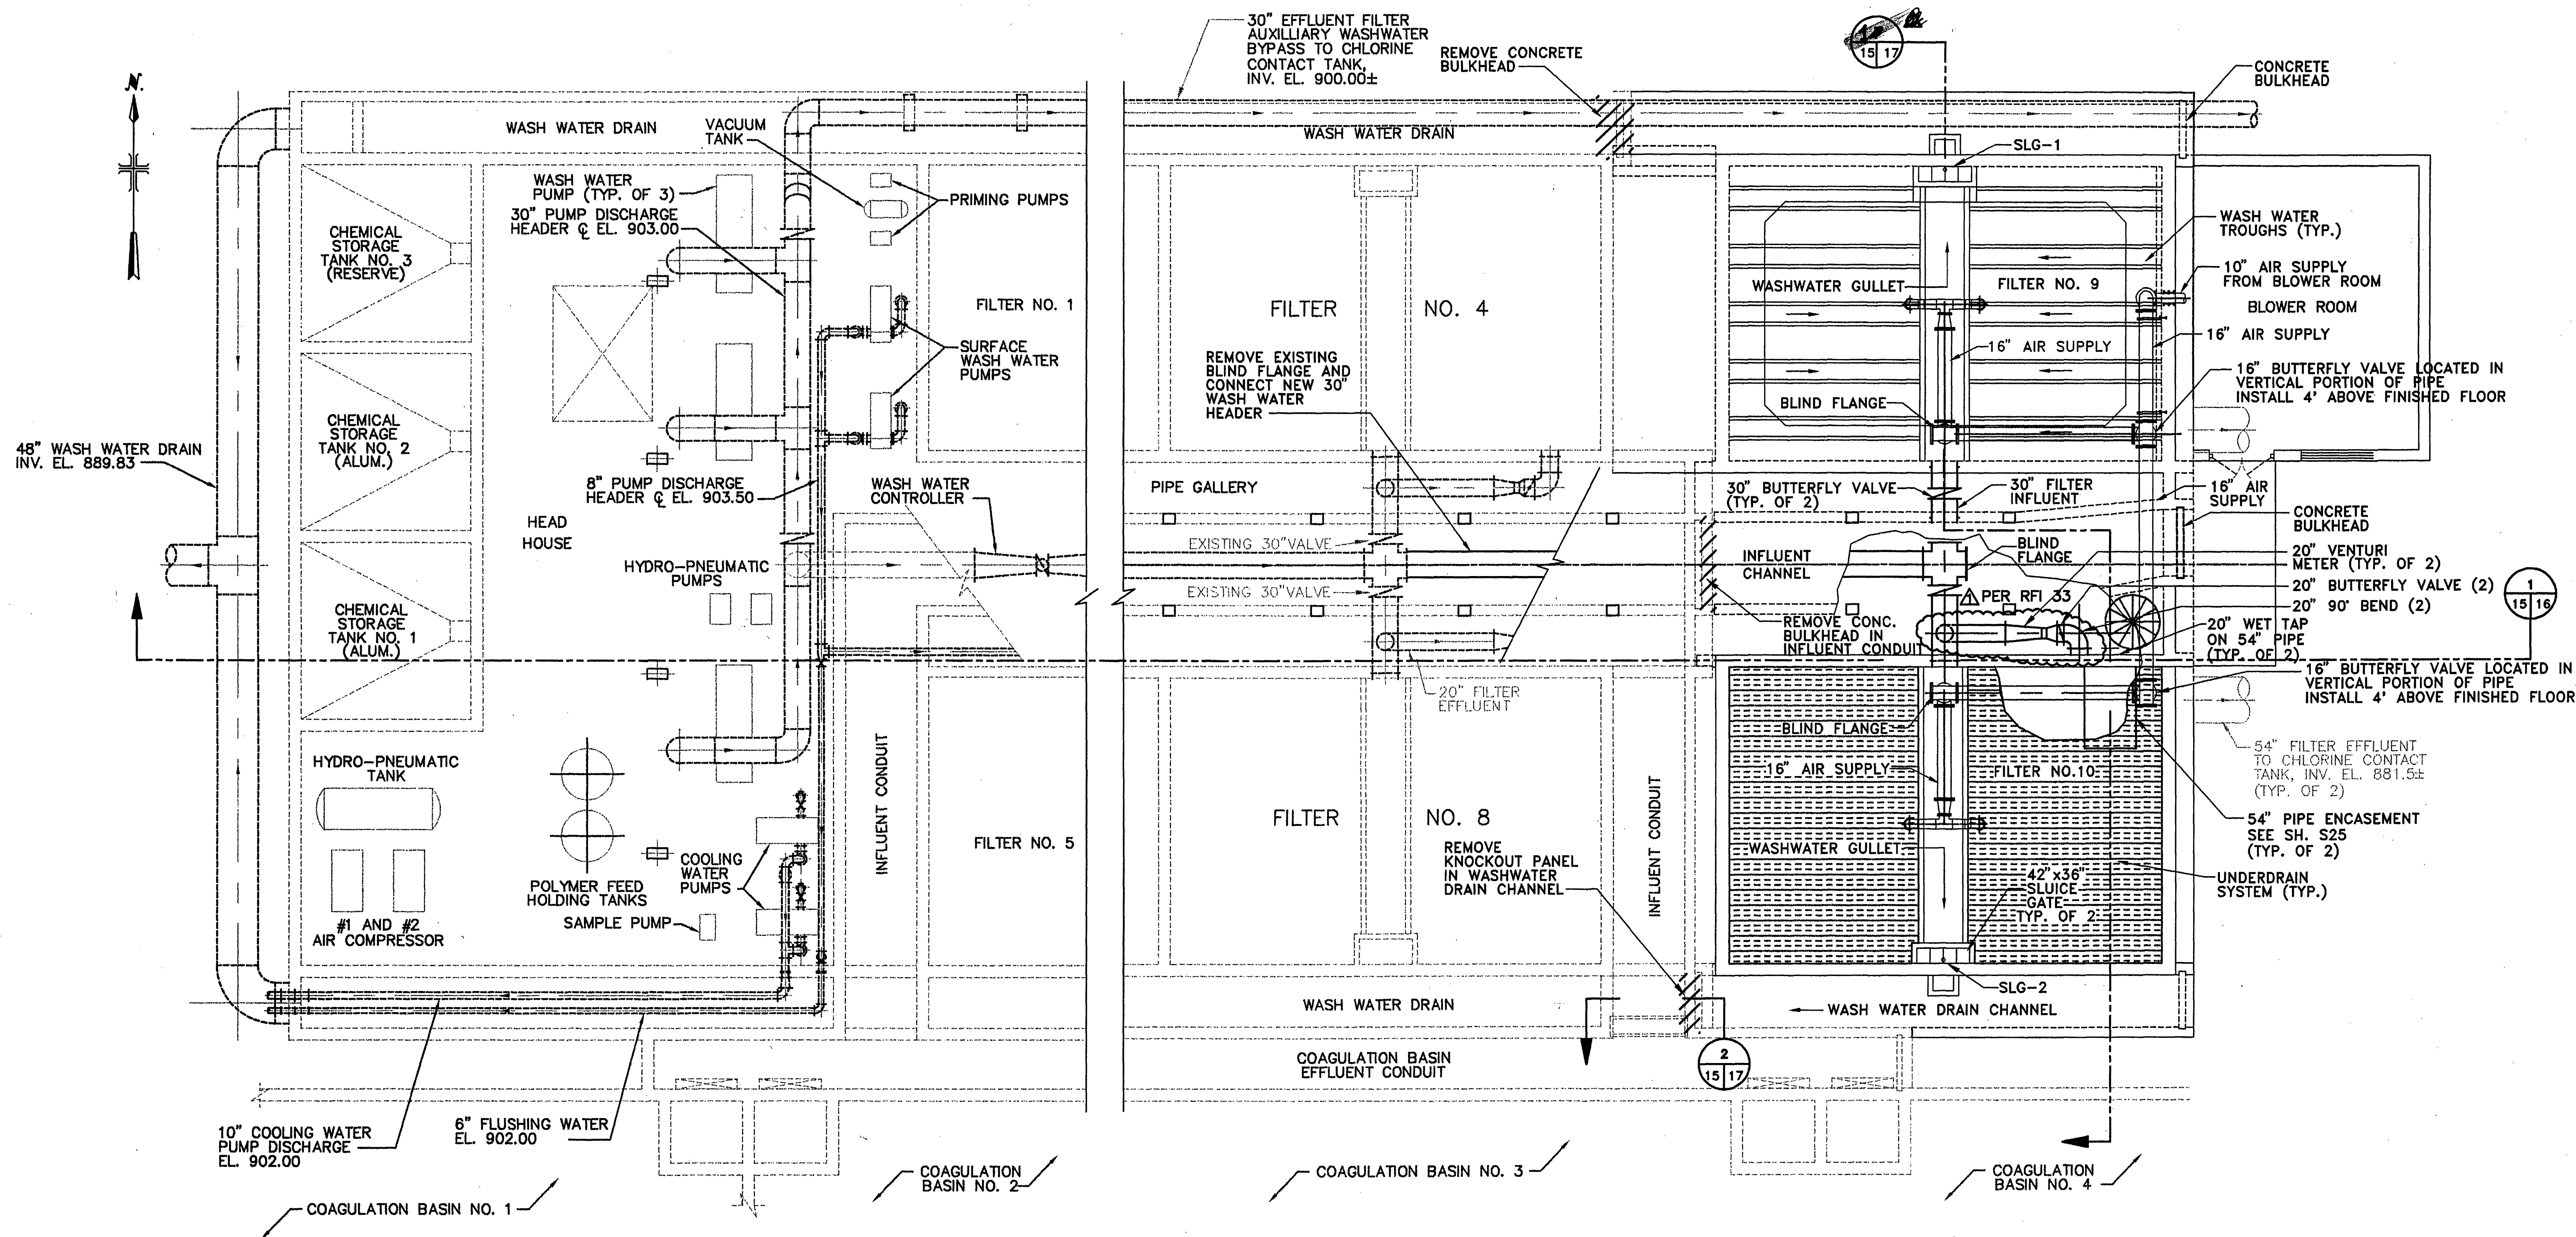

CITY OF ROANOKE, VIRGINIA
**WATER POLLUTION
CONTROL PLANT
UPGRADE AND EXPANSION**

EFFLUENT FILTERS

PLAN

SCALE: 1/8"=1'-0"

DATE: MAY, 1997
M SHEET 15 OF 30
CAD REF. NO. M15.DWG