

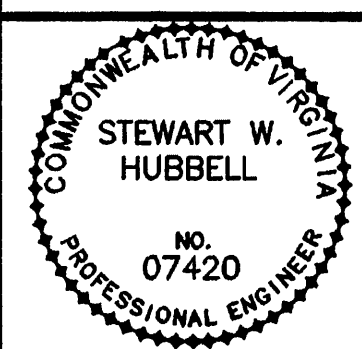


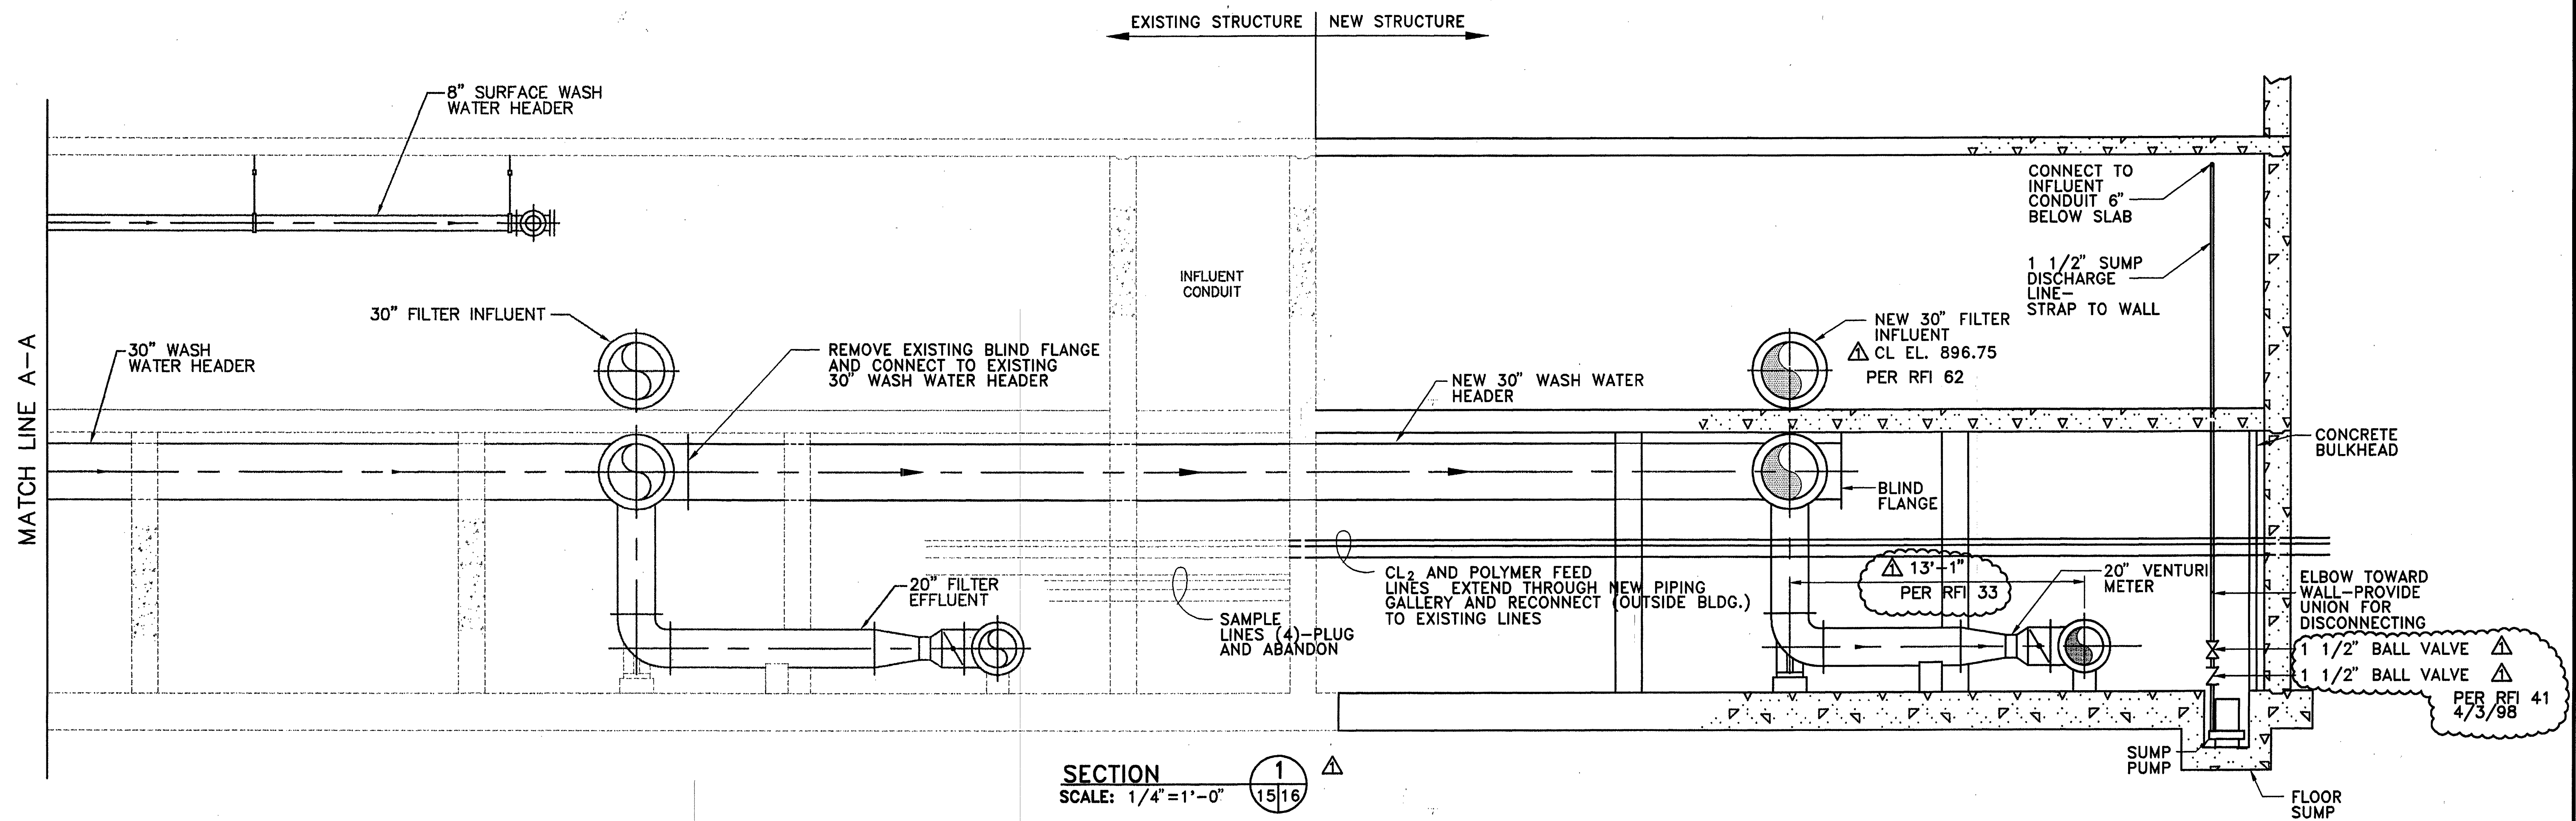

Mattern & Craig, Inc.
CONSULTING ENGINEERS - SURVEYORS
701 FIRST STREET, S.W.
ROANOKE, VIRGINIA 24004
(540) 945-9443
(540) 945-7800 FAX

REVISIONS			
NO.	BY	DATE	REMARKS
1	SWH	JAN. 2000	RECORD DRAWING

DES BCC
DWN LDL
CKD SWH

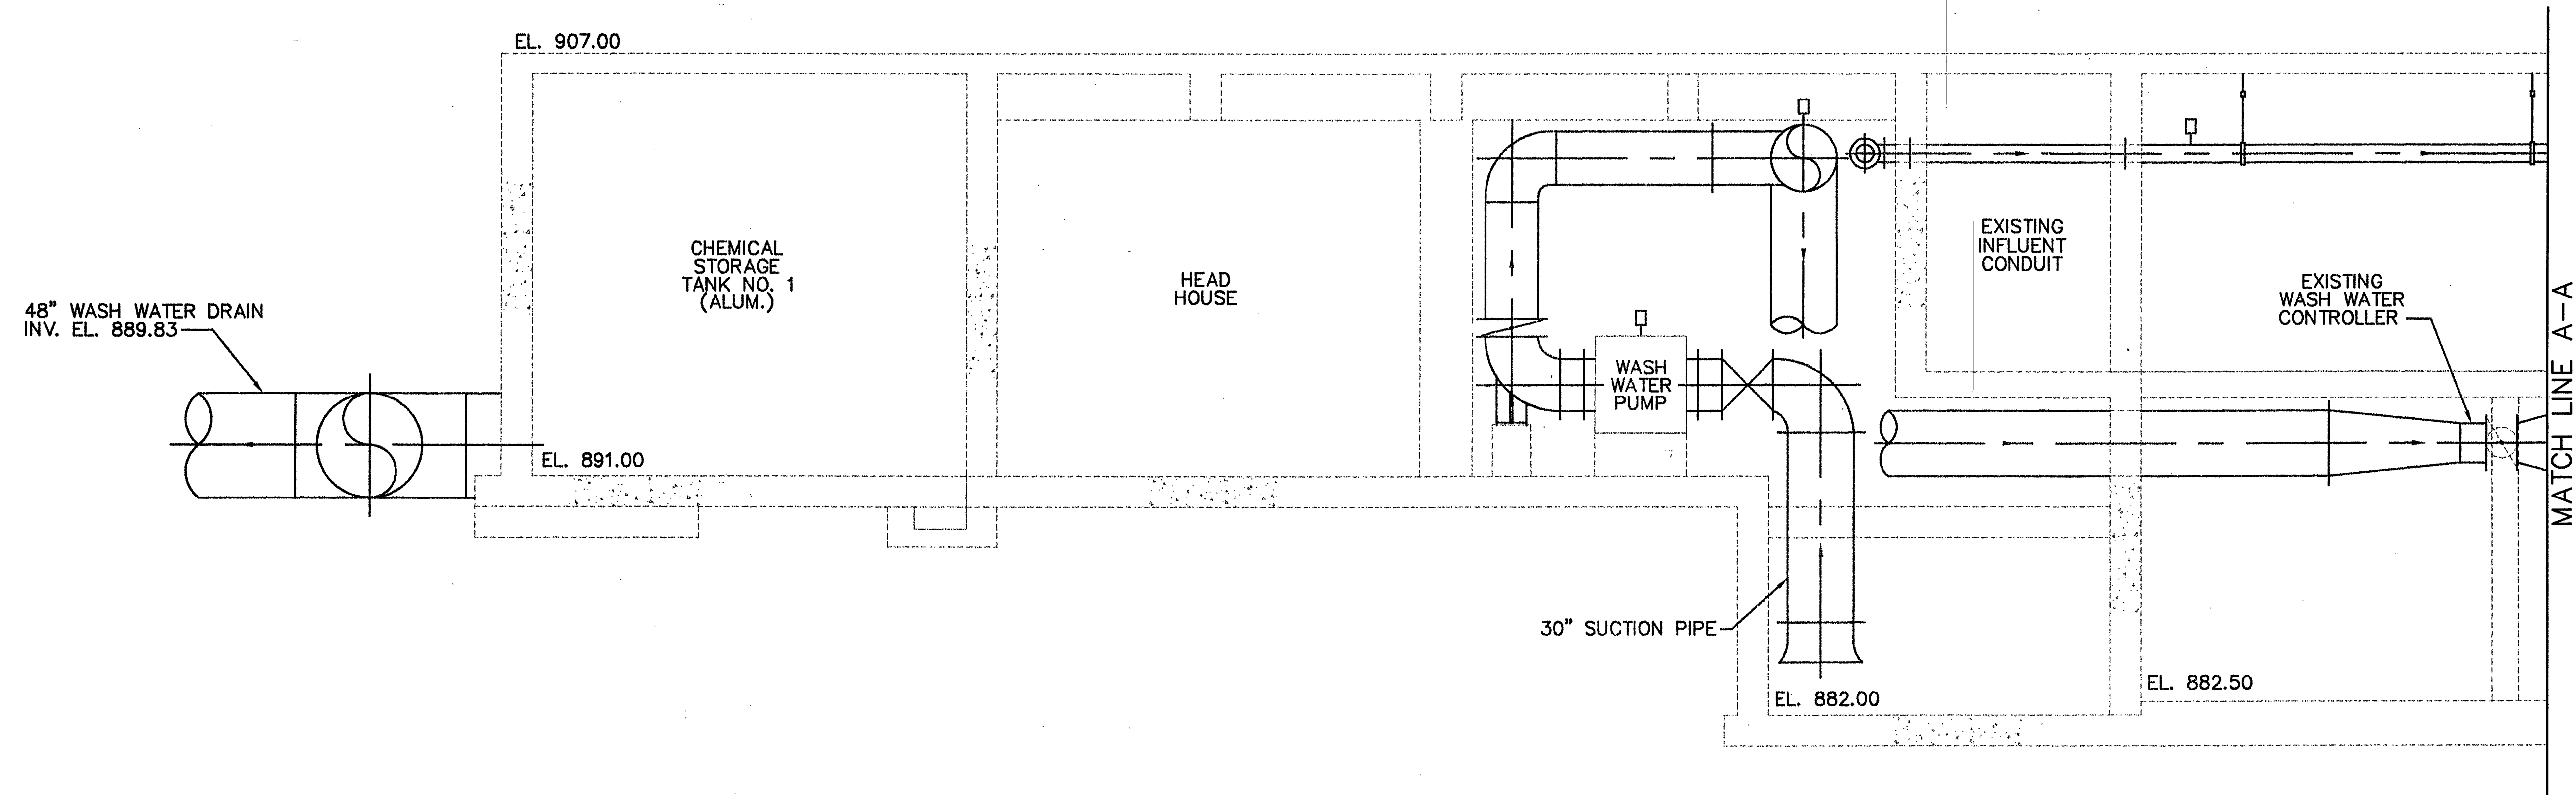

CITY OF ROANOKE, VIRGINIA
**WATER POLLUTION
CONTROL PLANT
UPGRADE AND EXPANSION**

EFFLUENT FILTERS

SECTIONS
SCALE: AS SHOWN

DATE MAY, 1997
M SHEET 16 OF 30
CAD REF. NO. M16.DWG