

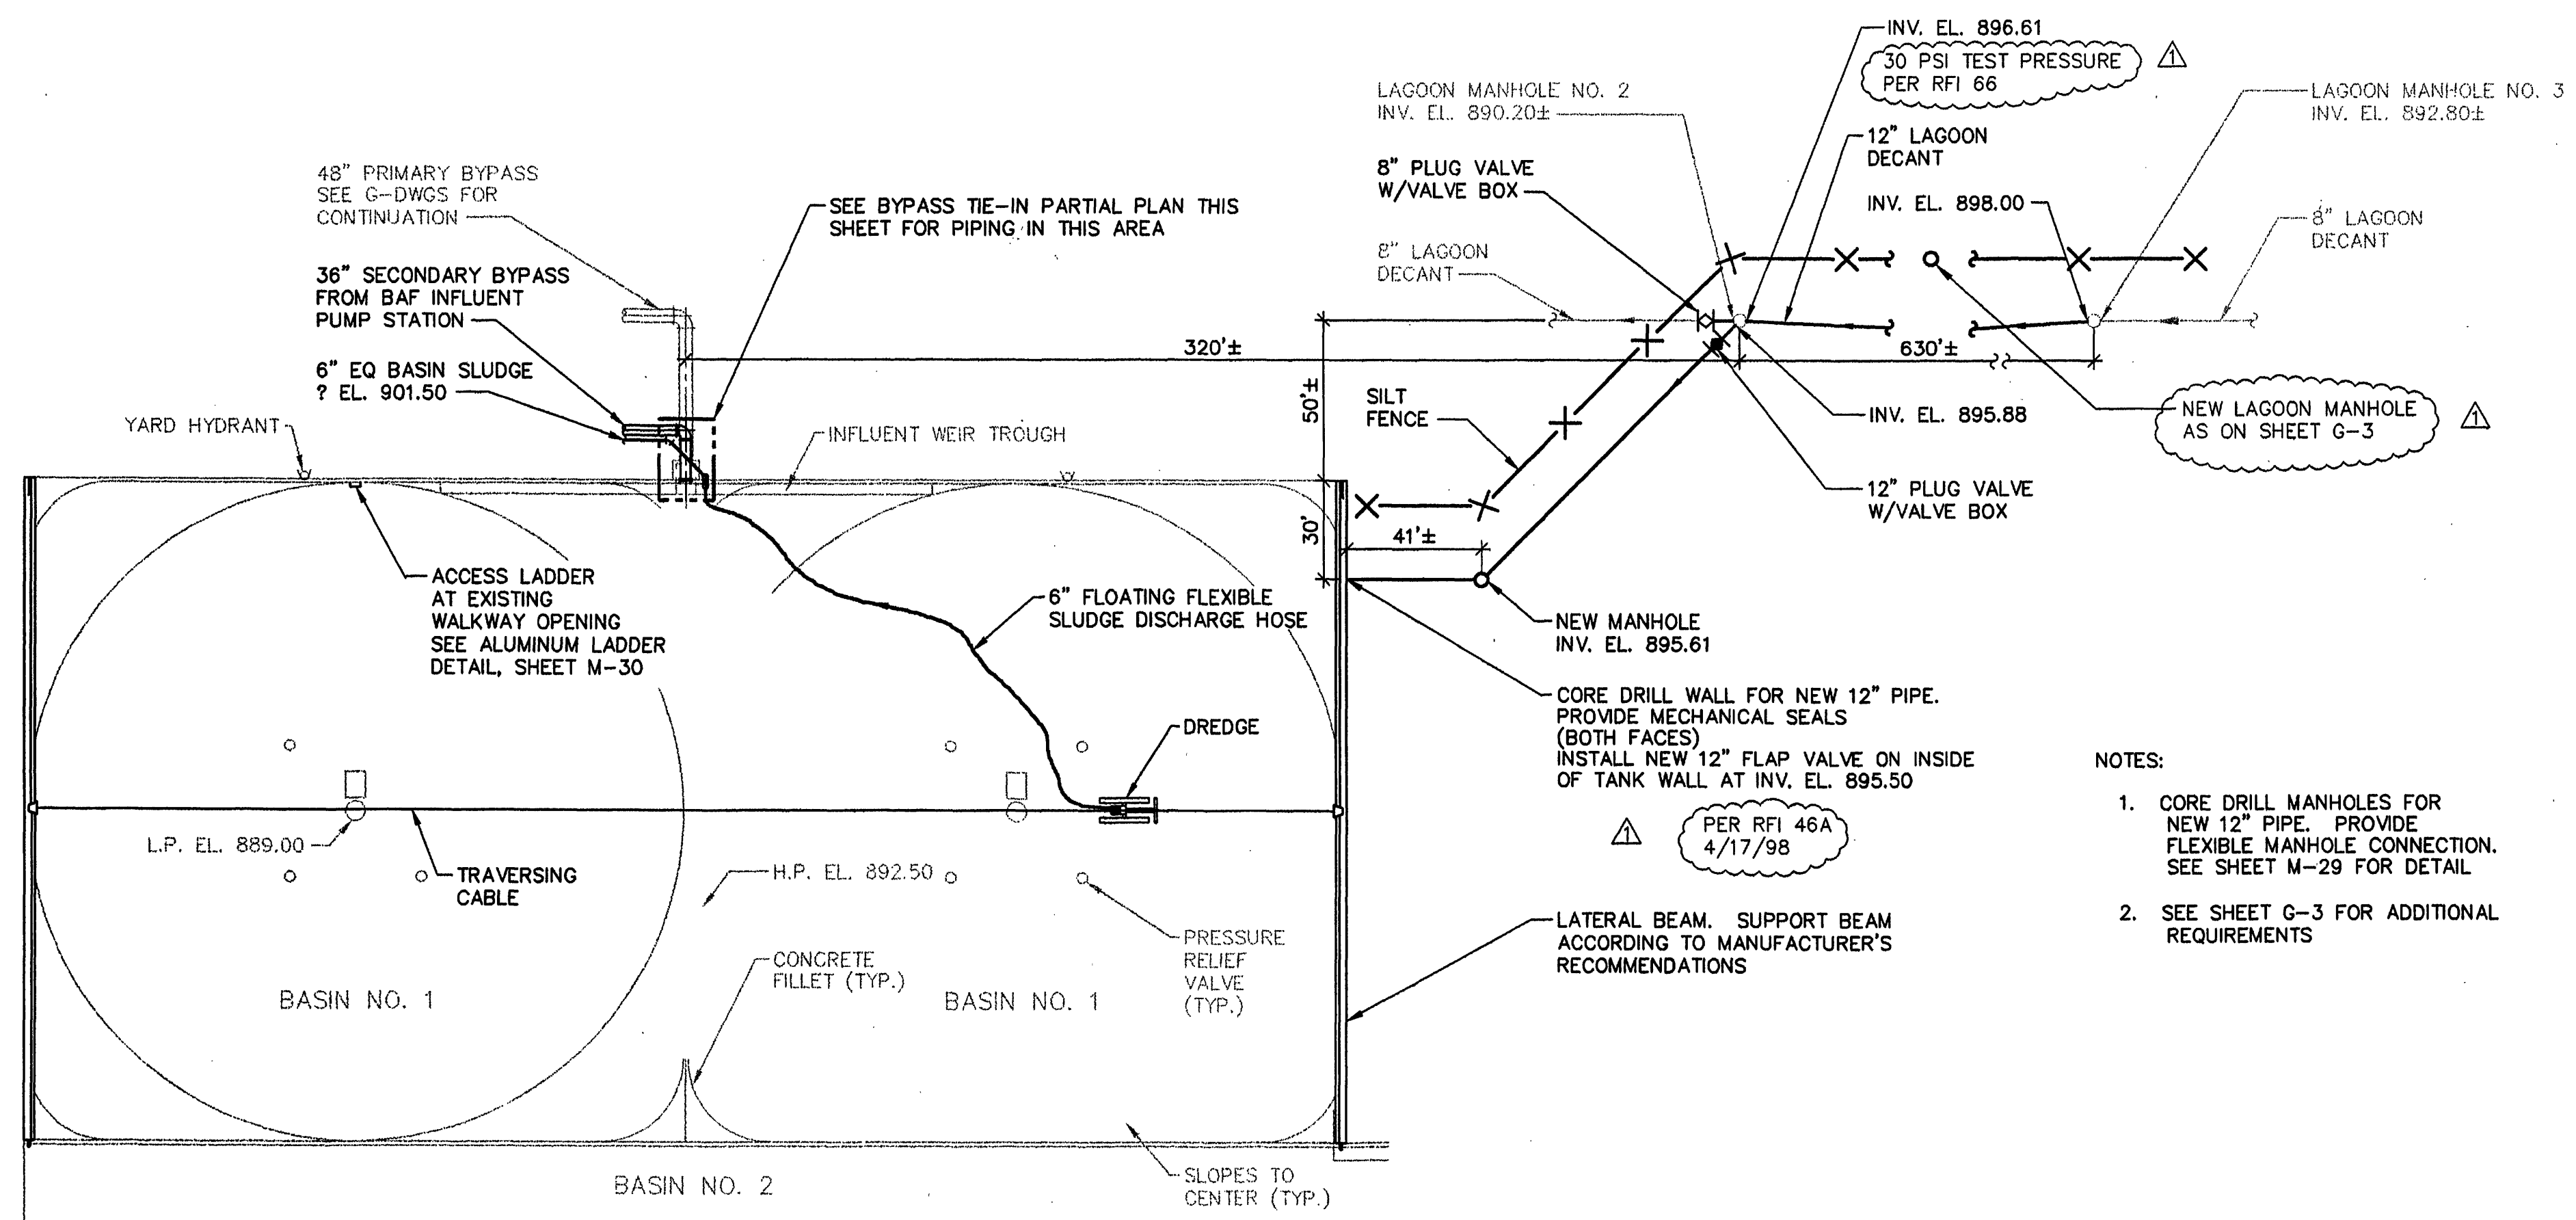


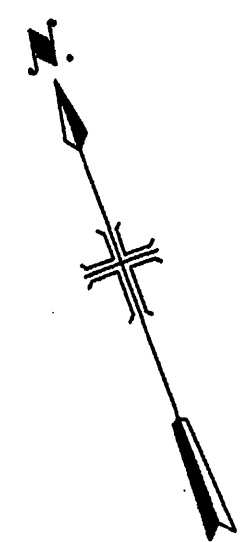


EQUILIZATION BASIN
PARTIAL PLAN
SCALE: 1" = 40'

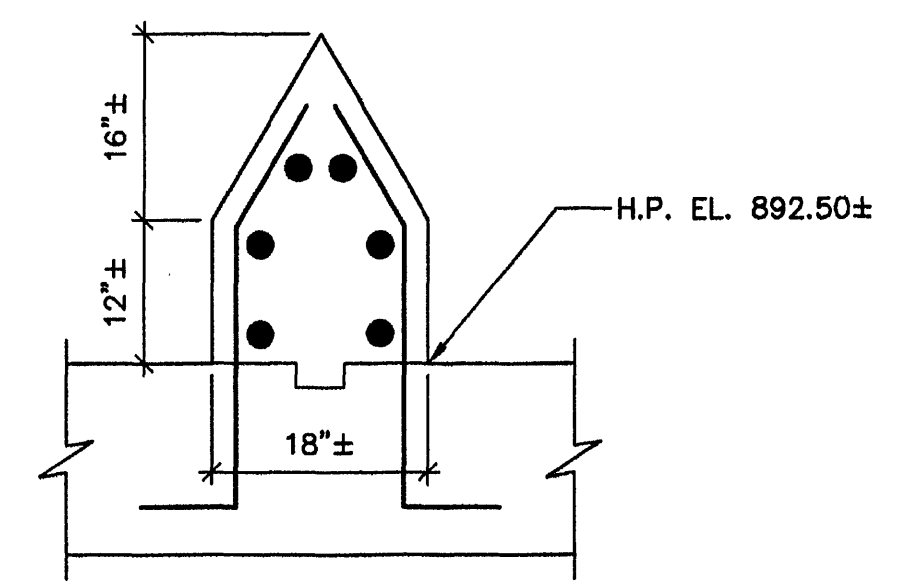


INTERMEDIATE CONCRETE DIVIDING WALL DETAIL
SCALE: 3/4" = 1'-0"


- NOTES:
1. CORE DRILL MANHOLES FOR NEW 12" PIPE. PROVIDE FLEXIBLE MANHOLE CONNECTION. SEE SHEET M-29 FOR DETAIL.
 2. SEE SHEET G-3 FOR ADDITIONAL REQUIREMENTS.

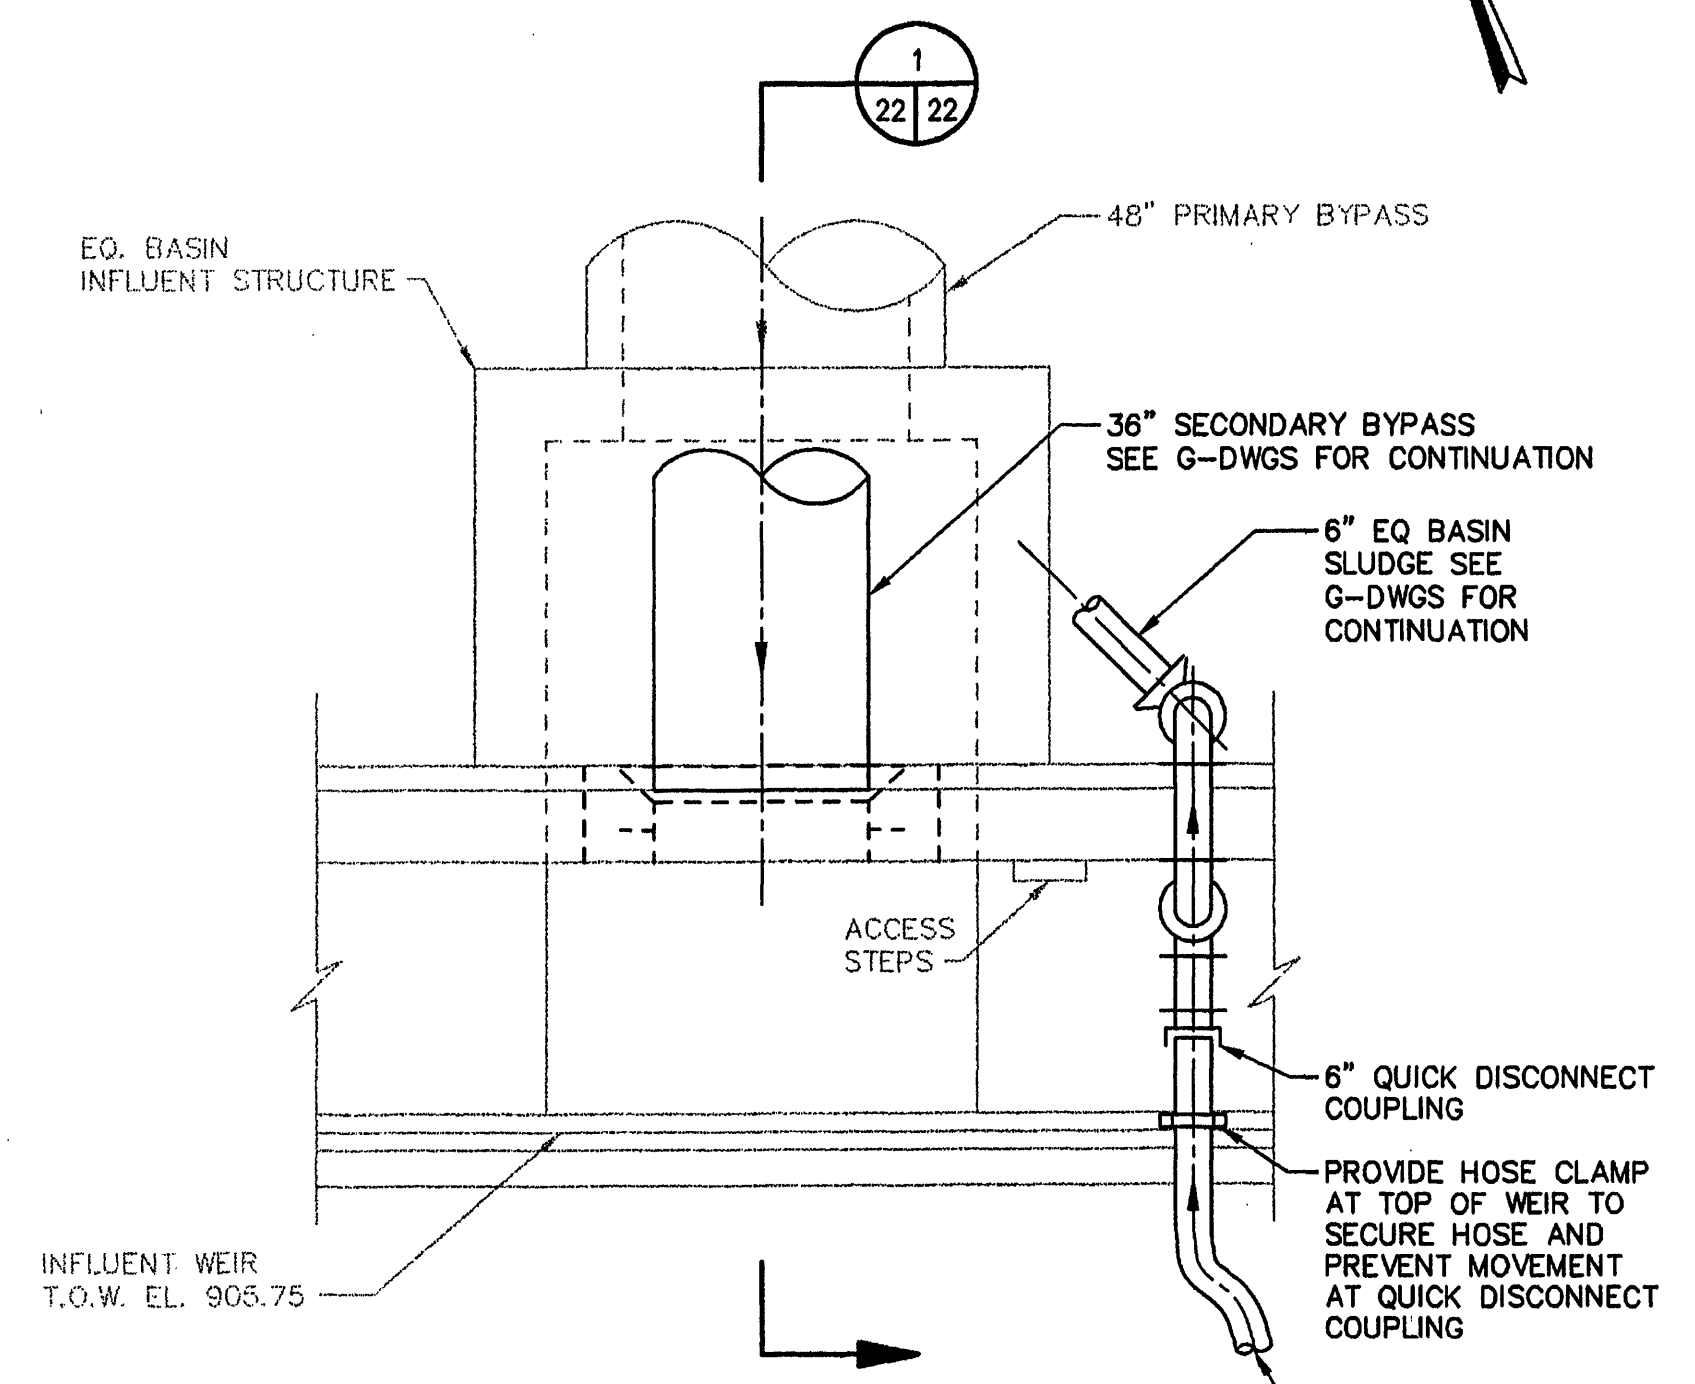


BYPASS TIE-IN PARTIAL PLAN
SCALE: 3/8" = 1'-0"

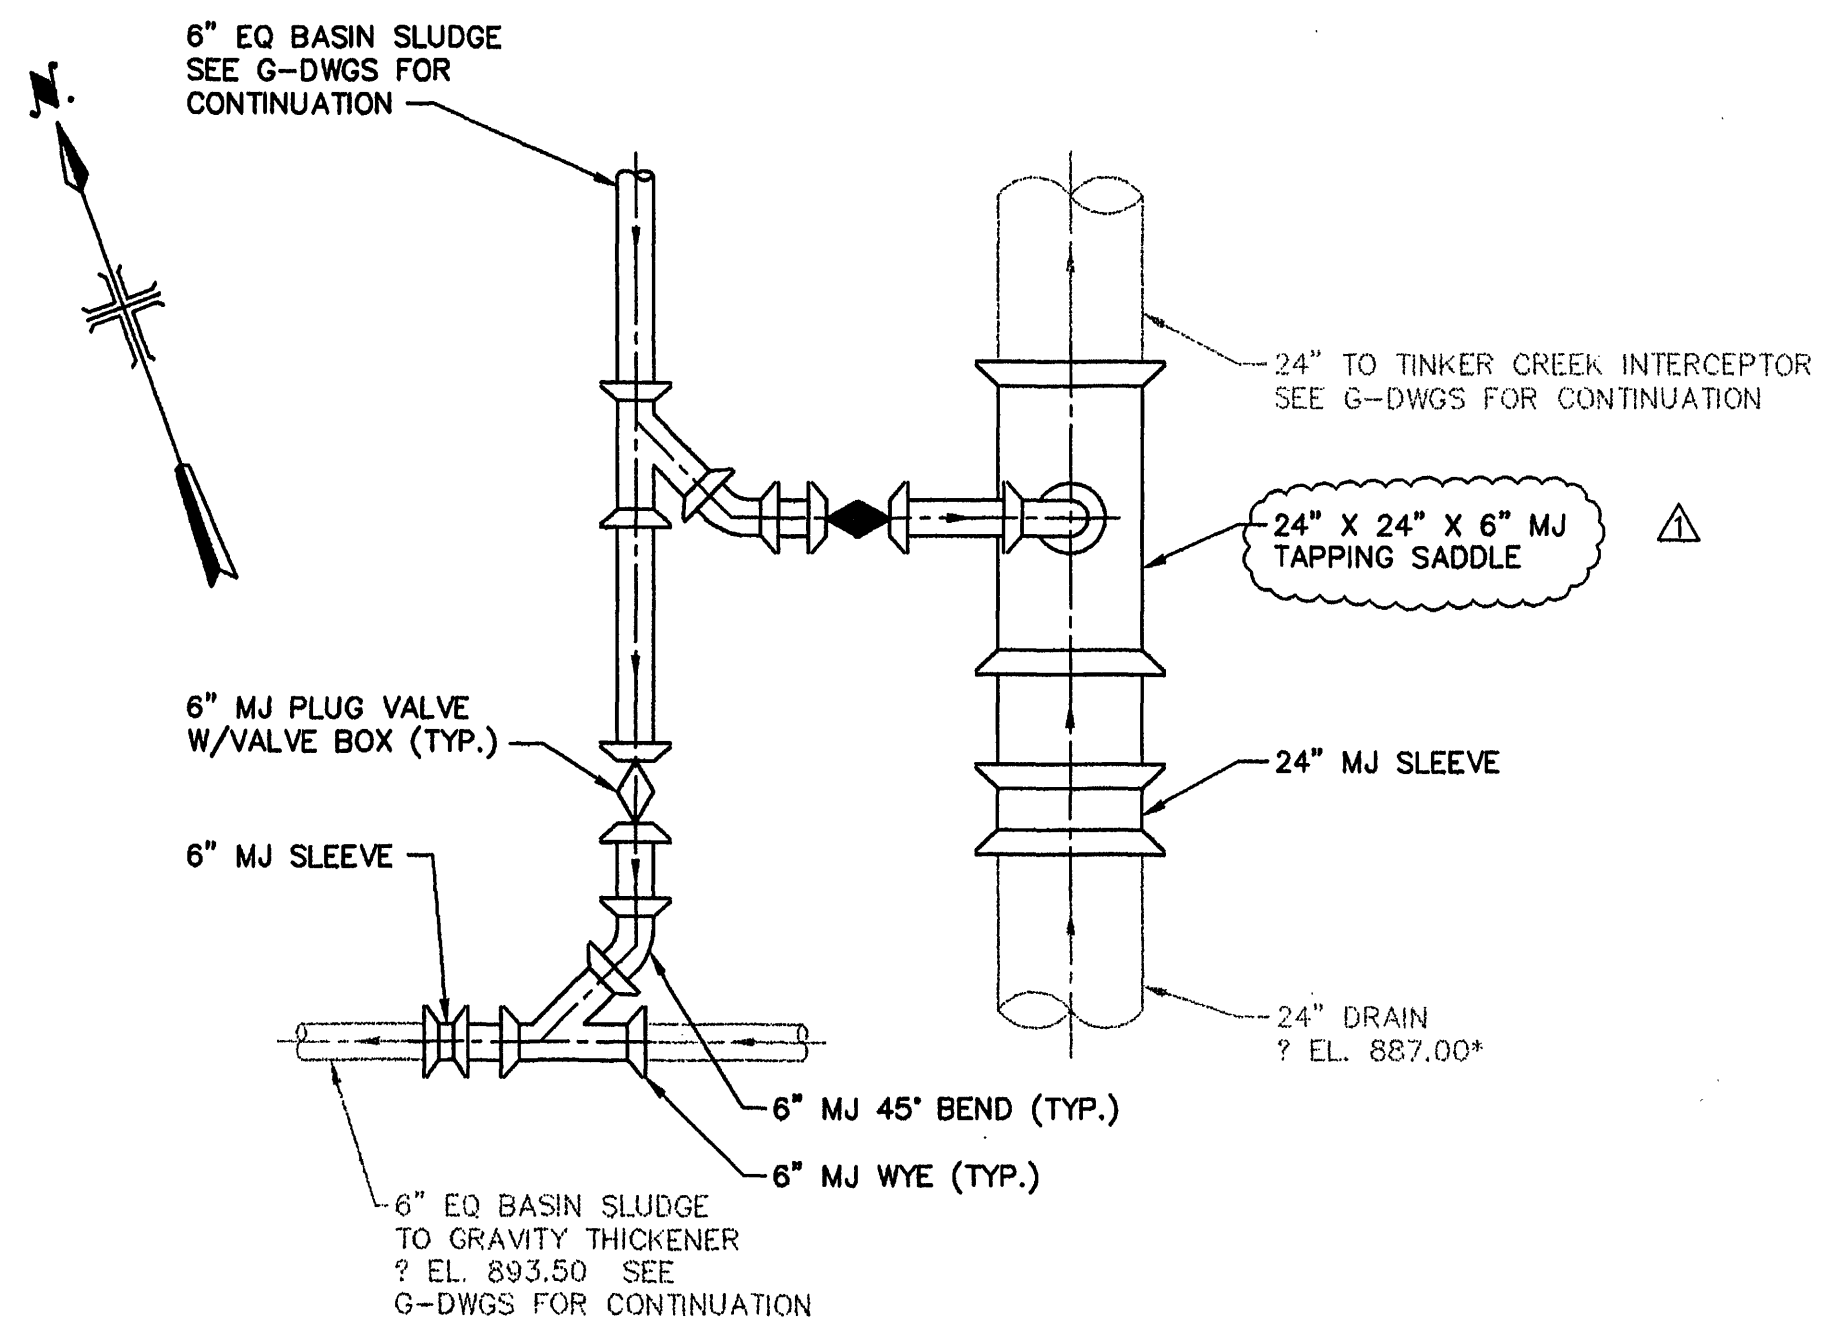


SLUDGE TIE-IN PARTIAL PLAN
SCALE: 3/8" = 1'-0"

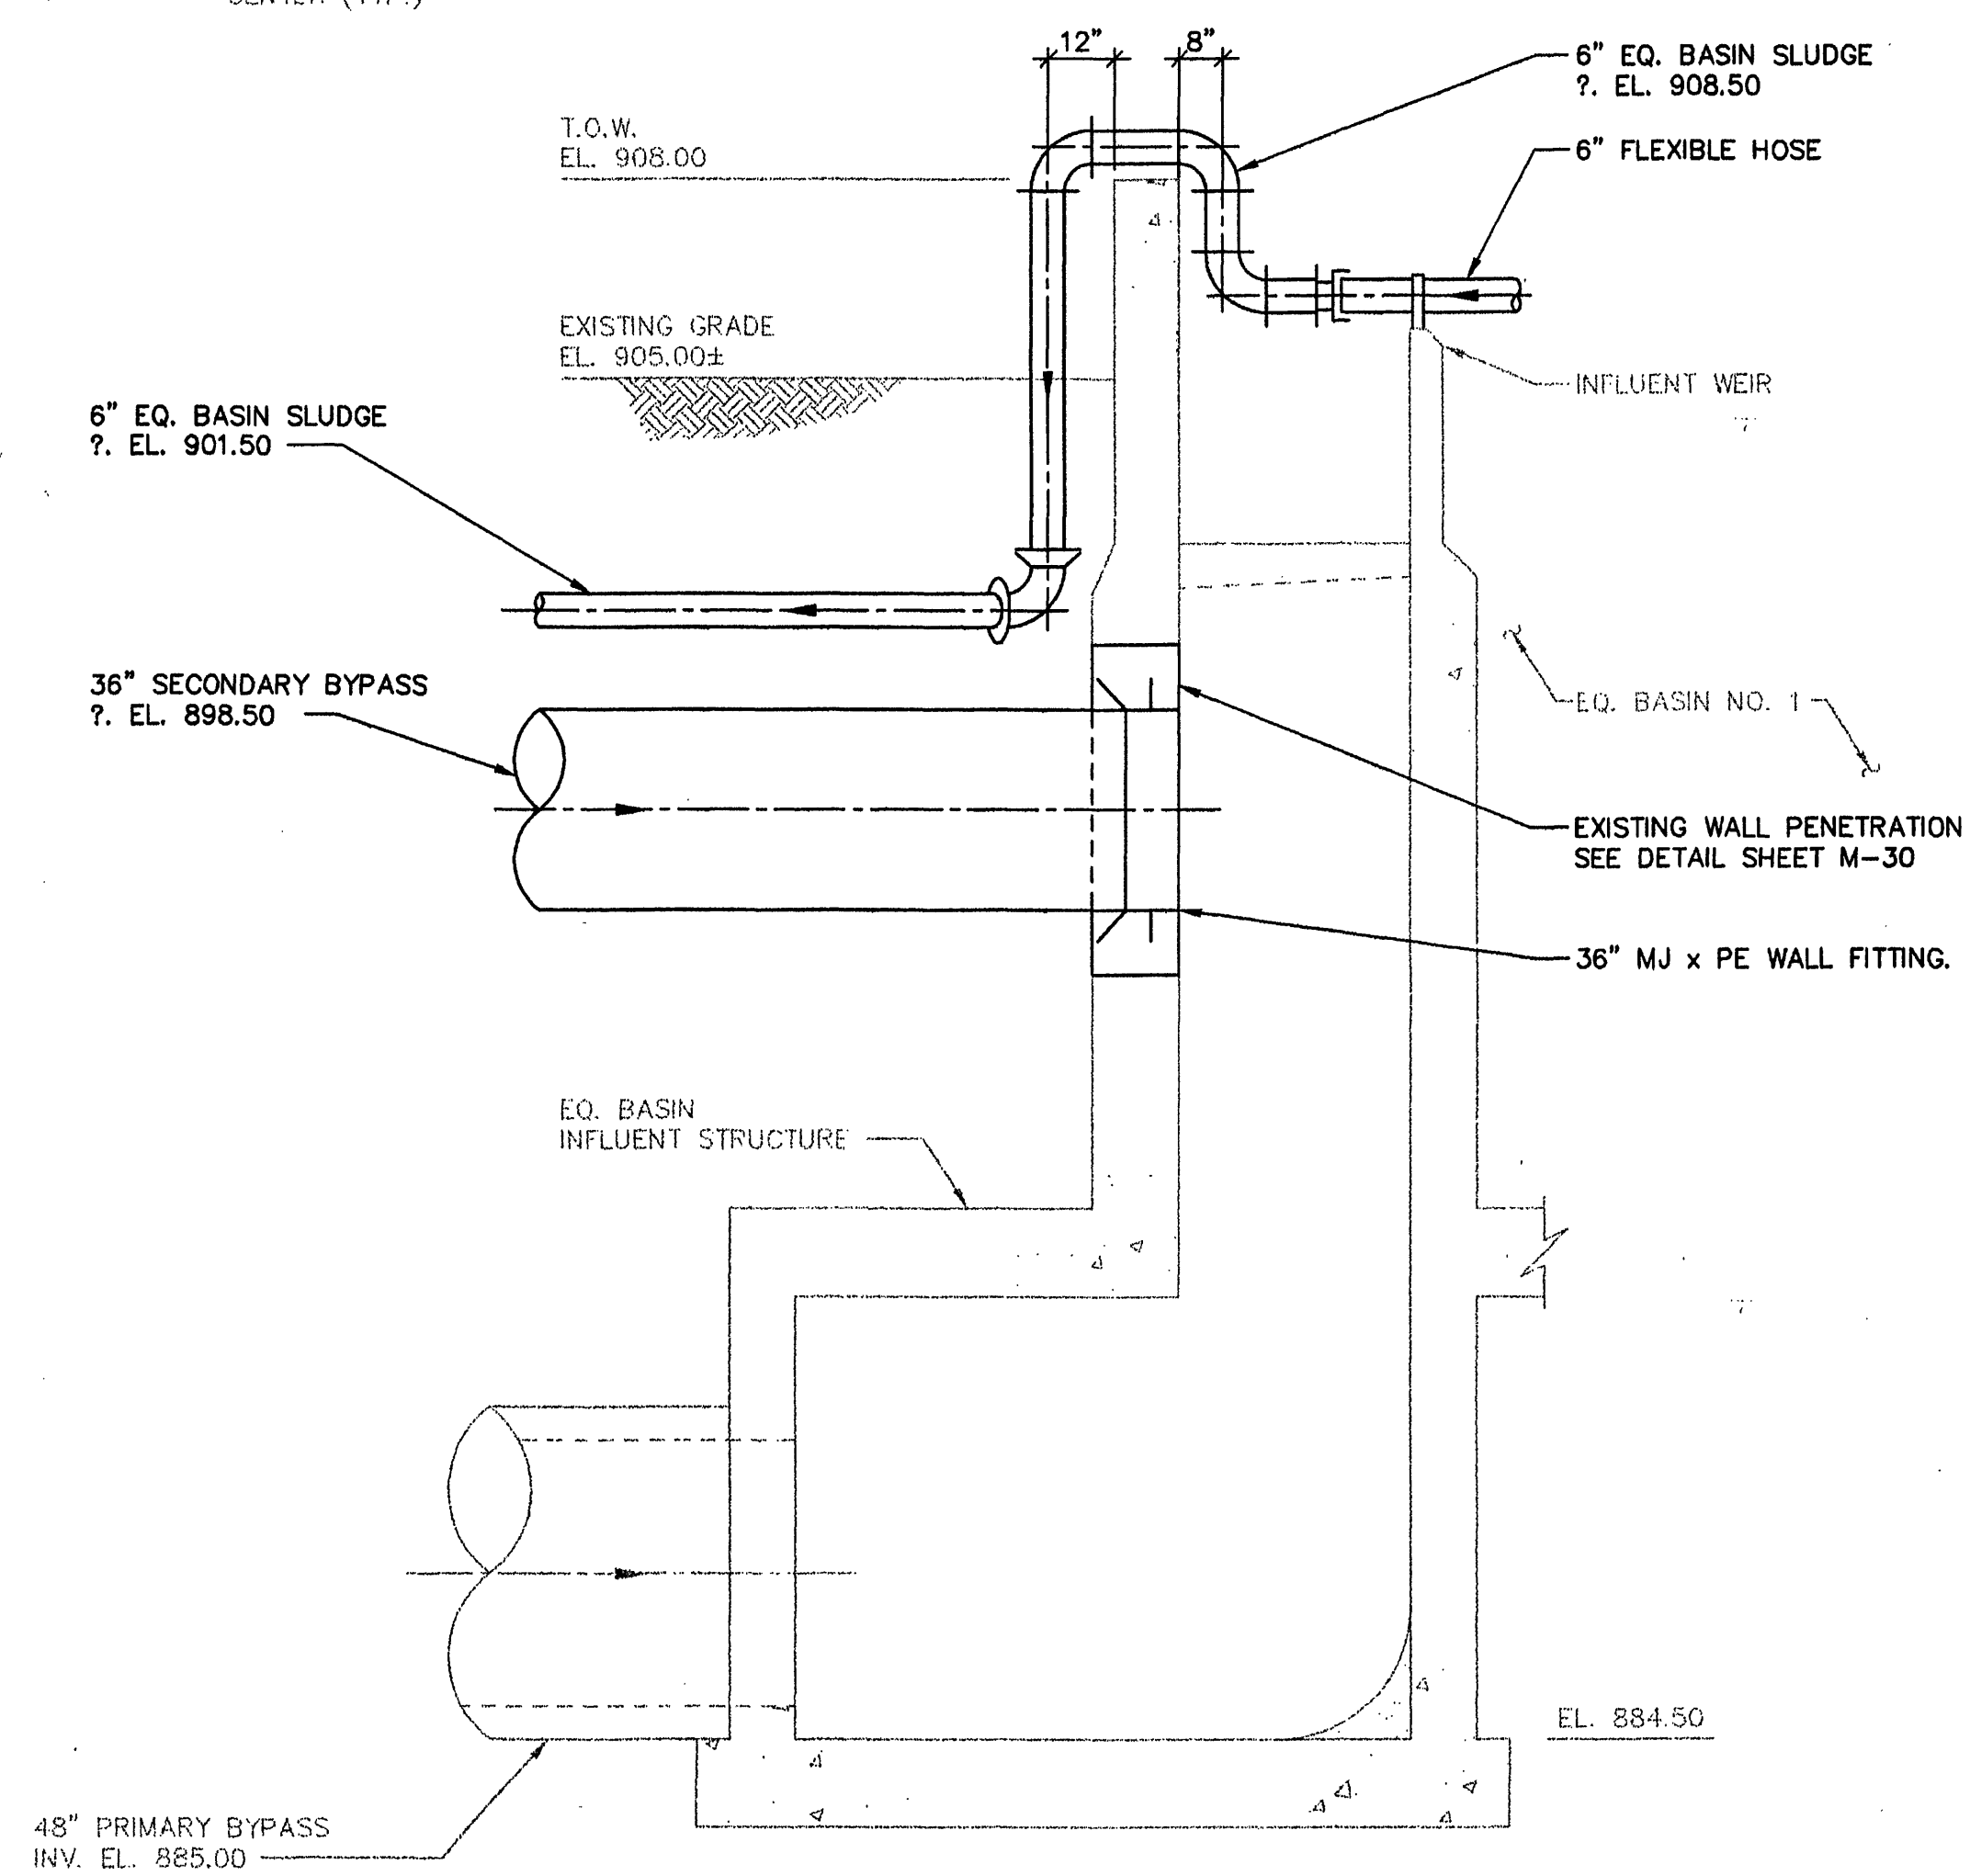


SECTION 1
SCALE: 3/8" = 1'-0"

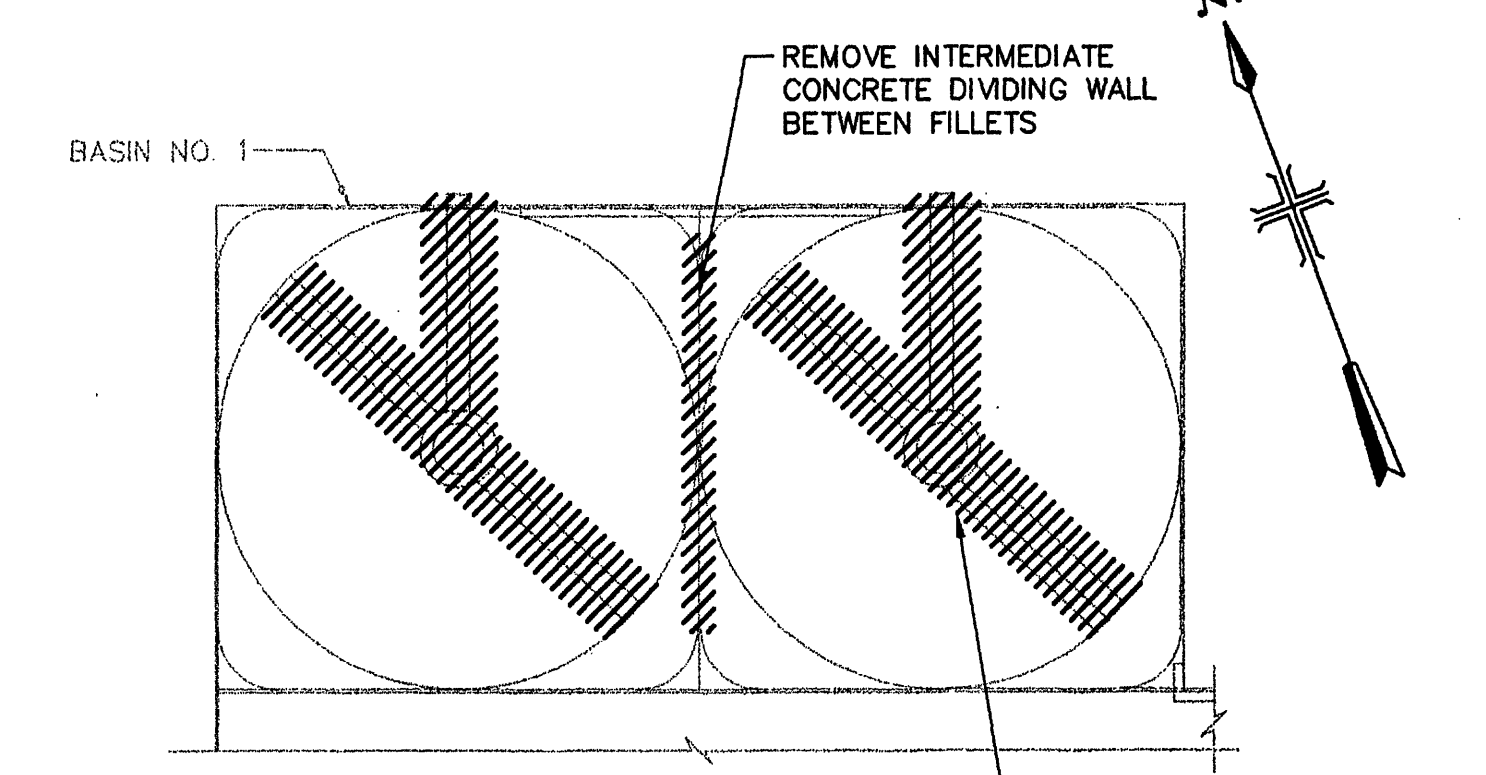

DEMOLITION PLAN
NOT TO SCALE

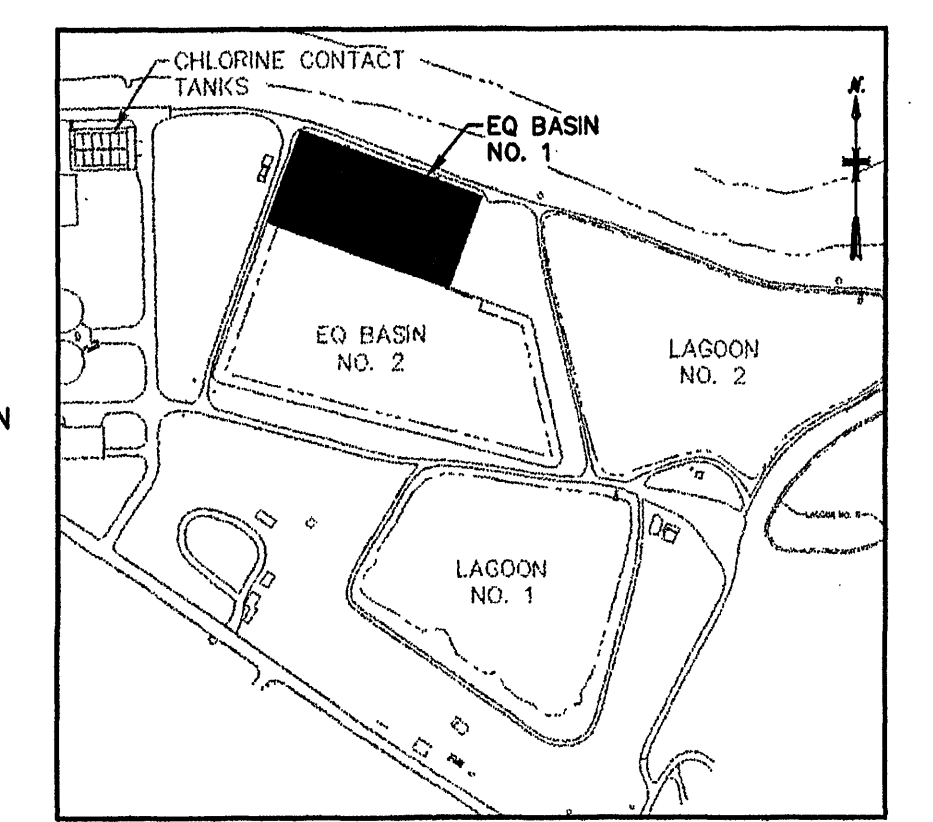

KEY PLAN
NTS

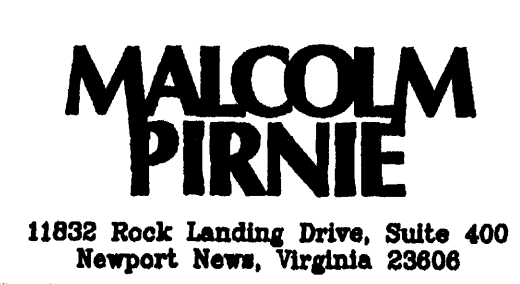

REVISIONS				DES	DWN	CKD
NO.	BY	DATE	REMARKS			
1	ARB	JAN. 2000	RECORD DRAWING	CWM	MPK	GJJ



CITY OF ROANOKE, VIRGINIA
WATER POLLUTION
CONTROL PLANT
UPGRADE AND EXPANSION

EQUALIZATION BASIN MODIFICATIONS
DEMOLITION PLAN, PARTIAL
PLANS AND SECTION
SCALE AS NOTED

COPYRIGHT © 1997
MALCOLM PIRNIE, INC.
DATE MAY 1997
M SHEET 22 OF 30
CAD REF. NO. 0060M023