




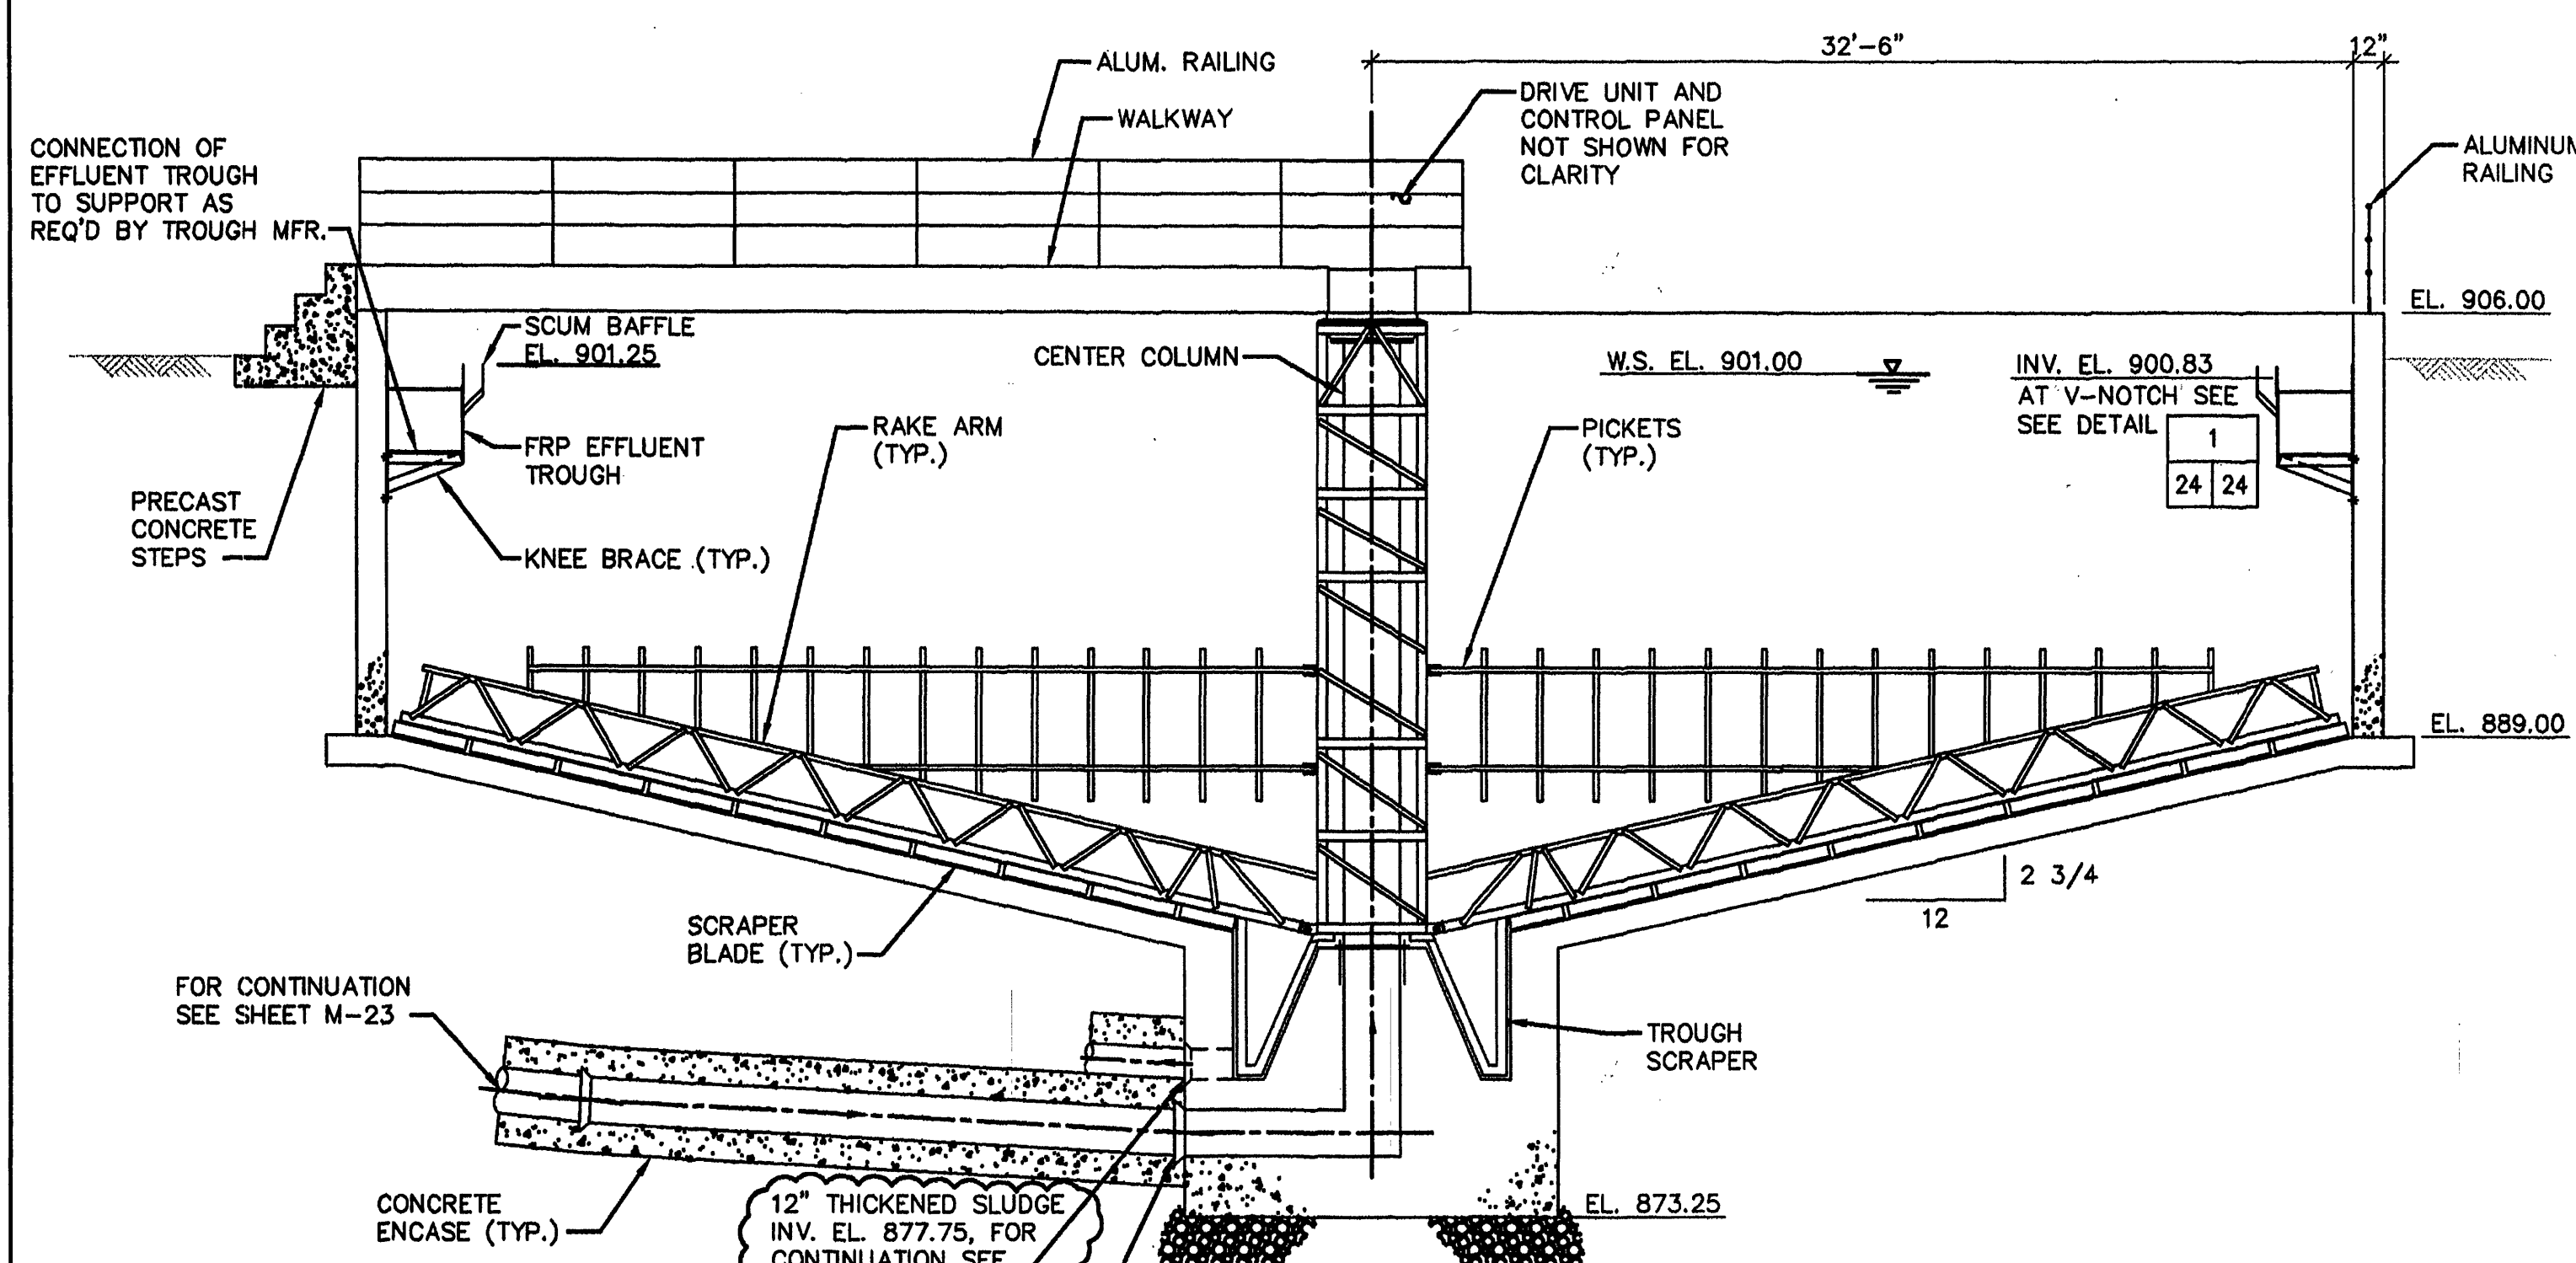


SECTION 1
SCALE: 3/16" = 1'-0"

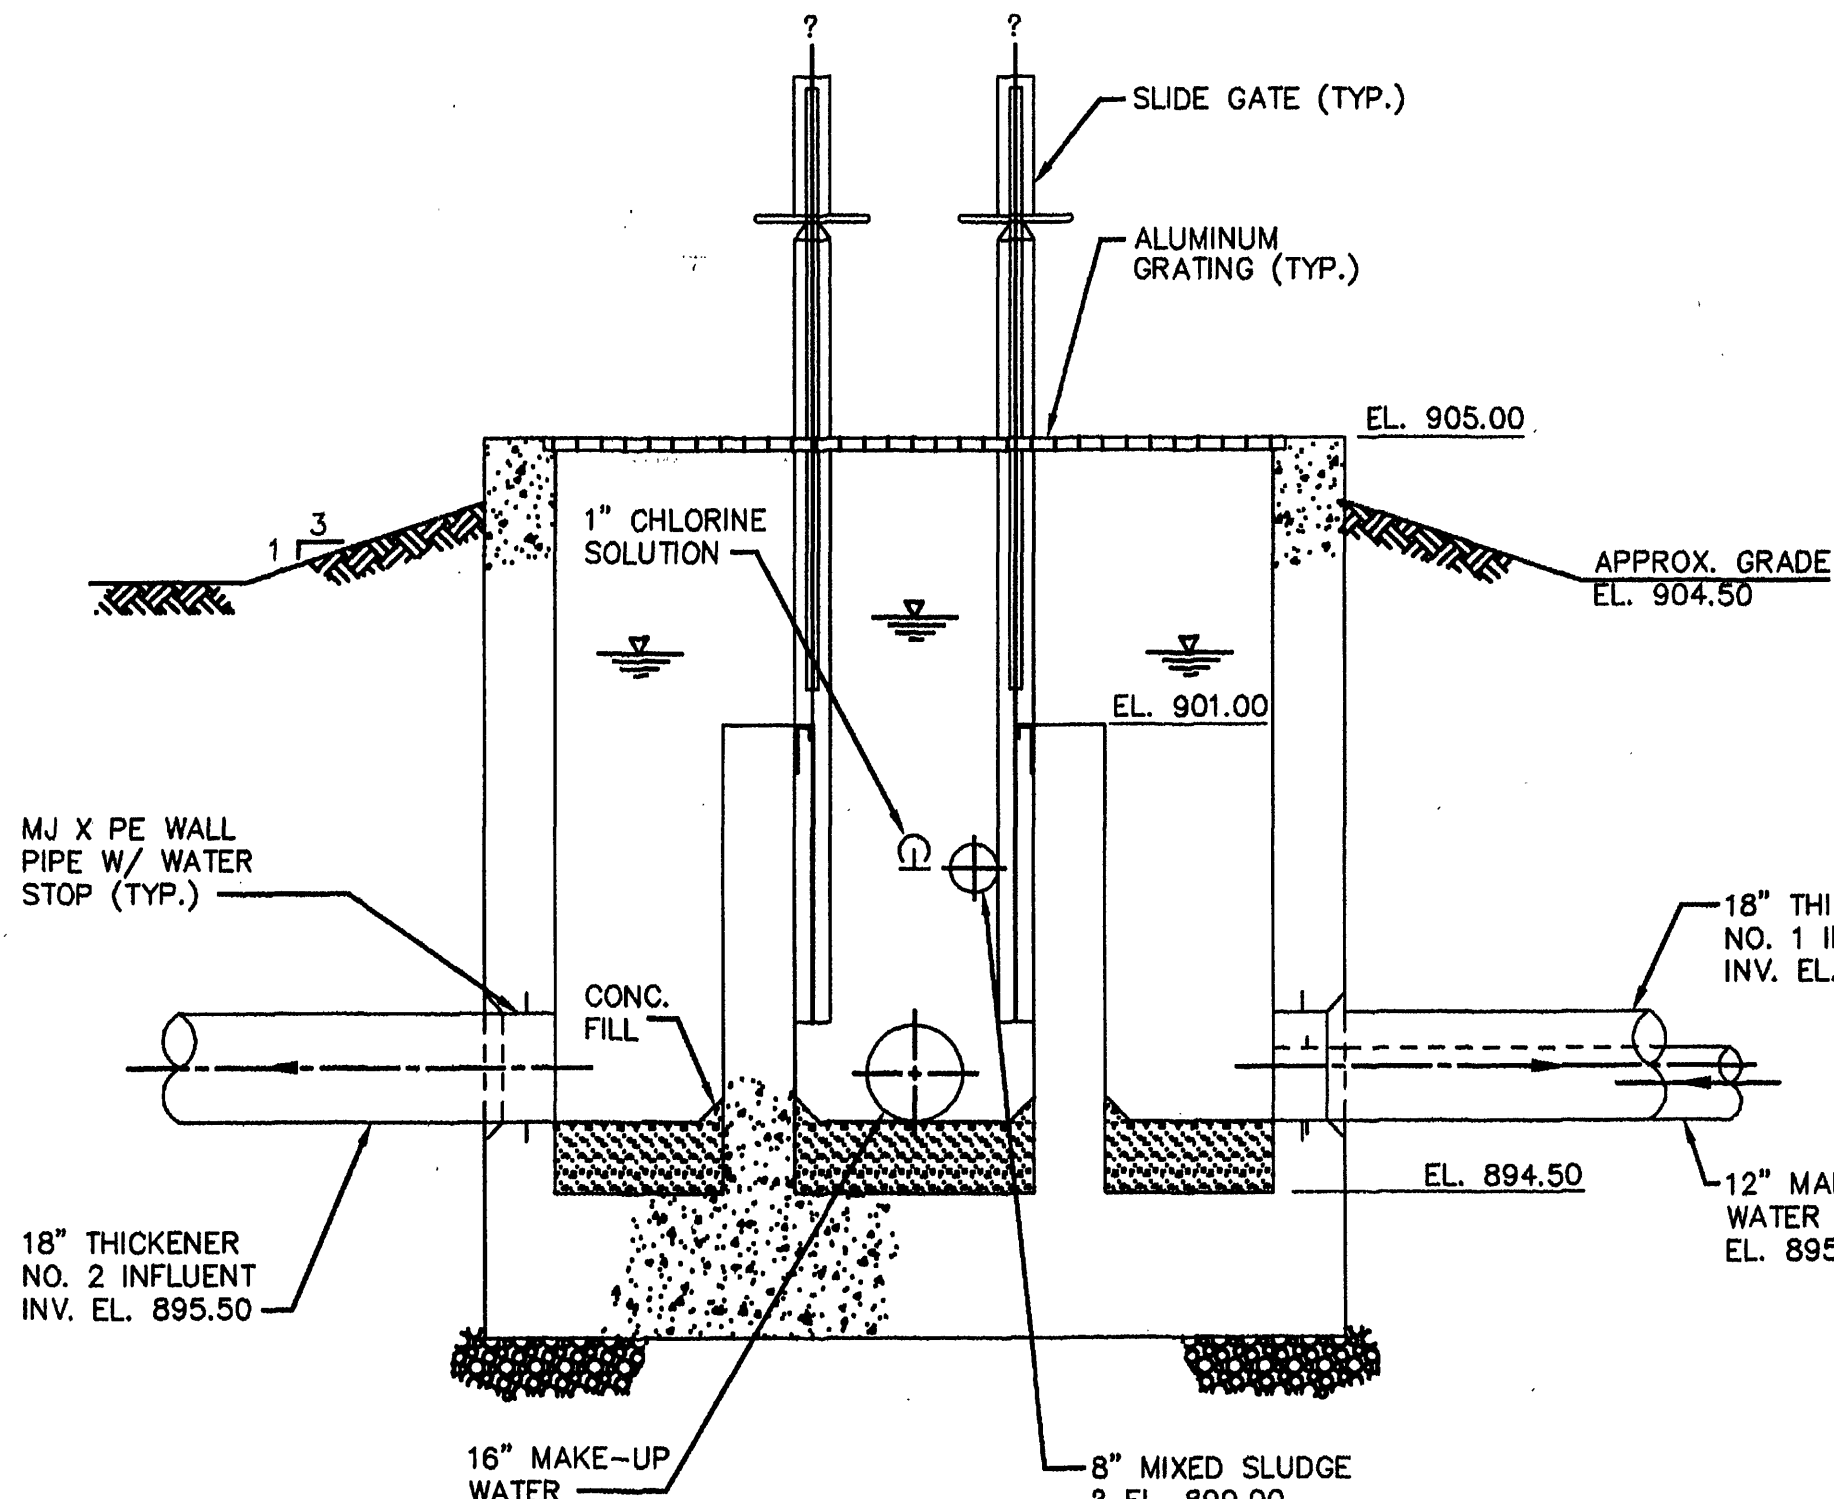


SECTION 2
SCALE: 3/8" = 1'-0"

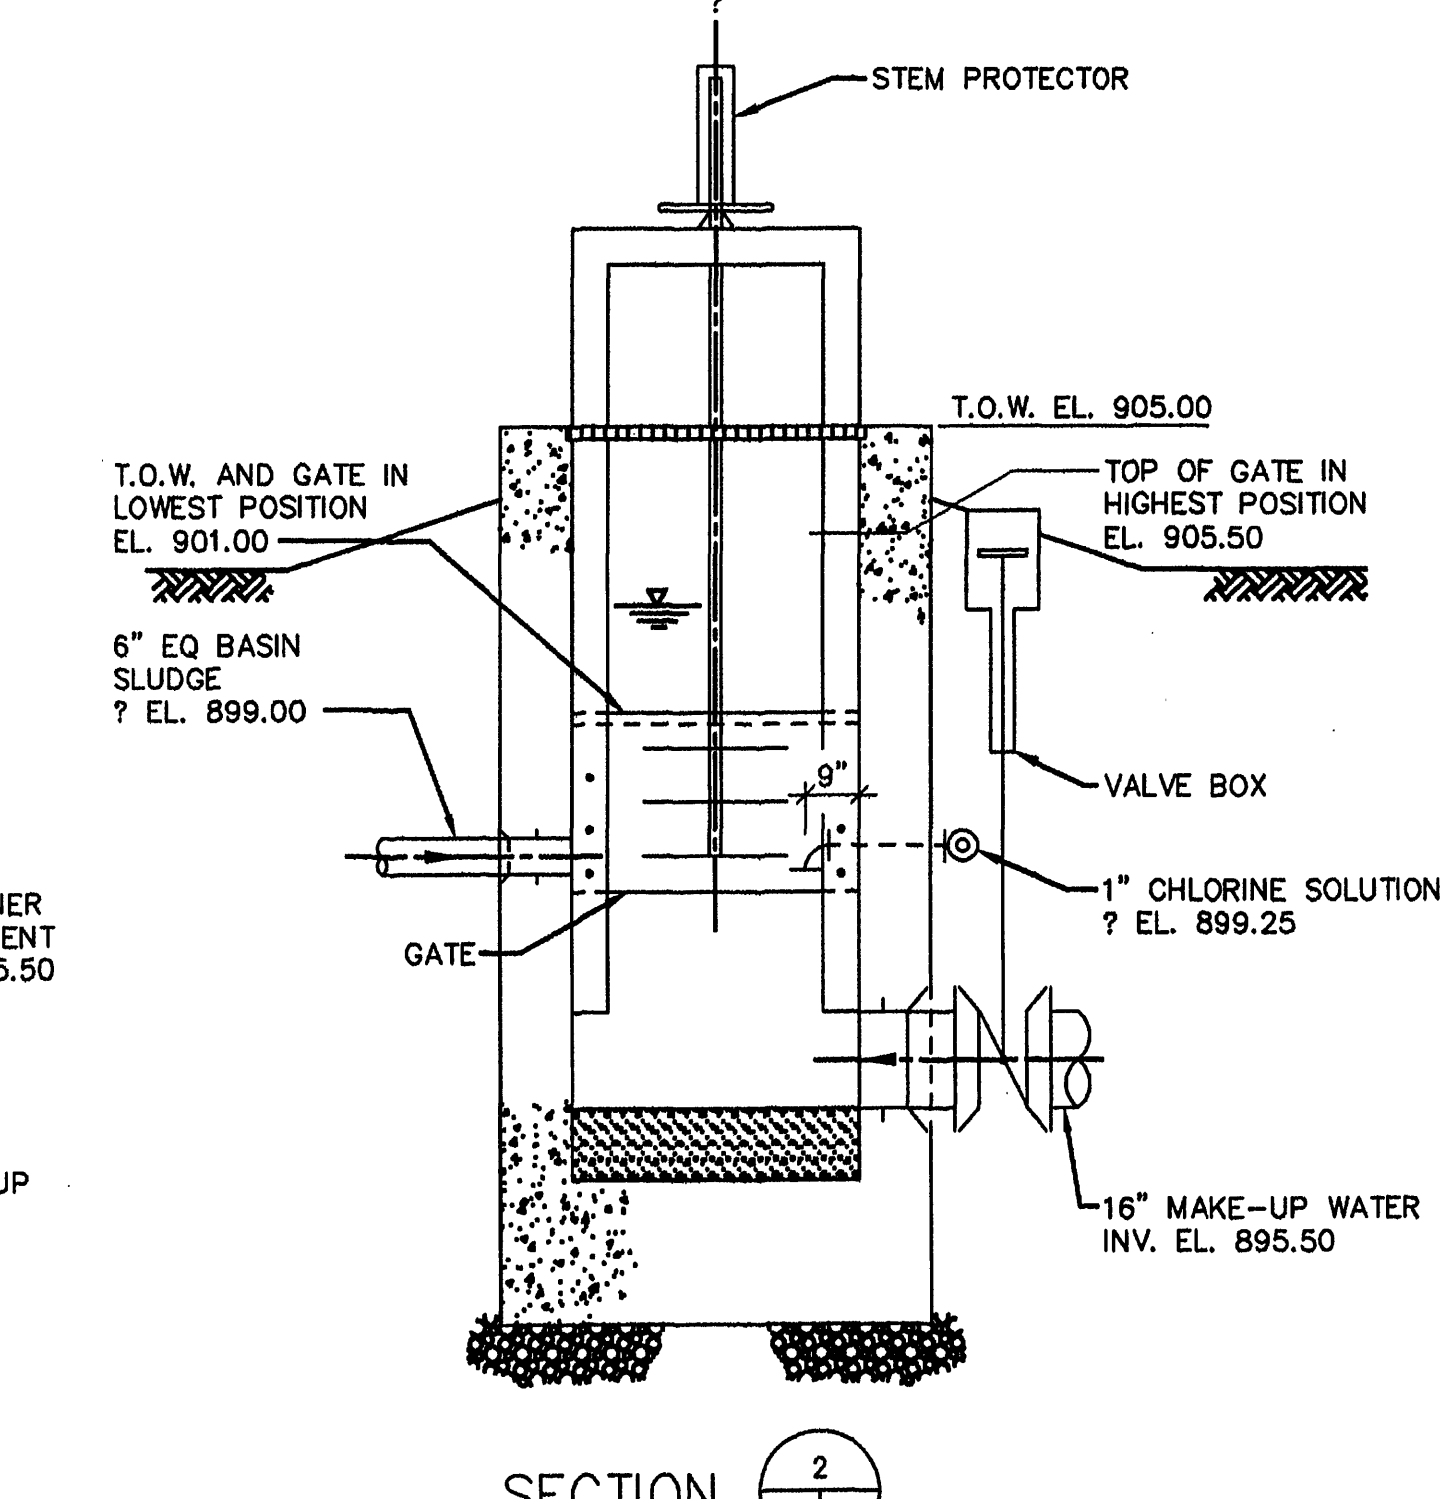


SECTION 3
SCALE: 3/8" = 1'-0"

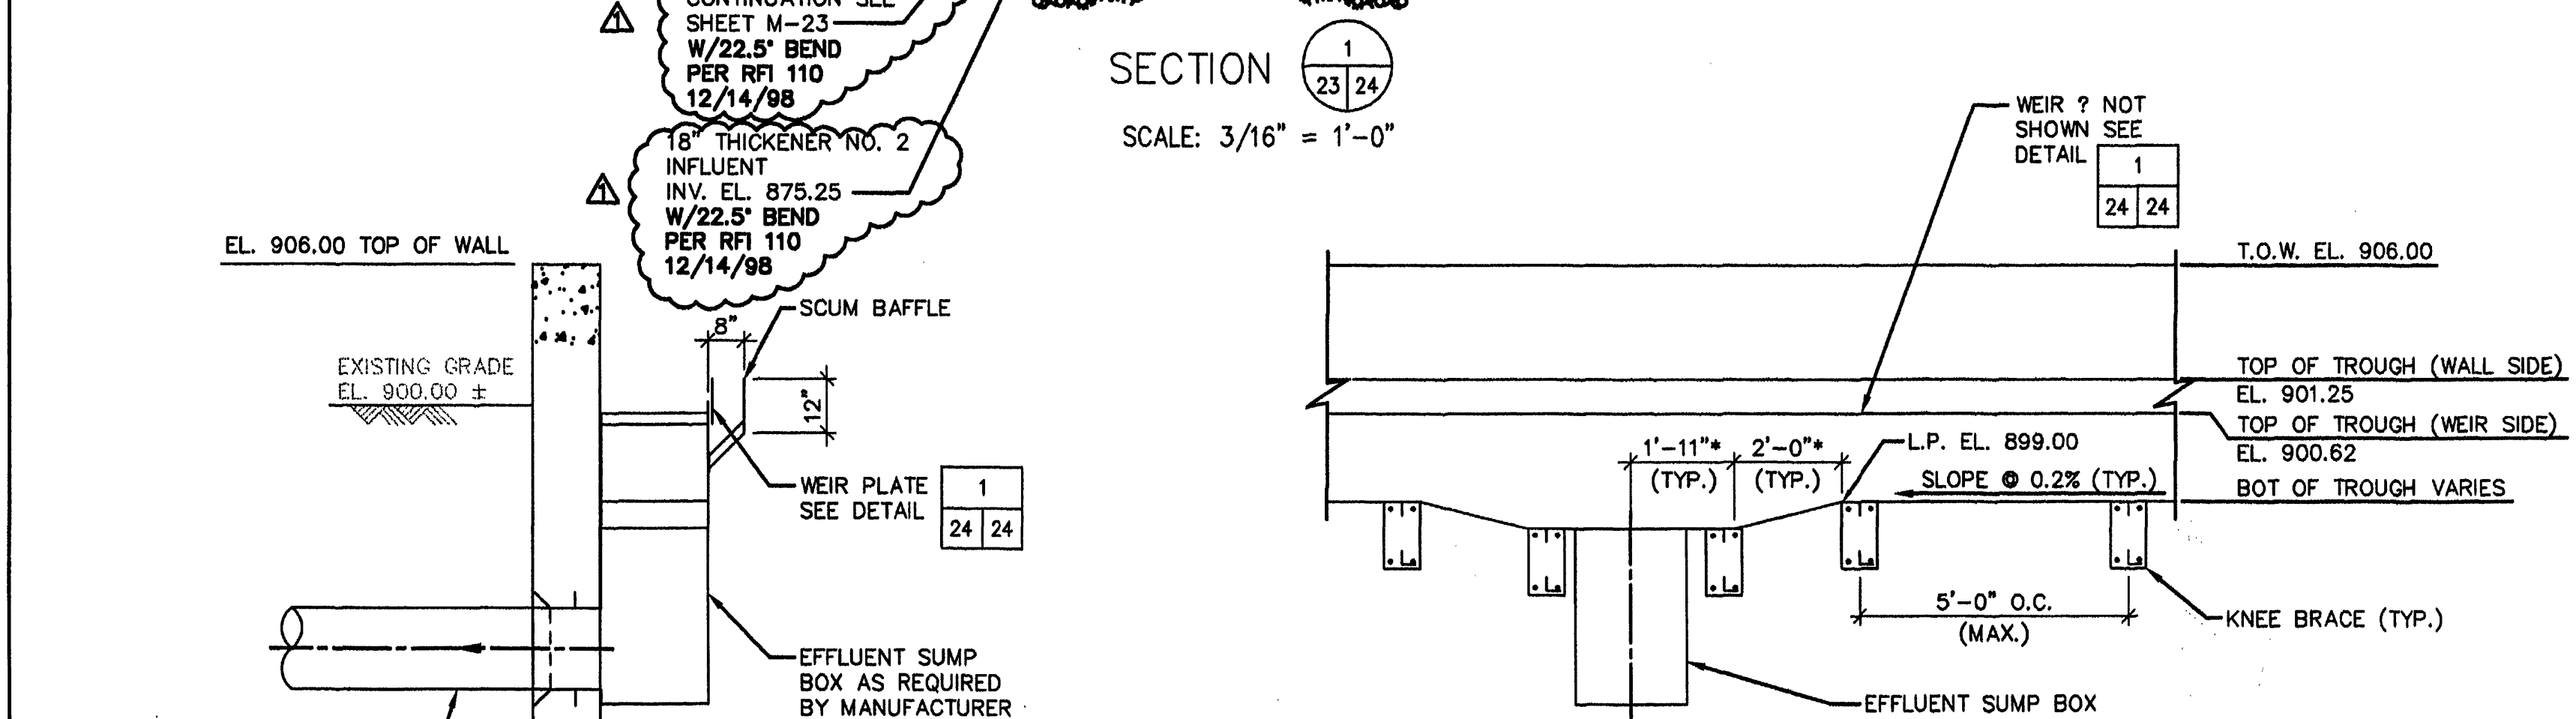

ELEVATION
DETAIL 1
SCALE: 3/8" = 1'-0"

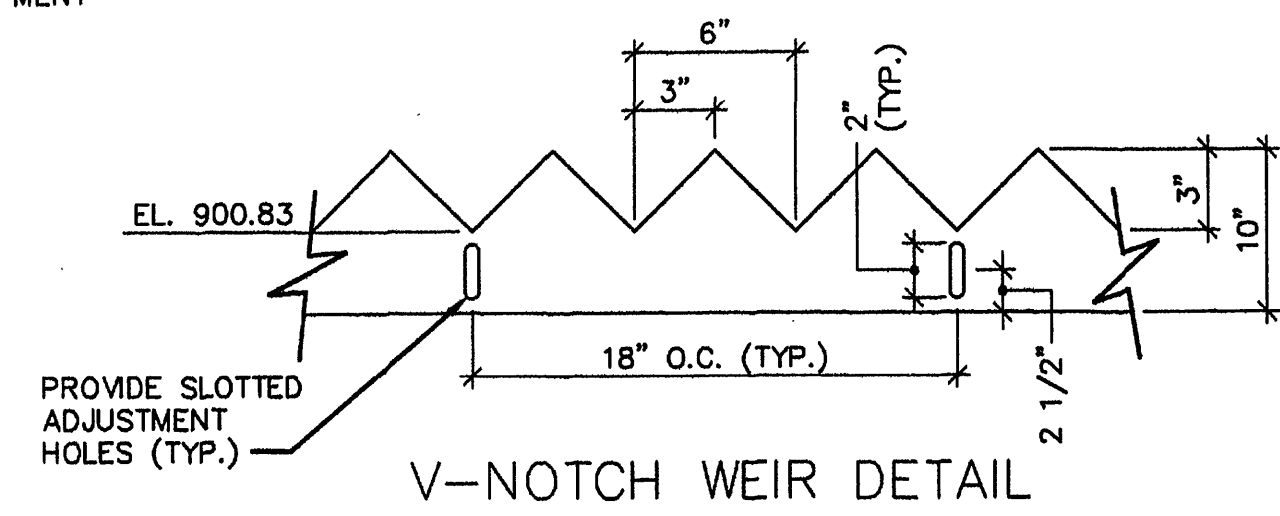


V-NOTCH WEIR DETAIL
DETAIL 1
NOT TO SCALE

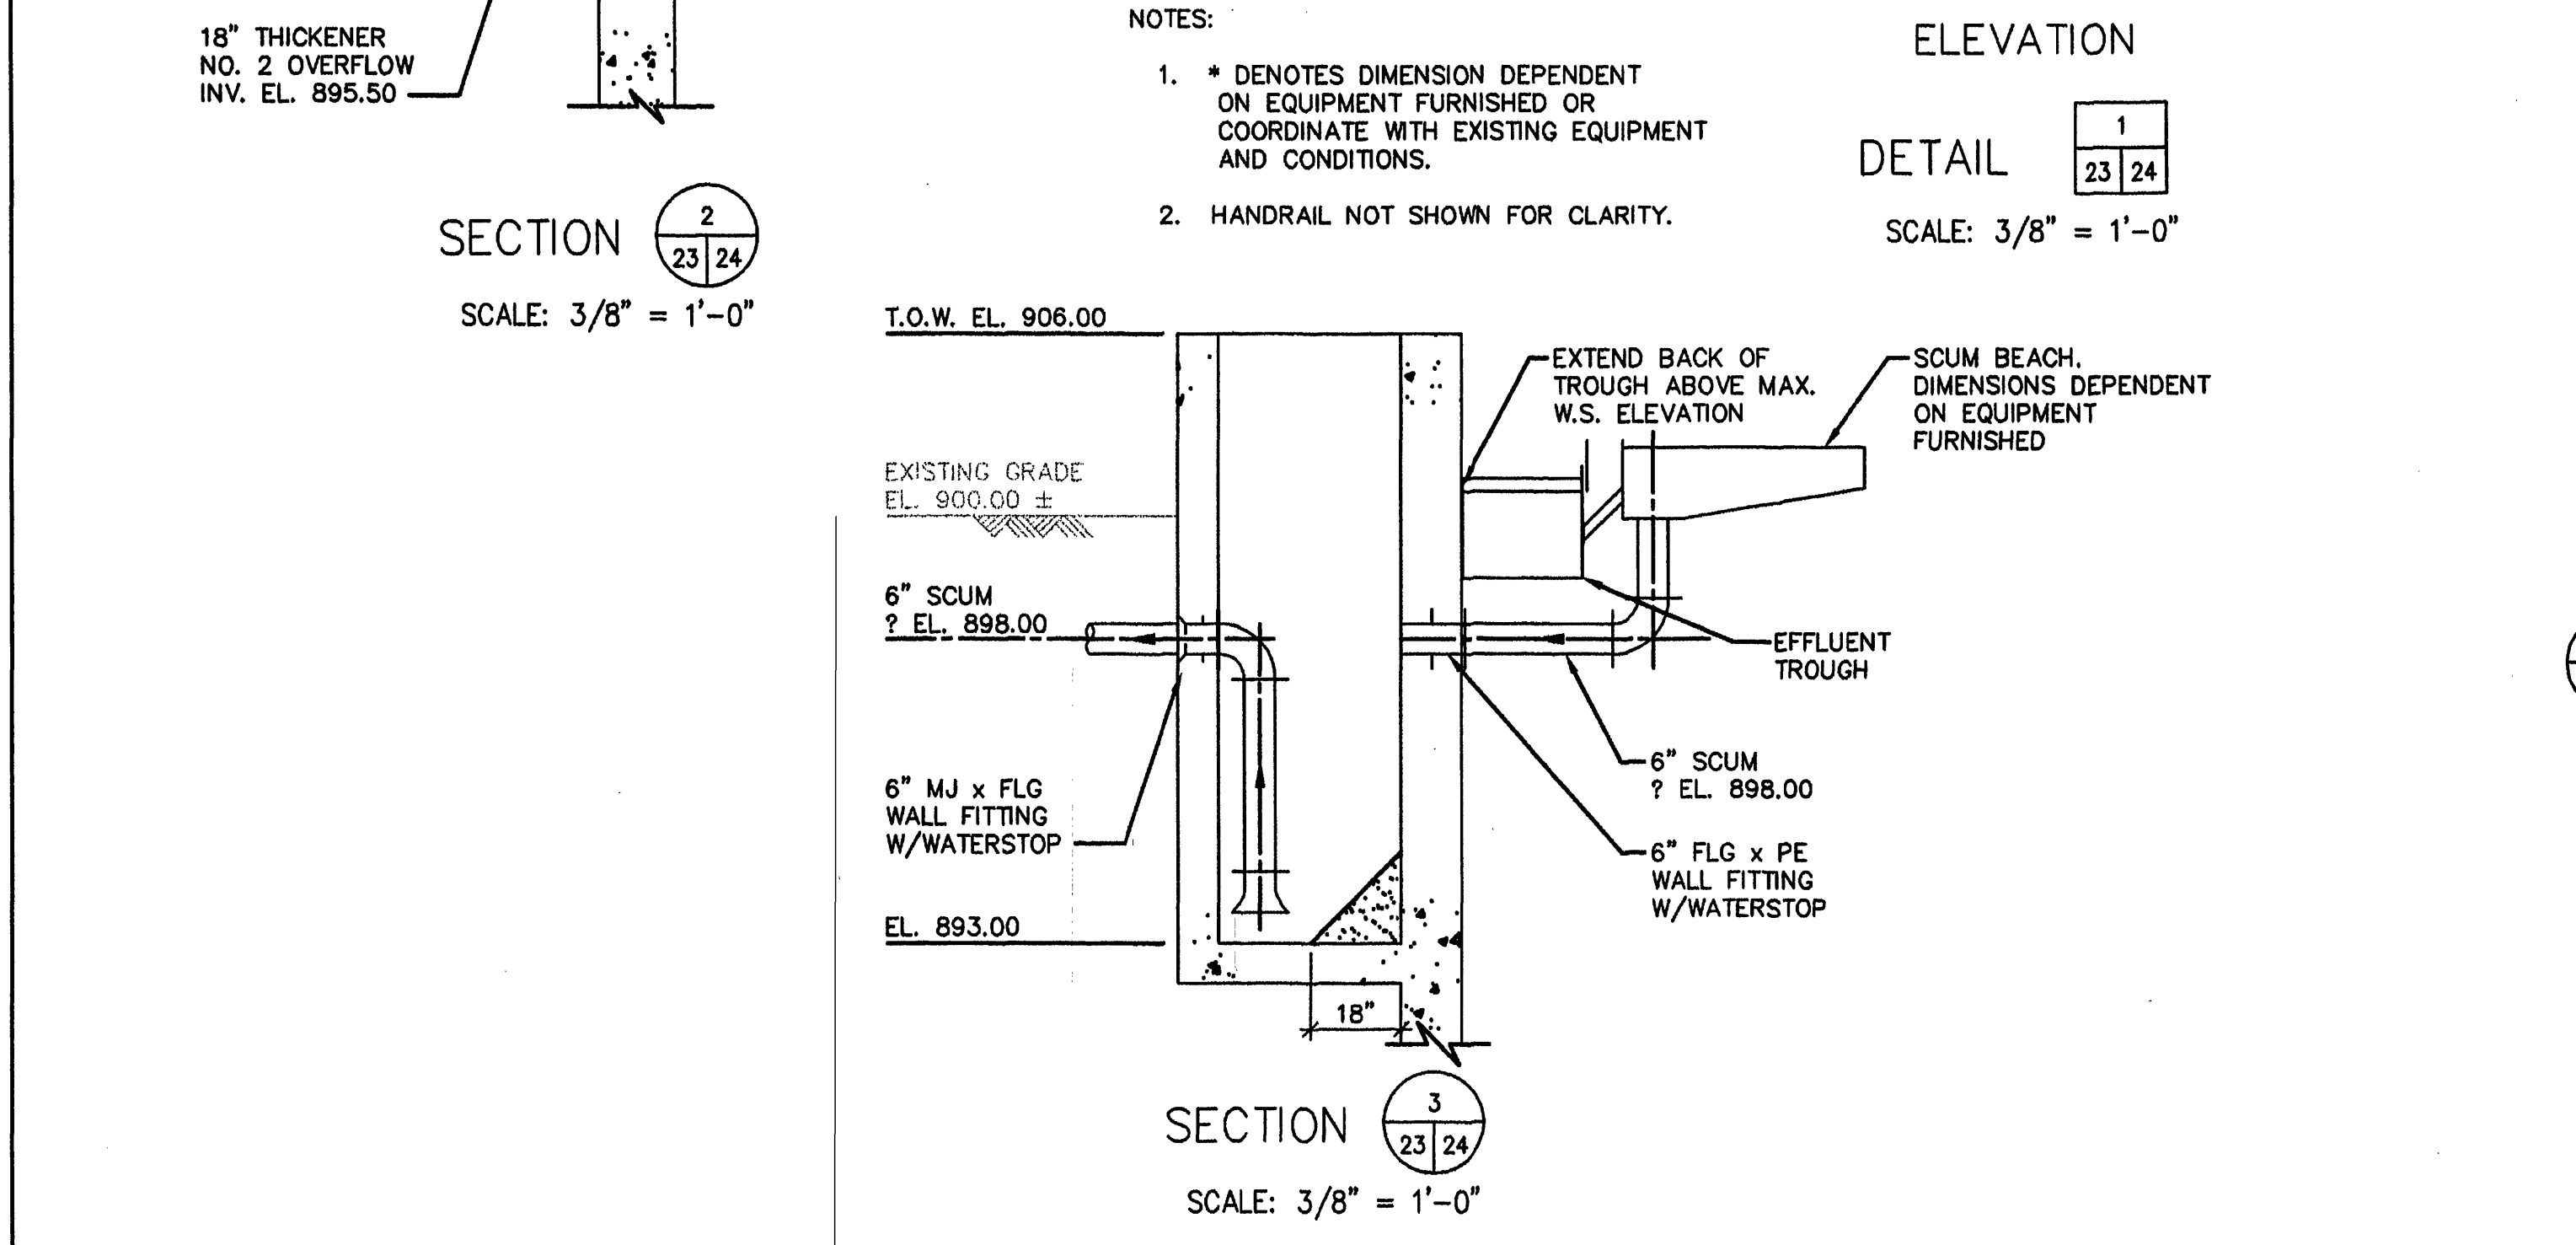


SECTION 2
SCALE: 3/8" = 1'-0"

SECTION 3
SCALE: 3/8" = 1'-0"

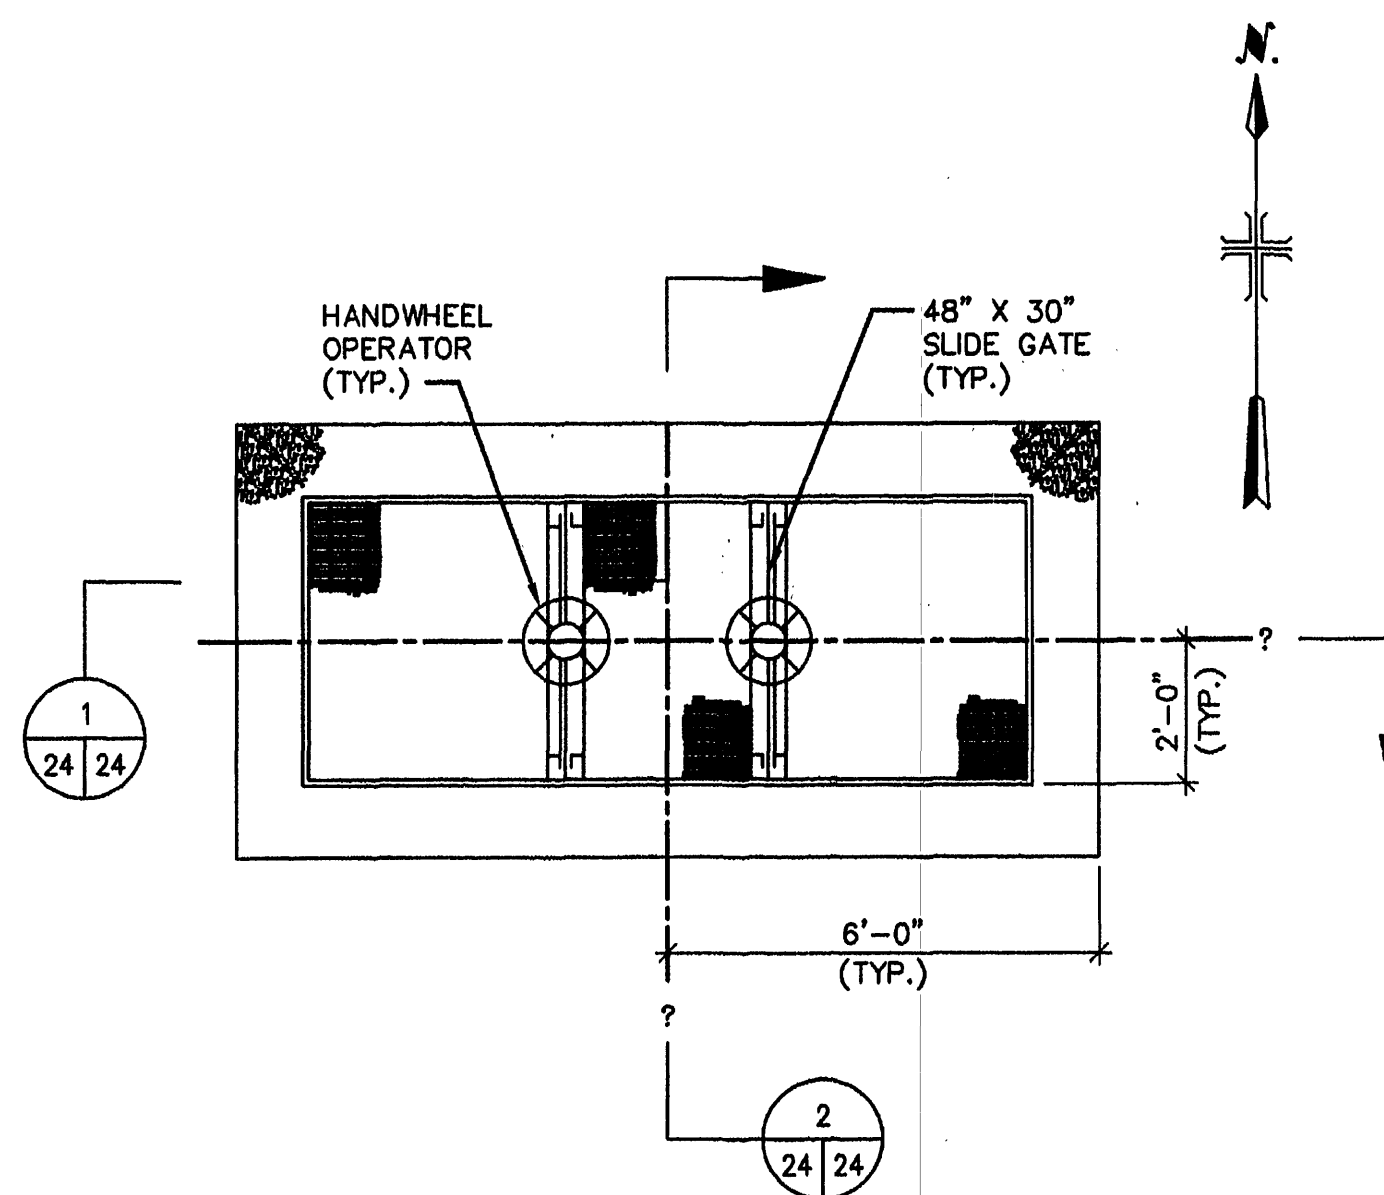

INFLUENT DISTRIBUTION CHAMBER
PLAN AT EL. 905.00
SCALE: 3/8" = 1'-0"

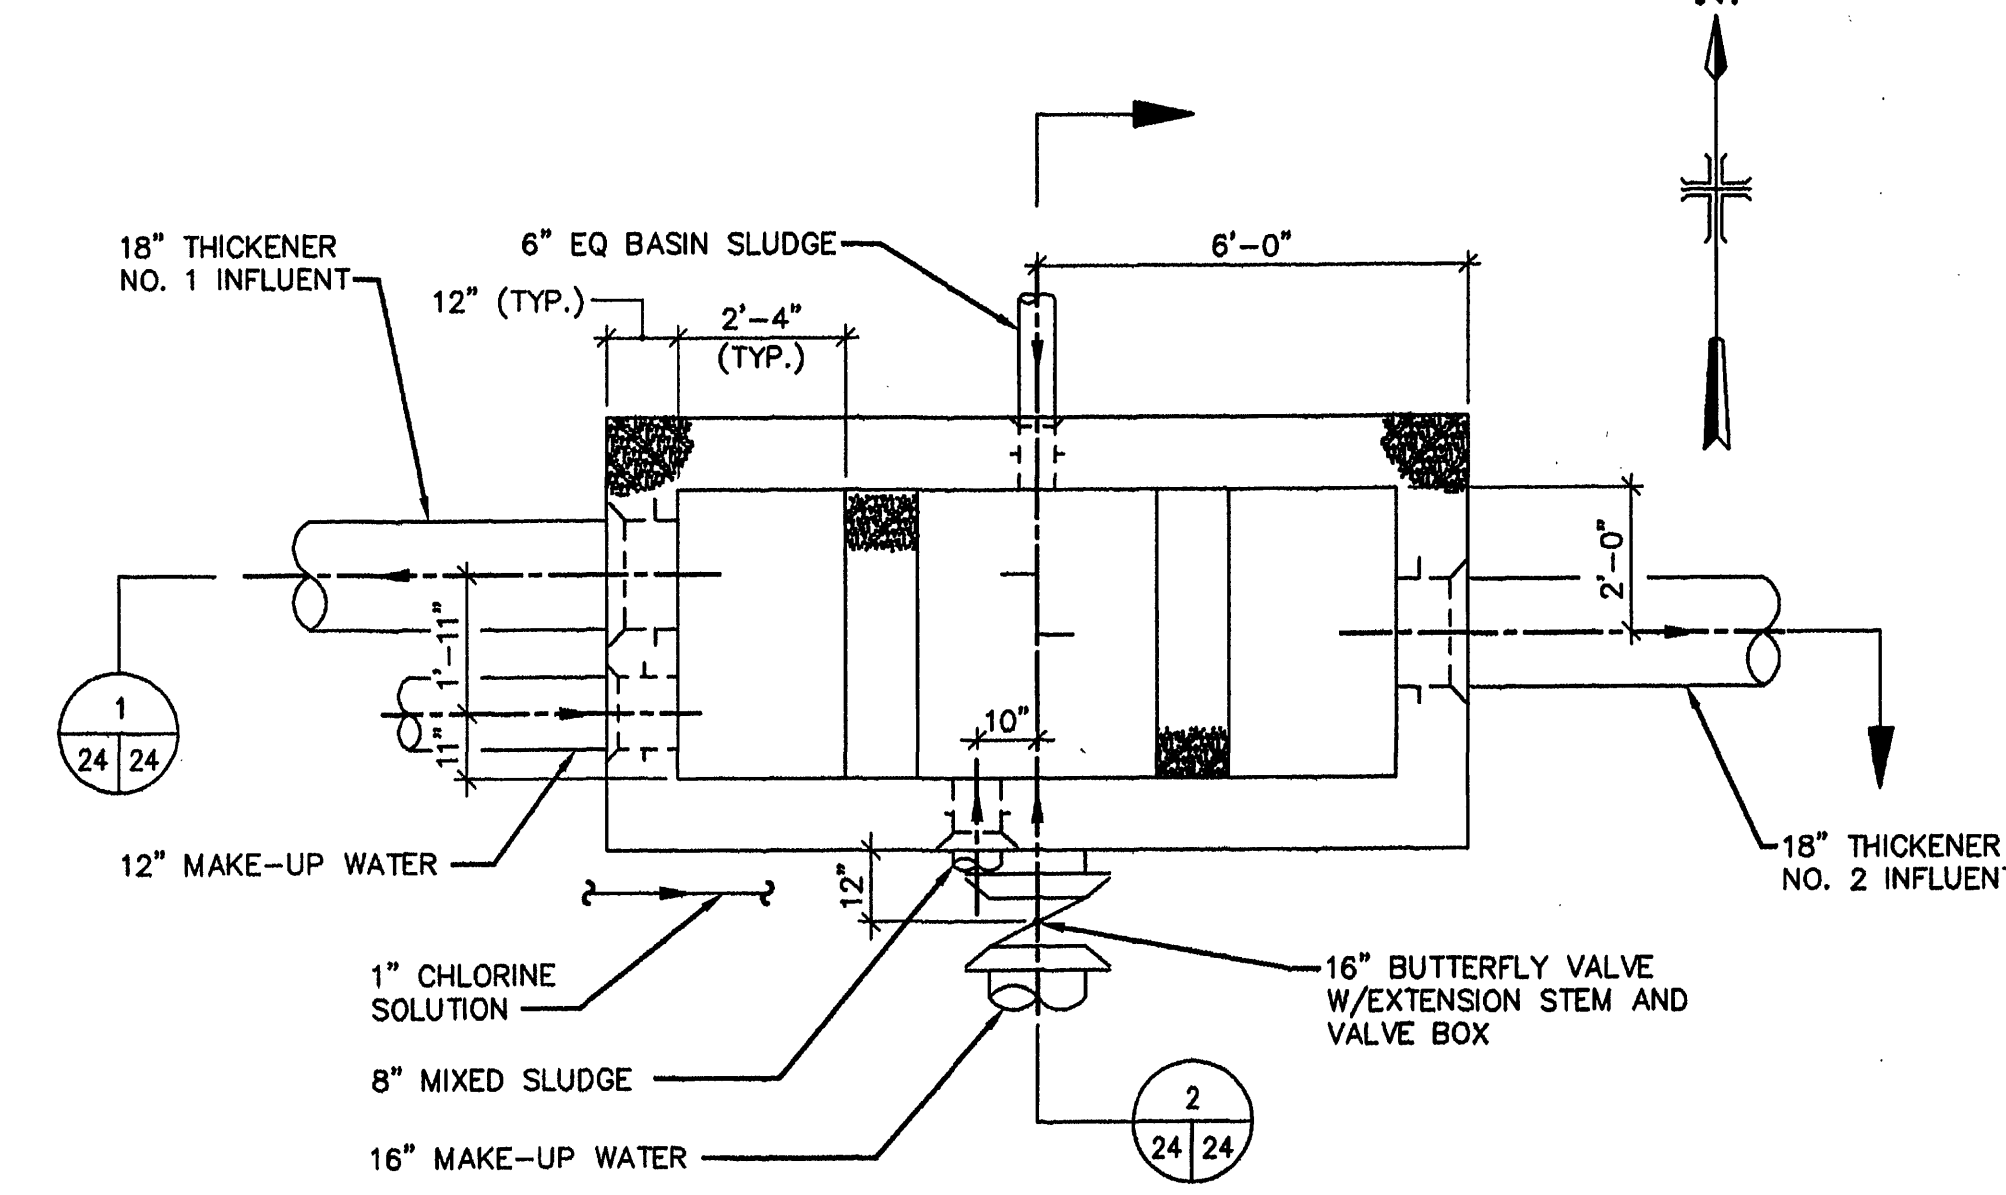


INFLUENT DISTRIBUTION CHAMBER
PLAN AT EL. 900.00
SCALE: 3/8" = 1'-0"

- NOTES:
- * DENOTES DIMENSION DEPENDENT ON EQUIPMENT FURNISHED OR COORDINATE WITH EXISTING EQUIPMENT AND CONDITIONS.
 - HANDRAIL NOT SHOWN FOR CLARITY.

MALCOLM PIRNIE
11832 Rock Landing Drive, Suite 400
Newport News, Virginia 23606

NO.	BY	DATE	REVISIONS	REMARKS
1	ARB	JAN. 2000	RECORD DRAWING	

DES. CWM
DWN. MPK
CKD. GJJ

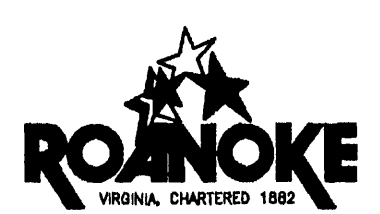

CITY OF ROANOKE, VIRGINIA
WATER POLLUTION
CONTROL PLANT
UPGRADE AND EXPANSION

GRAVITY THICKENER
PLANS, SECTIONS AND DETAILS
SCALE AS NOTED

COPYRIGHT © 1997
MALCOLM PIRNIE, INC.
DATE MAY 1997
M SHEET 24 OF 30
CAD REF. NO. 0060M025