



**PLAN OF SECONDARY DIGESTER WITH NEW COVER**  
SCALE: 1/8"=1'-0"

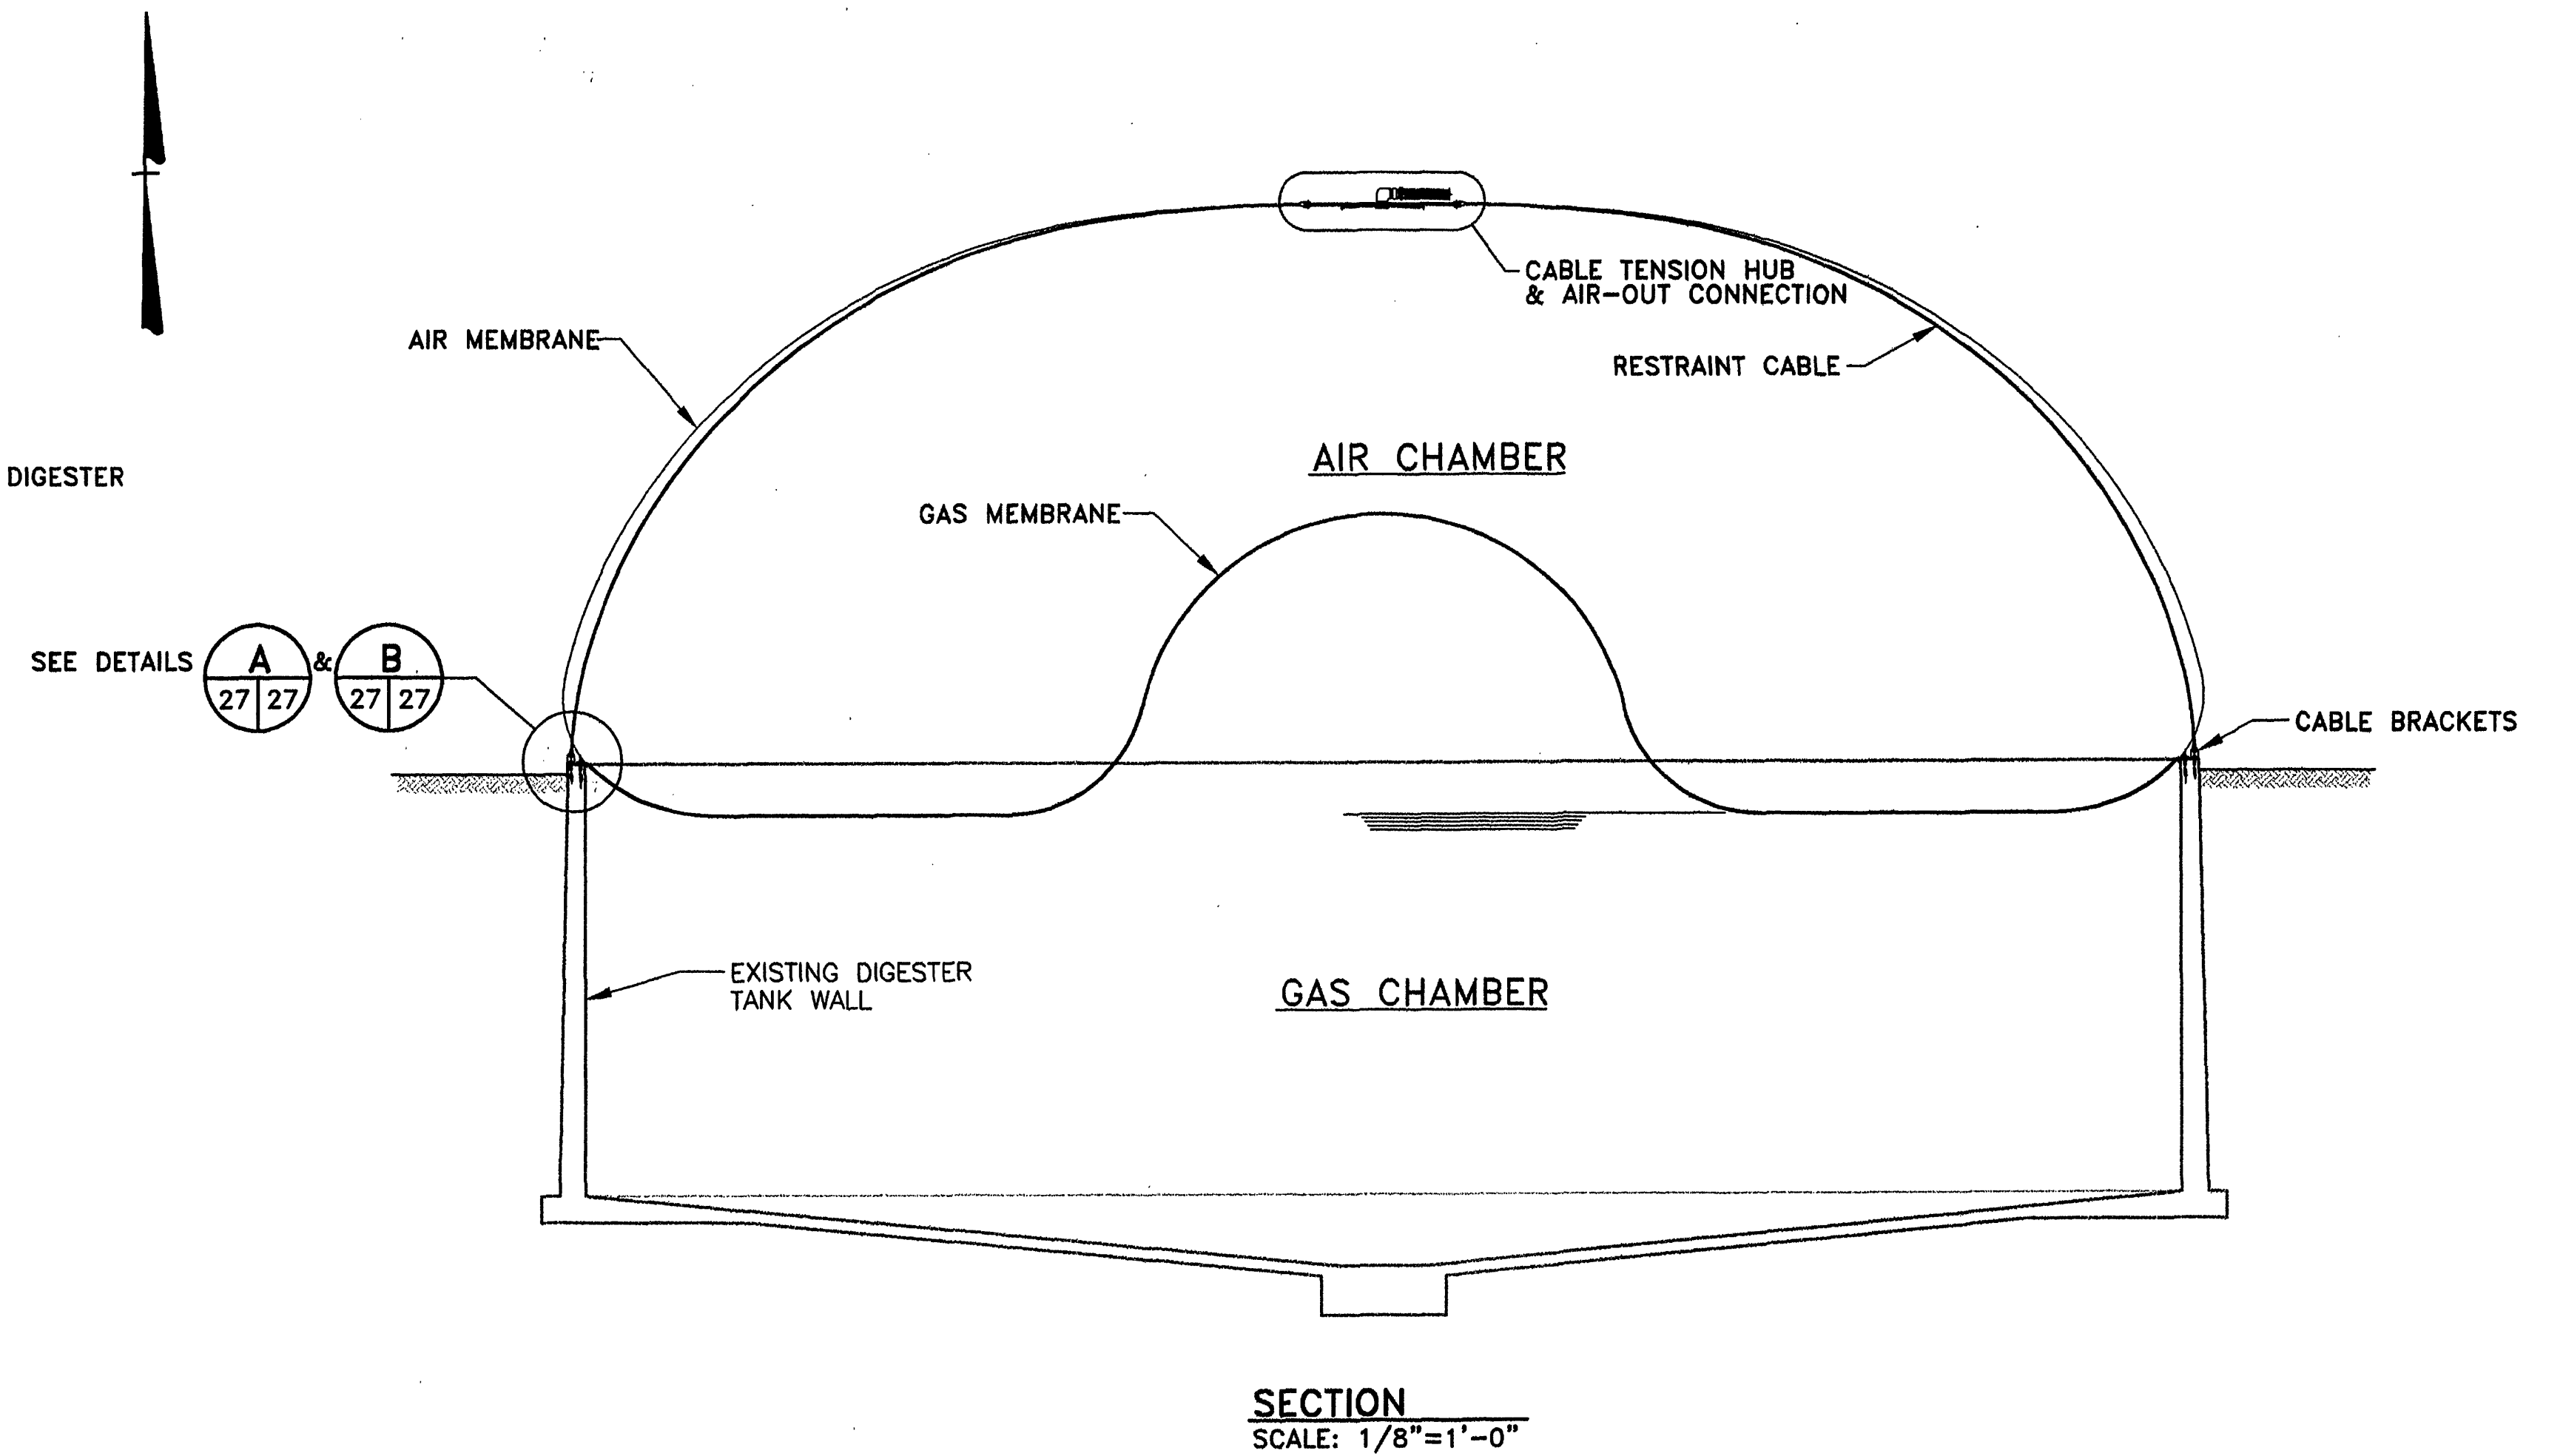

**SECTION**  
SCALE: 1/8"=1'-0"


**NOTES**

1. DETAILS SHOWN HEREON ARE CONSIDERED TO BE FOR GENERAL SYSTEM CONFIGURATIONS. DIMENSIONS AND LAYOUT SHALL BE IN ACCORDANCE WITH THE SPECIFICATIONS AND MANUFACTURER'S REQUIREMENTS.

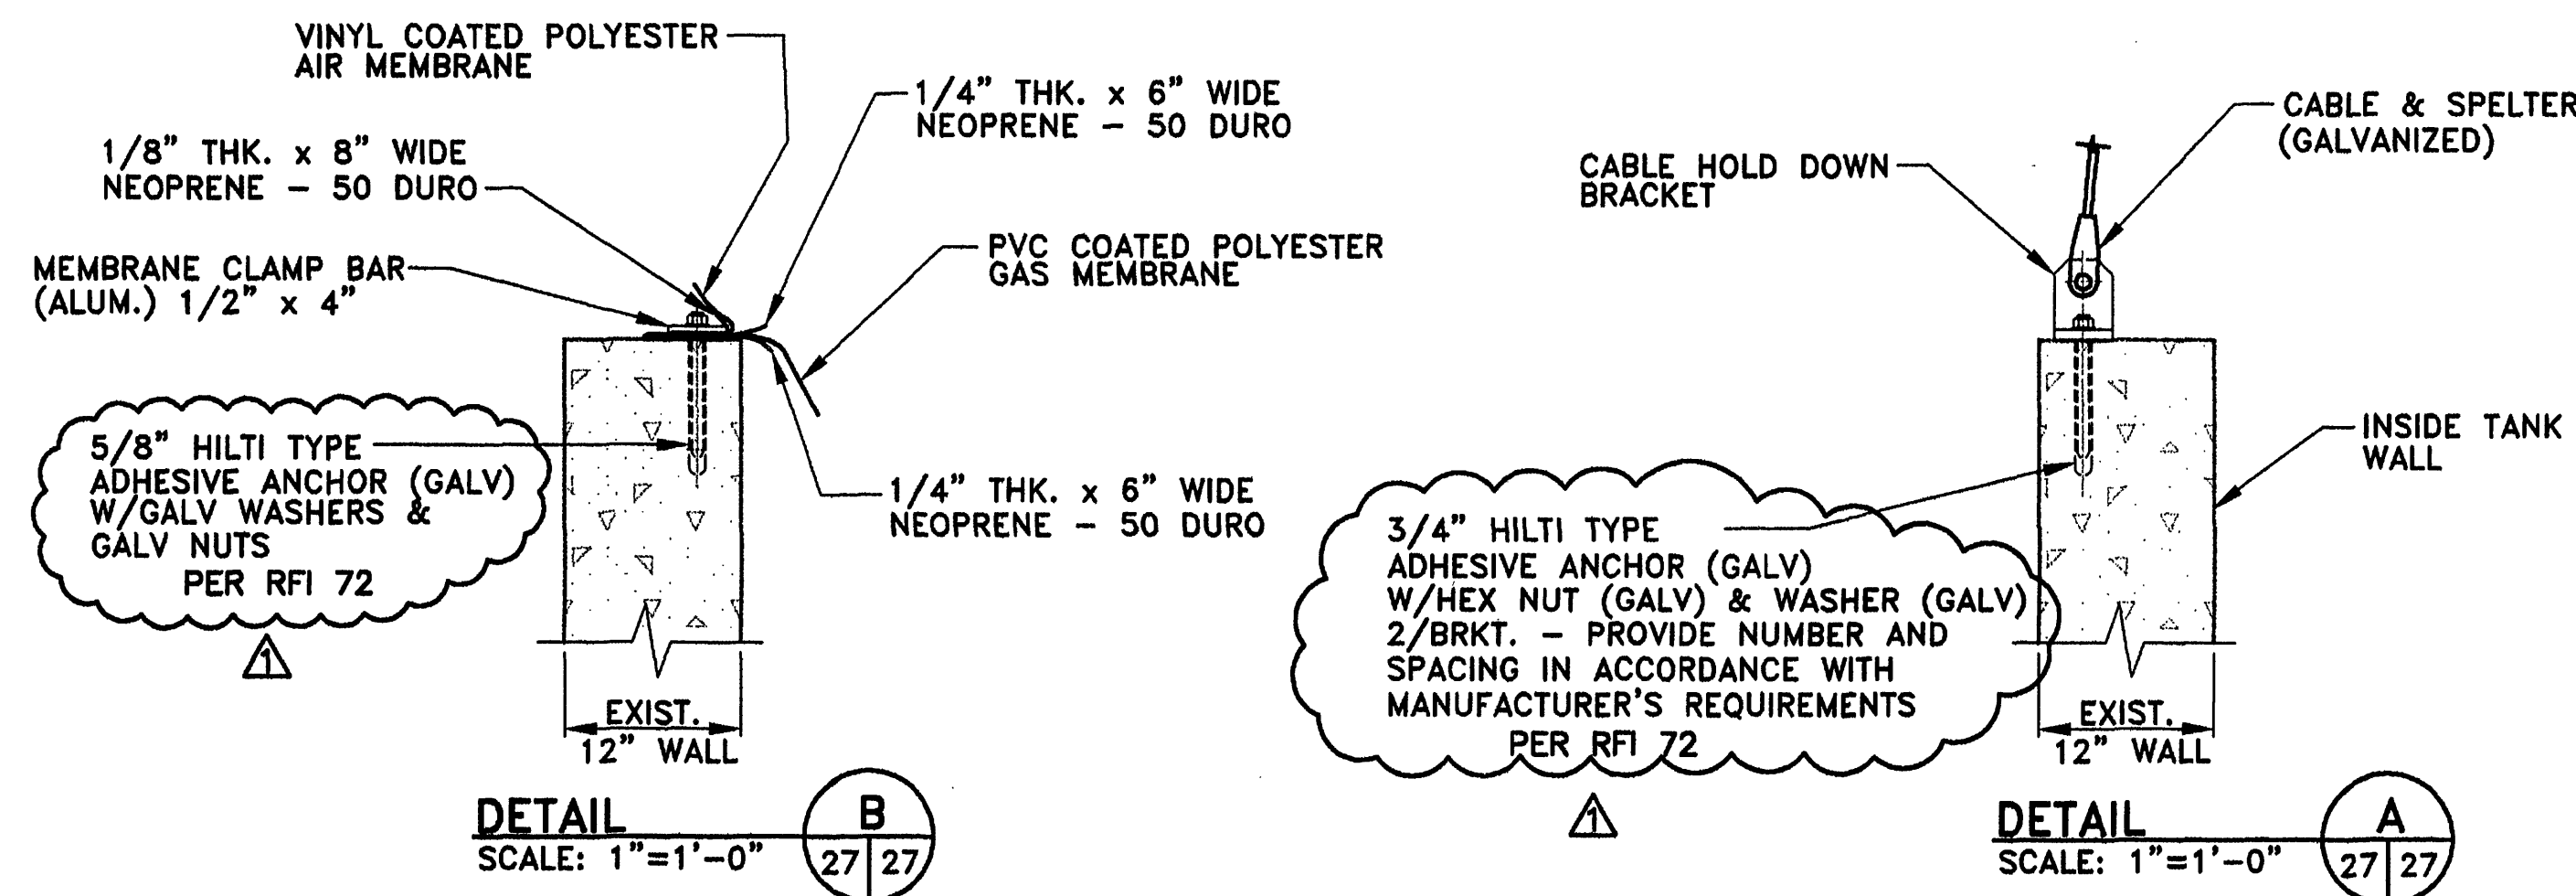

**DETAIL B**  
SCALE: 1"=1'-0"


**DETAIL A**  
SCALE: 1"=1'-0"

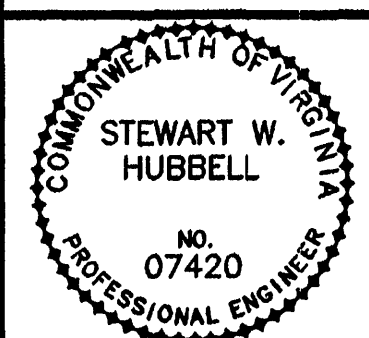

**Mattern & Craig, Inc.**  
CONSULTING ENGINEERS - SURVEYORS  
100 TRUMP STREET, S.W.  
ROANOKE, VIRGINIA 24016  
(800) 544-0444  
(540) 942-7001 FAX

REVISIONS				
NO.	BY	DATE	REVISIONS	REMARKS
1	ARB	JAN. 2000	RECORD DRAWING	

DES: WTA  
DWN: LDL:ARB  
CKD: SWH

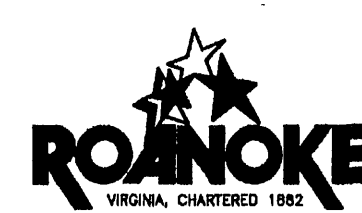

CITY OF ROANOKE, VIRGINIA  
**WATER POLLUTION  
CONTROL PLANT  
UPGRADE AND EXPANSION**

SECONDARY DIGESTERS 3 & 5  
**NEW COVER  
SECTION AND DETAILS**  
SCALE: AS SHOWN

DATE: MAY, 1997  
M SHEET 27 OF 30  
CAD REF. NO. M27.DWG