


7360 2439030501 1\ACAD\VP\PLA\06060205\06060354 Scale: 1/8" = 1'-0" Date: 05/05/1997 Time: 15:40

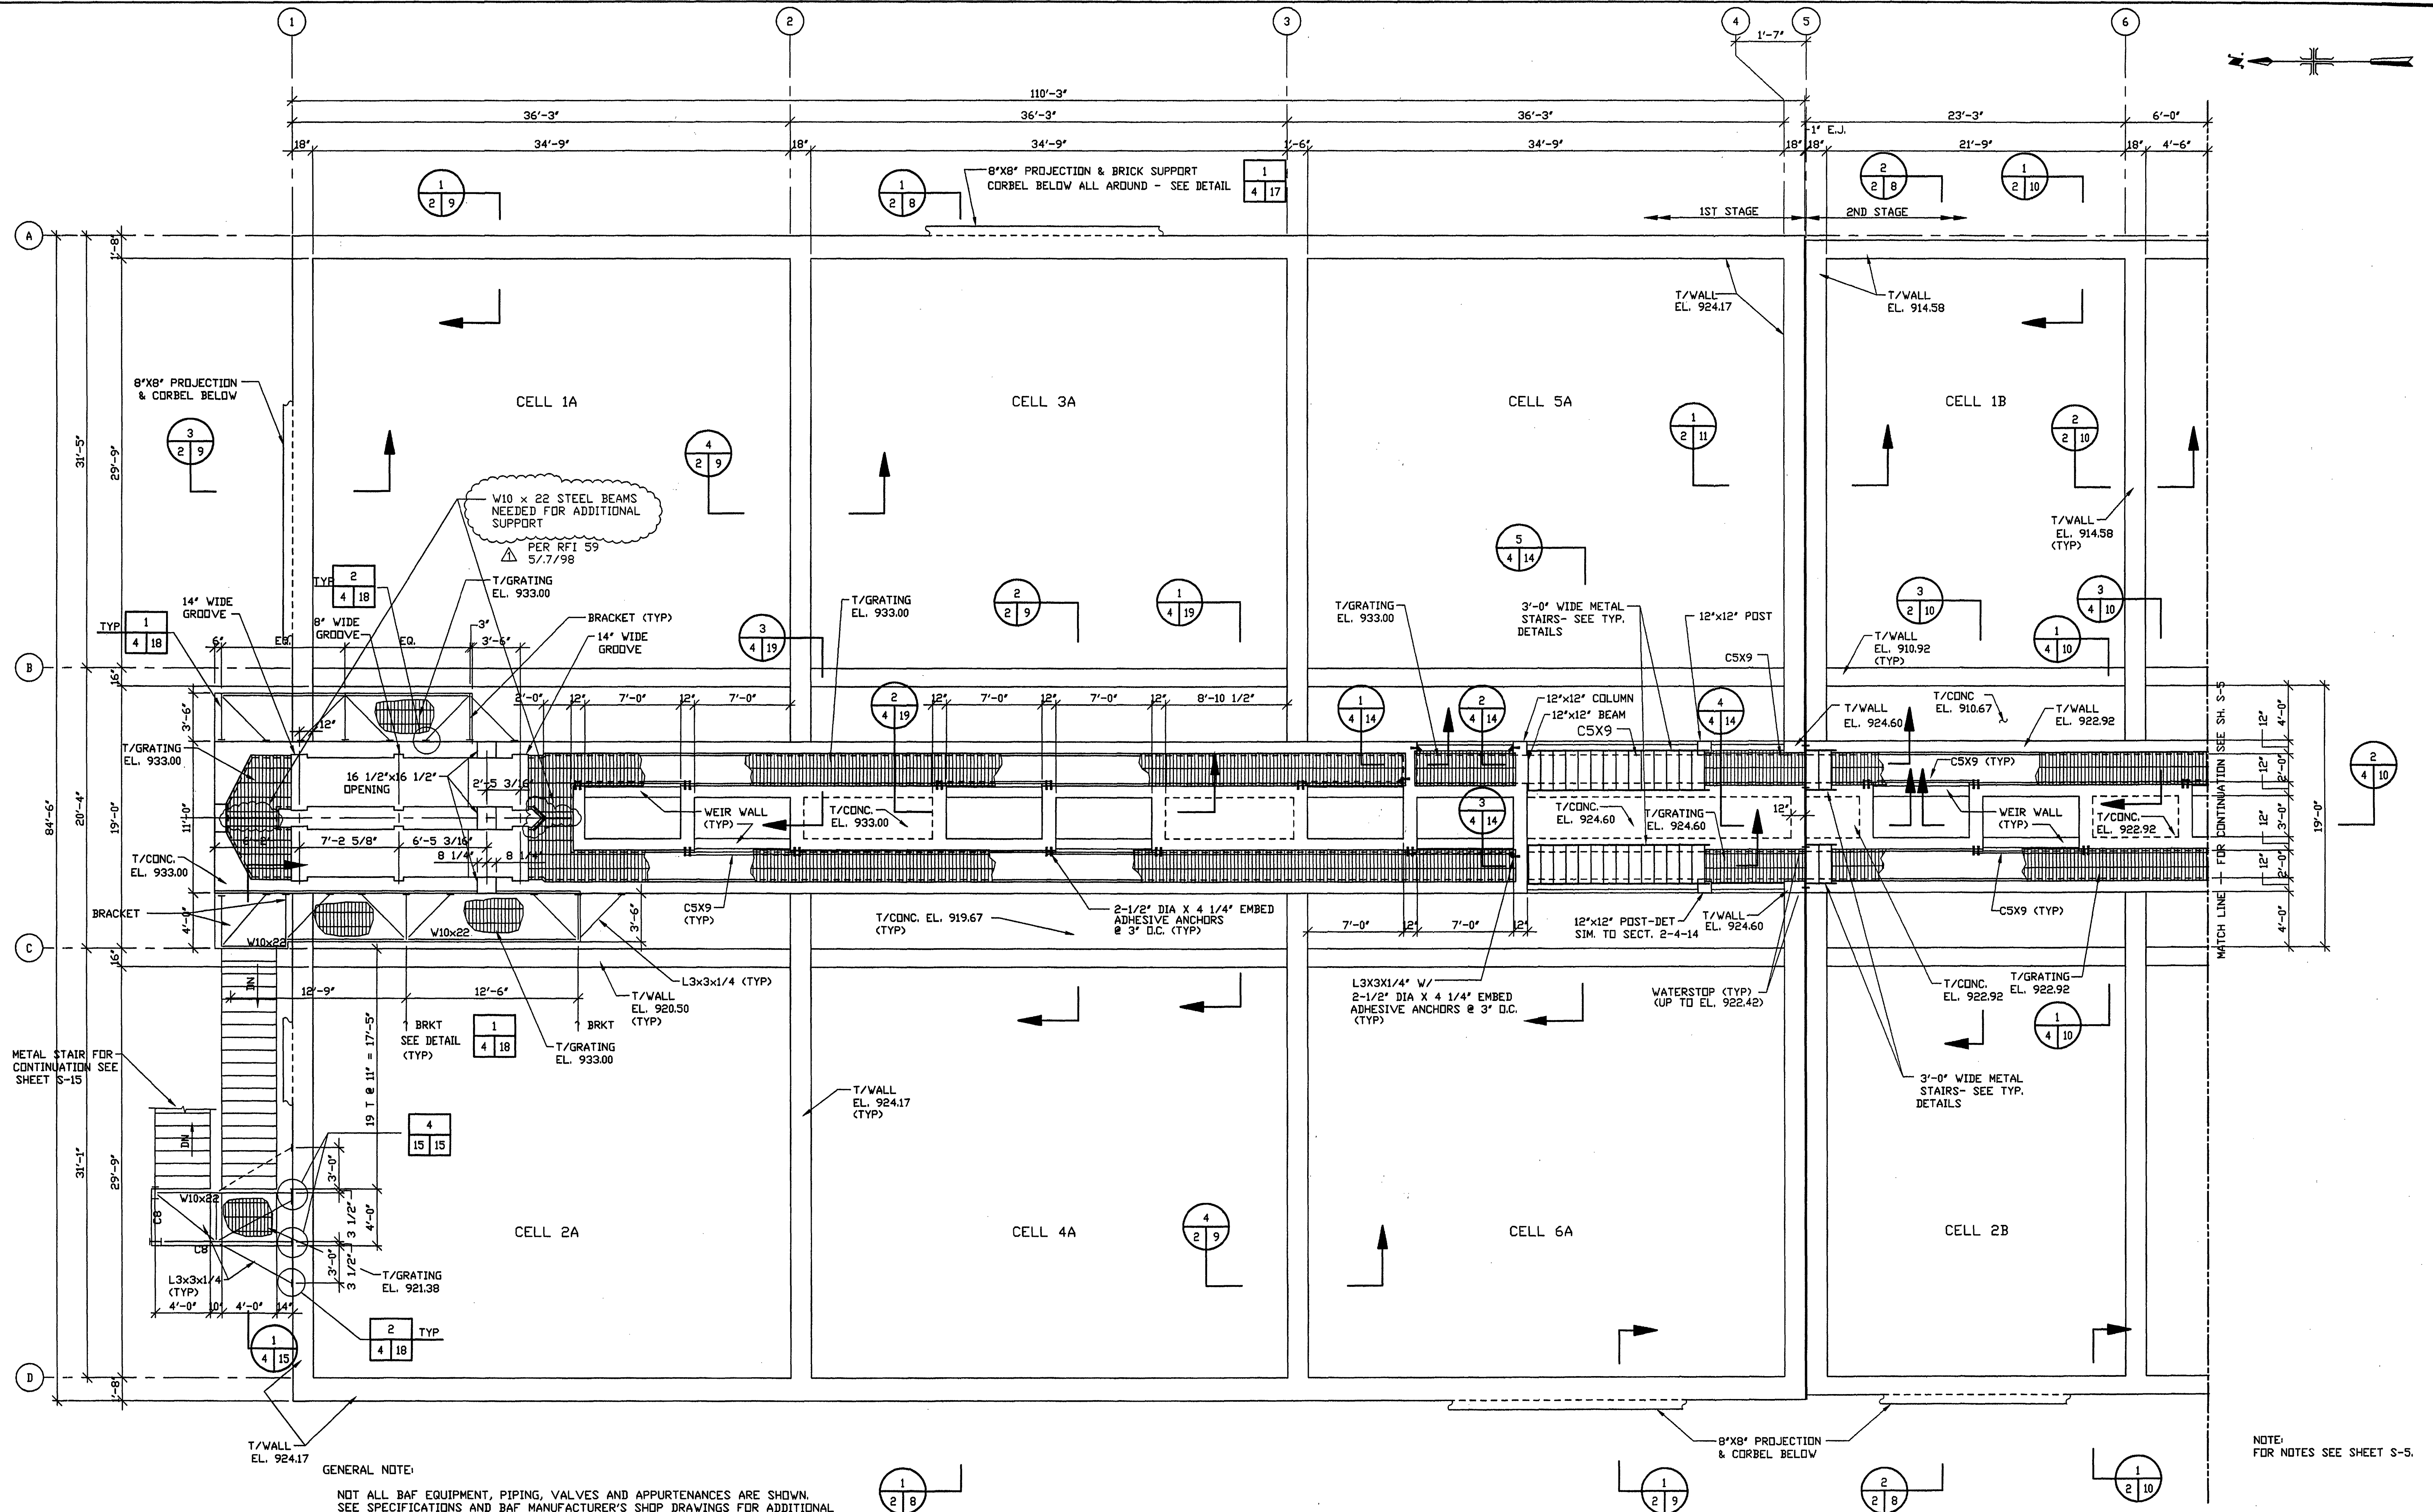

GENERAL NOTE:

NOT ALL BAF EQUIPMENT, PIPING, VALVES AND APPURTENANCES ARE SHOWN. SEE SPECIFICATIONS AND BAF MANUFACTURER'S SHOP DRAWINGS FOR ADDITIONAL ITEMS AND SCOPE OF EQUIPMENT, PIPING, VALVES AND APPURTENANCES SUPPLIED TO THE CONTRACTOR BY THE BAF MANUFACTURER.

NOTE:
FOR NOTES SEE SHEET S-5.

**MALCOLM
PIRNIE**

11832 Rock Landing Drive, Suite 400
Newport News, Virginia 23606

REVISIONS			REMARKS
NO.	BY	DATE	
1	ARB	JAN. 2000	RECORD DRAWING

DES --- MZ ---
DRN DRK\CBM
CKD --- DB ---



CITY OF ROANOKE, VIRGINIA
WATER POLLUTION
CONTROL PLANT
UPGRADE AND EXPANSION

BIOLOGICAL AERATED FILTER
TOP PLAN
SHEET 1
3/16"=1'-0"

COPYRIGHT © 1997
MALCOLM PIRNIE, INC.
DATE --- MAY 1997 ---
SHEET 4 OF 44
CAD REF. NO. 0060S354