




4873 0060028592 I:\ACAD\PROJ\00600285\00600357 Scale: 1:1 Date: 04/30/1997 Time: 13:53

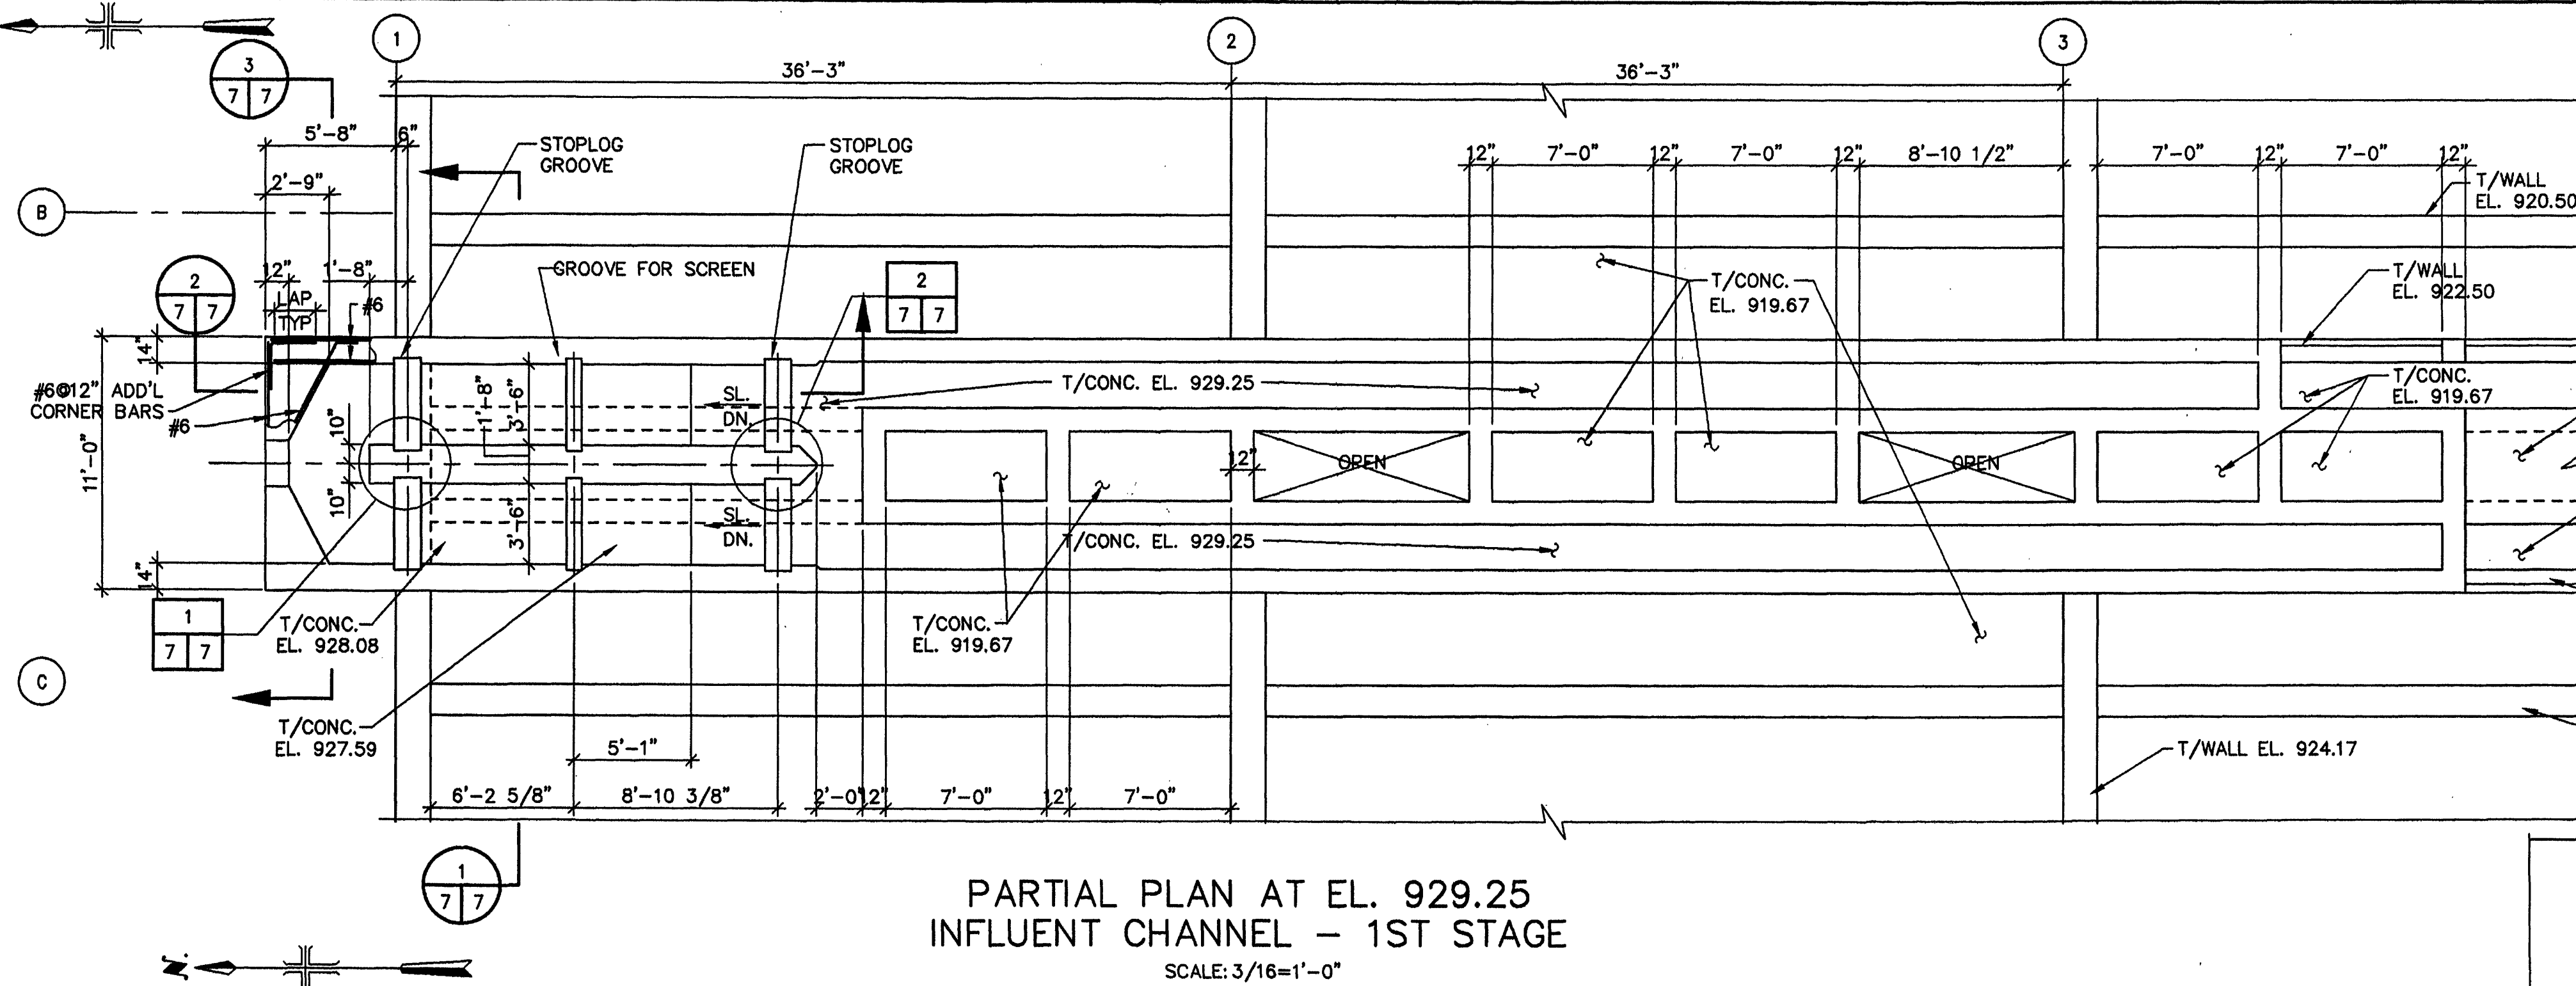


PARTIAL PLAN AT EL. 929.25
INFLUENT CHANNEL - 1ST STAGE
SCALE: 3/16"=1'-0"

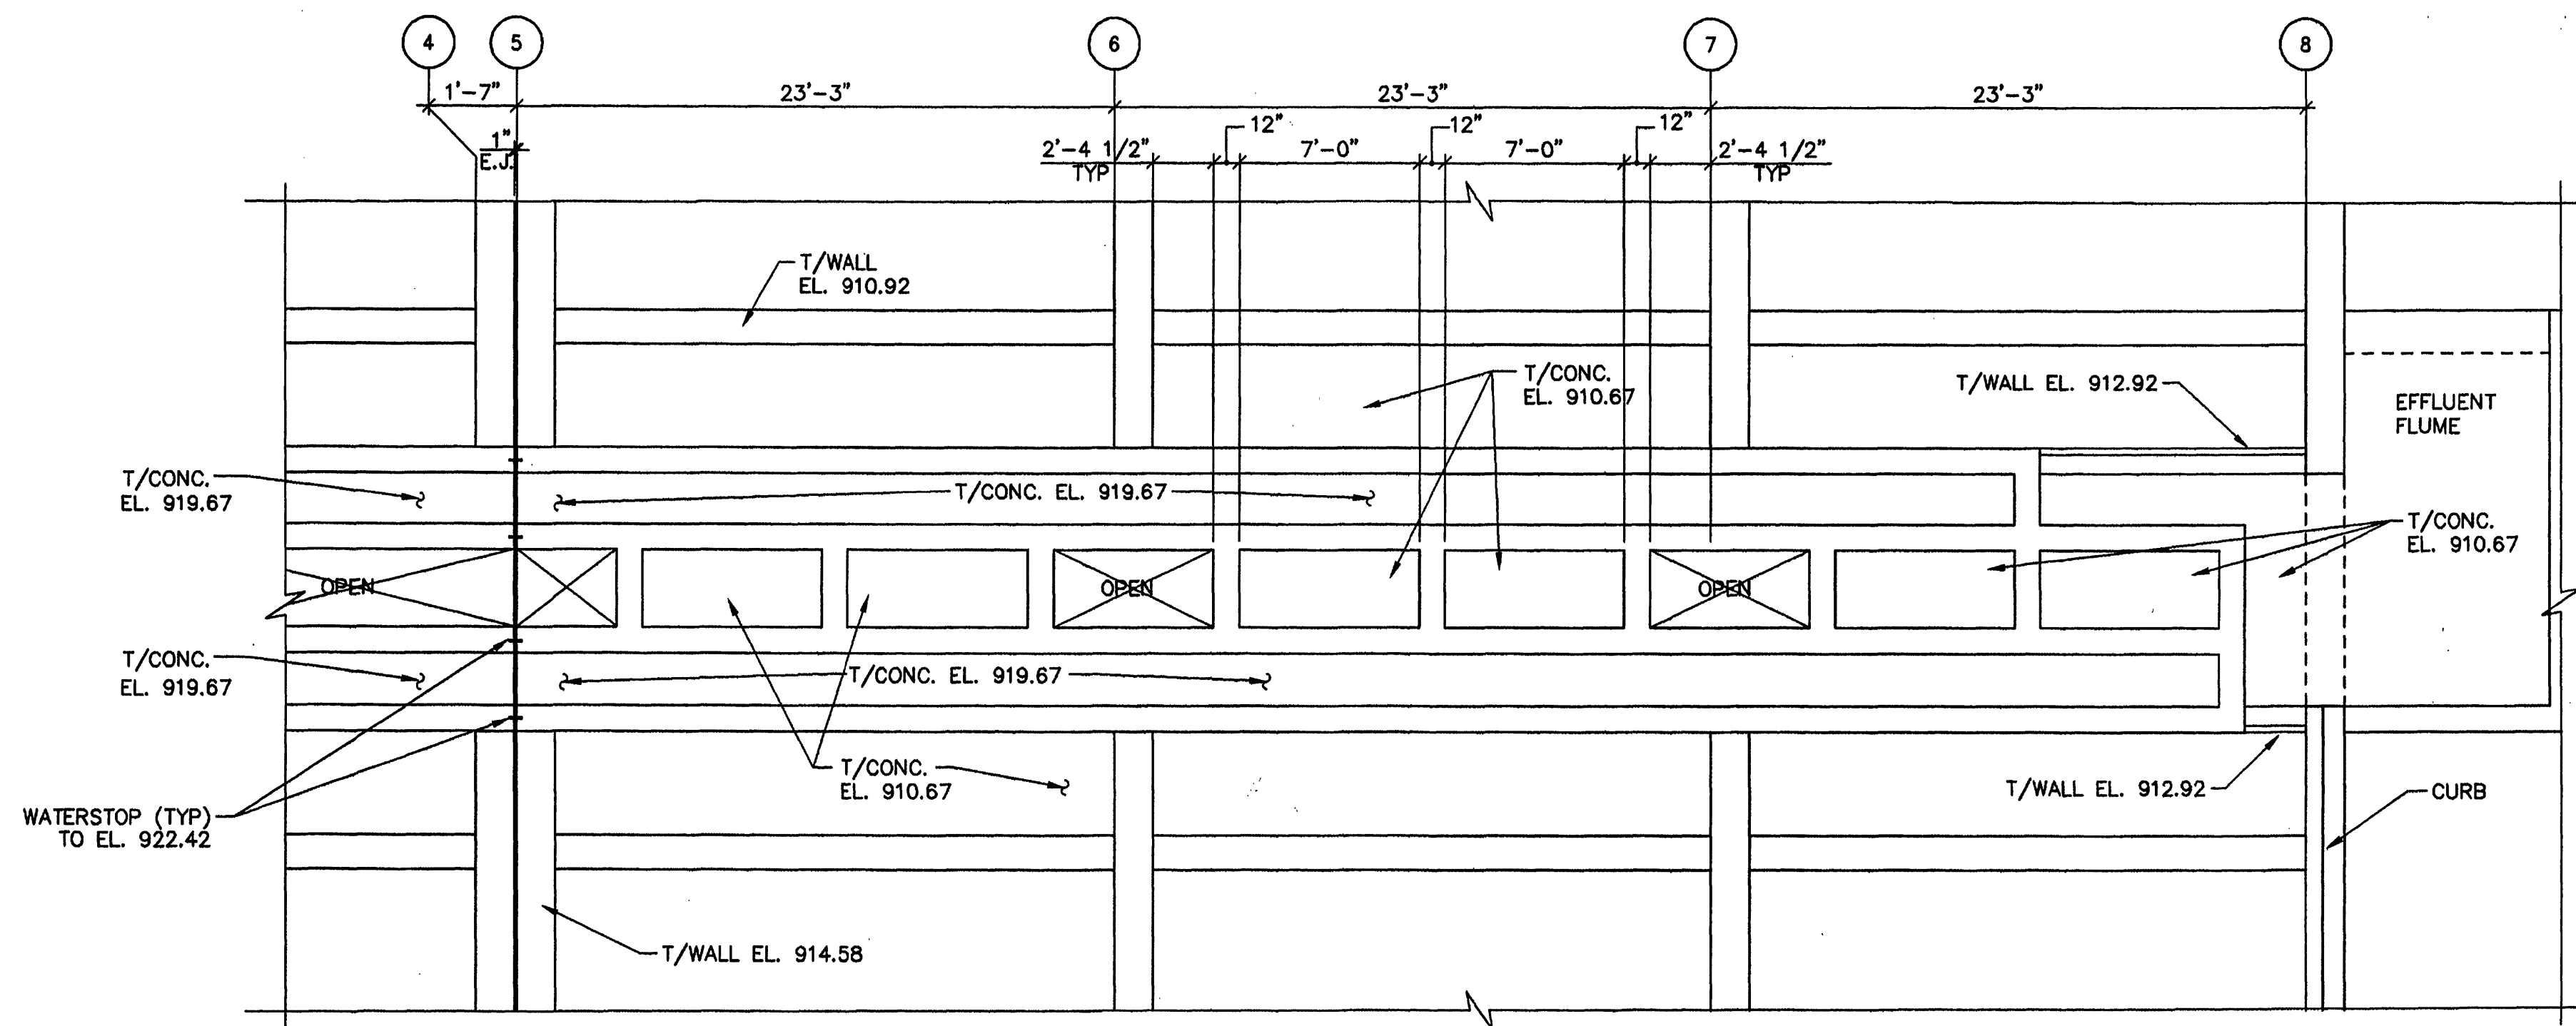


PARTIAL PLAN AT EL. 919.67
INFLUENT CHANNEL - 2ND STAGE
SCALE: 3/16"=1'-0"

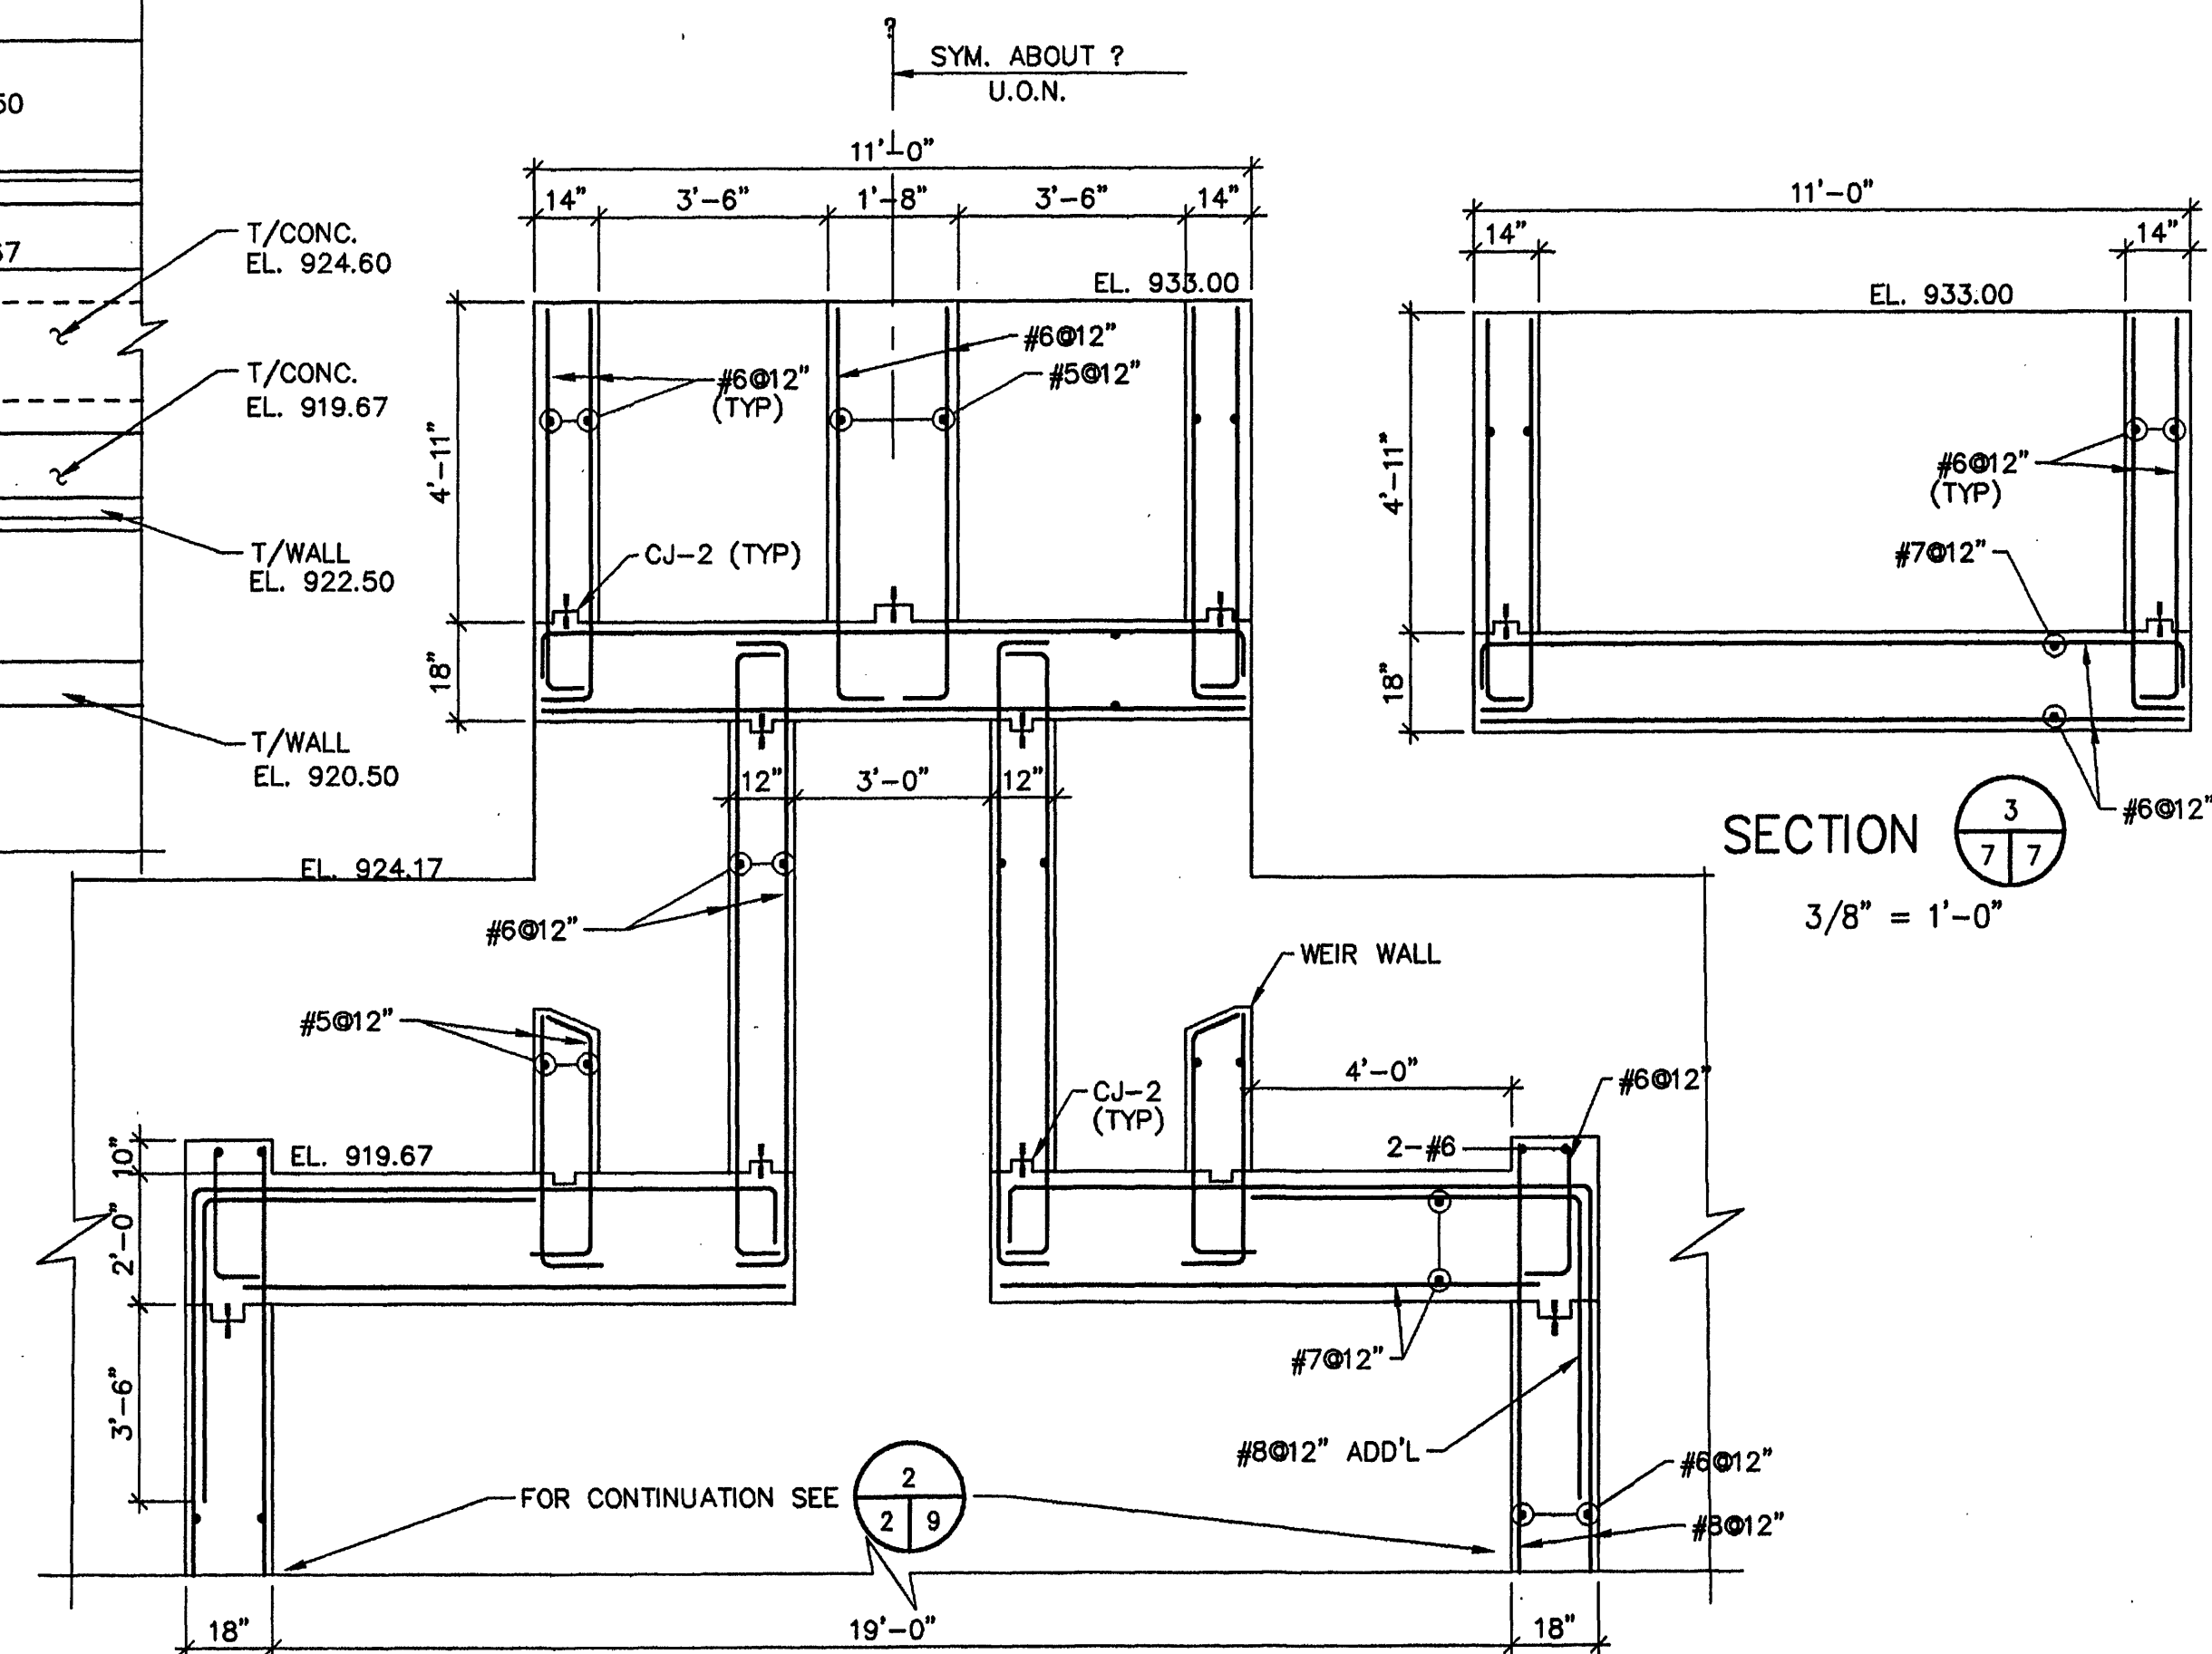


SECTION 3/7/7
3/8" = 1'-0"

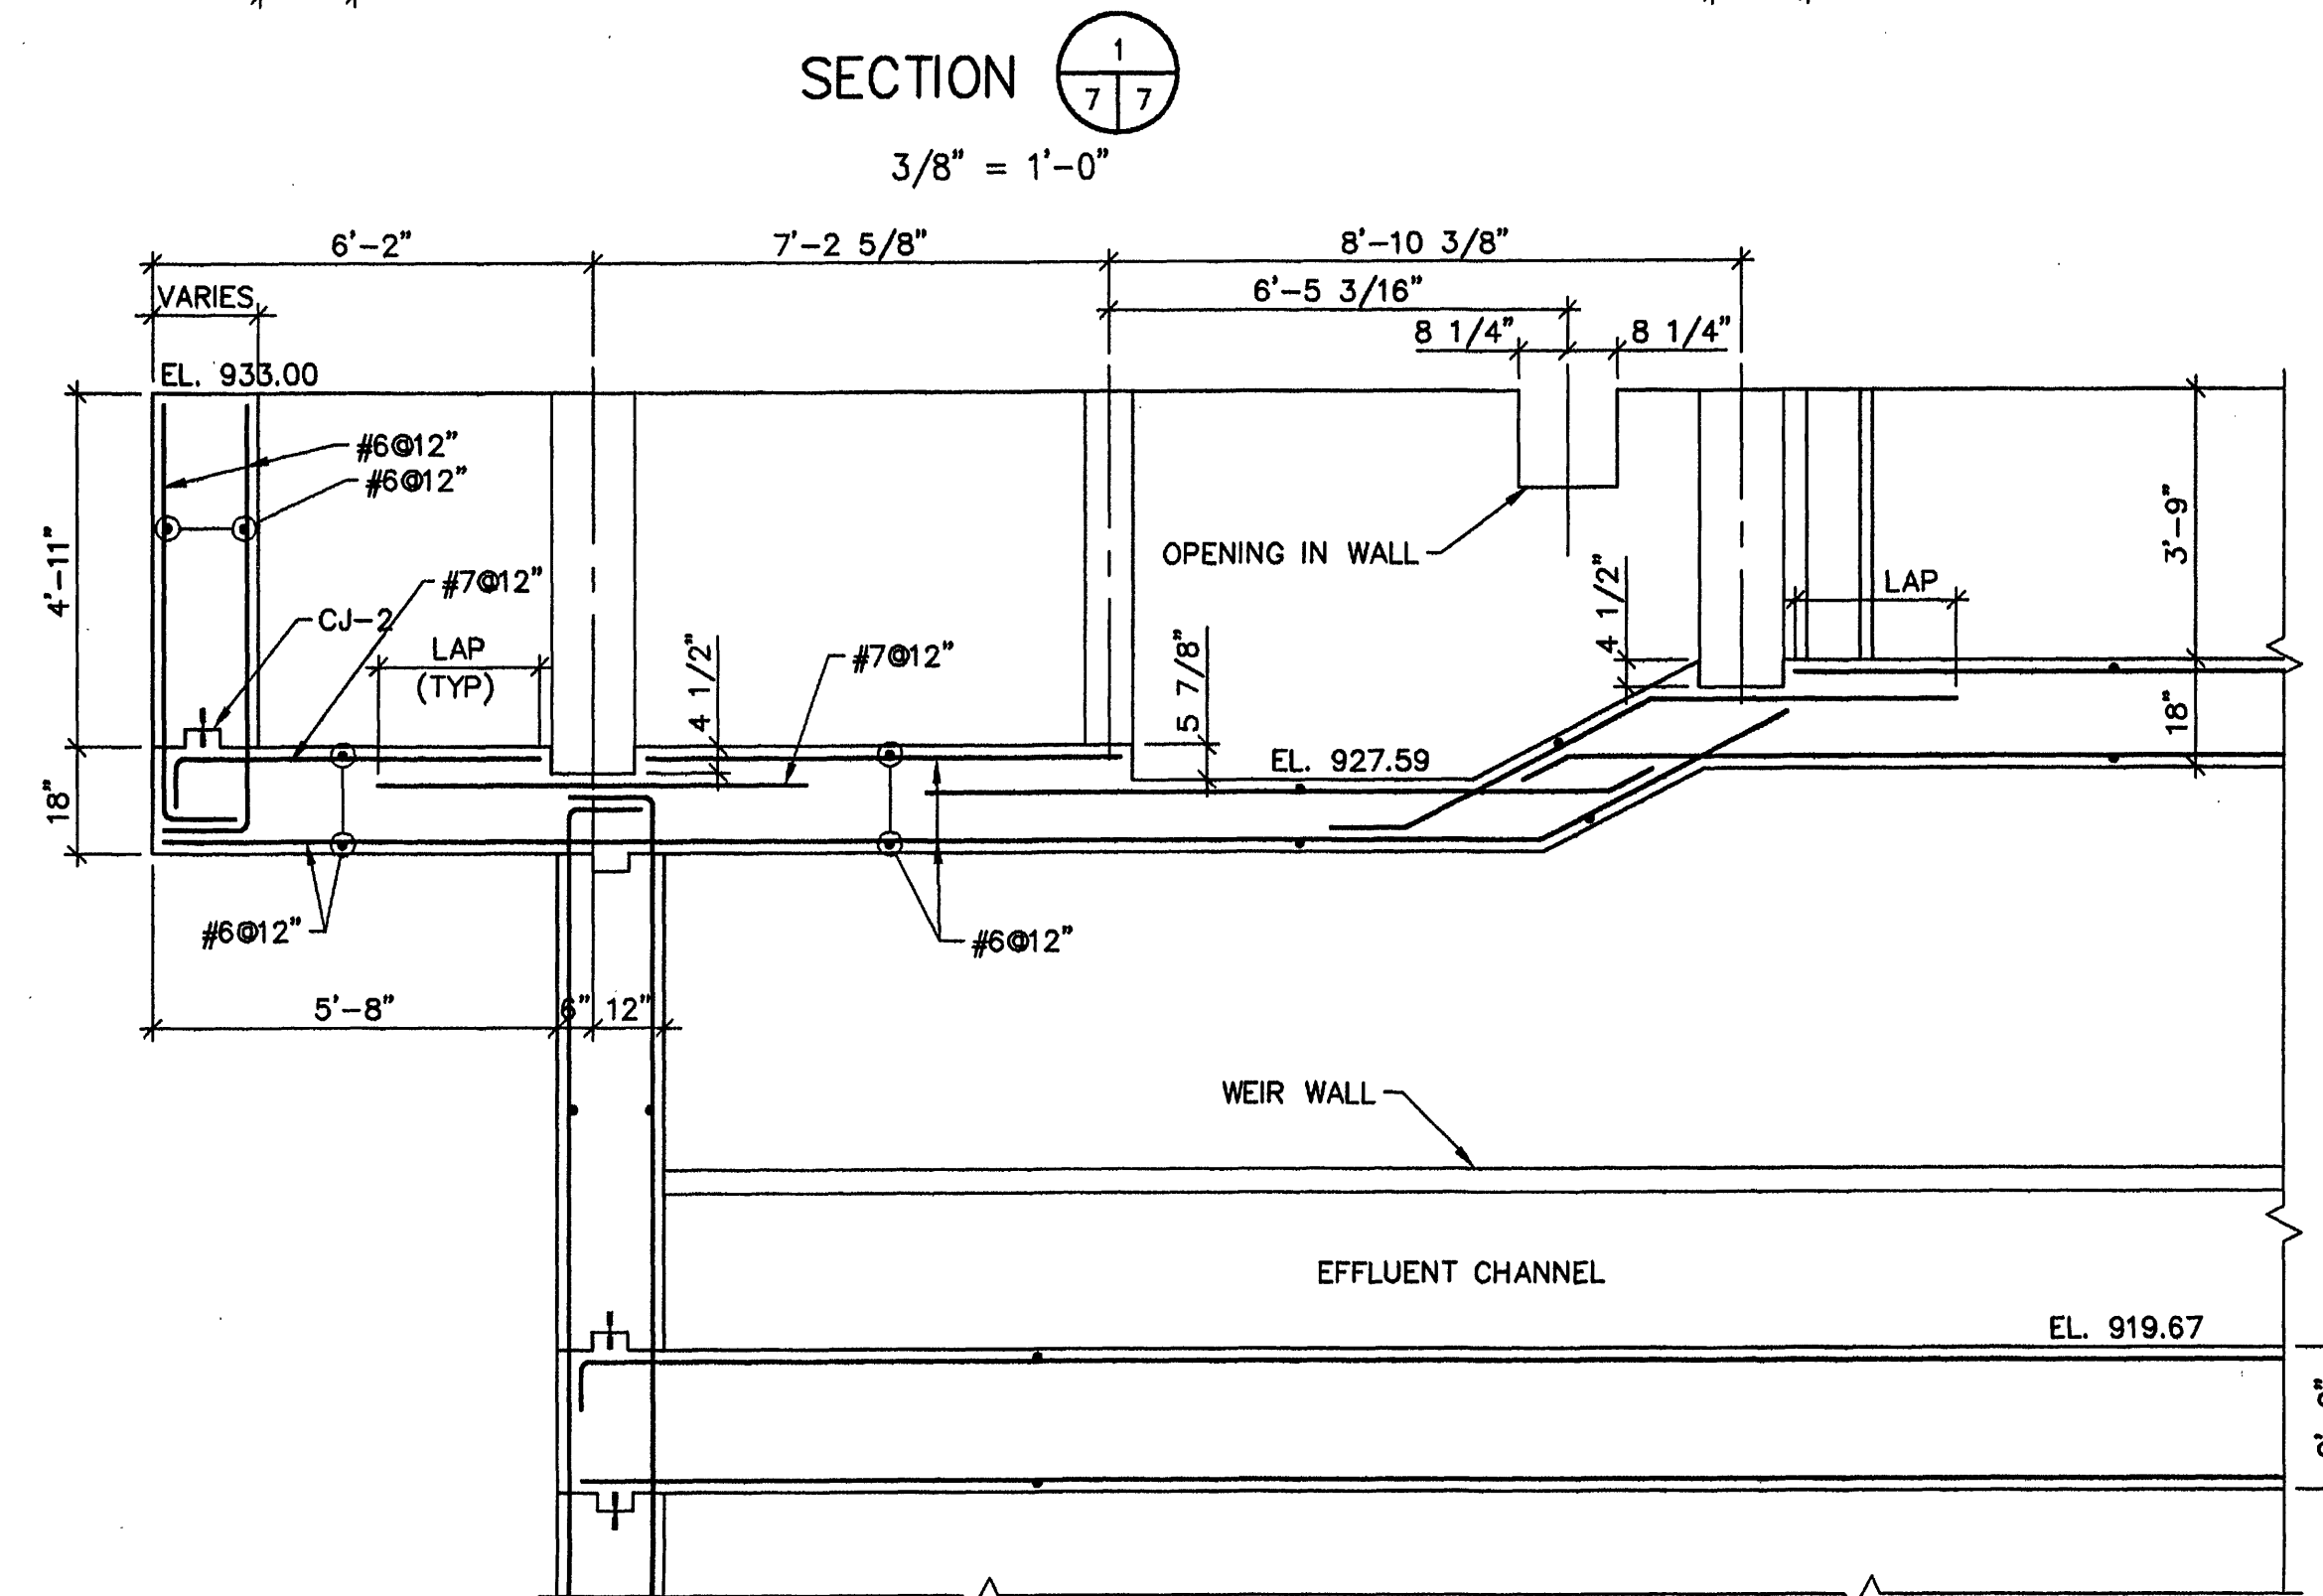

SECTION 2/7/7
3/8" = 1'-0"

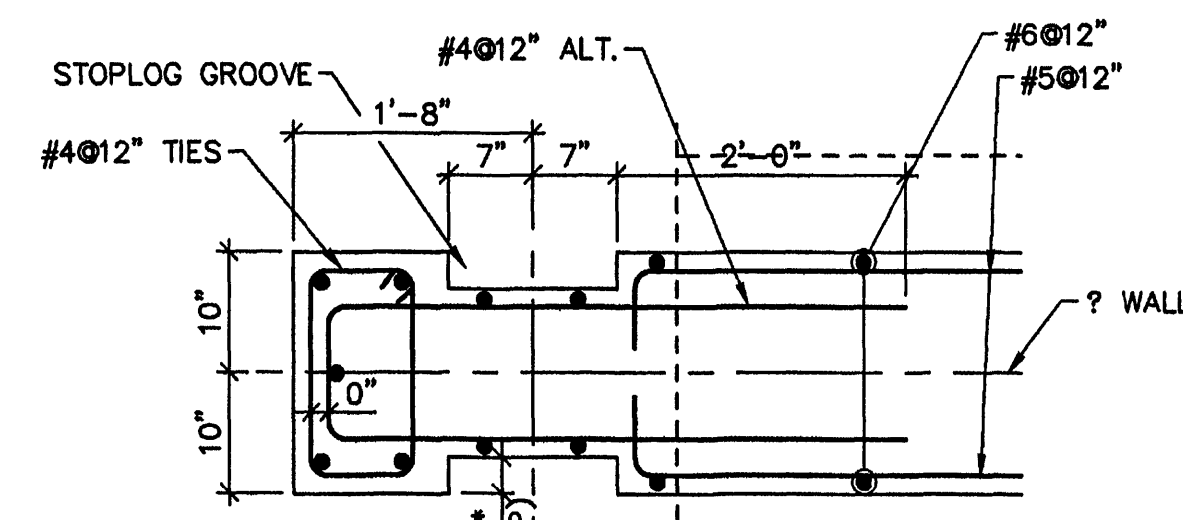

DETAIL 1/7/7
3/4"=1'-0"

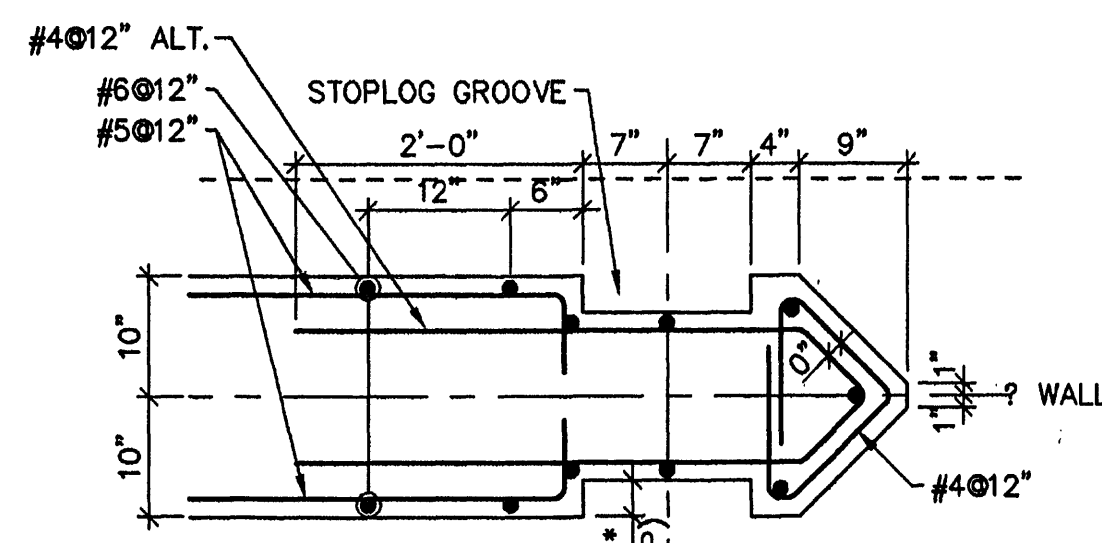

DETAIL 2/7/7
3/4"=1'-0"

GENERAL NOTE:

NOT ALL BAF EQUIPMENT, PIPING, VALVES AND APPURTENANCES ARE SHOWN.
SEE SPECIFICATIONS AND BAF MANUFACTURER'S SHOP DRAWINGS FOR ADDITIONAL
ITEMS AND SCOPE OF EQUIPMENT, PIPING, VALVES AND APPURTENANCES
SUPPLIED TO THE CONTRACTOR BY THE BAF MANUFACTURER.

NOTES:

1. ALL VERTICAL BARS SHOWN ARE #6
2. ASTERISK (*) INDICATES DIMENSIONS TO BE VERIFIED WITH EQUIPMENT

**MALCOLM
PIRNIE**
11832 Rock Landing Drive, Suite 400
Newport News, Virginia 23606

REVISIONS				REMARKS
NO.	BY	DATE	REVISION	
1	ARB	JAN. 2000	RECORD DRAWING	

DES ---MMZ---
DWN ---CBM---
CKD ---DB---



CITY OF ROANOKE, VIRGINIA
WATER POLLUTION
CONTROL PLANT
UPGRADE AND EXPANSION

BIOLOGICAL AERATED FILTER
PARTIAL PLANS &
SECTIONS
AS NOTED

COPYRIGHT © 1997
MALCOLM PIRNIE, INC.
DATE ---MAY 1997---
S SHEET 7 OF 44
CAD REF. NO. 00600357