



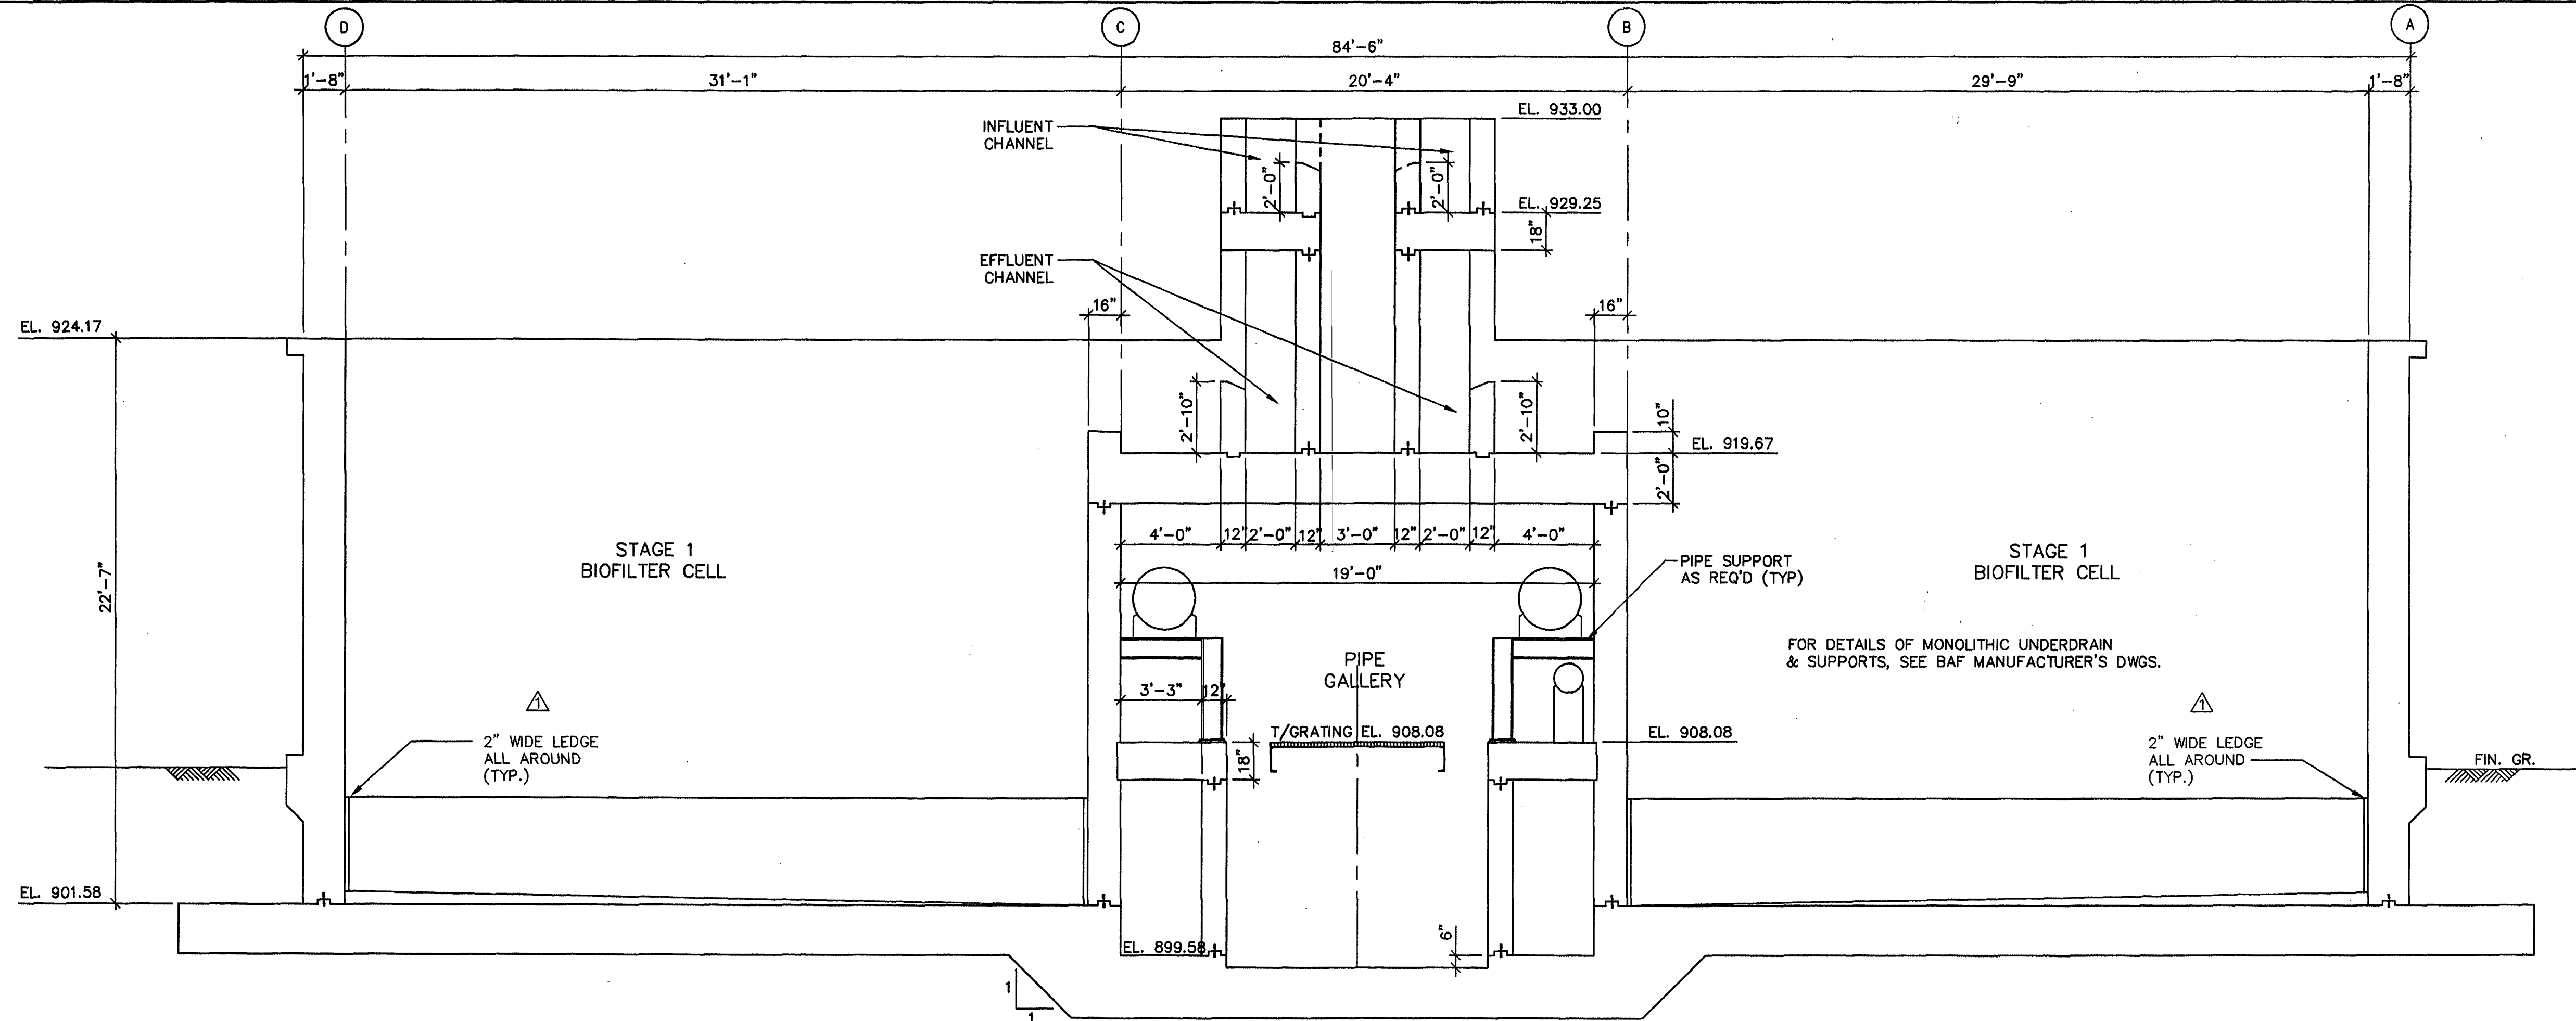

SECTION 1
2 8

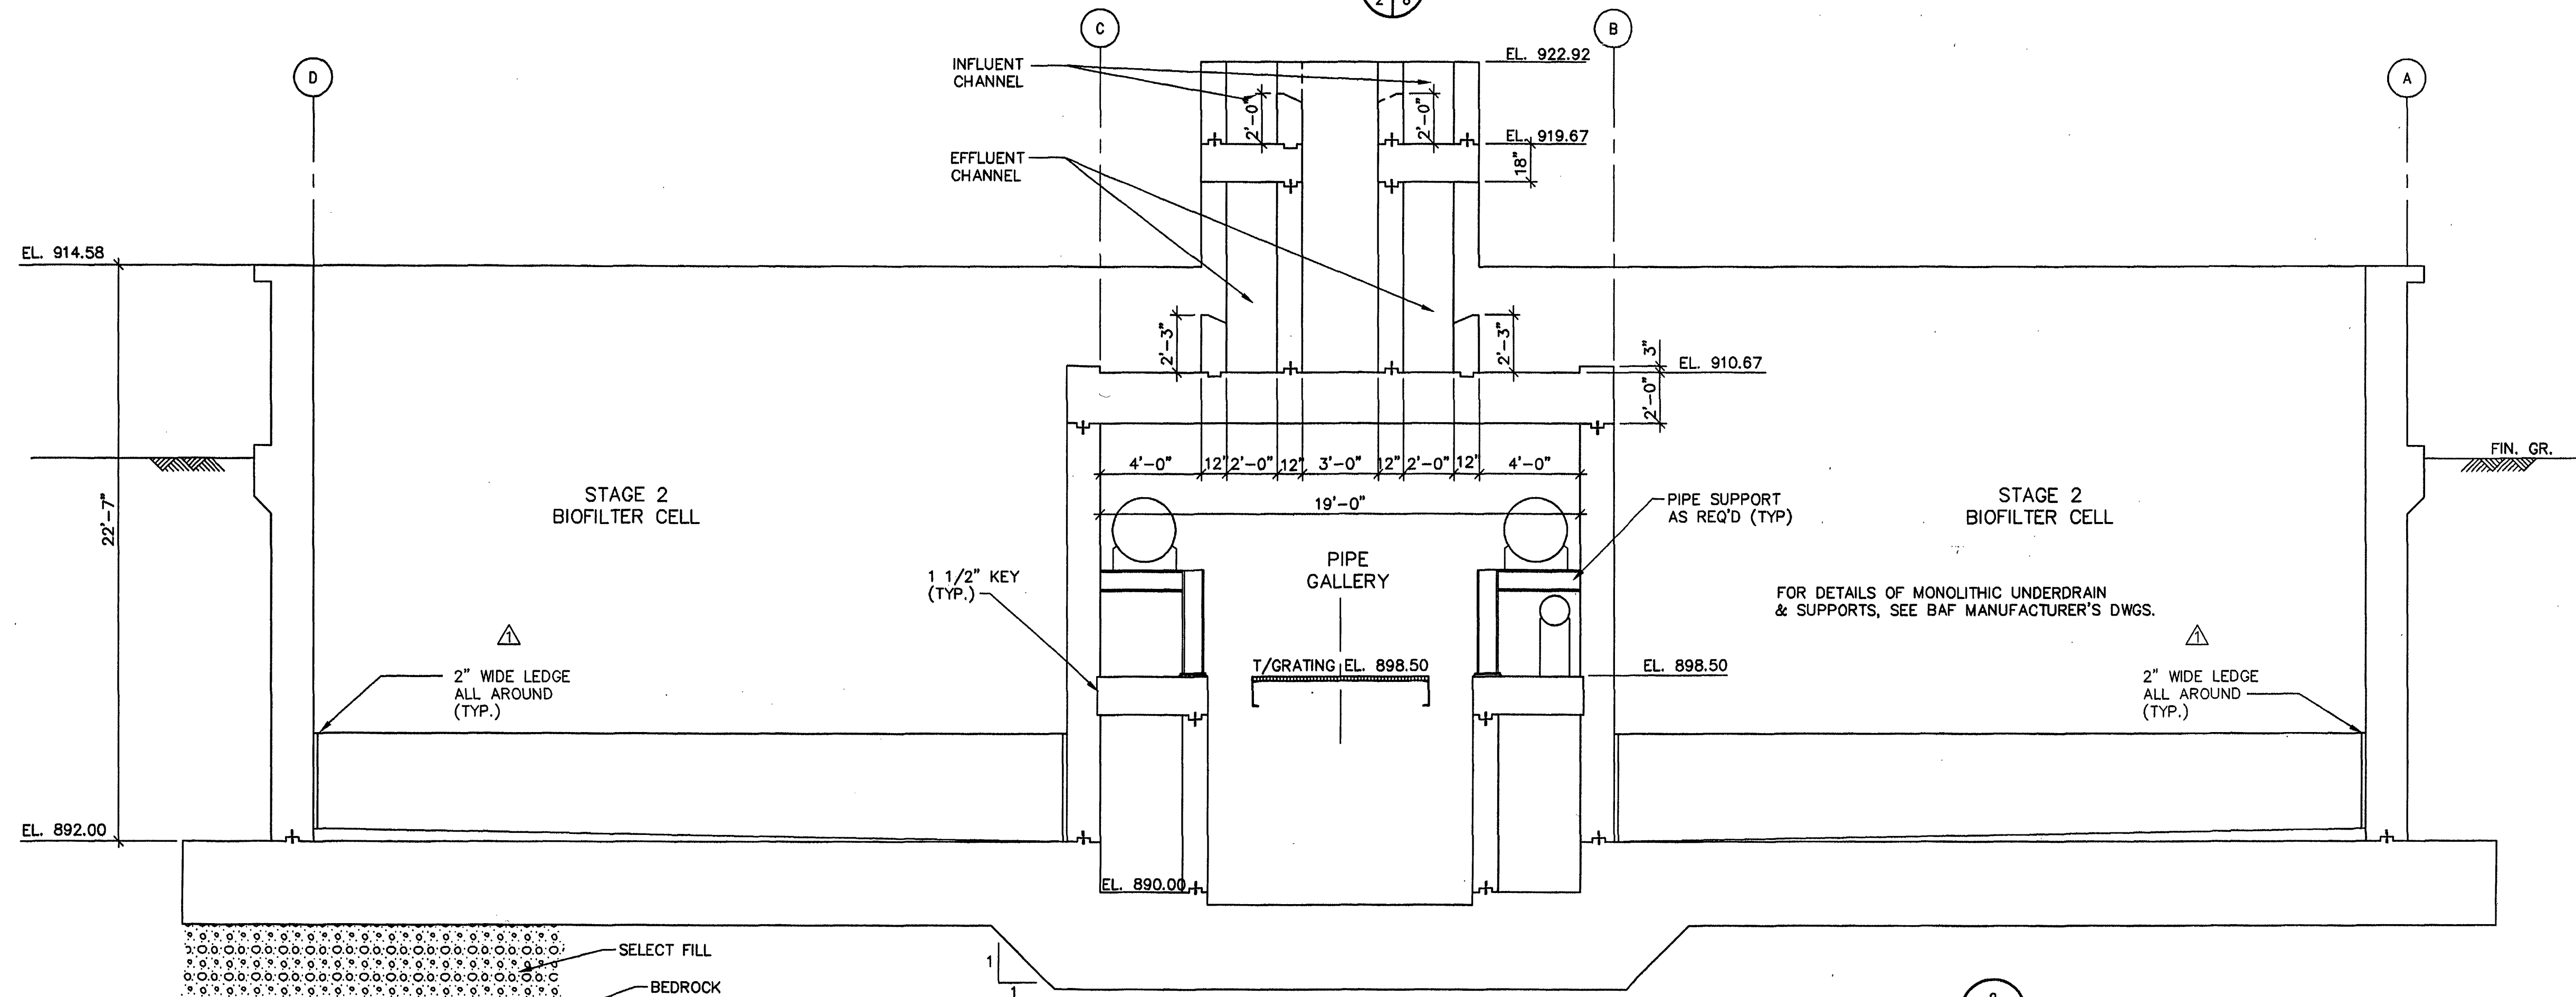

SECTION 2
2 8

GENERAL NOTE:

NOT ALL BAF EQUIPMENT, PIPING, VALVES AND APPURTENANCES ARE SHOWN. SEE SPECIFICATIONS AND BAF MANUFACTURER'S SHOP DRAWINGS FOR ADDITIONAL ITEMS AND SCOPE OF EQUIPMENT, PIPING, VALVES AND APPURTENANCES SUPPLIED TO THE CONTRACTOR BY THE BAF MANUFACTURER.

NOTE: LOCATION OF BEDROCK IS NOT TO SCALE.

**MALCOLM
PIRNIE**

11892 Rock Landing Drive, Suite 400
Newport News, Virginia 23606

REVISIONS				REMARKS
NO.	BY	DATE		
1	ARB	JAN. 2000	RECORD DRAWING	

DES -- MZ --
DWN -- DRK --
CKD -- DB --



CITY OF ROANOKE, VIRGINIA
**WATER POLLUTION
CONTROL PLANT
UPGRADE AND EXPANSION**

**BIOLOGICAL AERATED FILTER
SECTIONS**

1/4" = 1'-0"

COPYRIGHT © 1997
MALCOLM PIRNIE, INC.

DATE -- MAY 1997 --

S SHEET 8 OF 44

CAD REF. NO. 0060S358