




4873 2964003100 I: \ACAD\PROJ\00600285\00600359 Scale: 1:32 Date: 05/06/1997 Time: 13:22

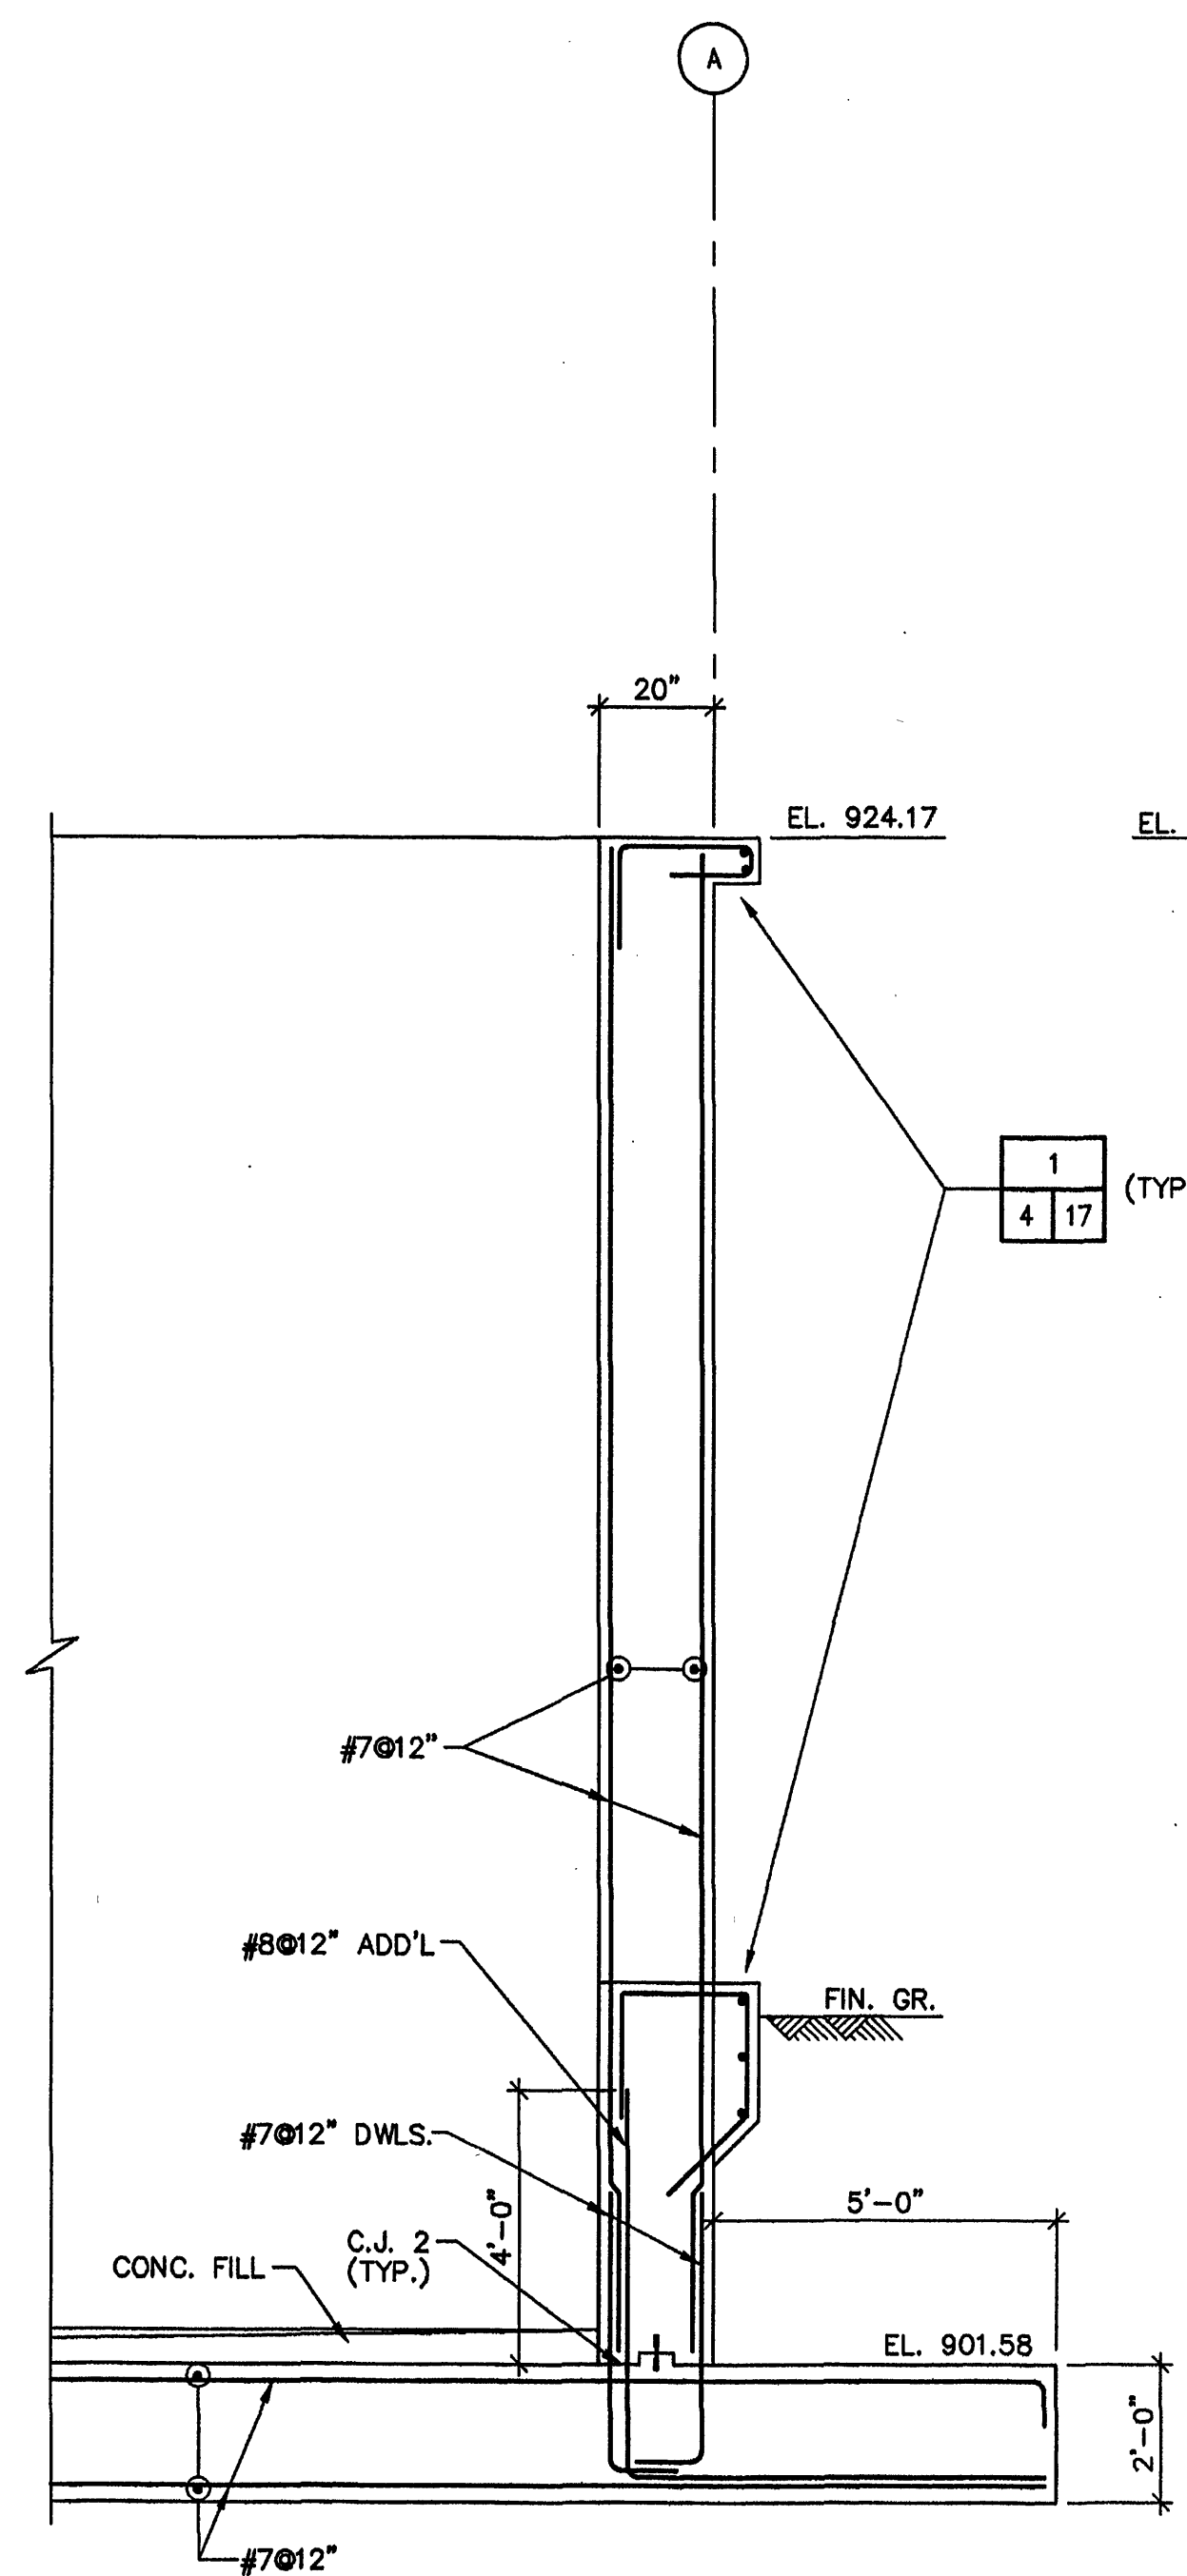


SECTION 1/2

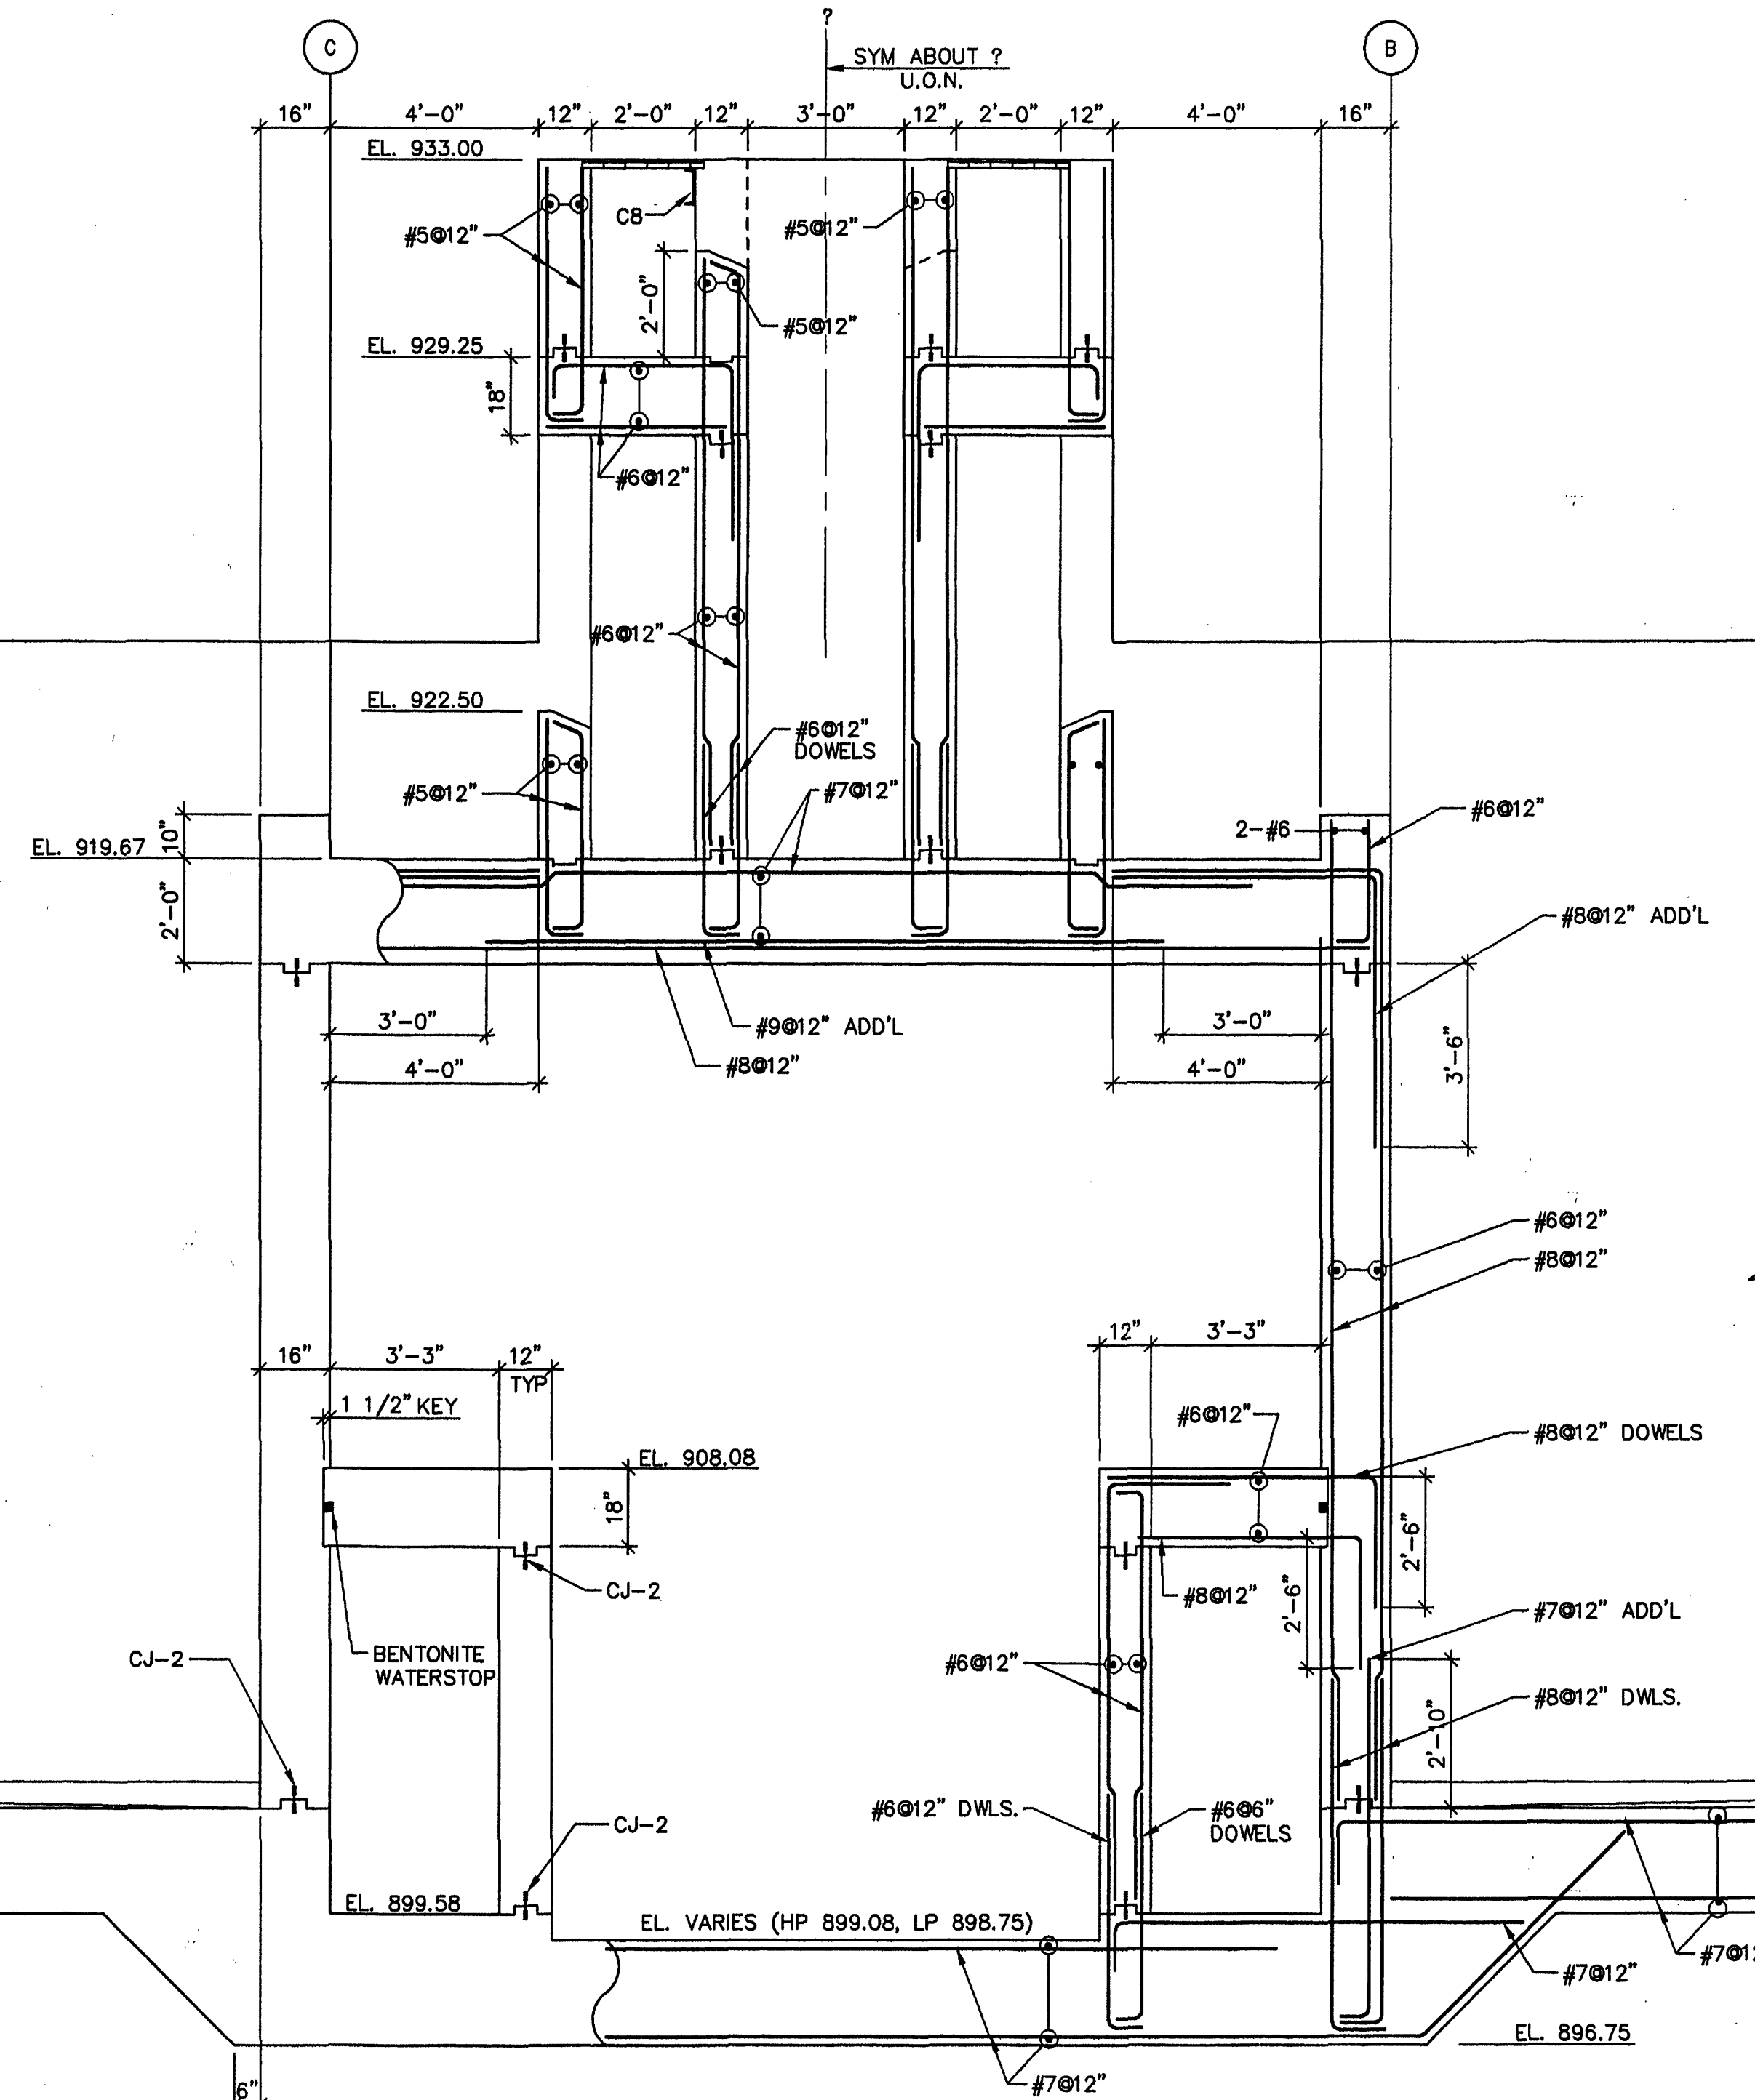

SECTION 2/2

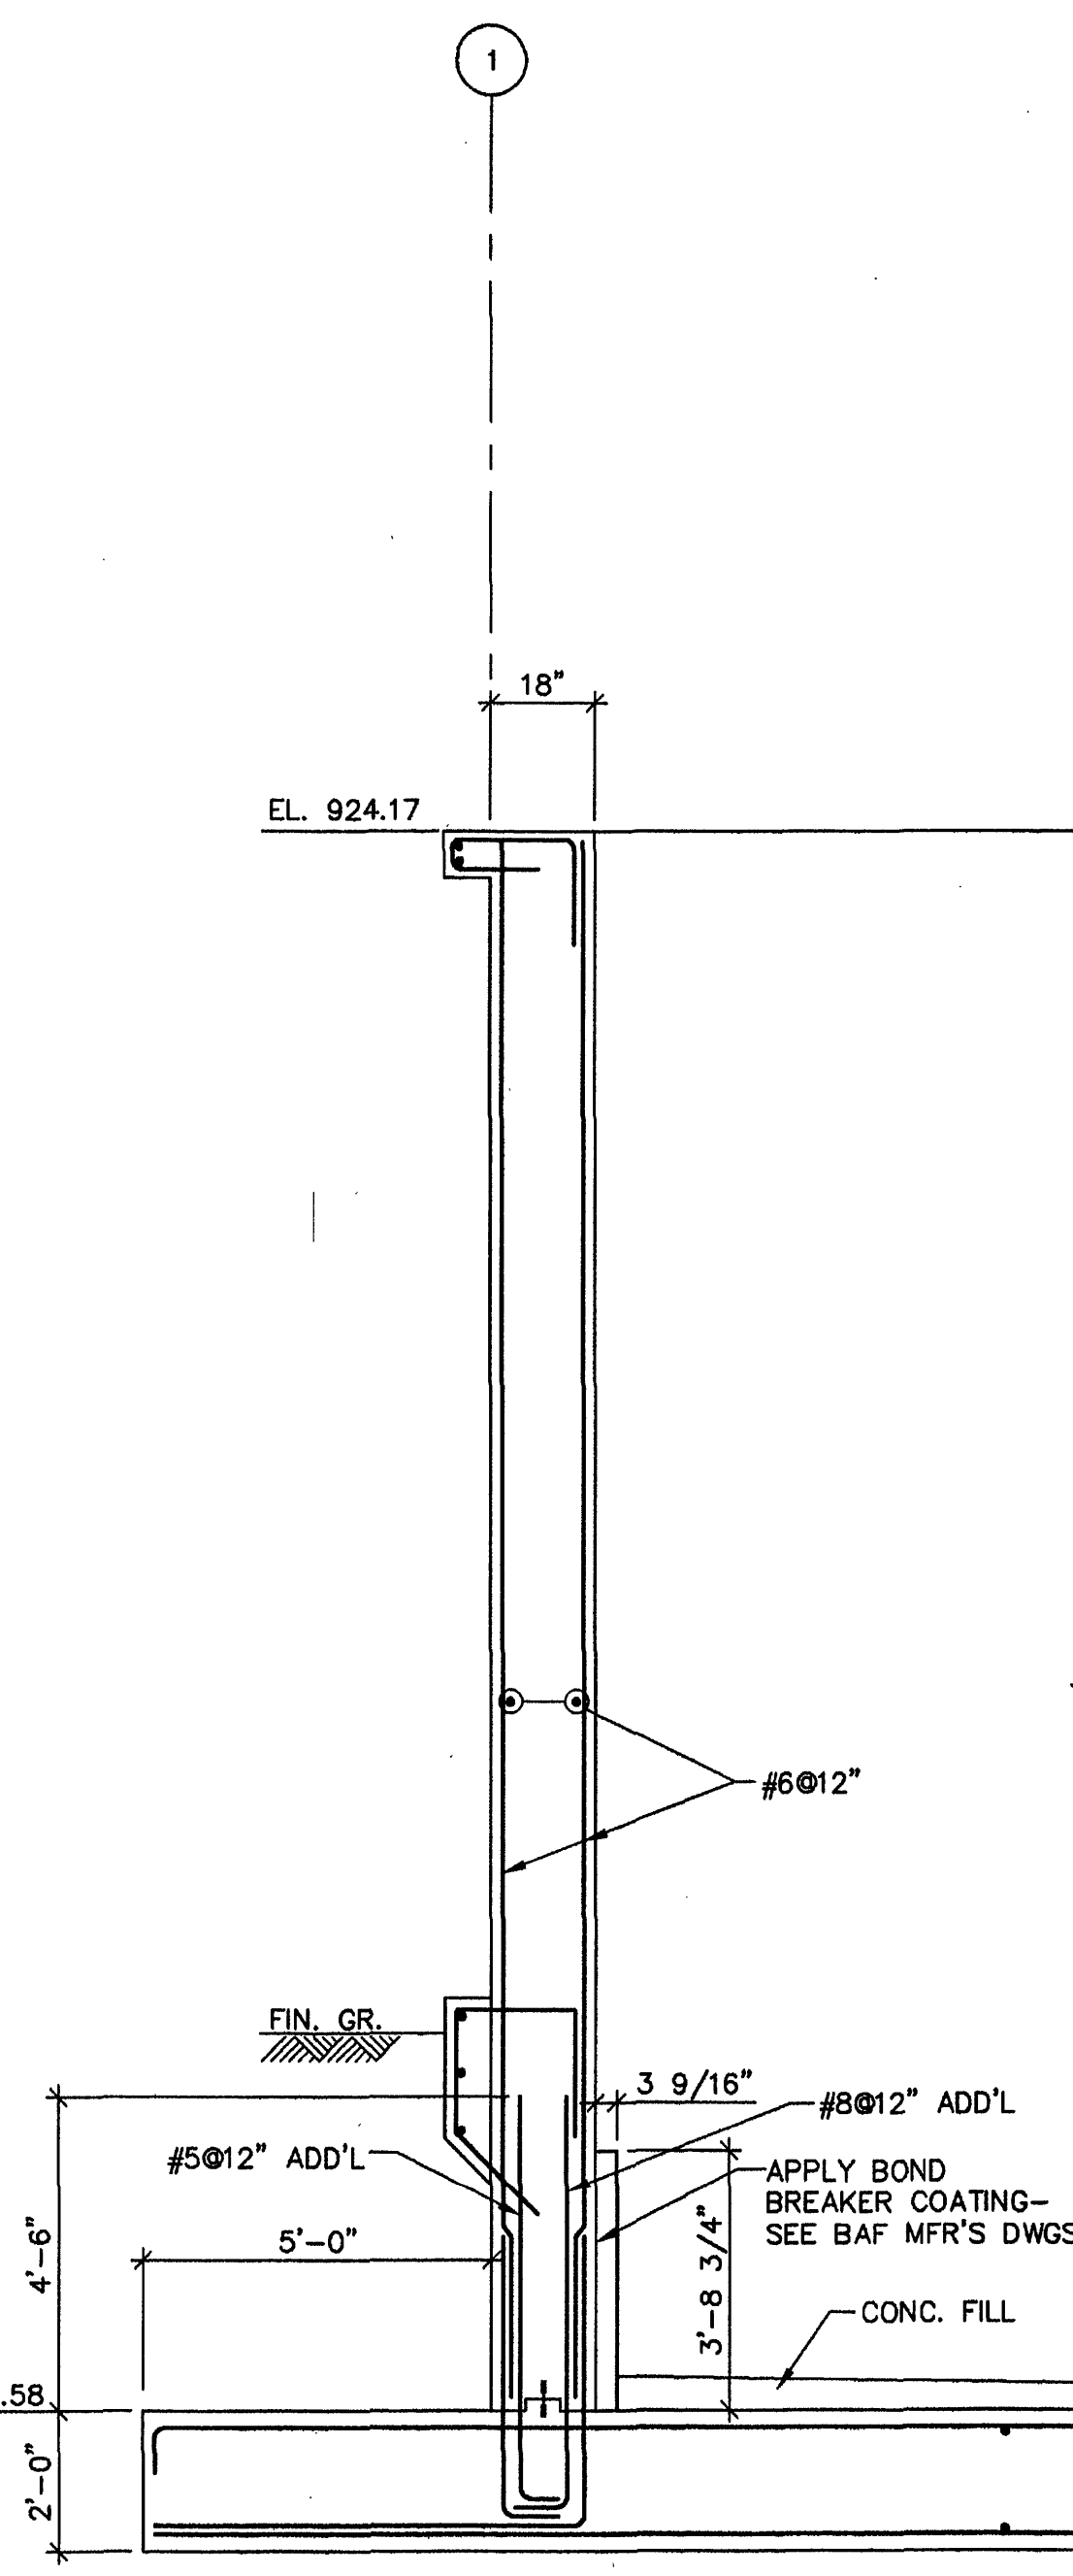


SECTION 3/2

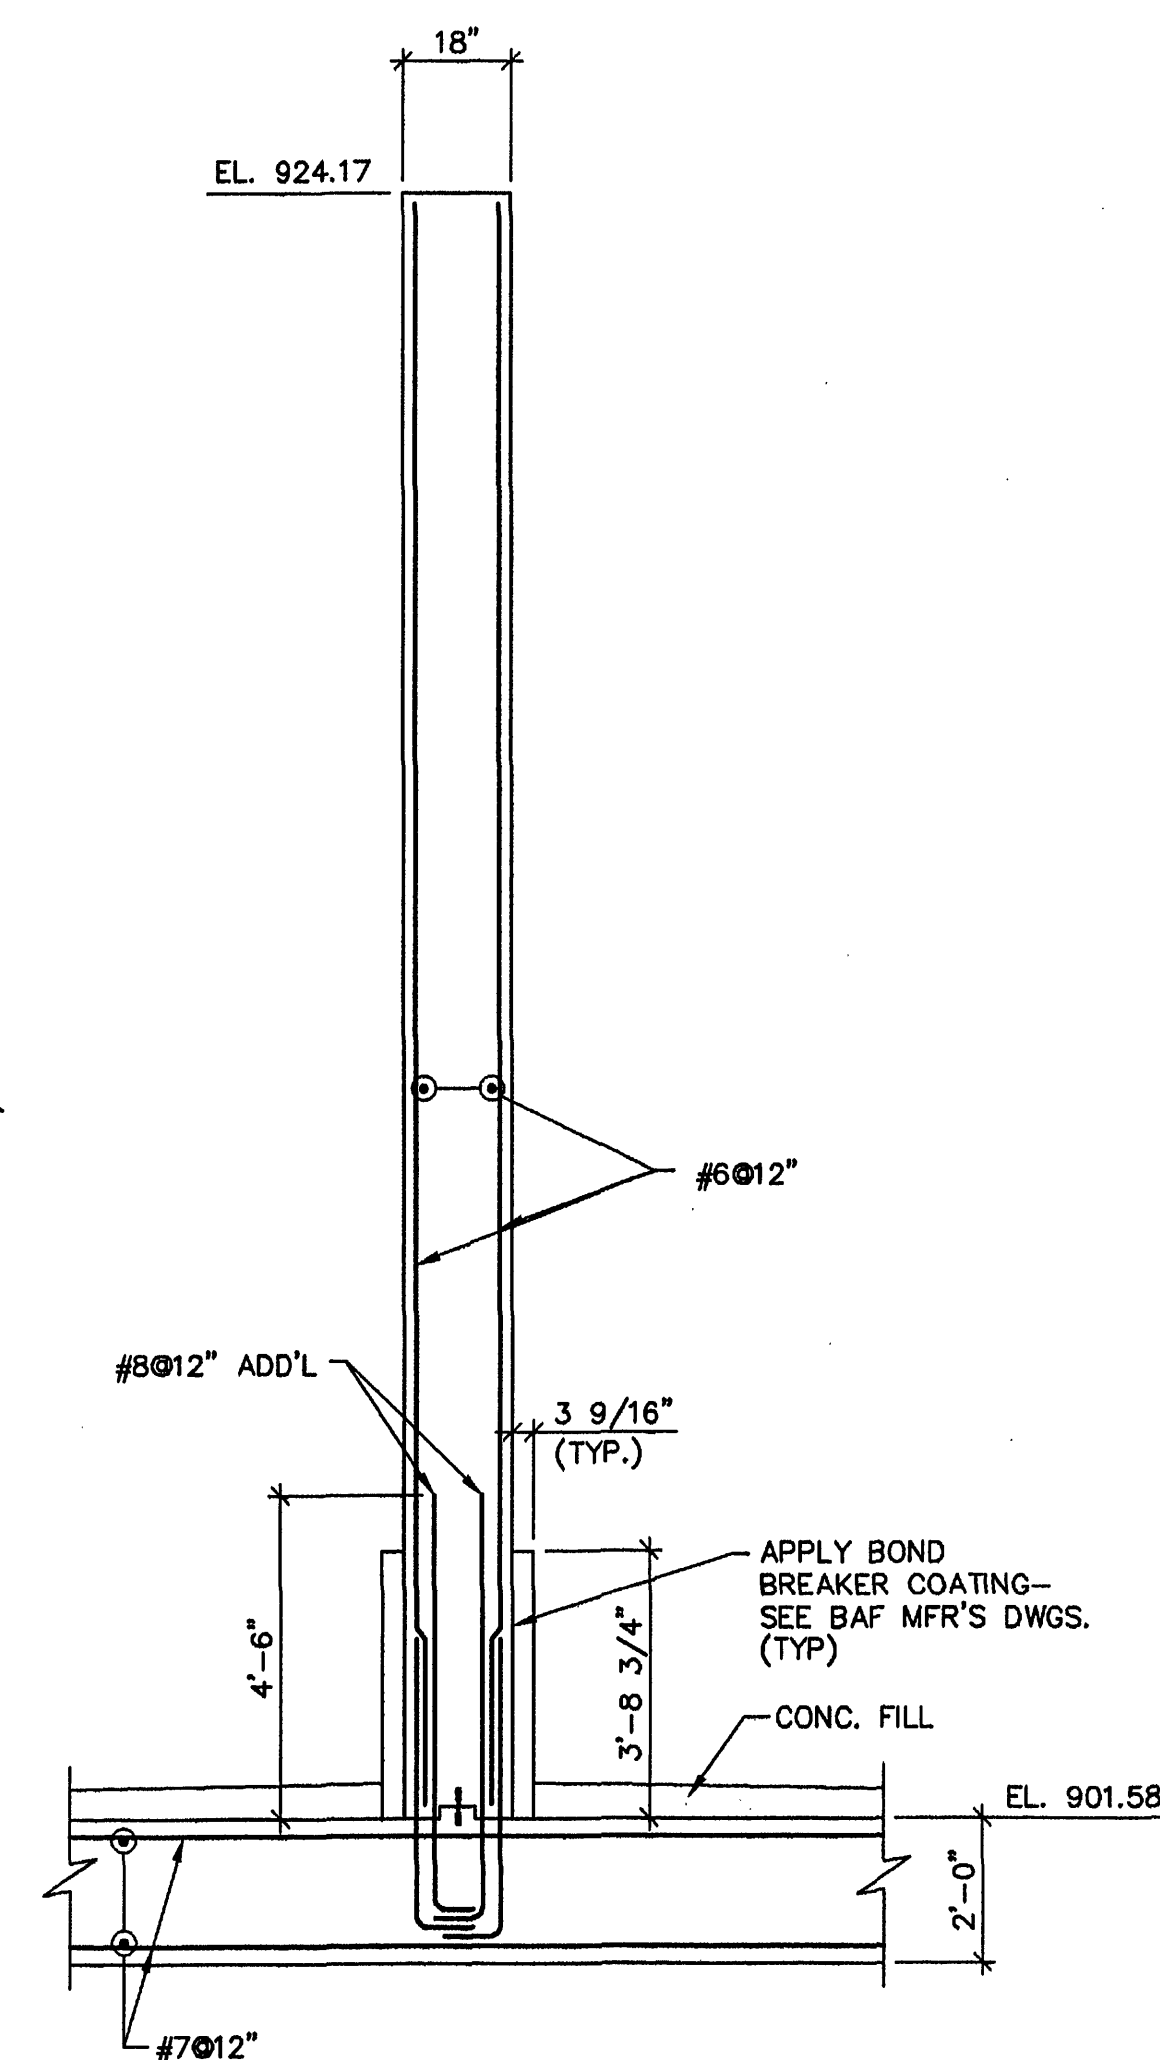

SECTION 4/2

GENERAL NOTE:

NOT ALL BAF EQUIPMENT, PIPING, VALVES AND APPURTENANCES ARE SHOWN. SEE SPECIFICATIONS AND BAF MANUFACTURER'S SHOP DRAWINGS FOR ADDITIONAL ITEMS AND SCOPE OF EQUIPMENT, PIPING, VALVES AND APPURTENANCES SUPPLIED TO THE CONTRACTOR BY THE BAF MANUFACTURER.

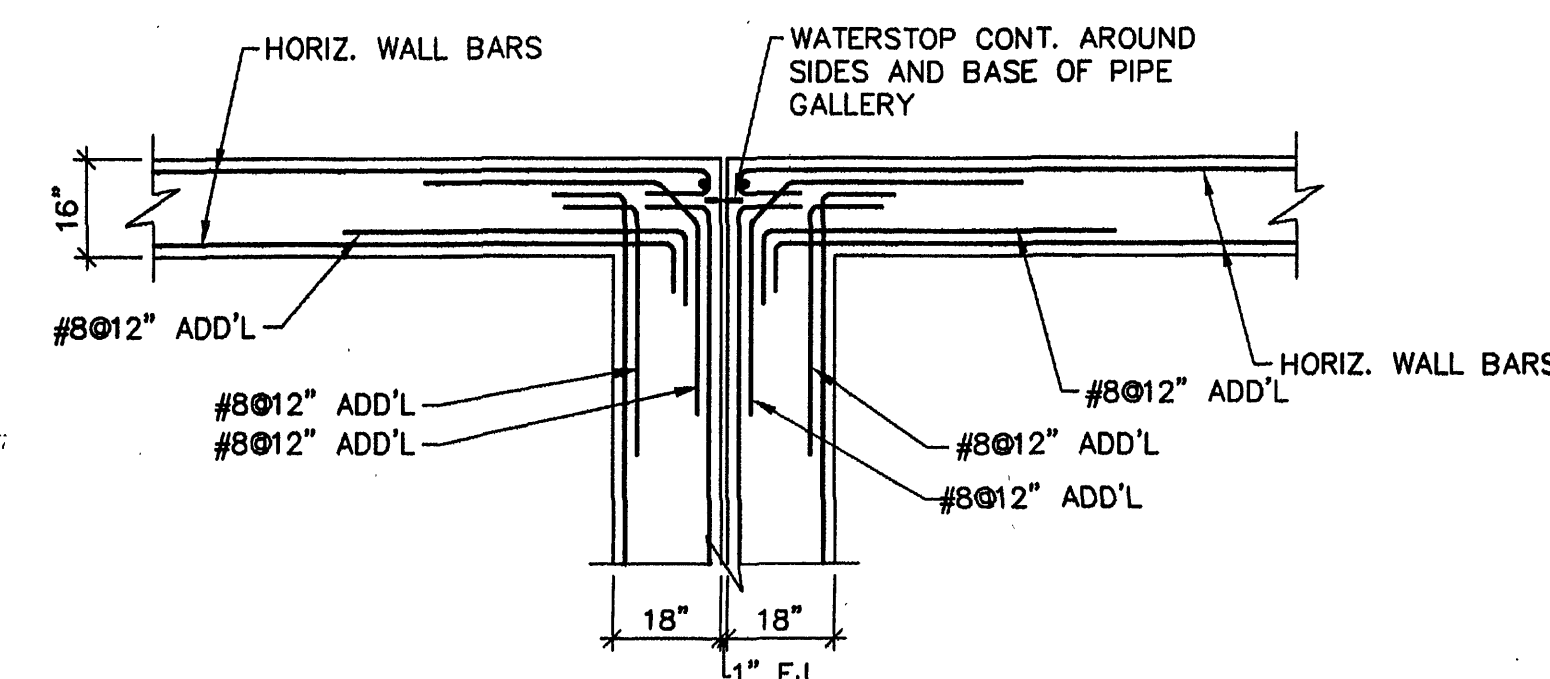

DETAIL 1/2

NOTE: MONOLITHIC UNDERDRAIN FLOOR AND SUPPORT STRUCTURES NOT SHOWN. SEE BAF MANUFACTURER'S DWGS.

MALCOLM PIRNIE
11832 Rock Landing Drive, Suite 400
Newport News, Virginia 23606

REVISIONS				REMARKS
NO.	BY	DATE	DESCRIPTION	
1	ARB	JAN. 2000	RECORD DRAWING	

DES --- MZ ---
DWN DRK/CBM
CKD --- DB ---



CITY OF ROANOKE, VIRGINIA
WATER POLLUTION
CONTROL PLANT
UPGRADE AND EXPANSION

BIOLOGICAL AERATED FILTER
SECTIONS & DETAILS

3/8"=1'-0"

COPYRIGHT © 1997
MALCOLM PIRNIE, INC.
DATE --- MAY 1997 ---
S SHEET 9 OF 44
CAD REF. NO. 00600359