



4445 0060028505 I:\ACAD\PROJ\00600285\00600360 Scale: 1:32 Date: 05/01/1997 Time: 08:10

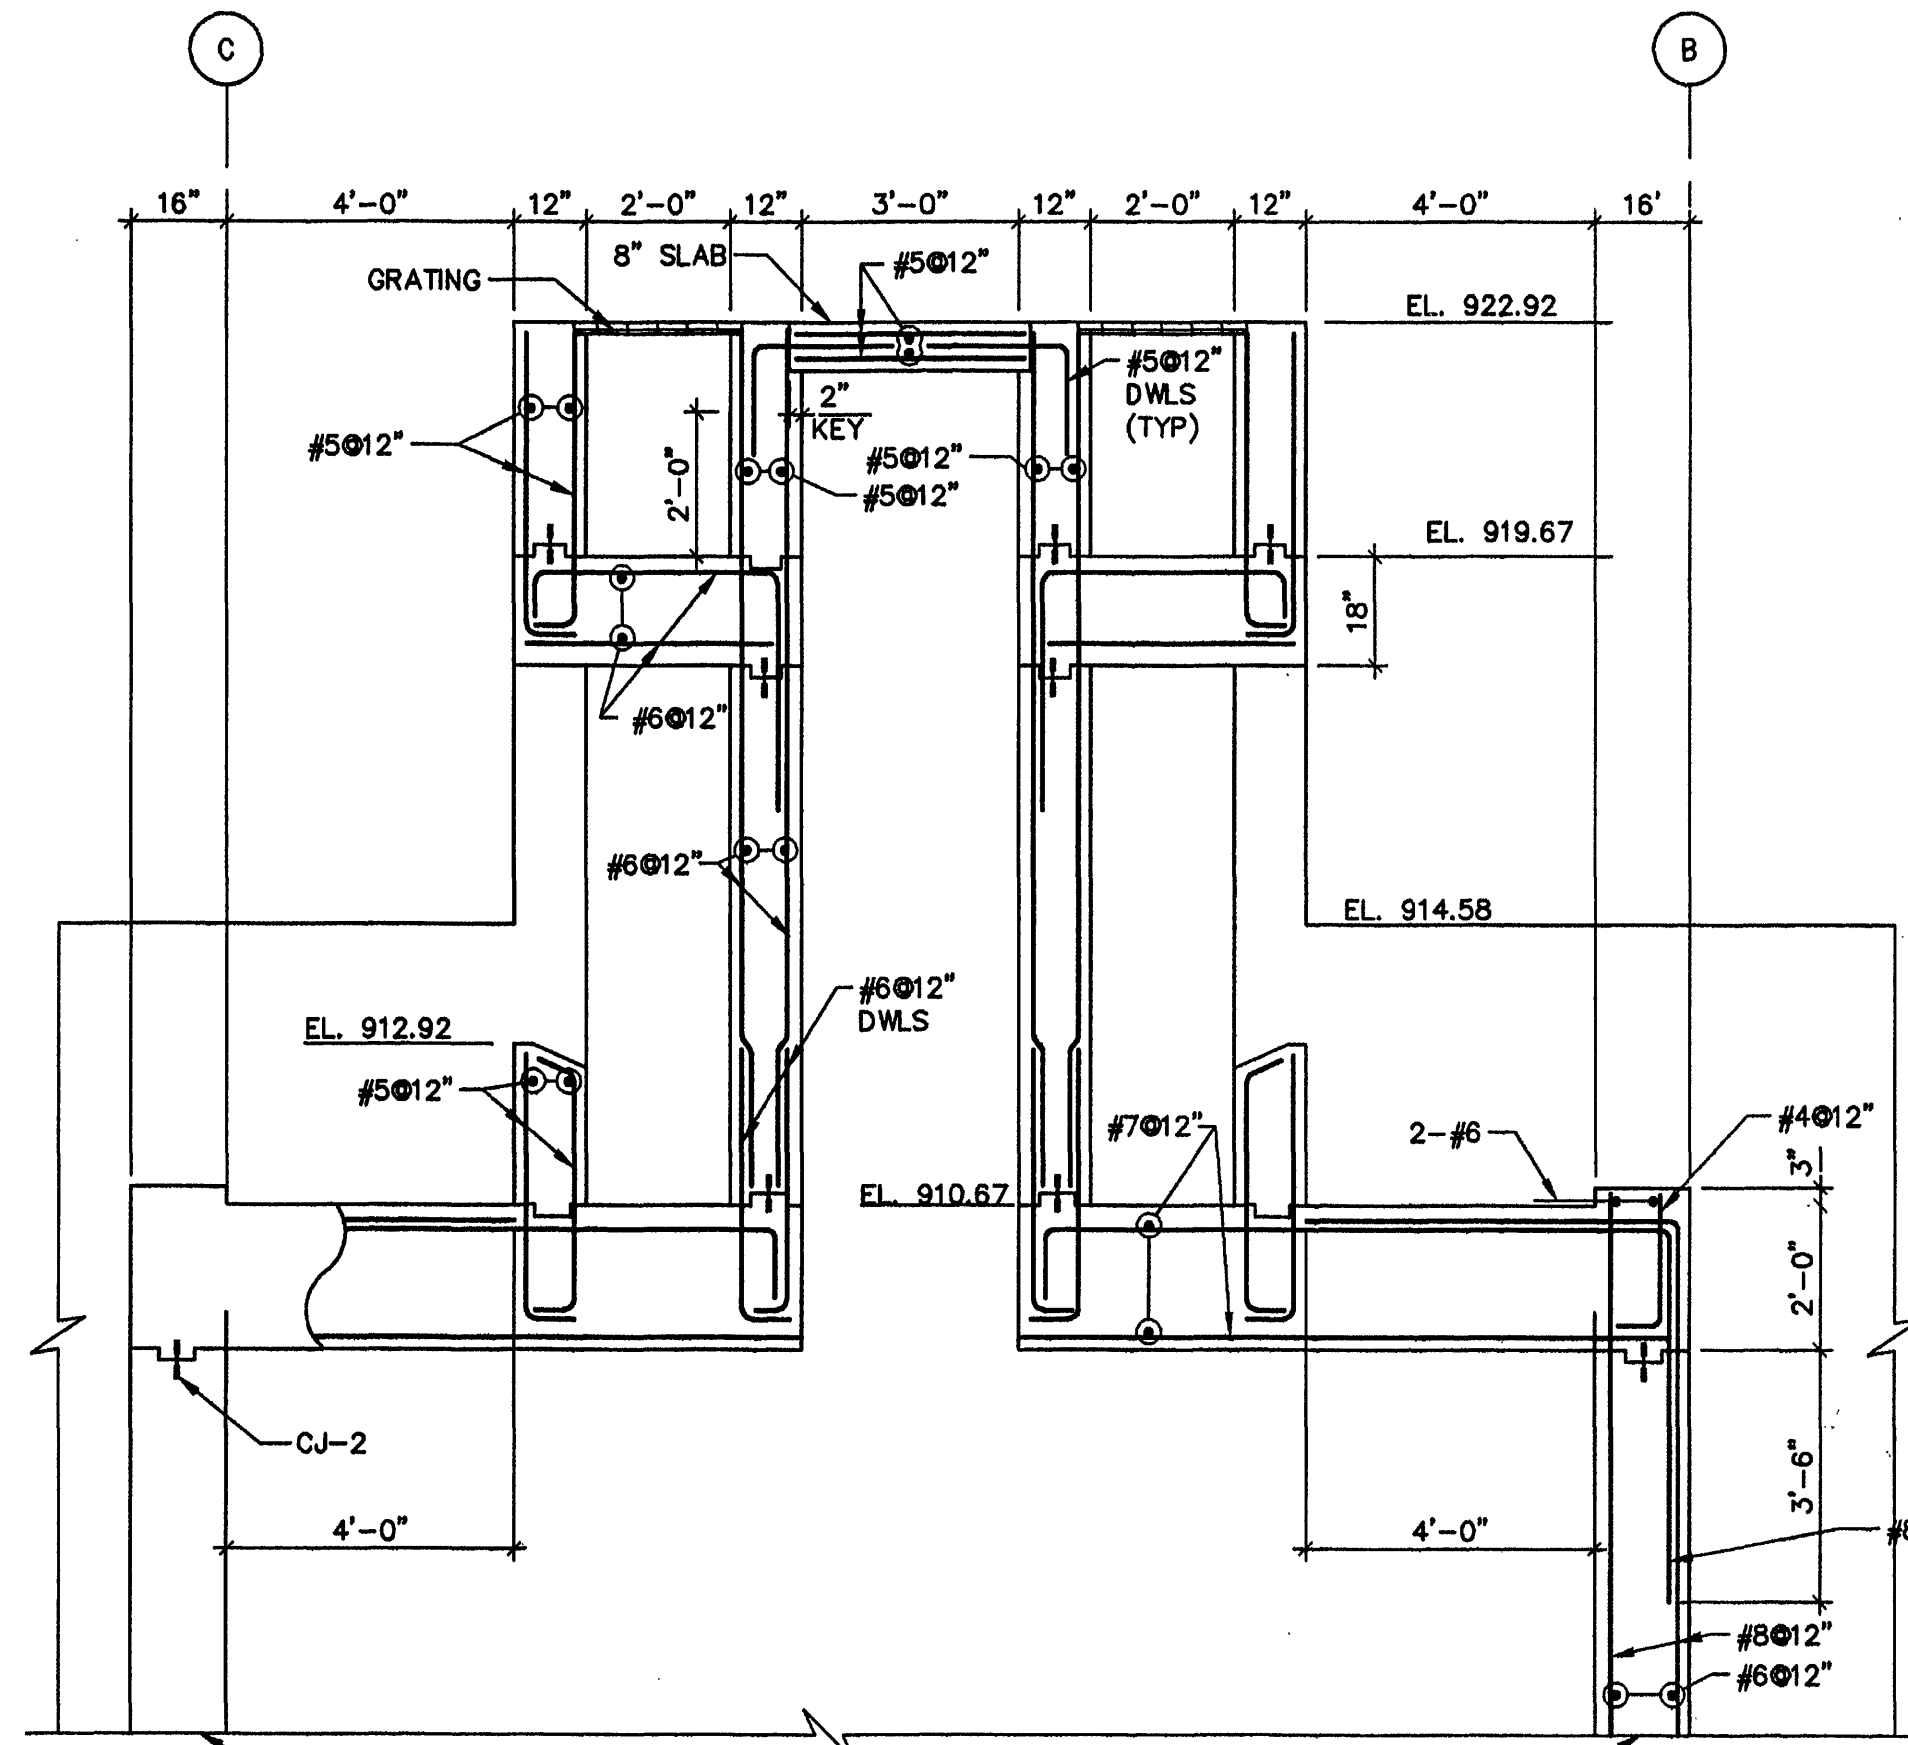


SECTION 1/4 10

FOR CONTINUATION, SEE SECTION 3/2 10

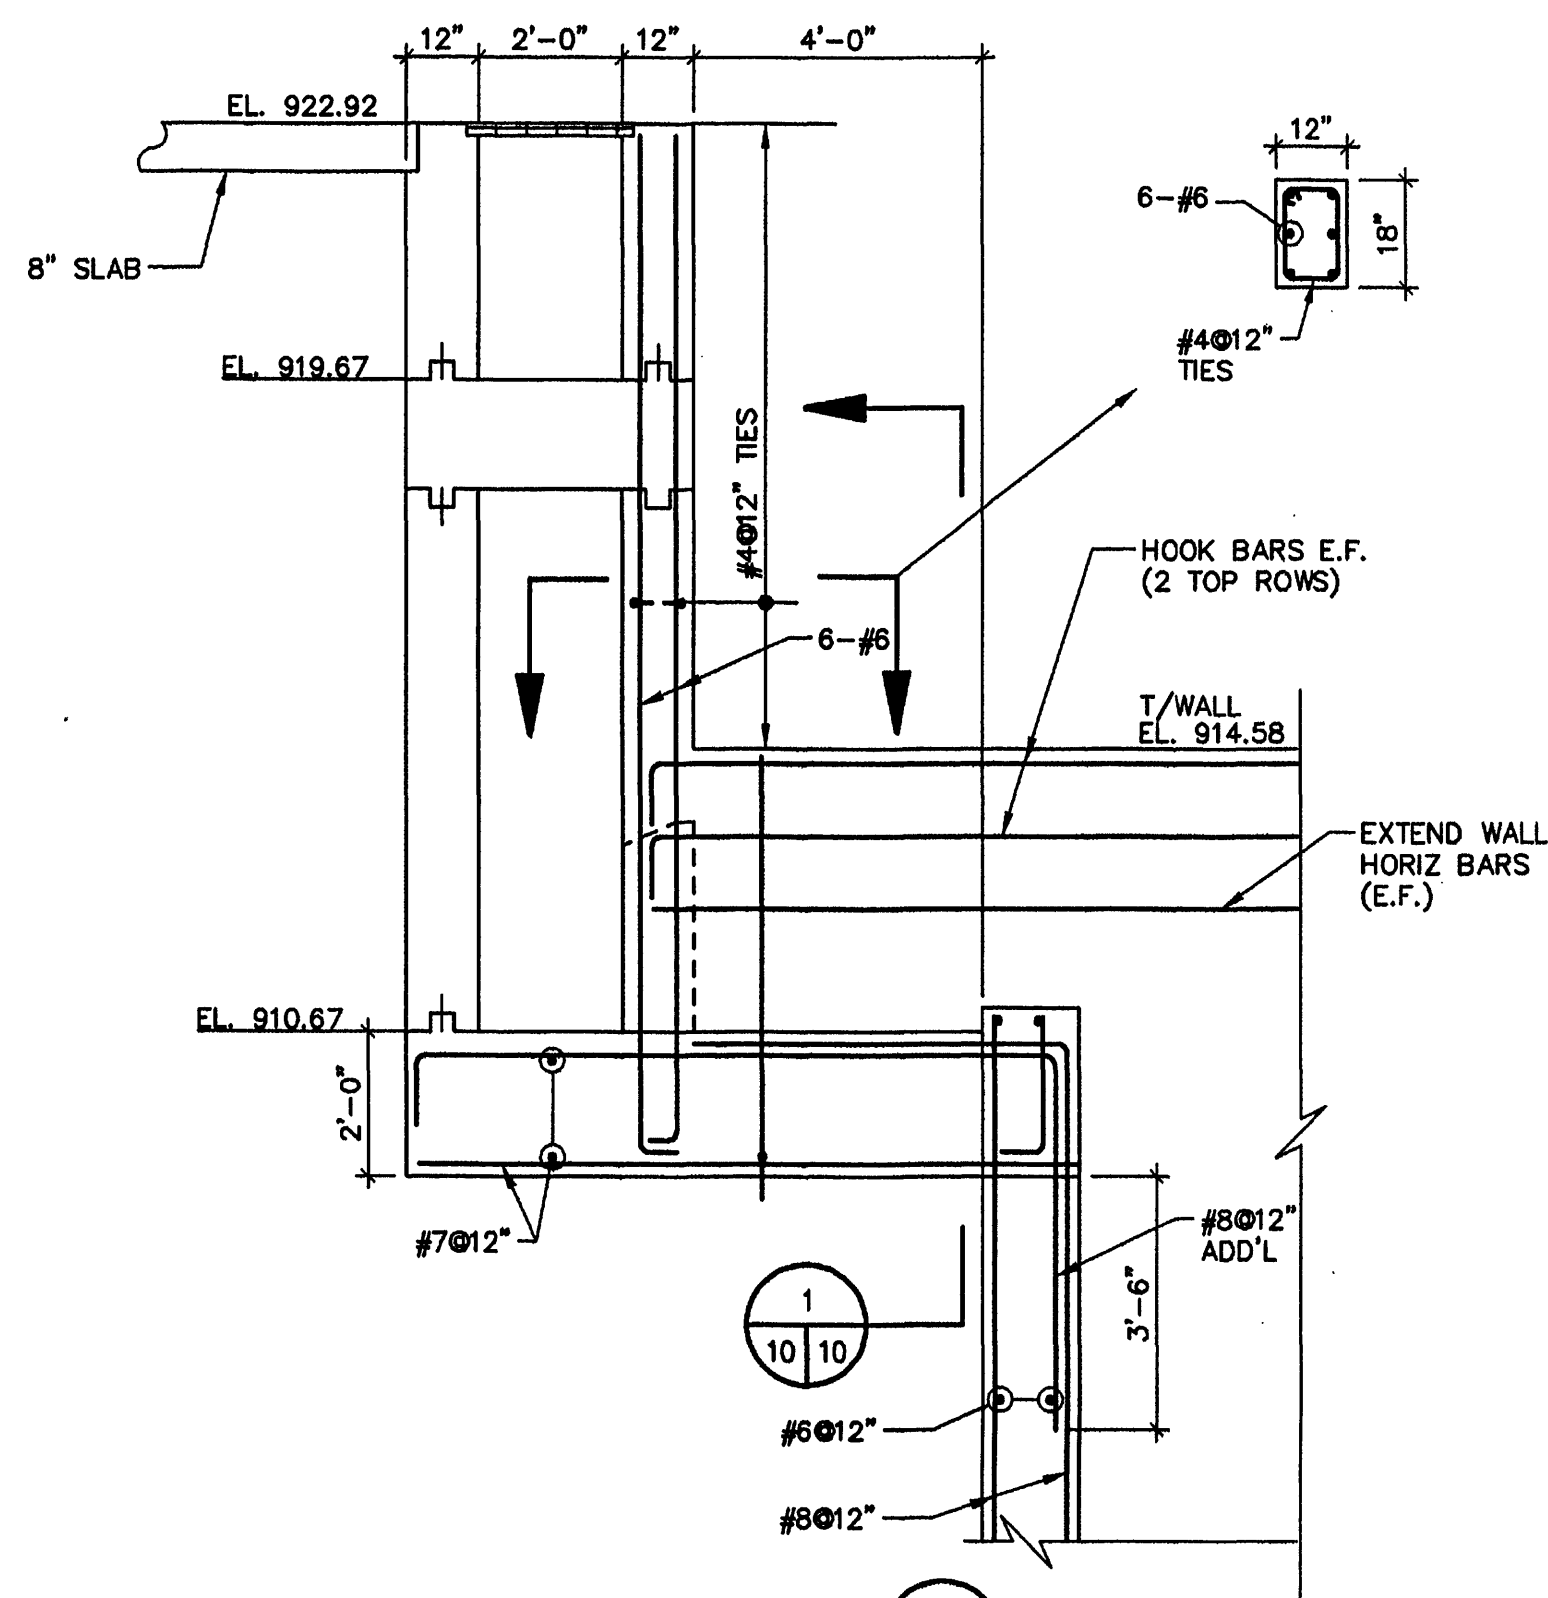


SECTION 3/4 19


SCALE: 3/8" = 1'-0"

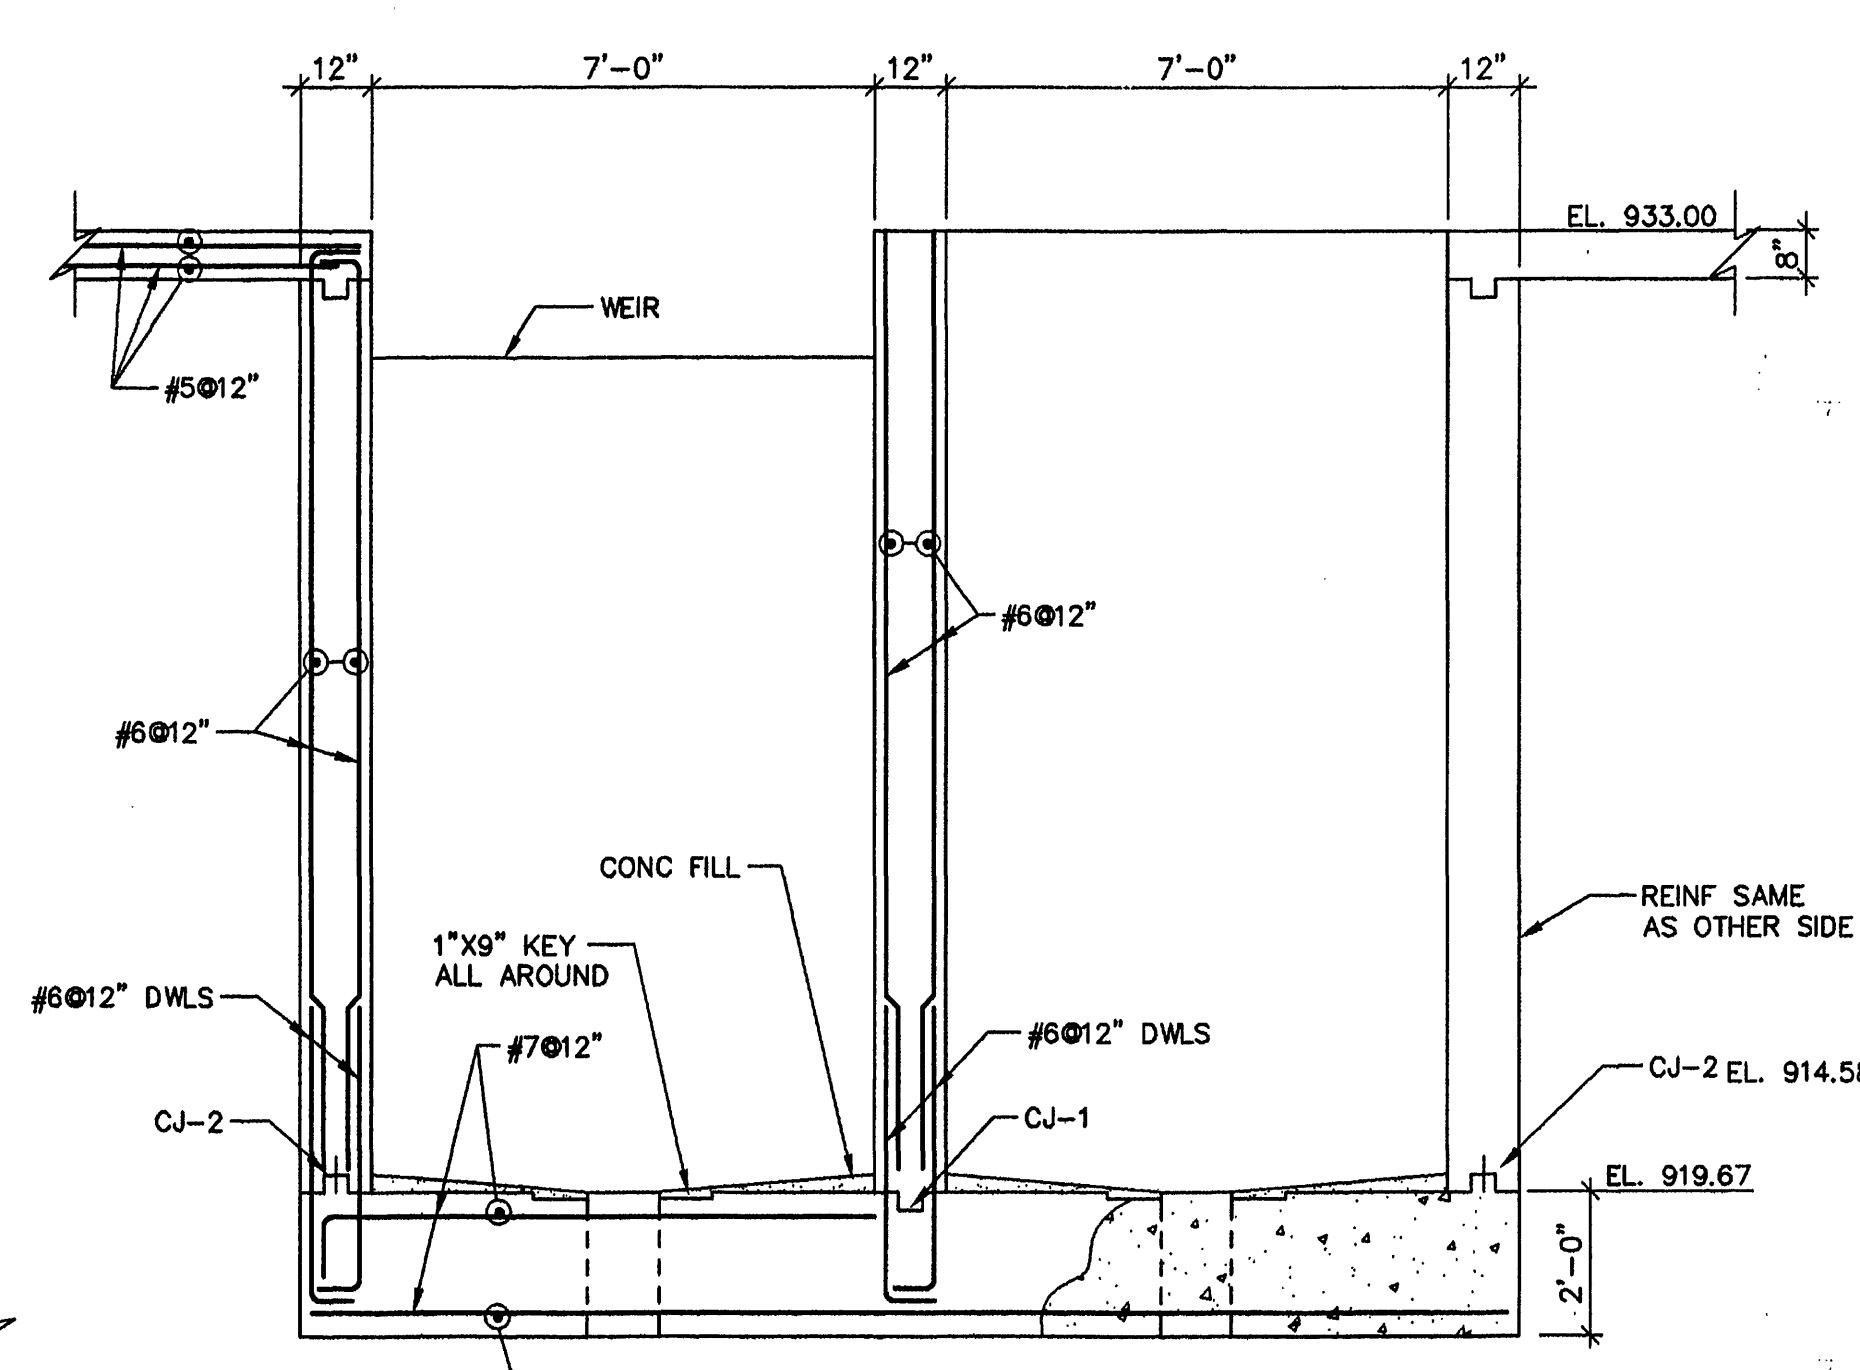


SECTION 2/4 10

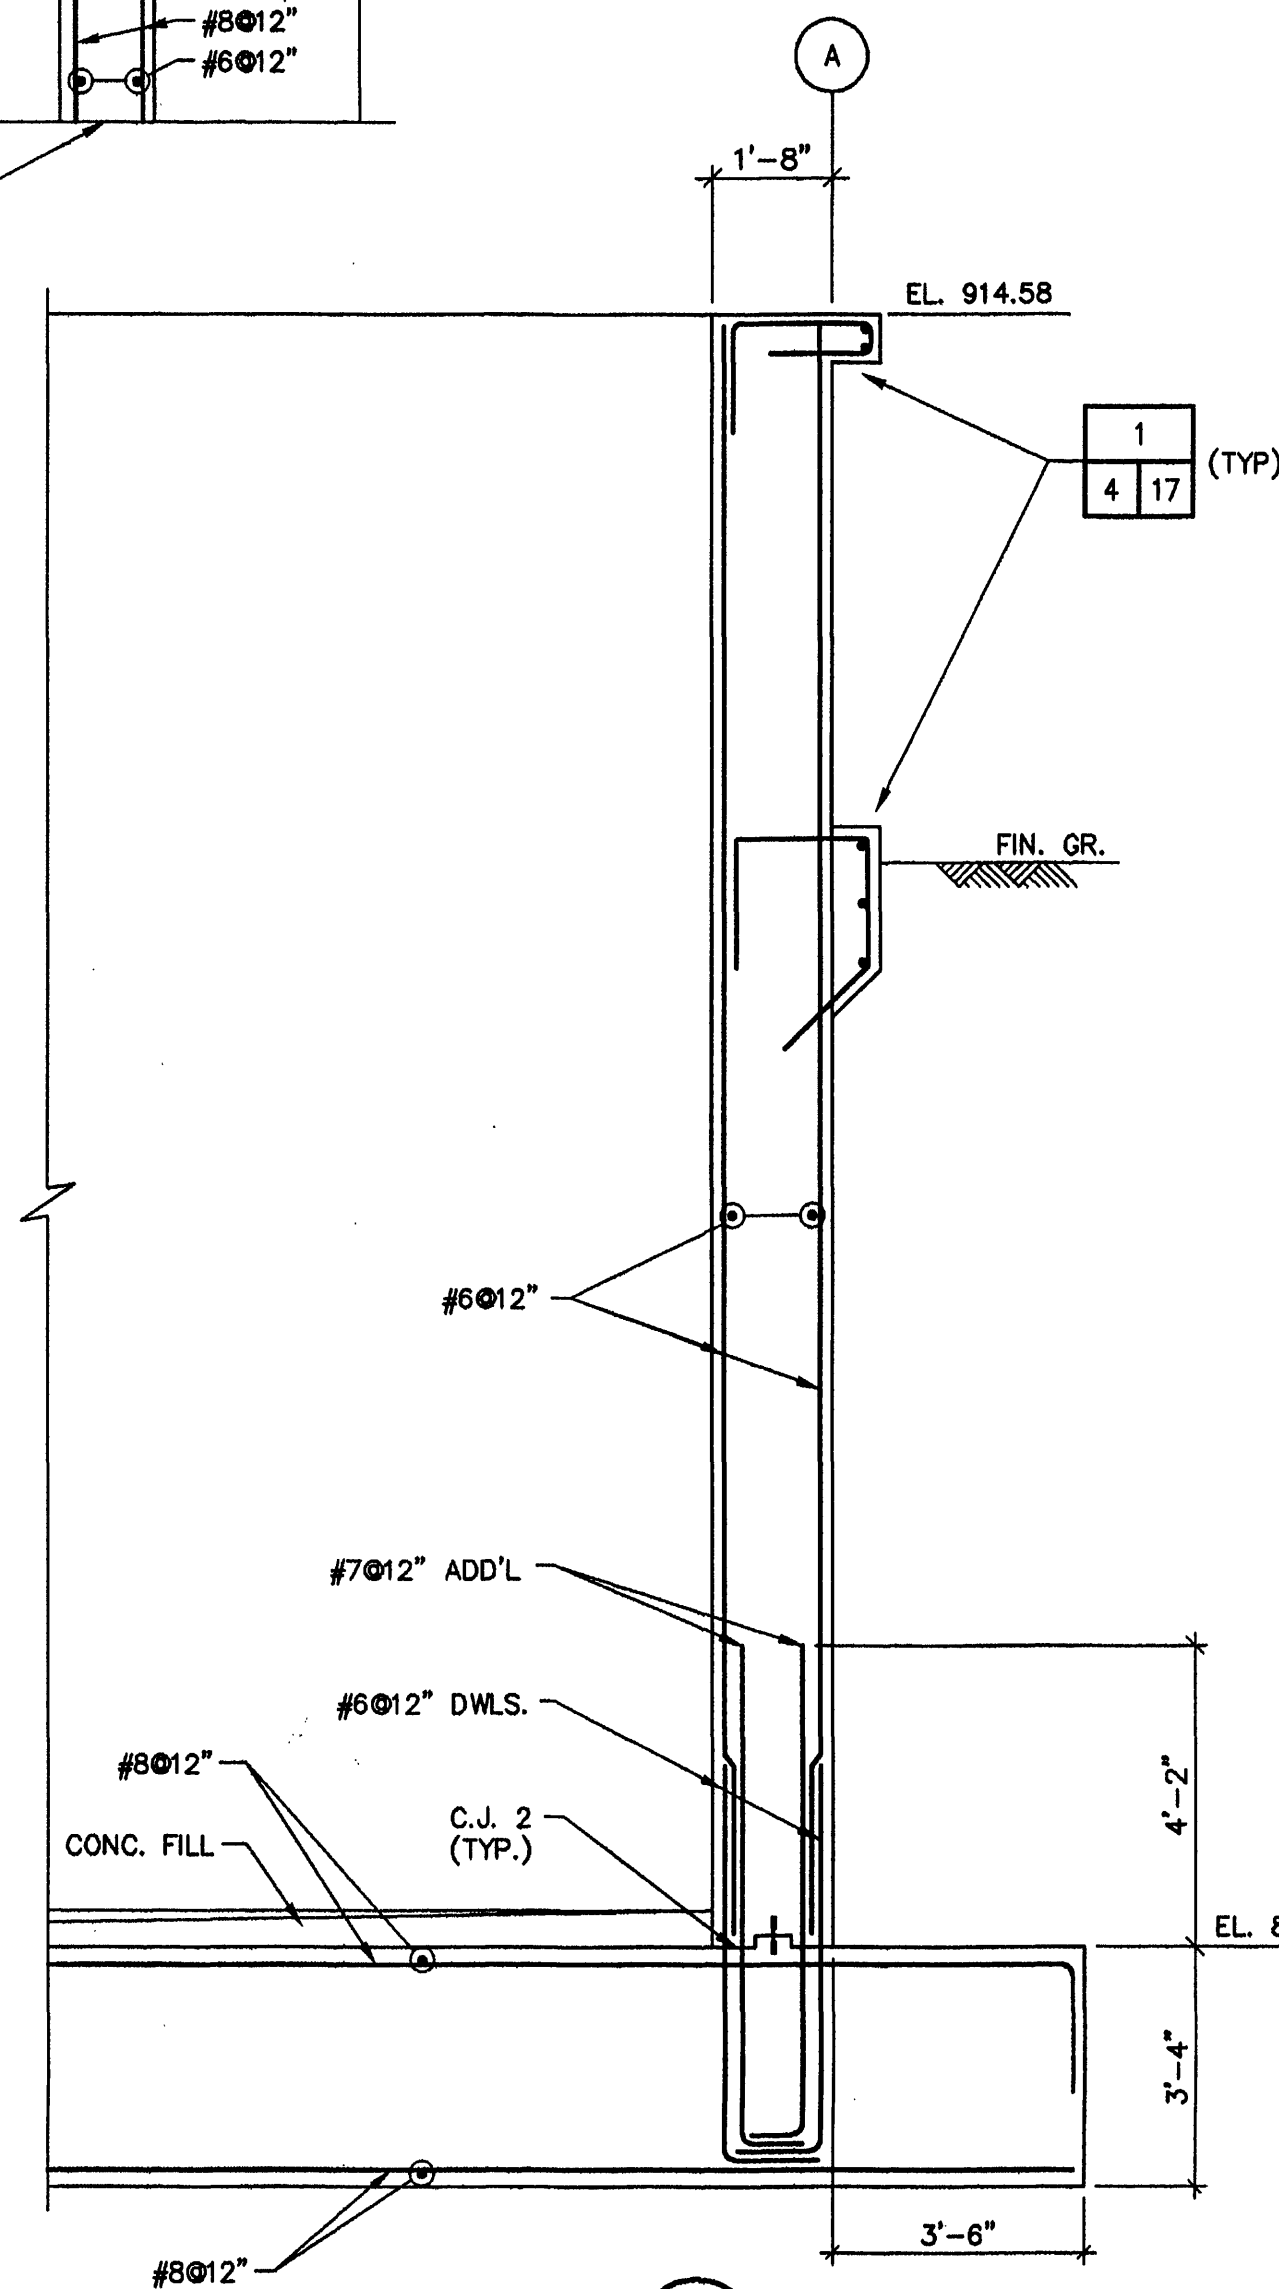

SECTION 1/2 10

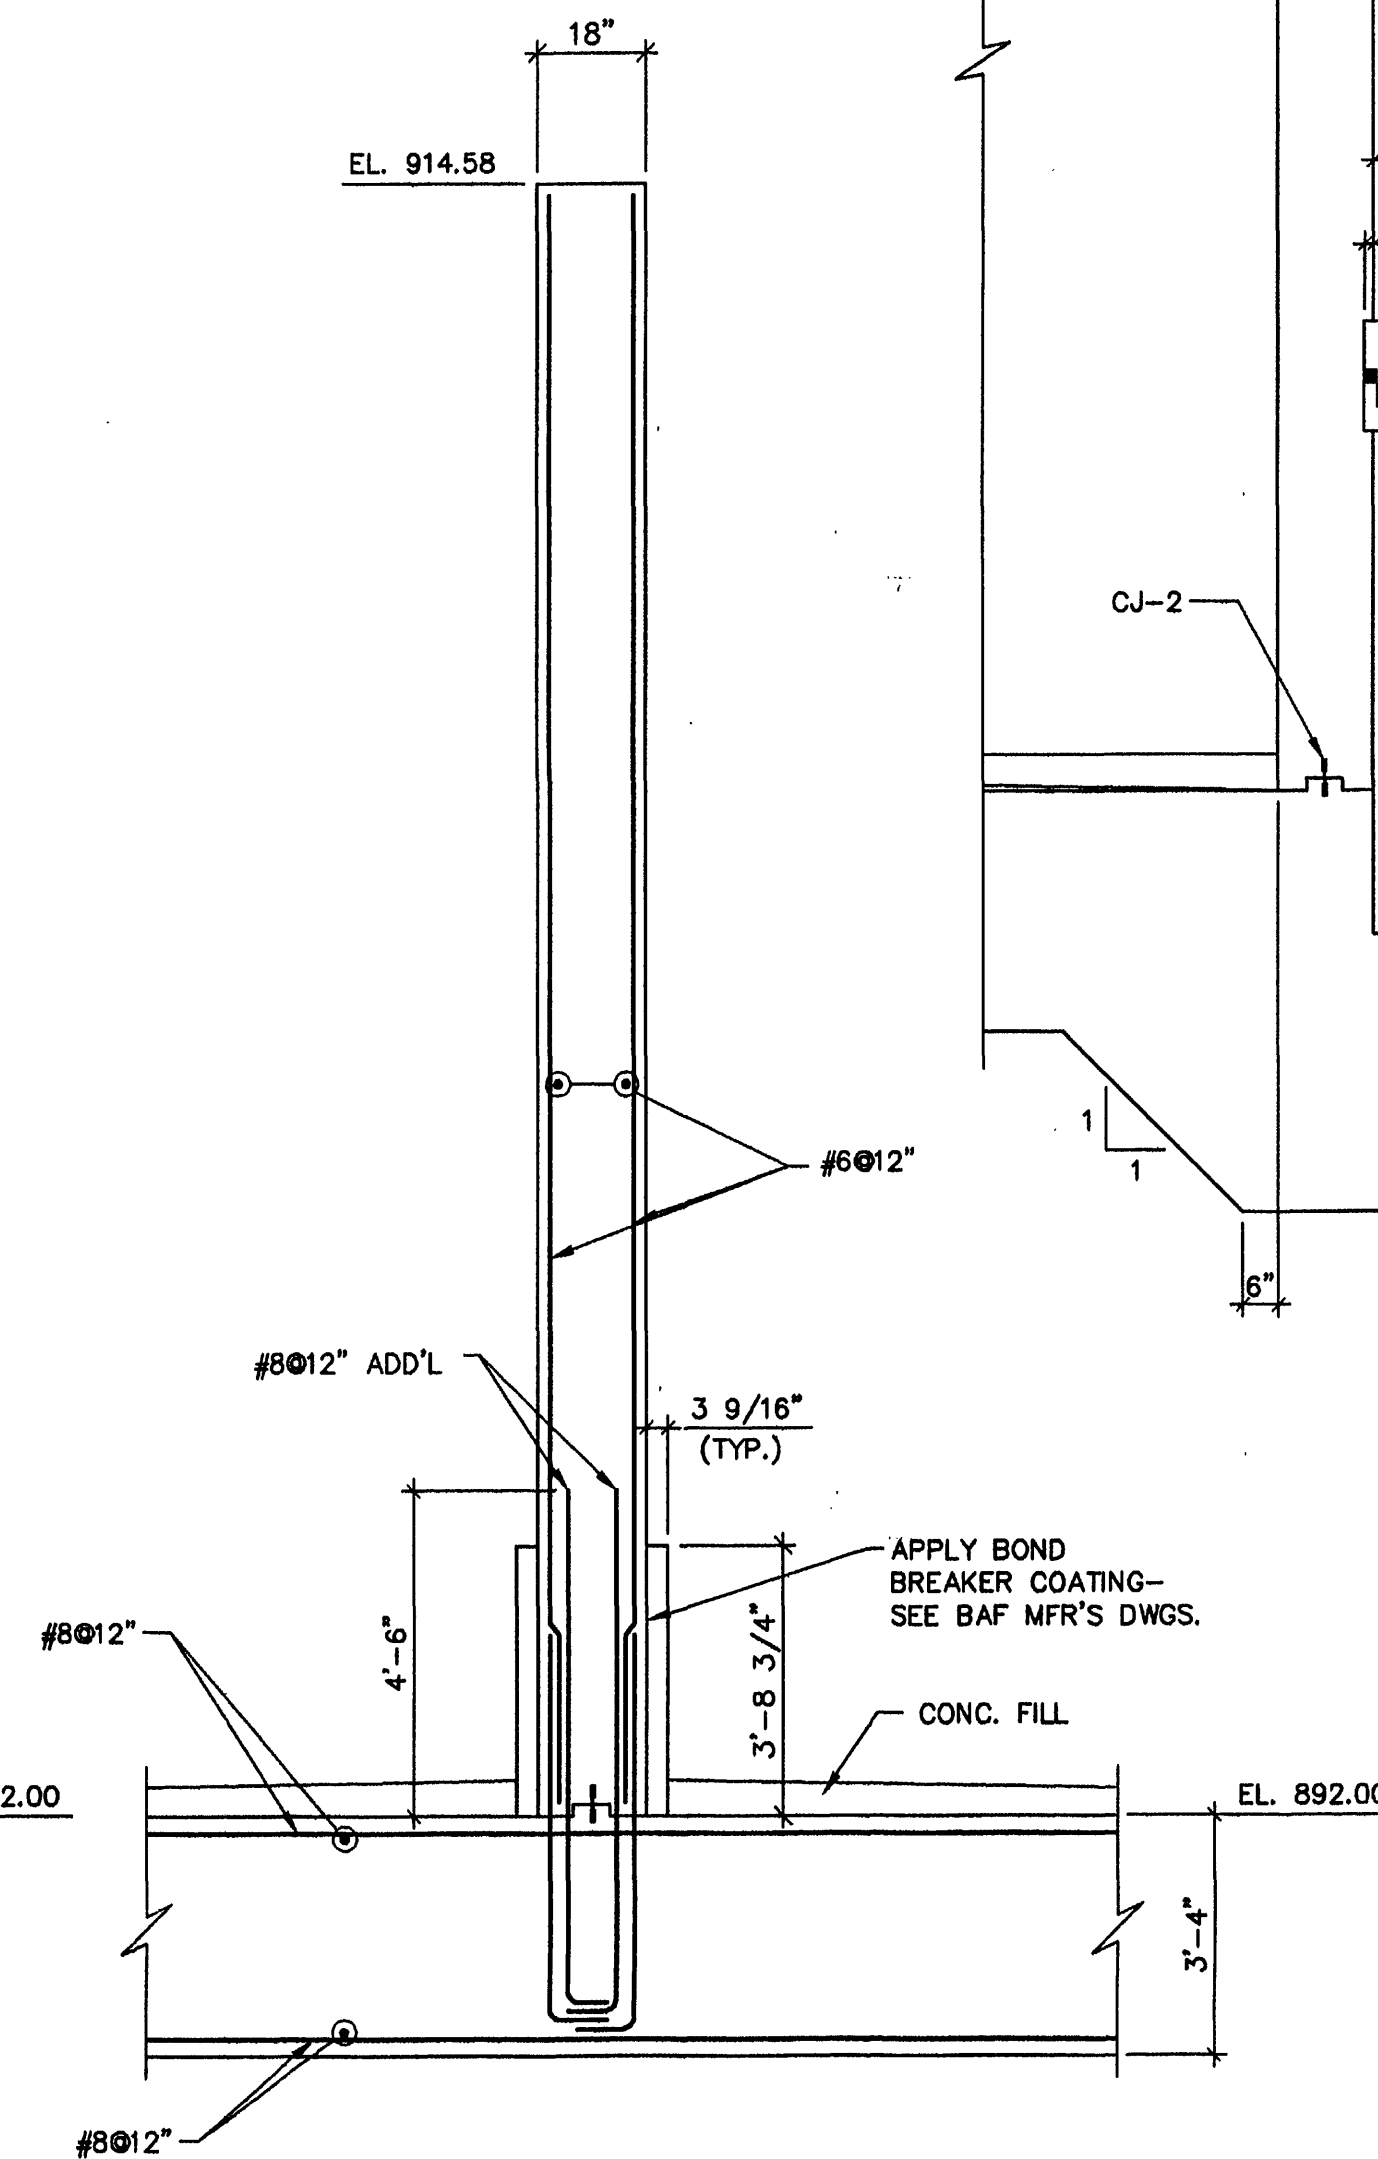


SECTION 2/2 10

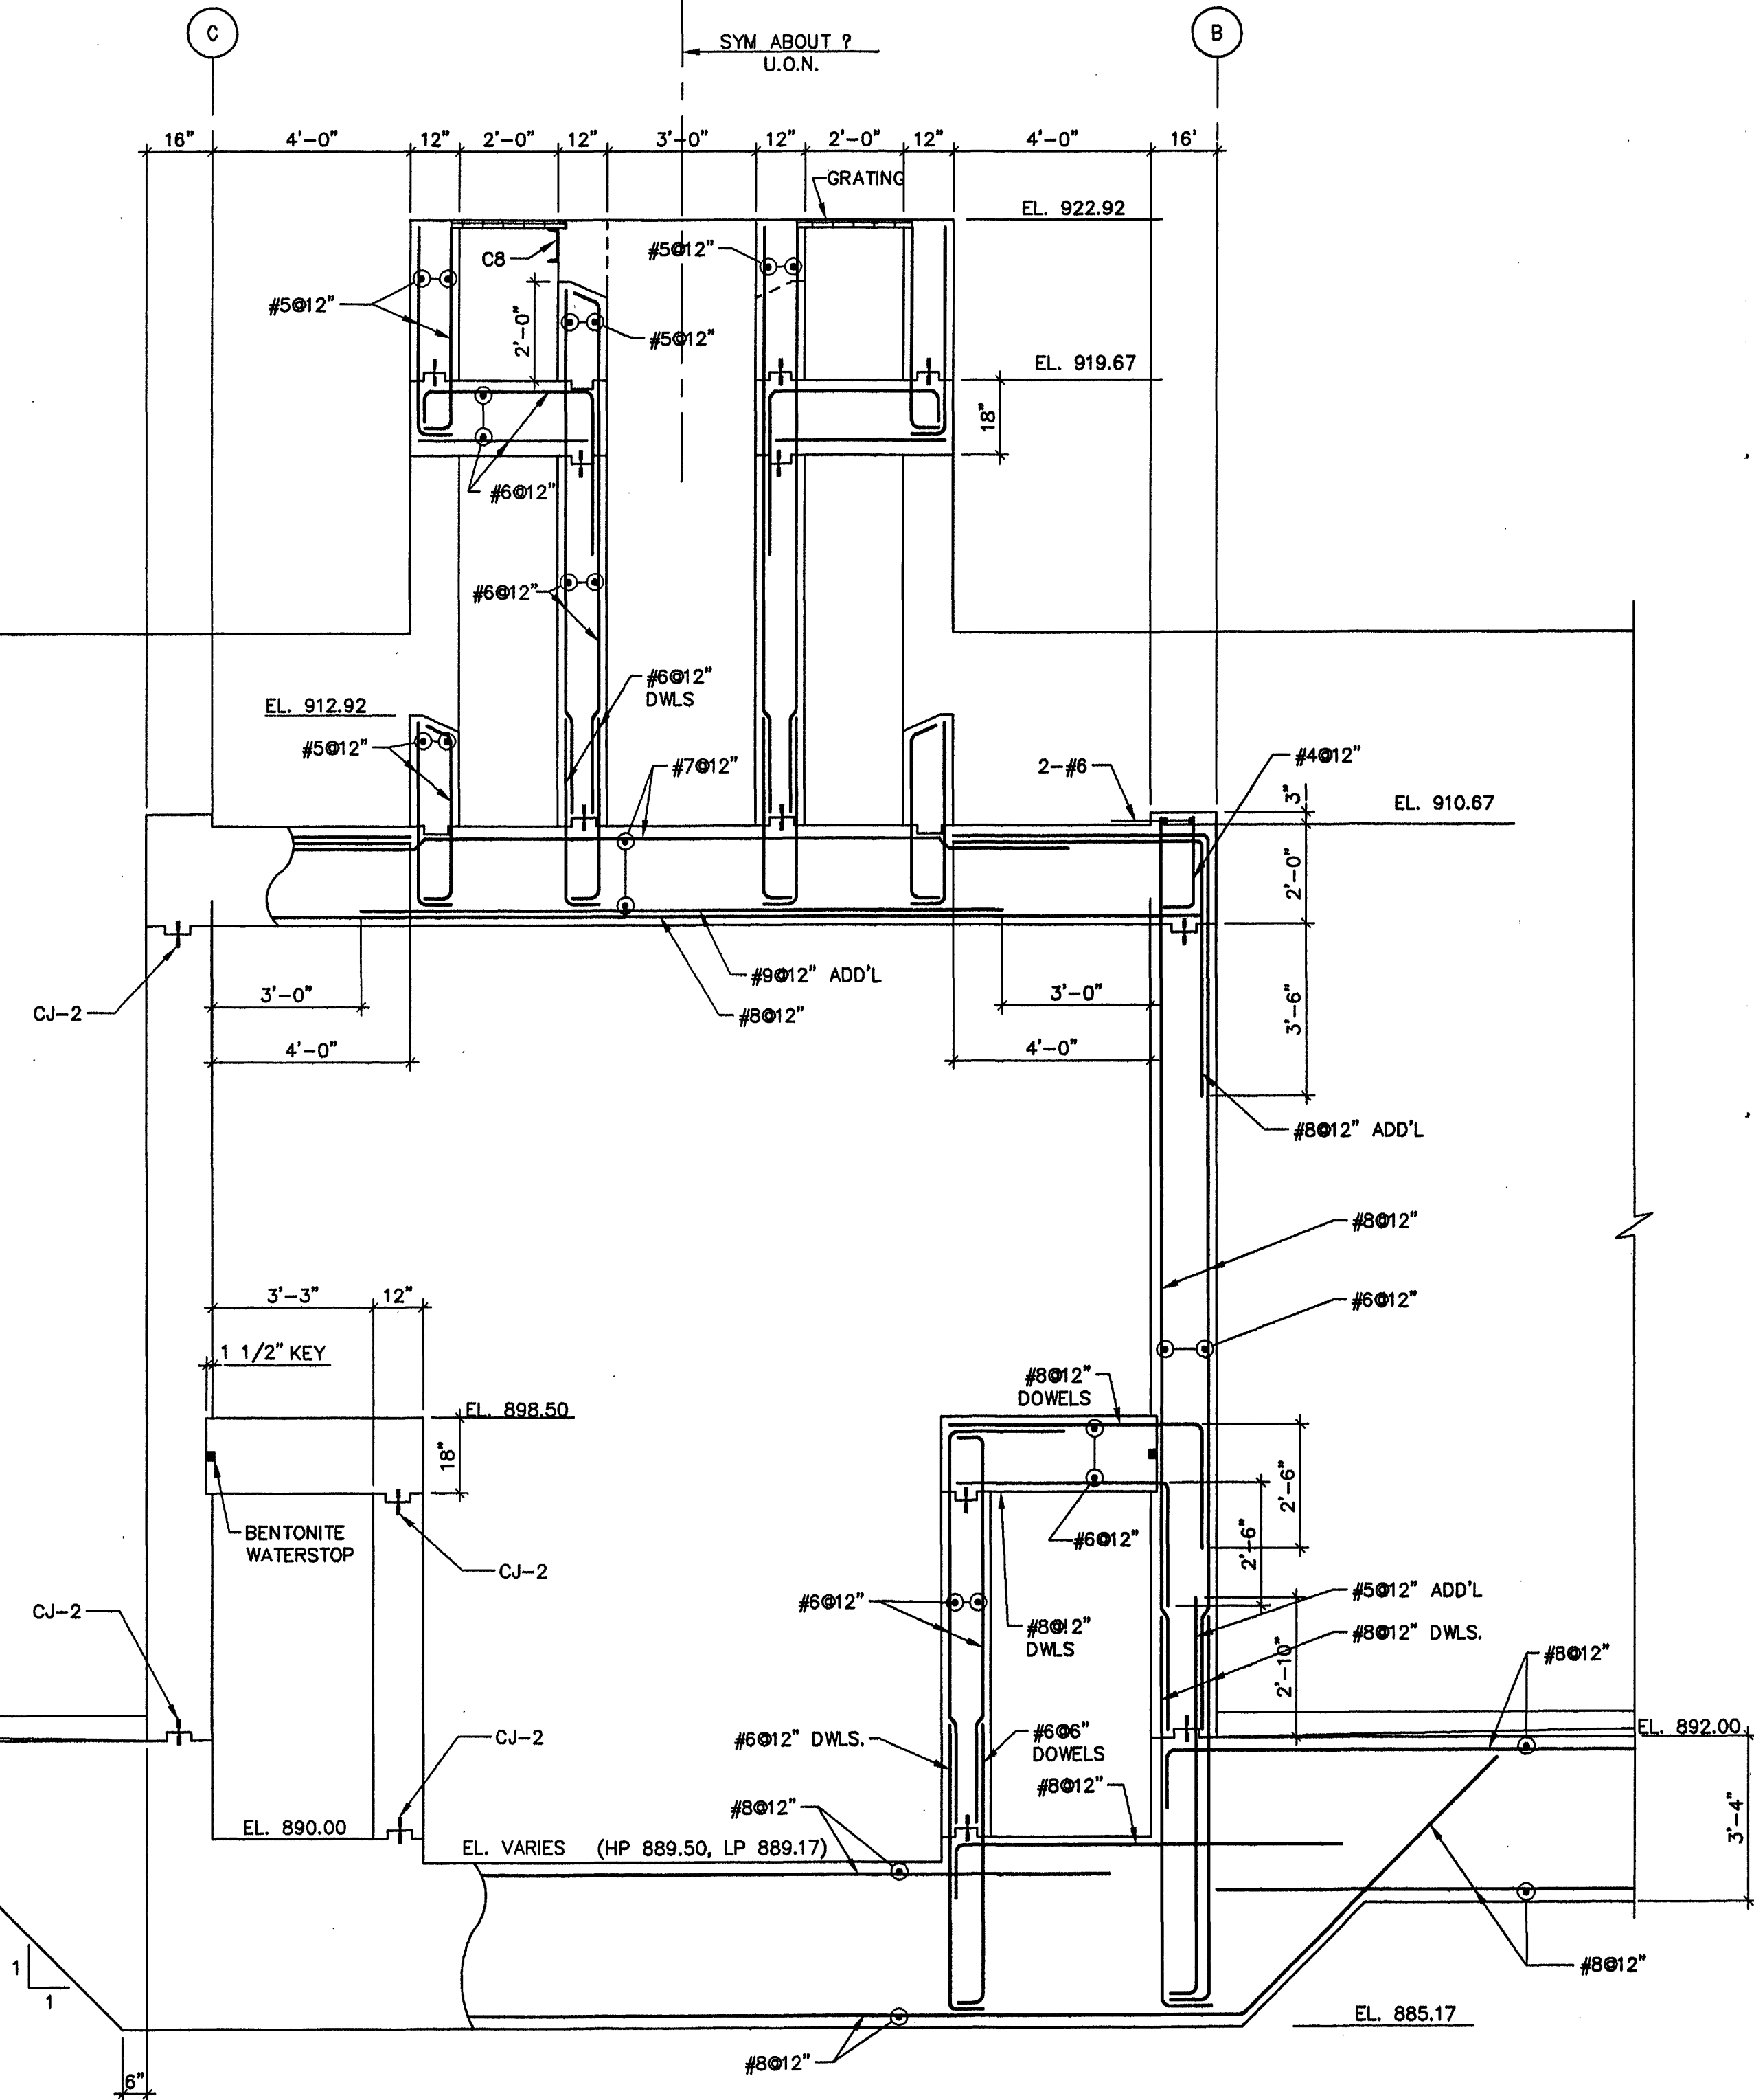

SECTION 3/2 10

NOTE: MONOLITHIC UNDERDRAIN FLOOR AND SUPPORT STRUCTURES NOT SHOWN. SEE IDI DWGS.

GENERAL NOTE:  
NOT ALL BAF EQUIPMENT, PIPING, VALVES AND APPURTENANCES ARE SHOWN. SEE SPECIFICATIONS AND BAF MANUFACTURER'S SHOP DRAWINGS FOR ADDITIONAL ITEMS AND SCOPE OF EQUIPMENT, PIPING, VALVES AND APPURTENANCES SUPPLIED TO THE CONTRACTOR BY THE BAF MANUFACTURER.

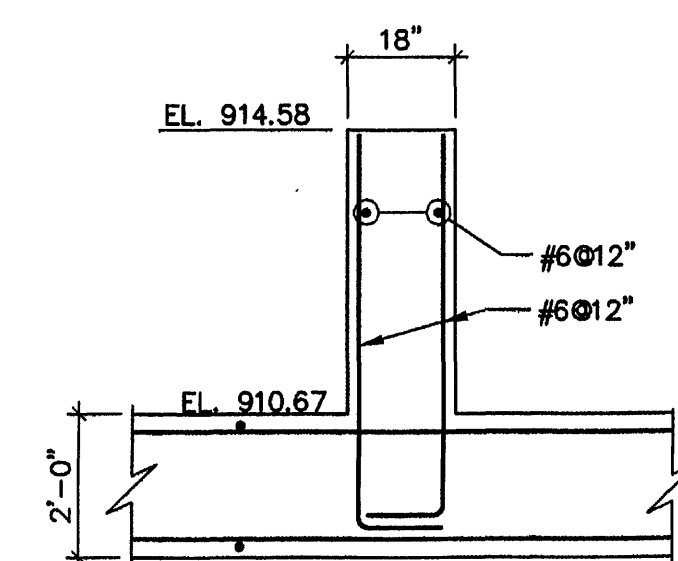

SECTION 1/10 10

**MALCOLM PIRNIE**

11892 Rock Landing Drive, Suite 400  
Newport News, Virginia 23606

| REVISIONS |     |           |                | REMARKS |
|-----------|-----|-----------|----------------|---------|
| NO.       | BY  | DATE      | DESCRIPTION    |         |
| 1         | ARB | JAN. 2000 | RECORD DRAWING |         |

DES - MZ  
DWN - CBM  
CKD - DB



CITY OF ROANOKE, VIRGINIA  
WATER POLLUTION  
CONTROL PLANT  
UPGRADE AND EXPANSION

BIOLOGICAL AERATED FILTER  
SECTIONS

3/8"=1'-0"

COPYRIGHT © 1997  
MALCOLM PIRNIE, INC.

DATE MAY 1997

SHEET 10 OF 44

CAD REF. NO. 00600360